



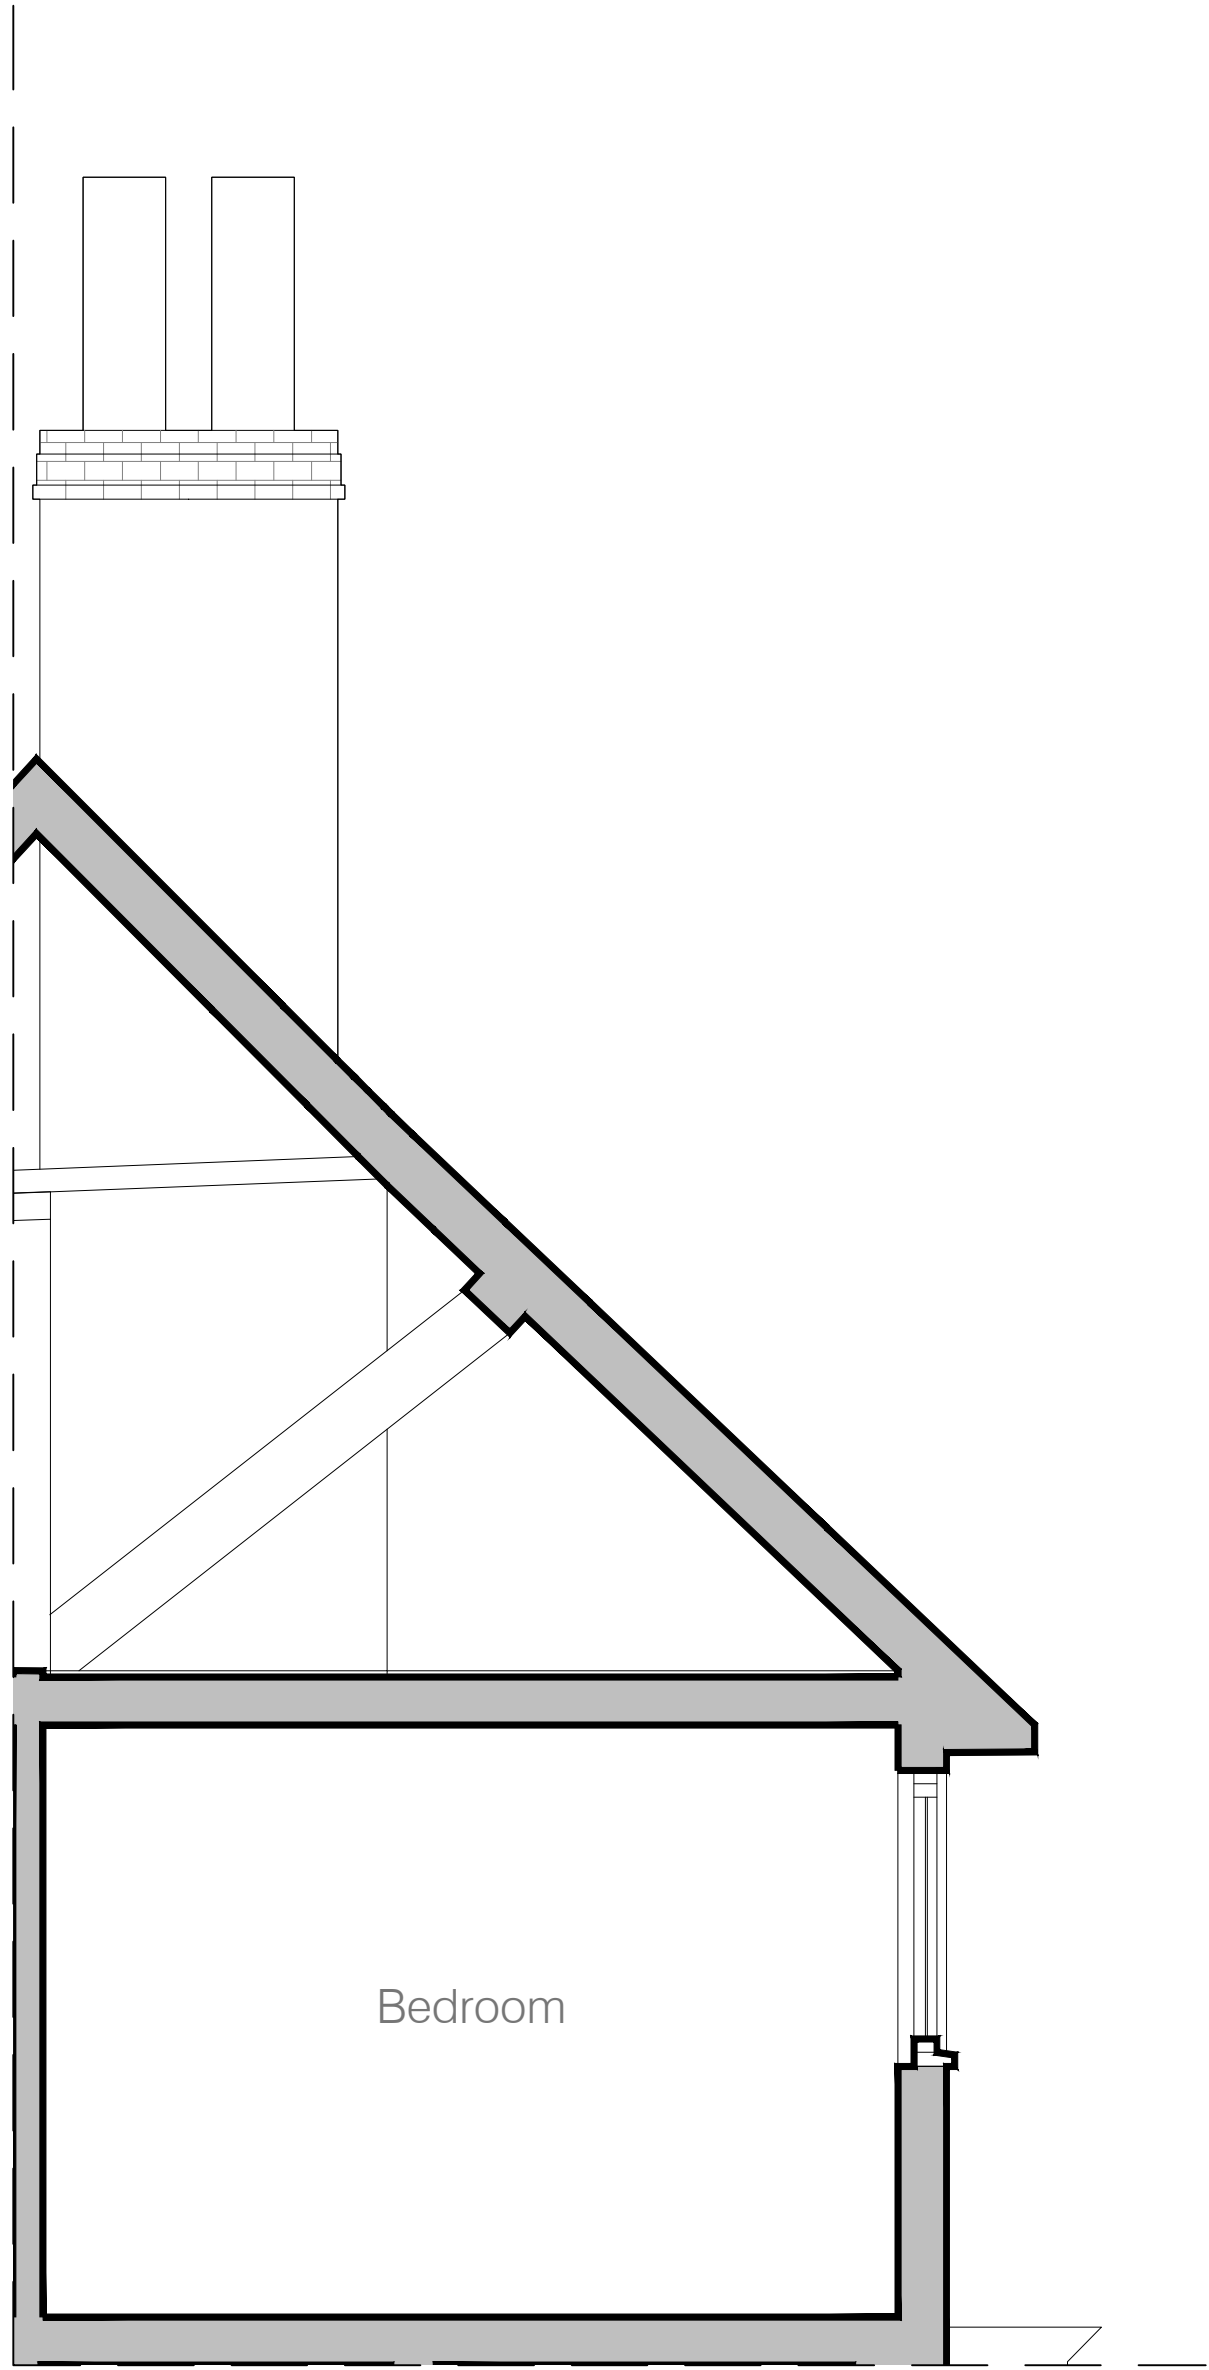


Approved Scheme First Floor SE Bedroom - Section
Scale 1:25@A1
1:50@A3

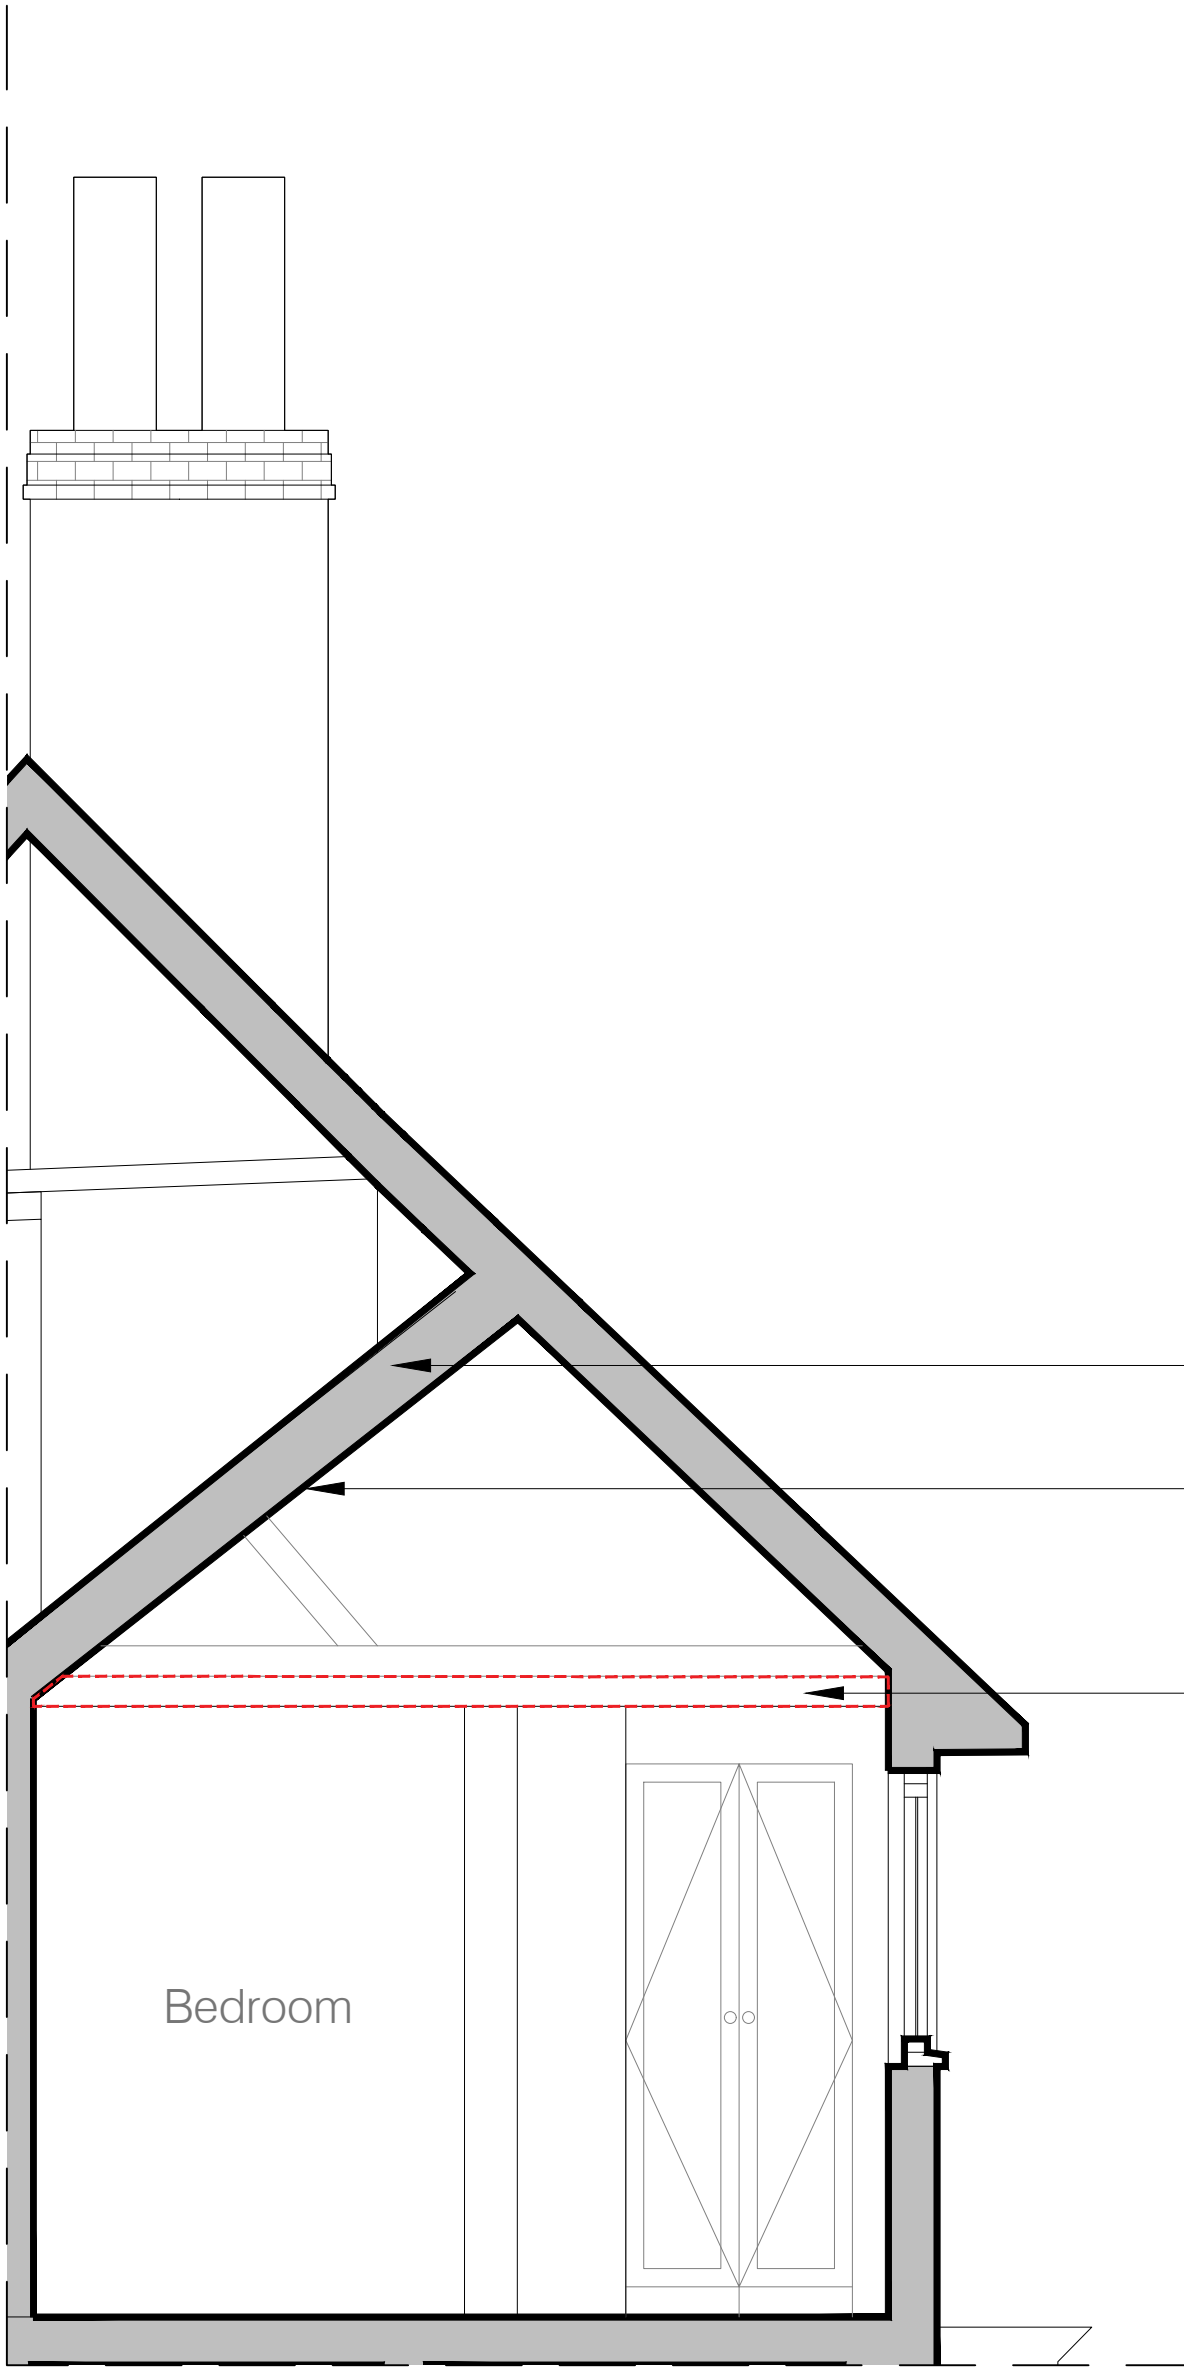

Proposed First Floor SE Bedroom - Section
Scale 1:25@A1
1:50@A3

Existing timber roof rafter retained and restored by a specialist
Insertion of vaulted ceiling in reclaimed timber rafters, lath and lime plaster finish
New timber ceiling joists to be installed in place of the removed ceiling

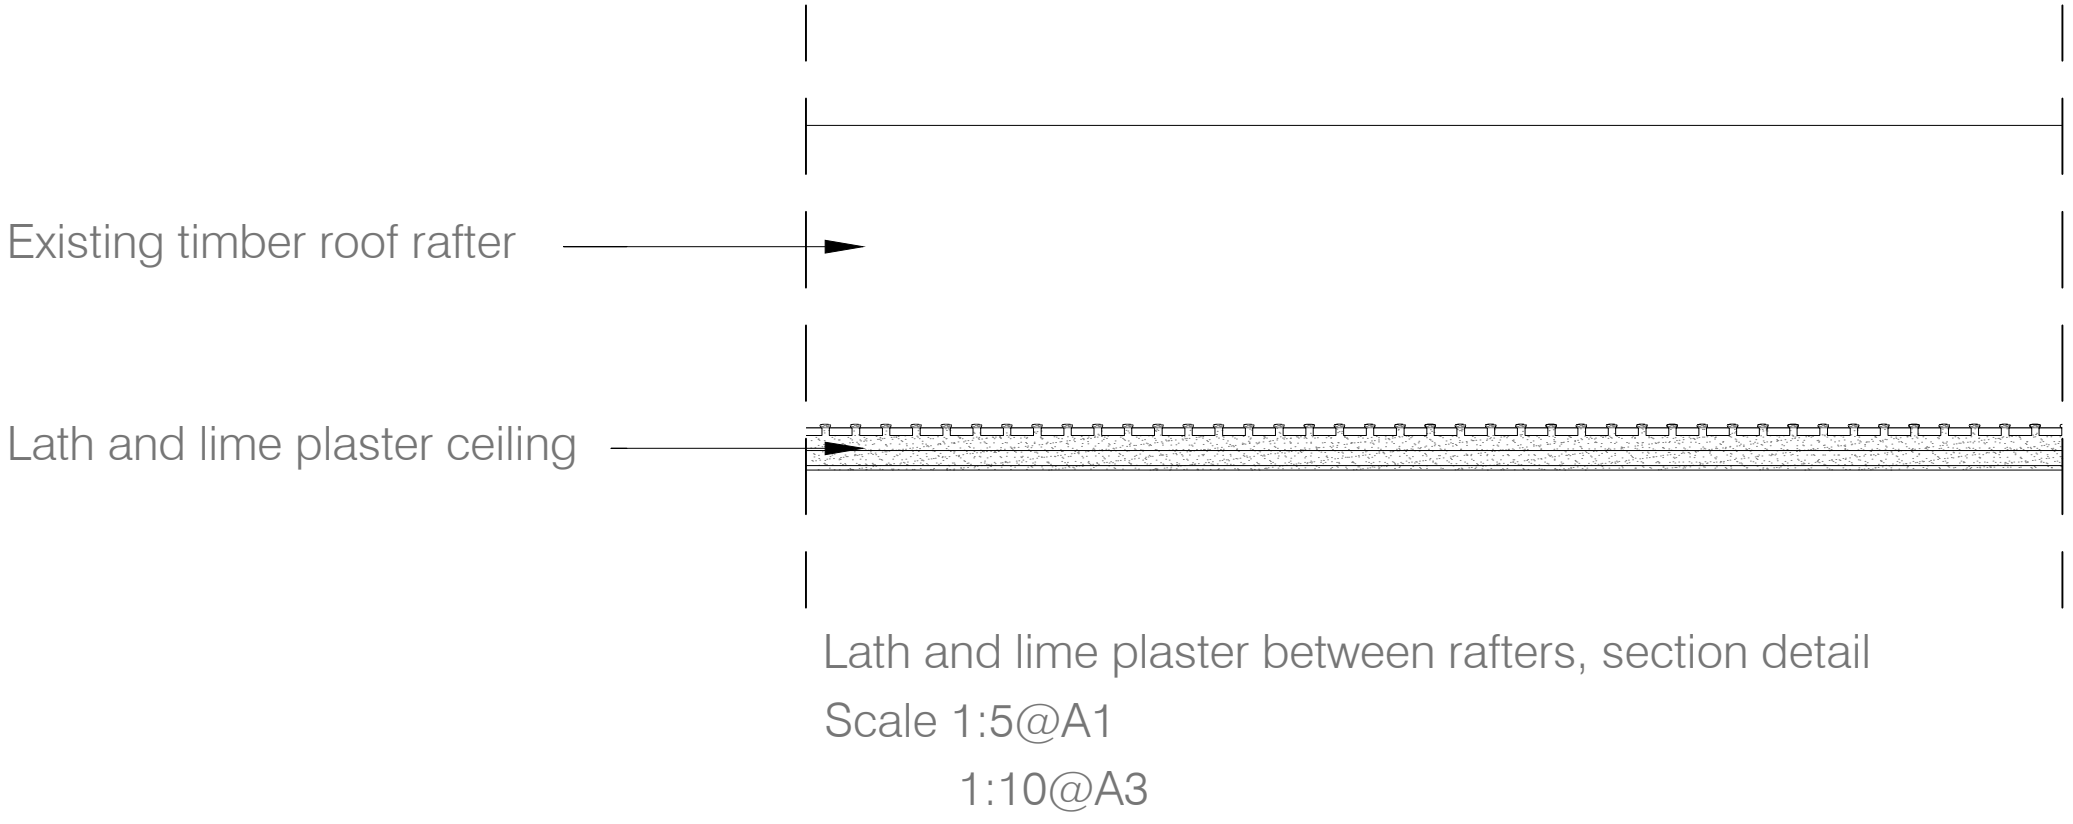

Vaulted ceiling, first floor SE bedroom

KEY:
Highlighted difference between Approved Scheme and 'As-Built'/Proposed Scheme

Rev: A				Comments: Amendments as clouded.				By: KN				Date: Nov 25							
				Client: Mr. Simon Dougall															
				Project Title: 107 High St, Lindfield, Haywards Heath, West Sussex, RH16 2HR															
				Drawing Title: Detail Drawings: First Floor SE Bedroom Vaulted Ceiling															
				Scale: 1:25@A1 1:50@A3				Date: Apr 25				Drawn: KN				Checked: KW			
				Project No.: 900-25				Drawing No.: 5022				Revision: A							

kyson

28 Scrutton Street
London
UK
EC2A 4RP

T: +44(0) 20 7247 2462
E: enquiries@kyson.co.uk
W: www.kyson.co.uk