




Front Elevation




Rear Elevation

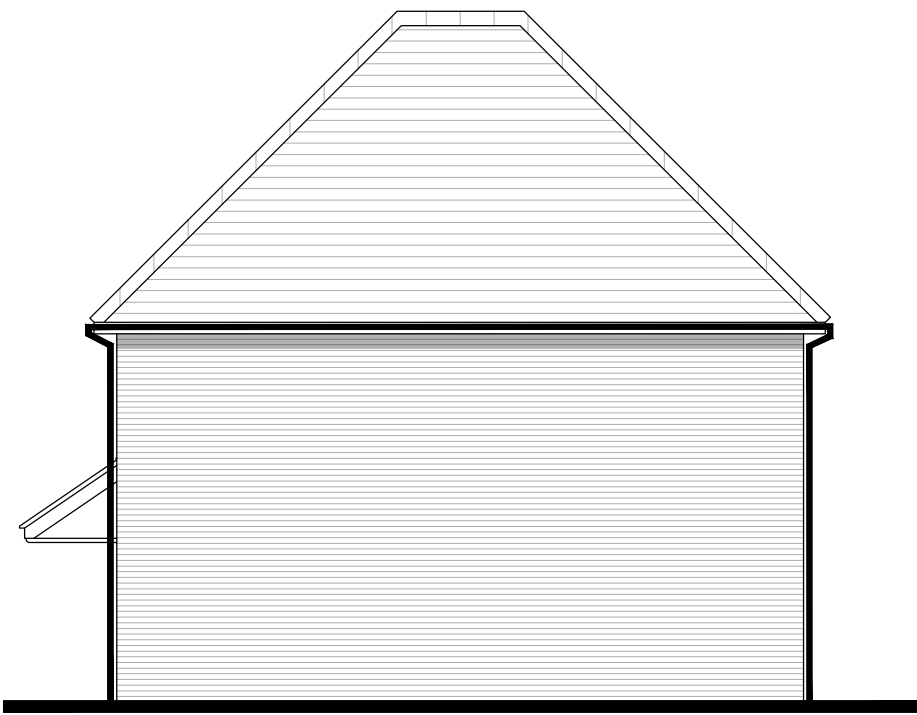


Side Elevation




Side Elevation

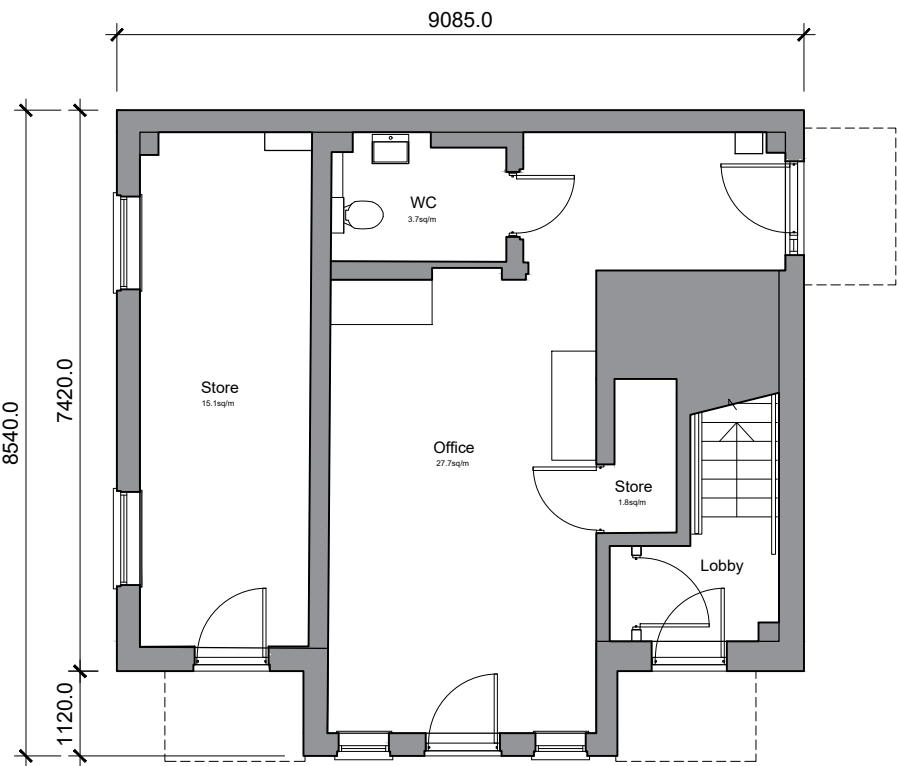

Ground Floor

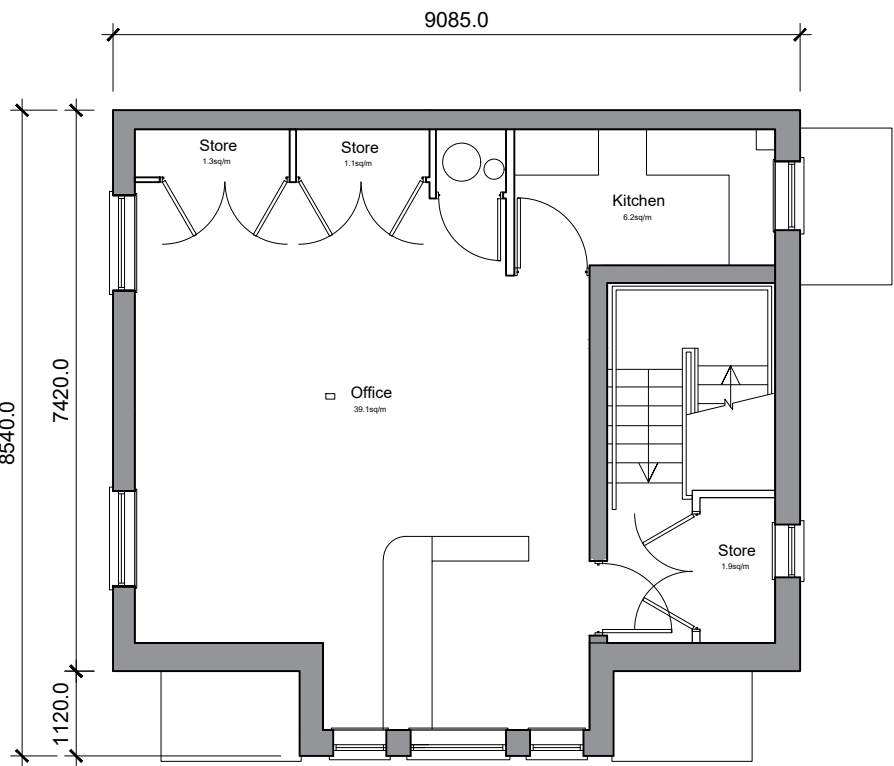

First Floor

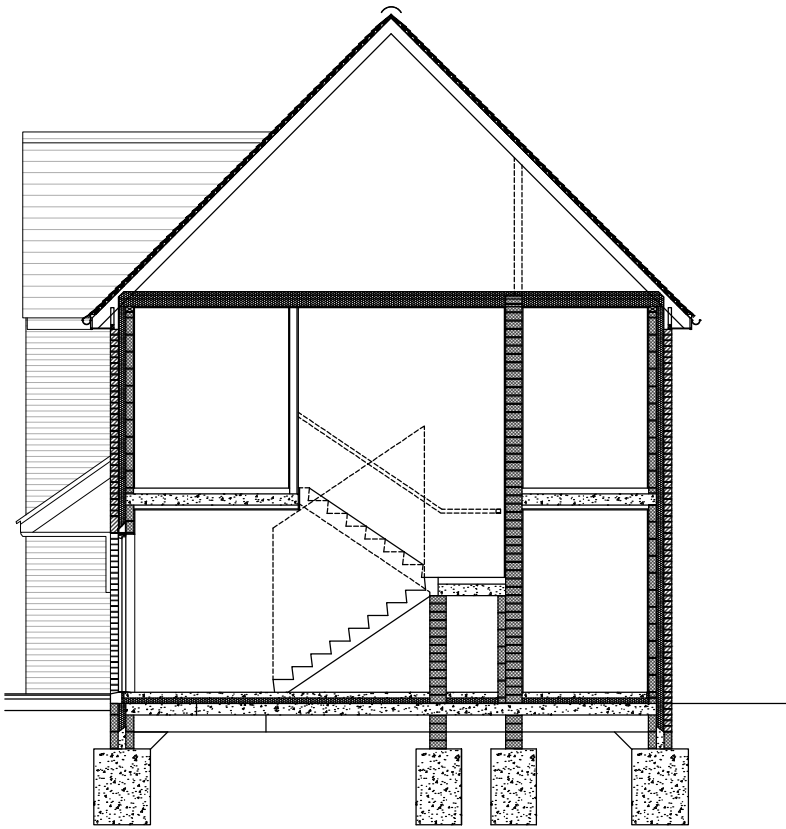

As-built Section



London:

76 Great Suffolk Street
London, SE1 0BL
T 0207 928 2773 E london@ecearchitecture.com

Sussex:

64 - 68 Brighton Road, Worthing
West Sussex, BN11 2EN
T 01903 248777 E sussex@ecearchitecture.com

Bristol:

Westworks, Beacon Tower
Colston Street, Bristol, BS1 4XE
T 0117 214 1101 E bristol@ecwestworks.com

ECE Architecture
www.ecearchitecture.com

Client's Name
Hyde Housing Association

Job Title
Old Farm Close
Haywards Heath

Drawing Title
Existing Floor plans and Elevations



Drawn	Checked	Date
NK	MG	03.02.25

Job No	Drawing No	Rev
7369	PL-04	P1

Status

INFORMATION