


CDM 2015 Health & Safety Information

This information relates only to 'Significant Hazards' identified on this drawing and is to be read in conjunction with the Designer's Hazard Register.




Front Elevation

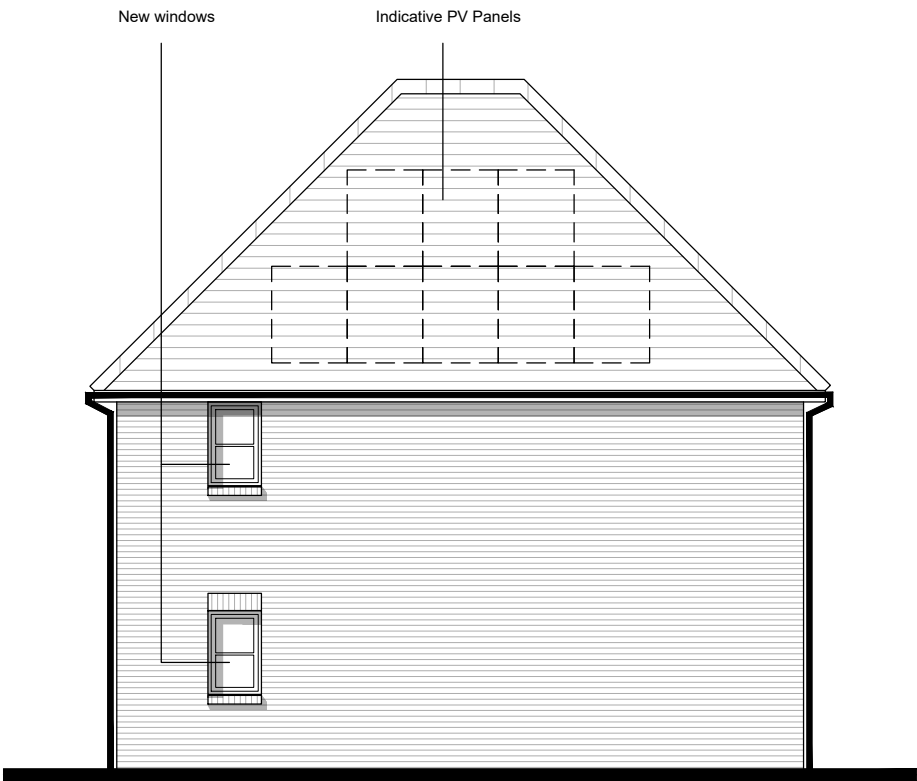


Rear Elevation



Side Elevation

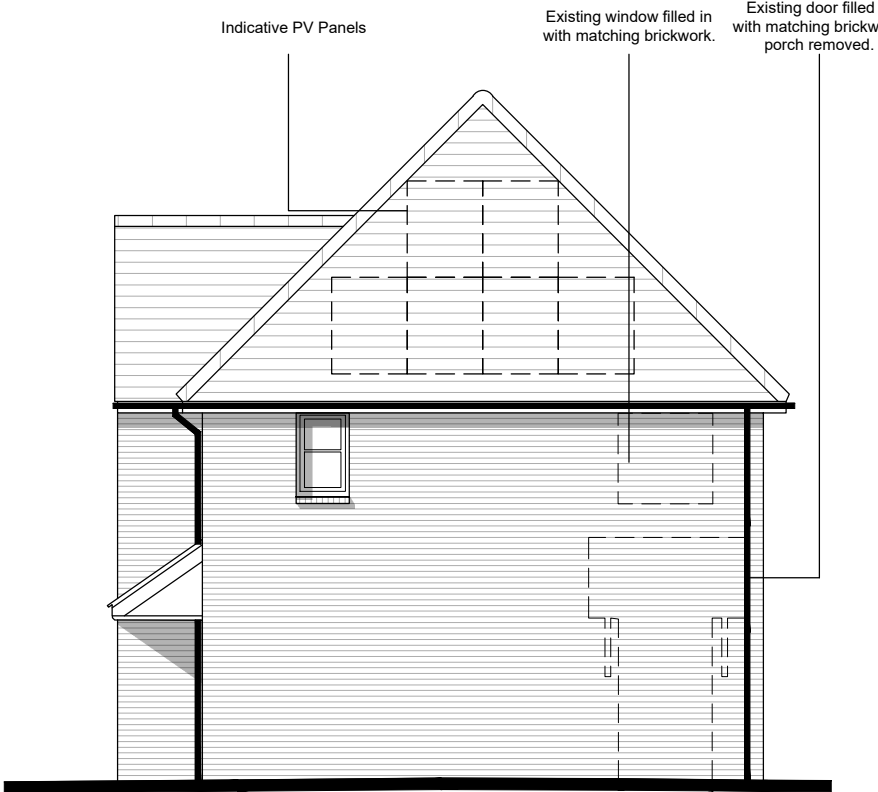


Side Elevation

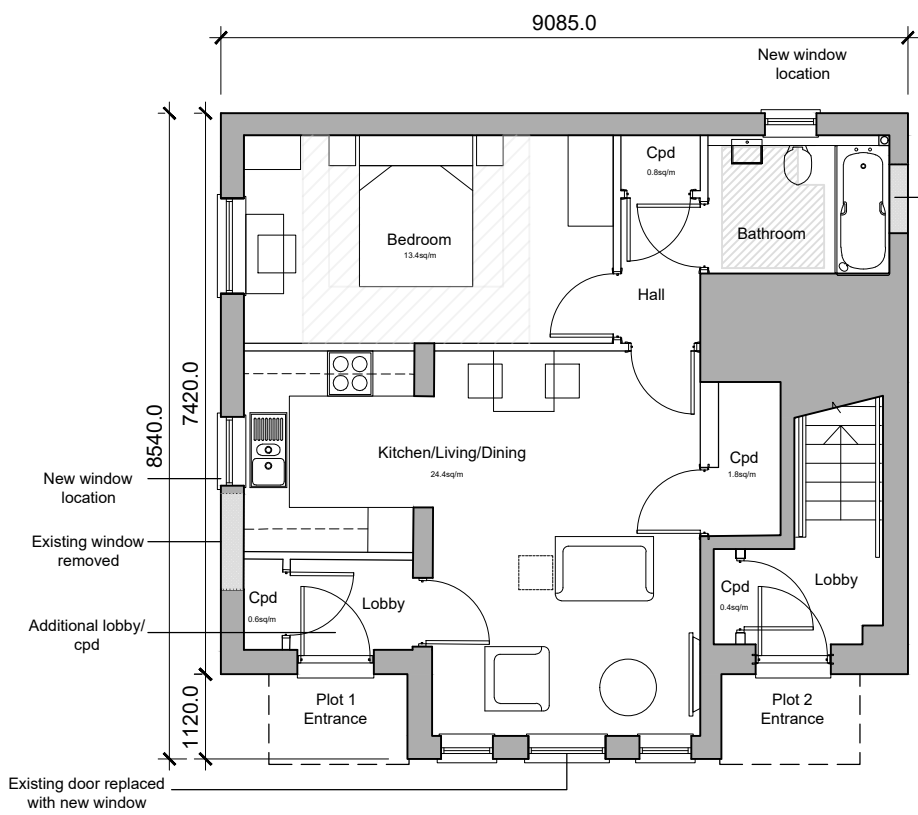

Ground Floor

PLOT 01
1 bed / 2 person flat
51.7sqm GIA to finishes
A minimum of 1.5m2 storage area is provided as per the requirements of NDSS

Total storage area provided is 3.2m2

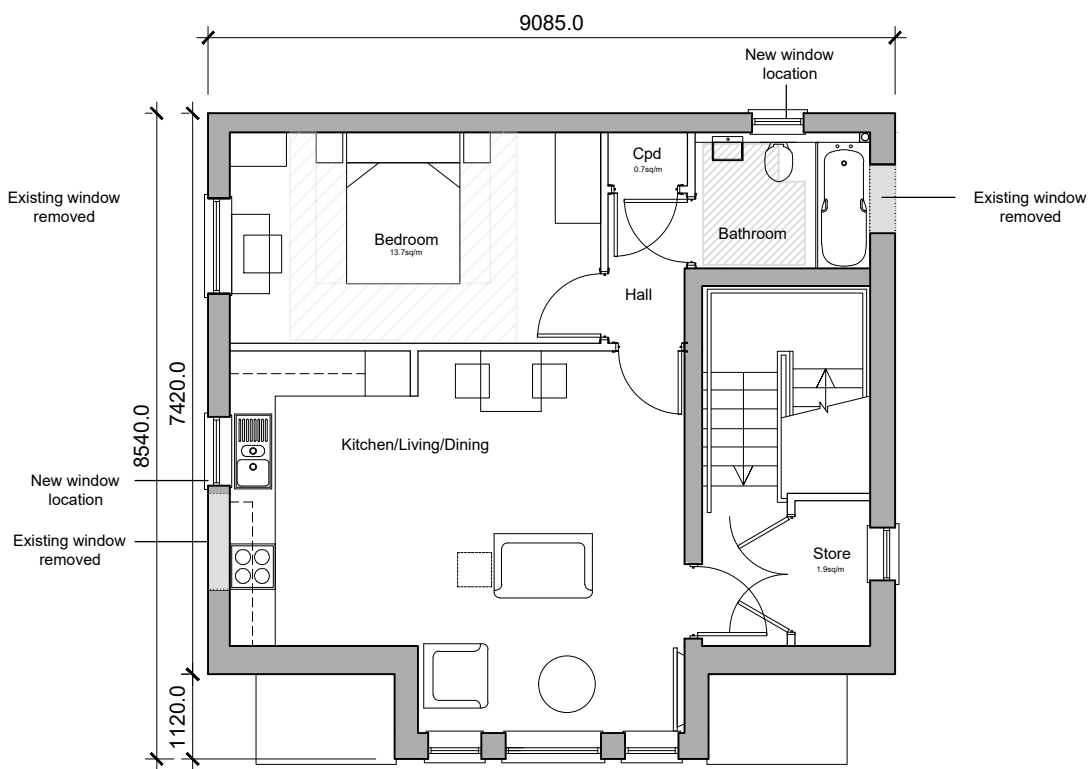


First Floor

PLOT 02
1 bed / 2 person flat
Ground Floor: 4.9sqm GIA to finishes
First Floor: 61.6sqm GIA to finishes
Total: 66.5sqm GIA to finishes

A minimum of 1.5m2 storage area is provided as per the requirements of NDSS

Total storage area provided is 3.1m2

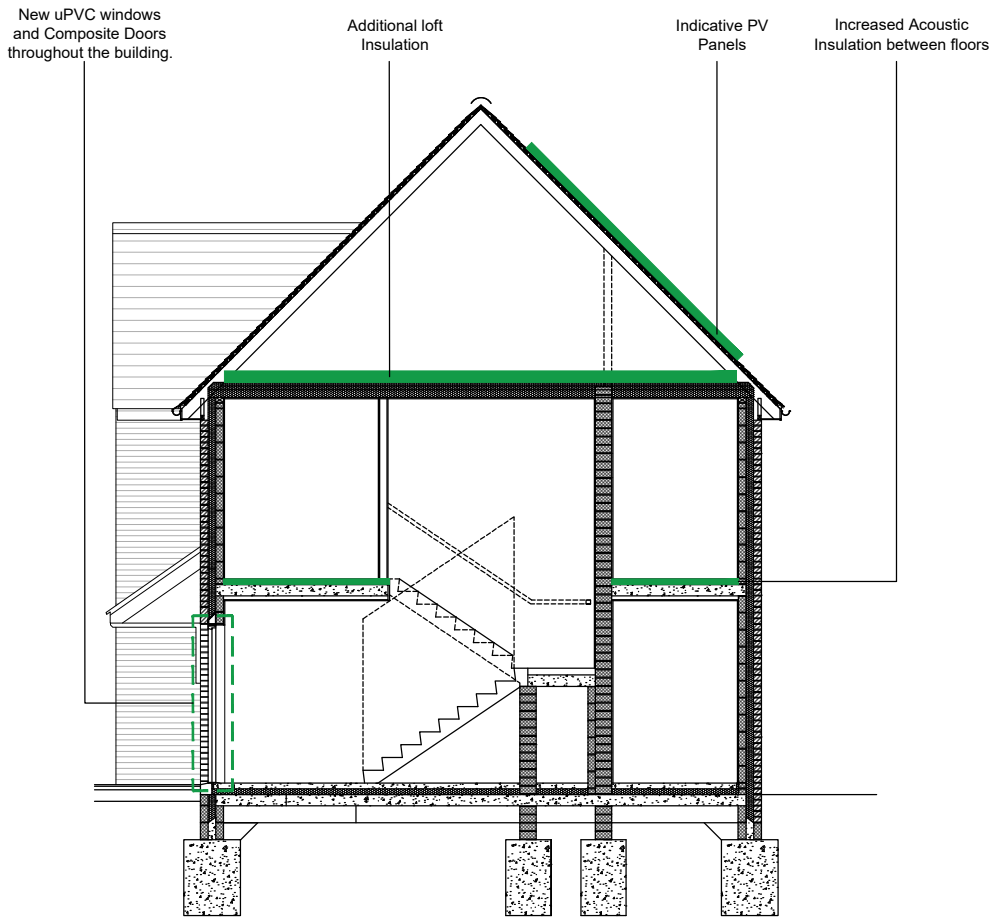

As-built Section

P1	25.02.25	Planning Submission	NK	MG
Rev	Date	Revision Details	Dr	Ch



London: 76 Great Suffolk Street
London, SE1 0BL
T 0207 928 2773 E london@eearchitecture.com

Sussex: 64 - 68 Brighton Road, Worthing
West Sussex, BN11 2EN
T 01903 248777 E sussex@eearchitecture.com

Bristol: Westworks, Beacon Tower
Colston Street, Bristol, BS1 4XE
T 0117 214 1101 E bristol@ecwestworks.com

ECE Architecture
www.eearchitecture.com

Client's Name
Hyde Housing Association

Job Title
**Old Farm Close
Haywards Heath**

Drawing Title
Proposed Floor plans and Elevations

Scale
1:100 @ A2



Drawn	Checked	Date
NK	MG	03.02.25

Job No	Drawing No	Rev
7369	PL-06	P1

Status
APPROVAL