



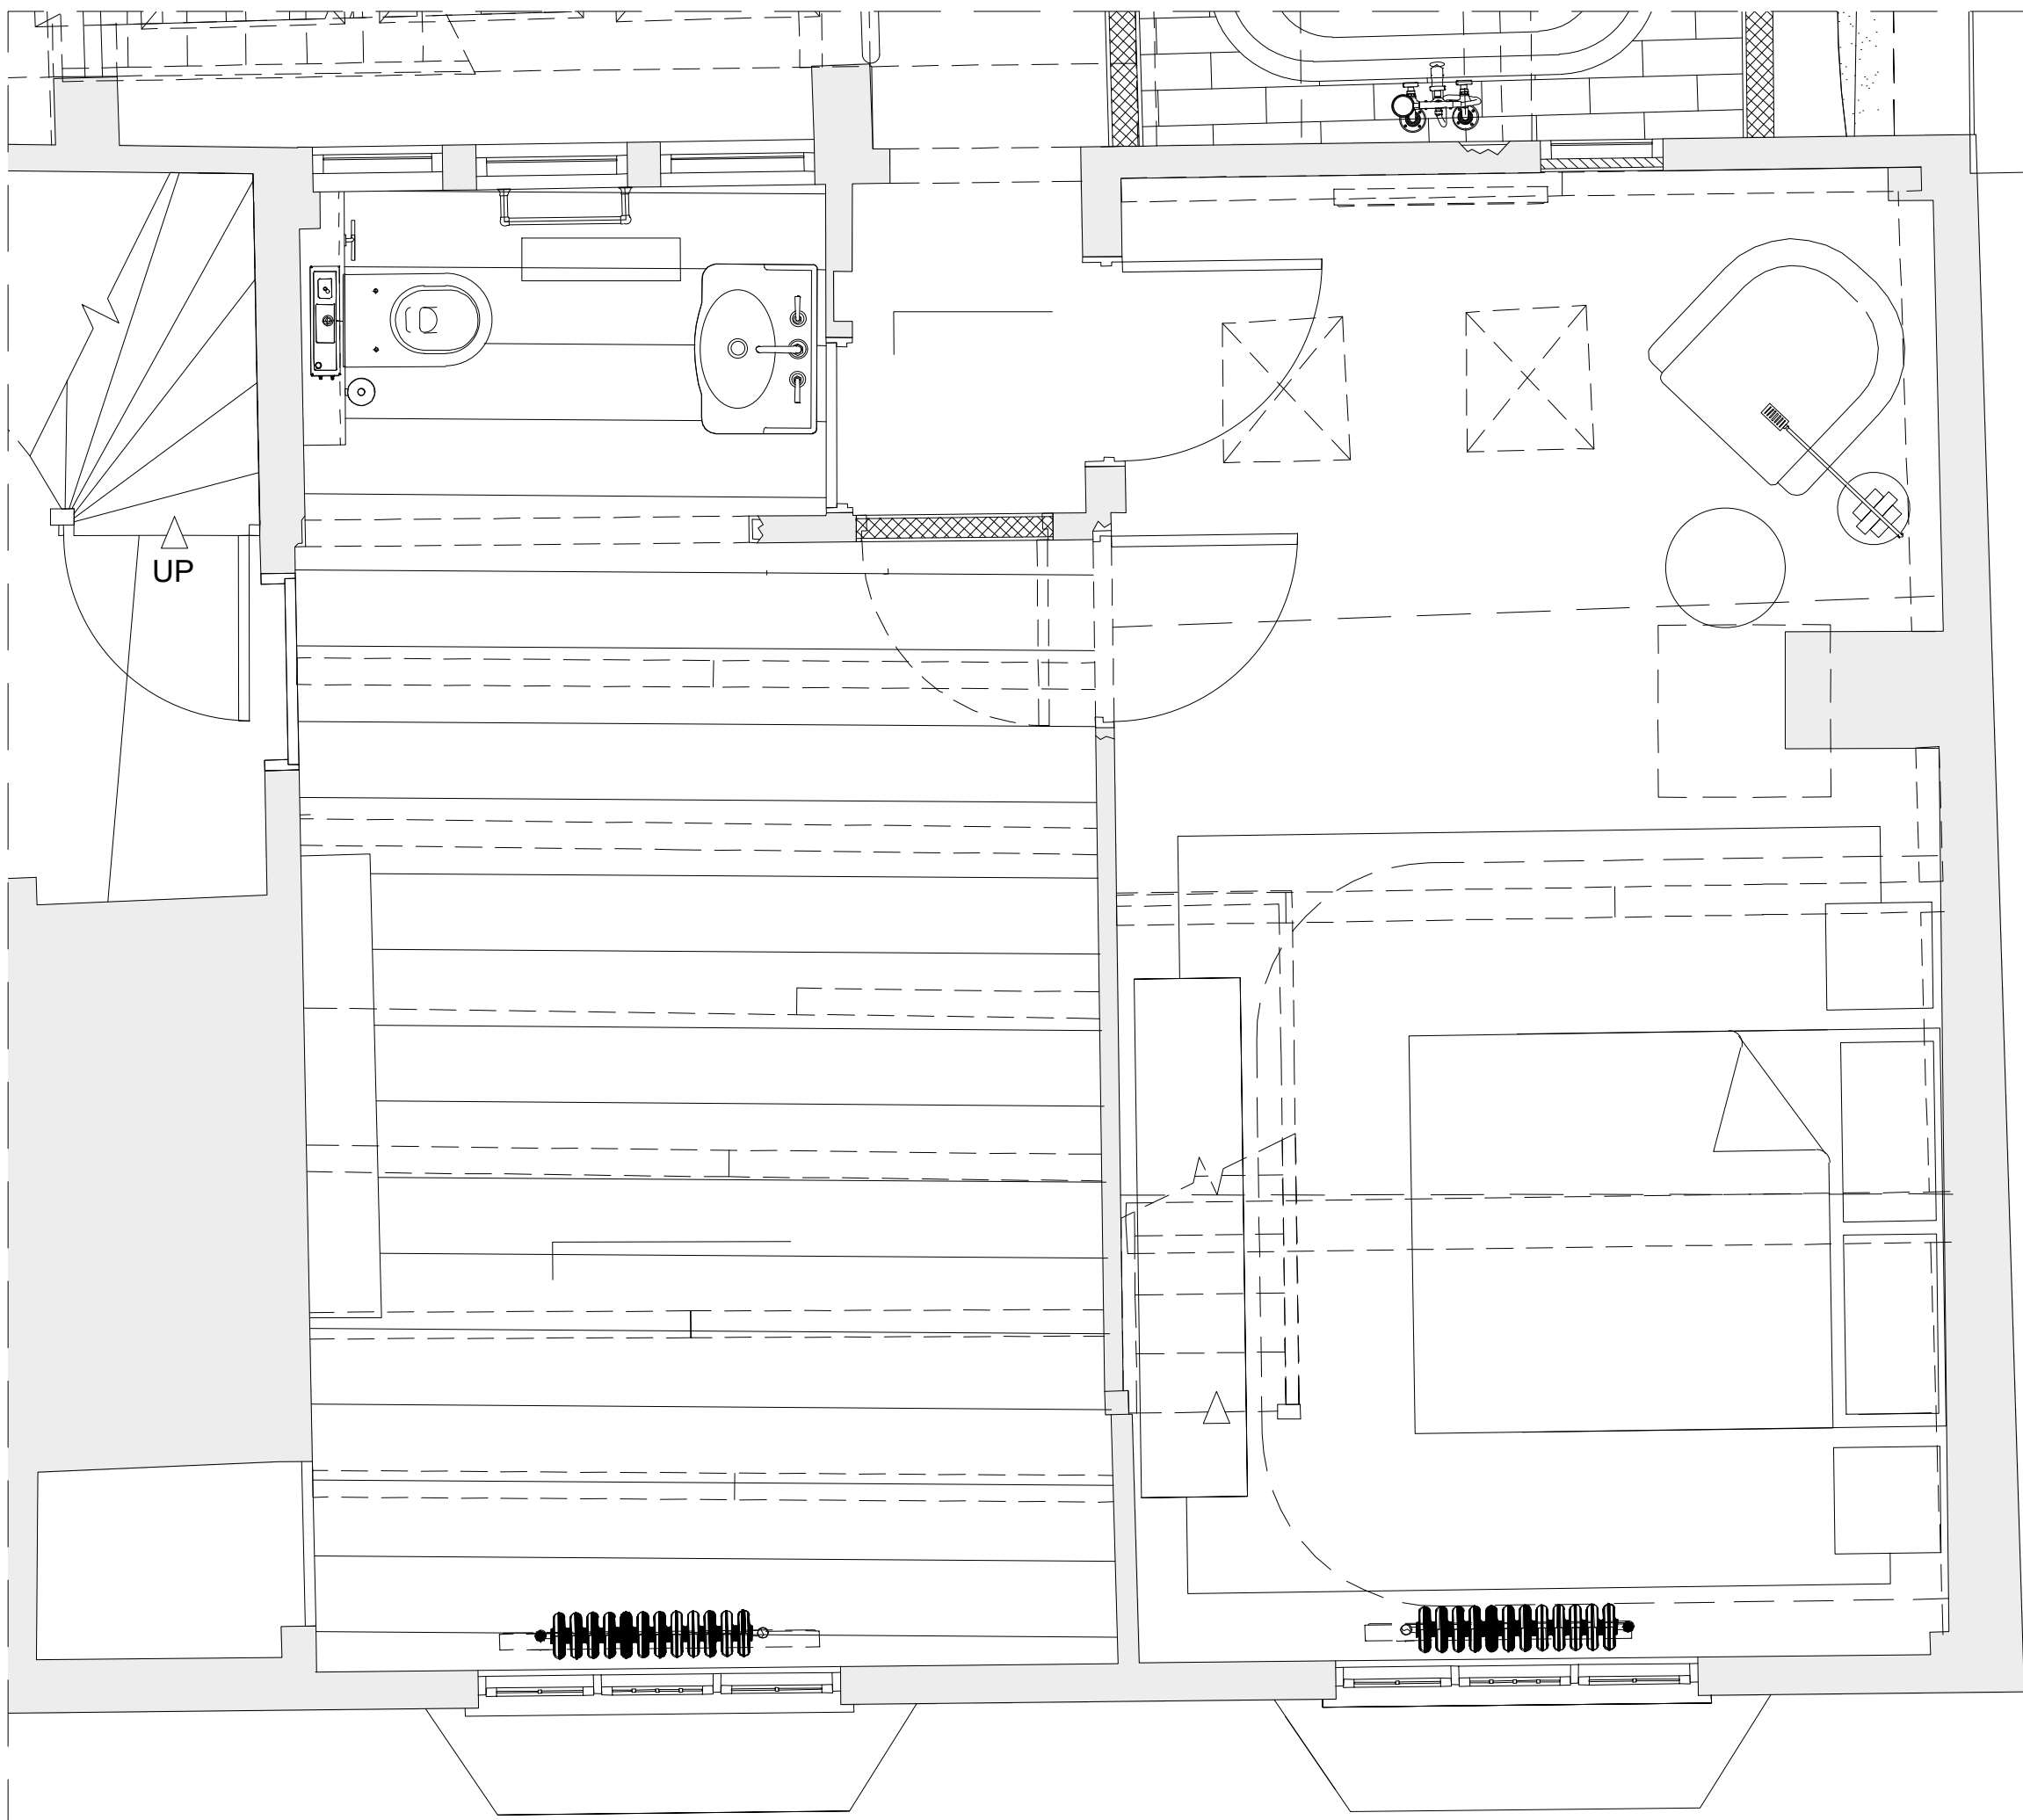

Approved Scheme First Floor Plan
Scale 1:25@A1
1:50@A3

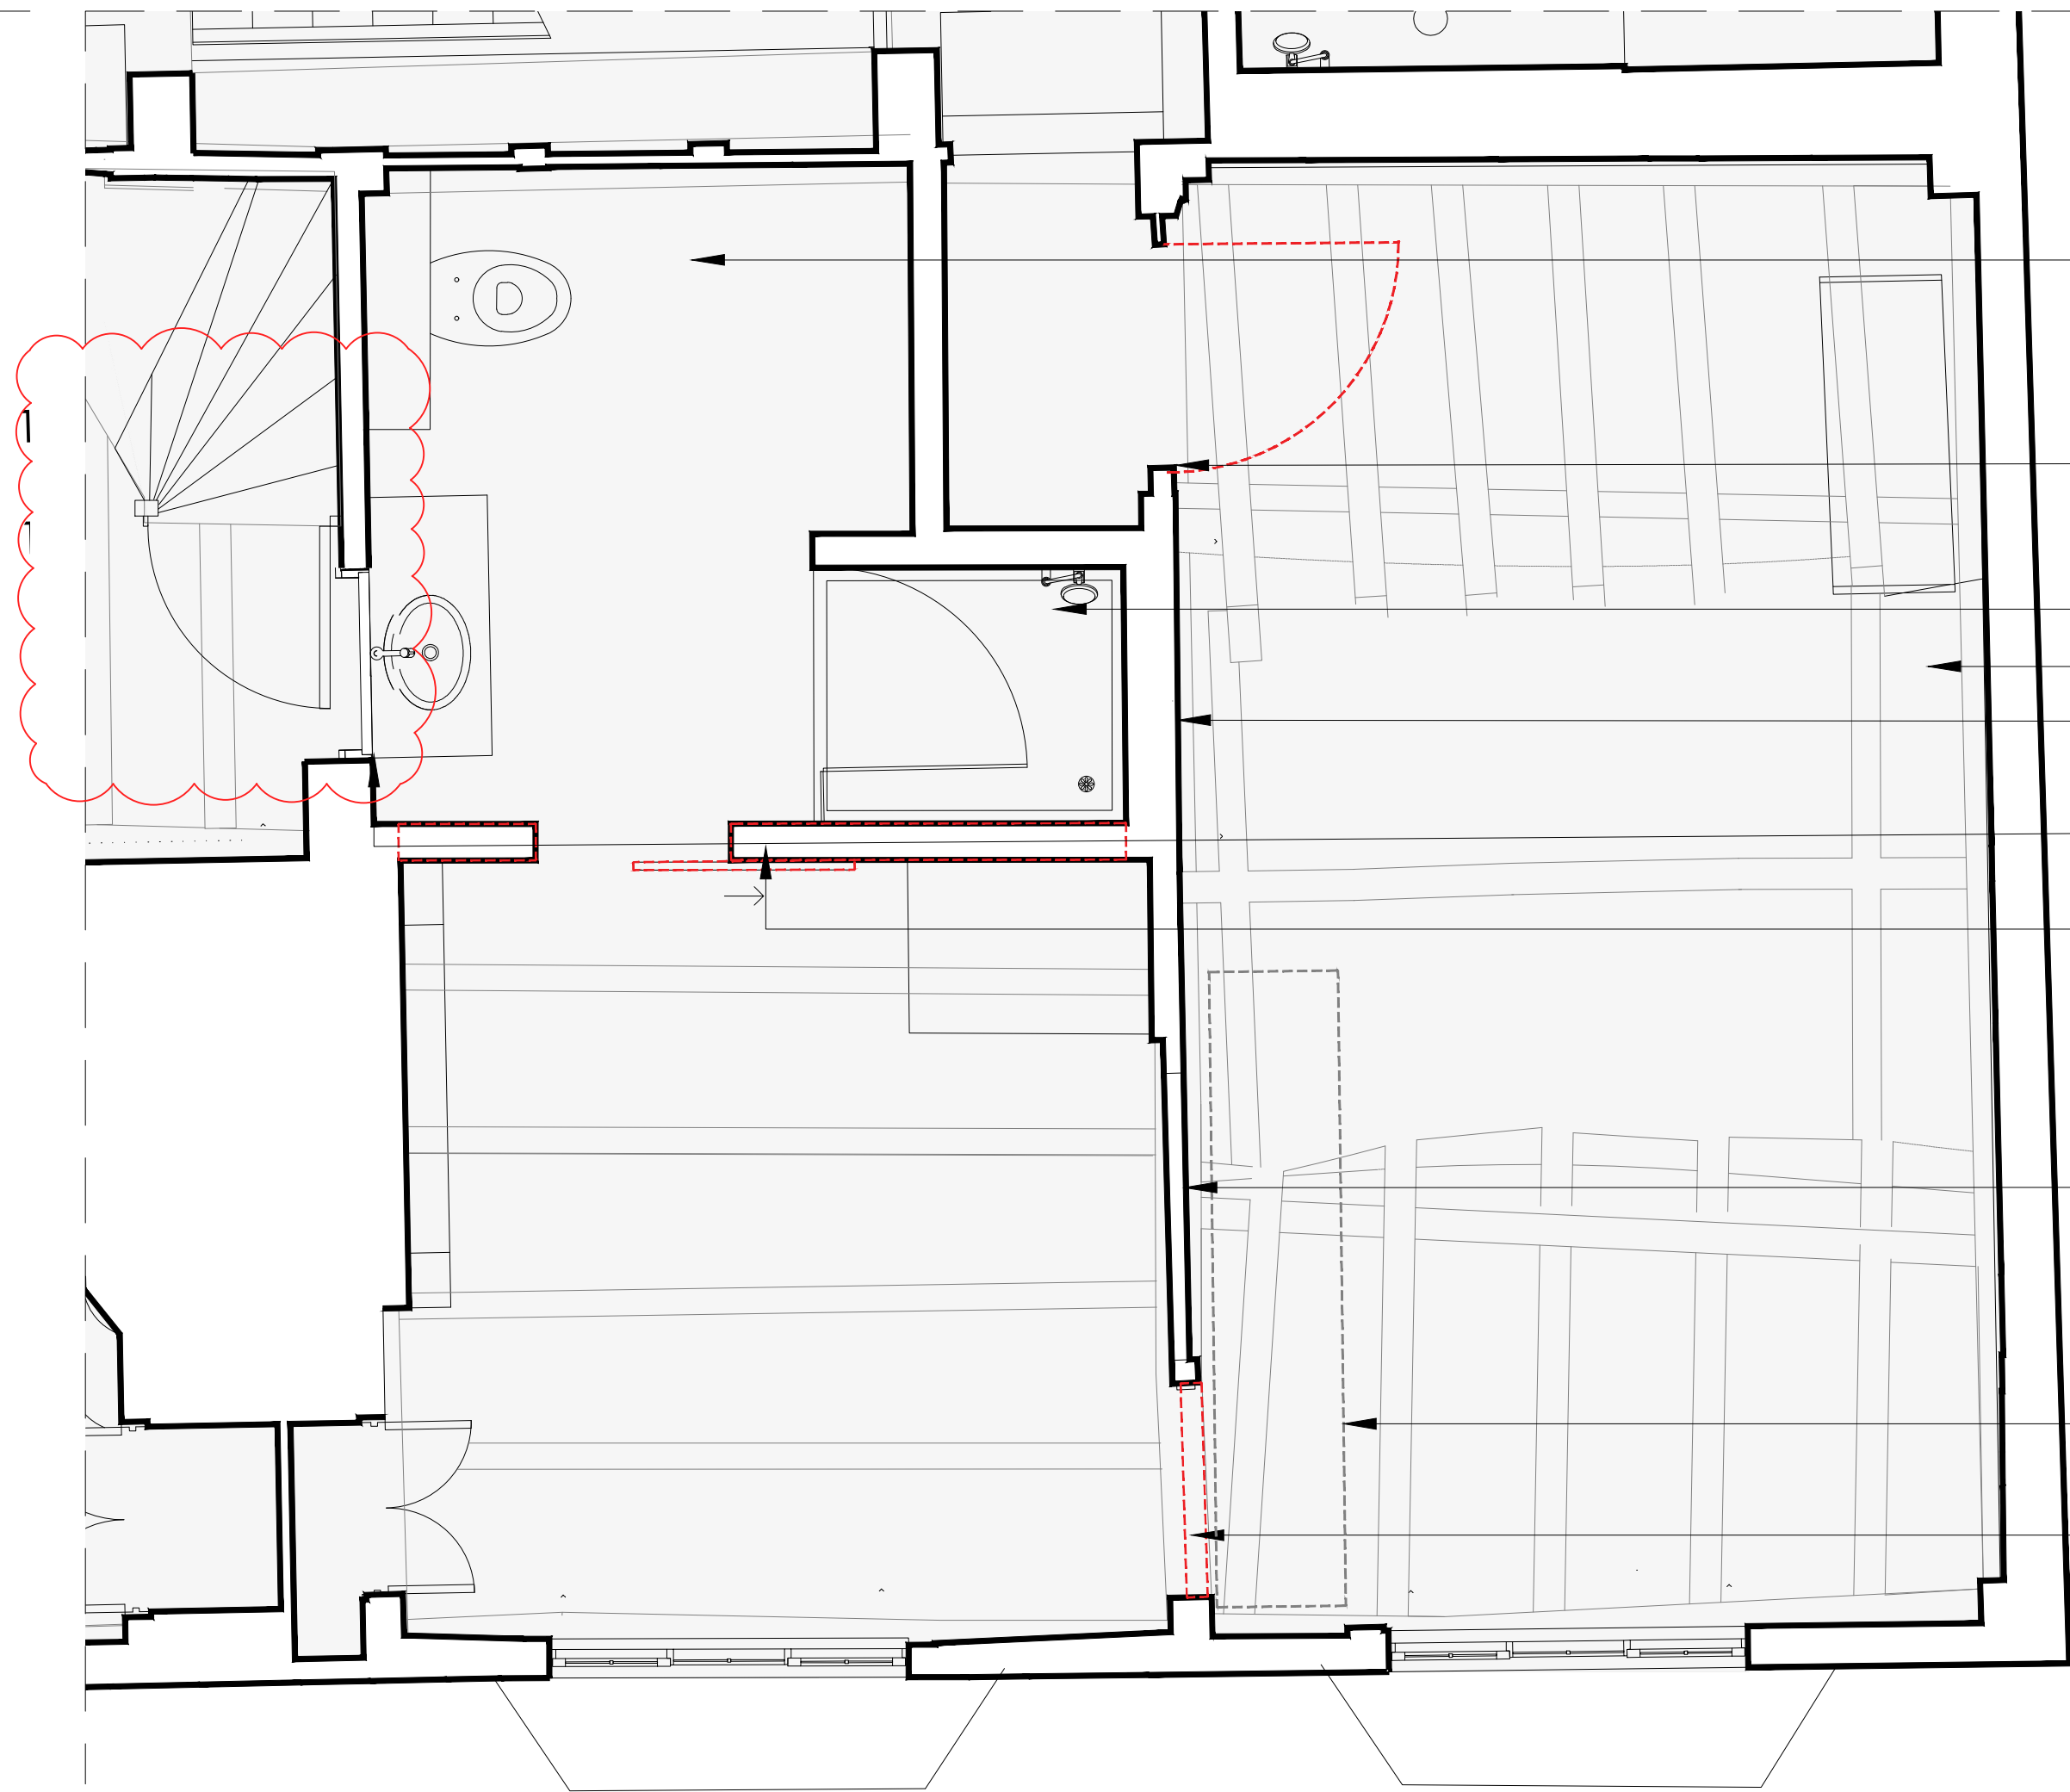


Proposed First Floor Plan
Scale 1:25@A1
1:50@A3

- Altered bathroom layout
- Approved opening and door - not implemented
- New shower cabin
- Chimney removal, refer to details 5005, 5006
- Approved door opening omitted, original timber frame retained
- Door reinstated, refer to detail 5013
- New partition wall and re-instated sliding door enclosing en-suite
- Lime plaster infill paneling reinstated
- Existing staircase removed as approved
- Modern infill paneling removed, timber framing retained in-situ, exposed and restored



Northern bedroom - view towards wall with removed infill paneling and retained timber framing

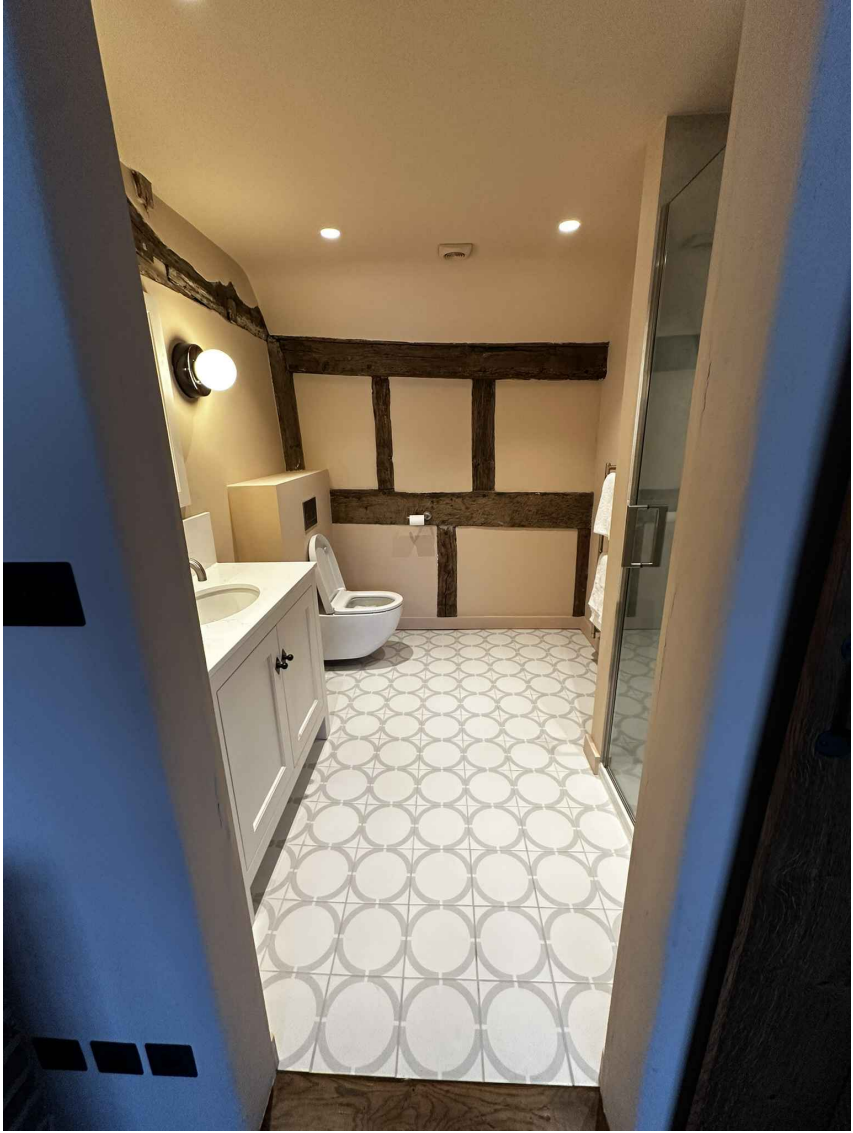

Northern bedroom - new partition wall and sliding door to en-suite

KEY:
Highlighted difference between Approved Scheme and 'As-Built'/Proposed Scheme

Rev.	Comments	By:	Date:
A	Amendments as clouded.	KN	Nov 25
B	First floor staircase access door reinstated	KN	Feb 25

Do not scale this drawing. All dimensions must be checked on site.
All rights reserved. No reproduction in any material form is permitted without consent.

**LISTED BUILDING
CONSENT**

Client:
Mr. Simon Dougall

Project Title:
107 High St, Lindfield, Haywards Heath, West Sussex, RH16 2HR

Drawing Title:
Detail Drawings:
First Floor Layout Changes - North Bedroom

Scale:
1:25@A1
1:50@A3

Date:
Mar 25

Drawn:
KN

Checked:
KW

kyson

Studio

28 Scrutton Street
London
UK
EC2A 4RP

T: +44(0) 20 7247 2462
E: enquiries@kyson.co.uk
W: www.kyson.co.uk

Project No.:
900-25

Drawing No.:
5018

Revision:
B

