



Boundary

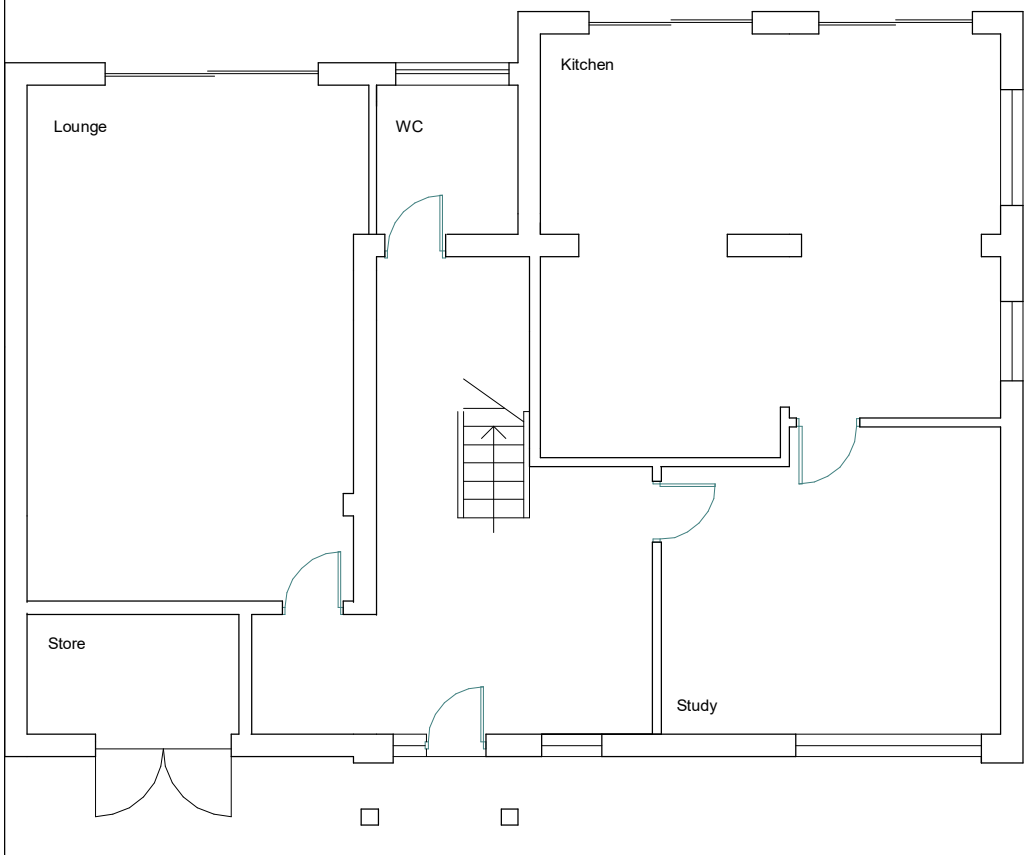

Ground Floor



1:100

Boundary

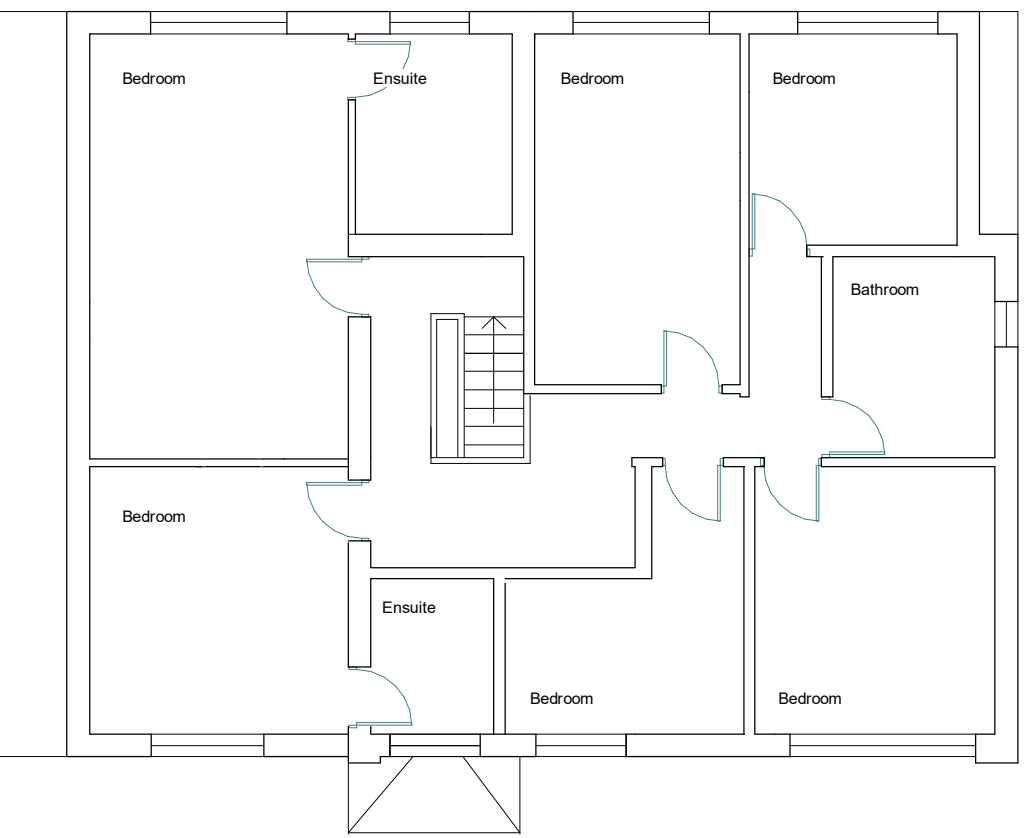

First Floor

1:100

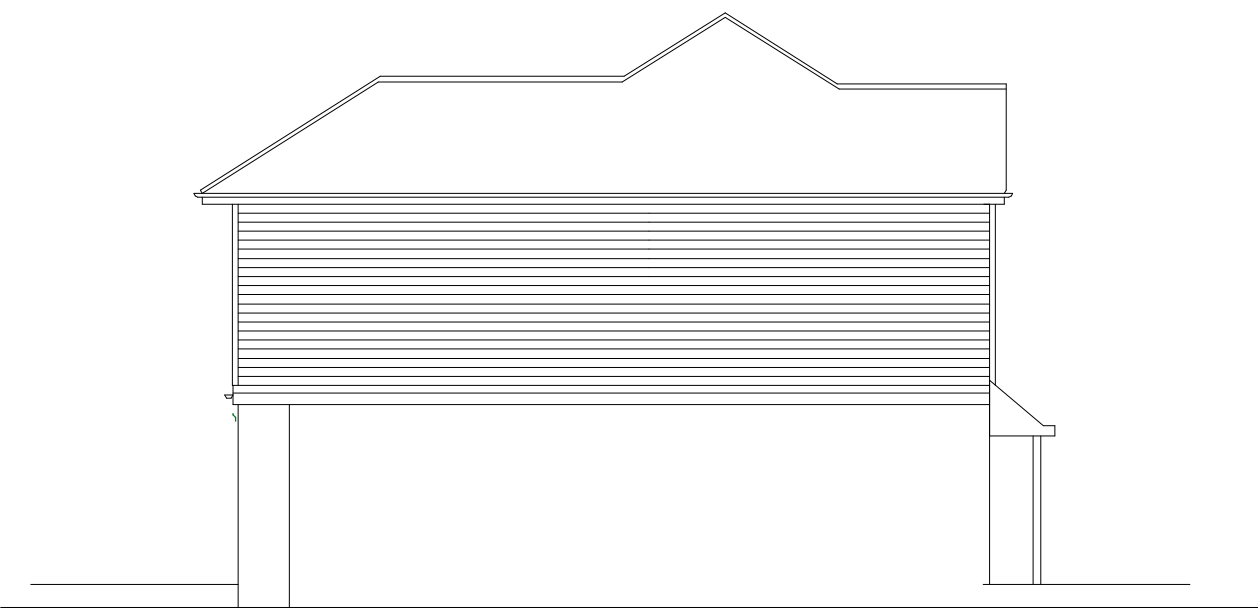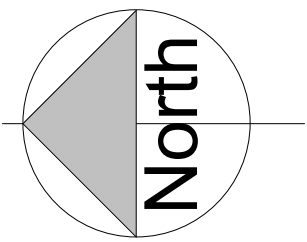


Side - South

1:100



Front - West

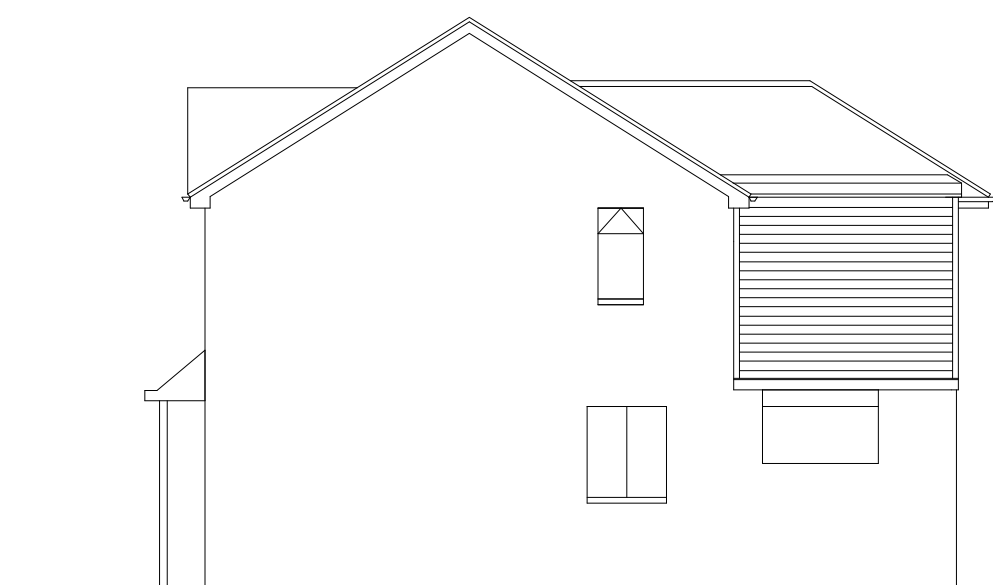


Side - North



Rear - East

Revisions

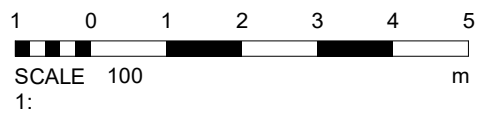

Materials

Drawing Number	2025/71	Sheet	1 of 1
----------------	---------	-------	--------

Size	A1	Scale	1:100
------	----	-------	-------

Project	As built April 2025
---------	------------------------

Job Title	43 Wilderness Road Hurstpierpoint West Sussex BN6 9XD
-----------	--

Do Not scale from this drawing except for planning as photocopies will be subject to distortion
Drawings to be read in conjunction with all other Designers and structural engineers contract drawings and specifications: Any discrepancies must be brought to the attention of the Designer immediately.
The contractor must verify all dimensions by site measurement before ordering materials or manufacturing components
Substitute materials and products to those named will be acceptable if proven to be of equal or higher performance and not in conflict with other elements

M.J.Humphrey
Ltd



Mel Humphrey MRICS 9 Aldsworth Avenue Goring By Sea West Sussex BN12 4XQ	Adam Humphrey MCIOB 21 Pendine Avenue Worthing West Sussex BN11 2NA
Mel@mjhumphrey.co.uk 07701055182	Adam@mjhumphrey.co.uk 07812419142