




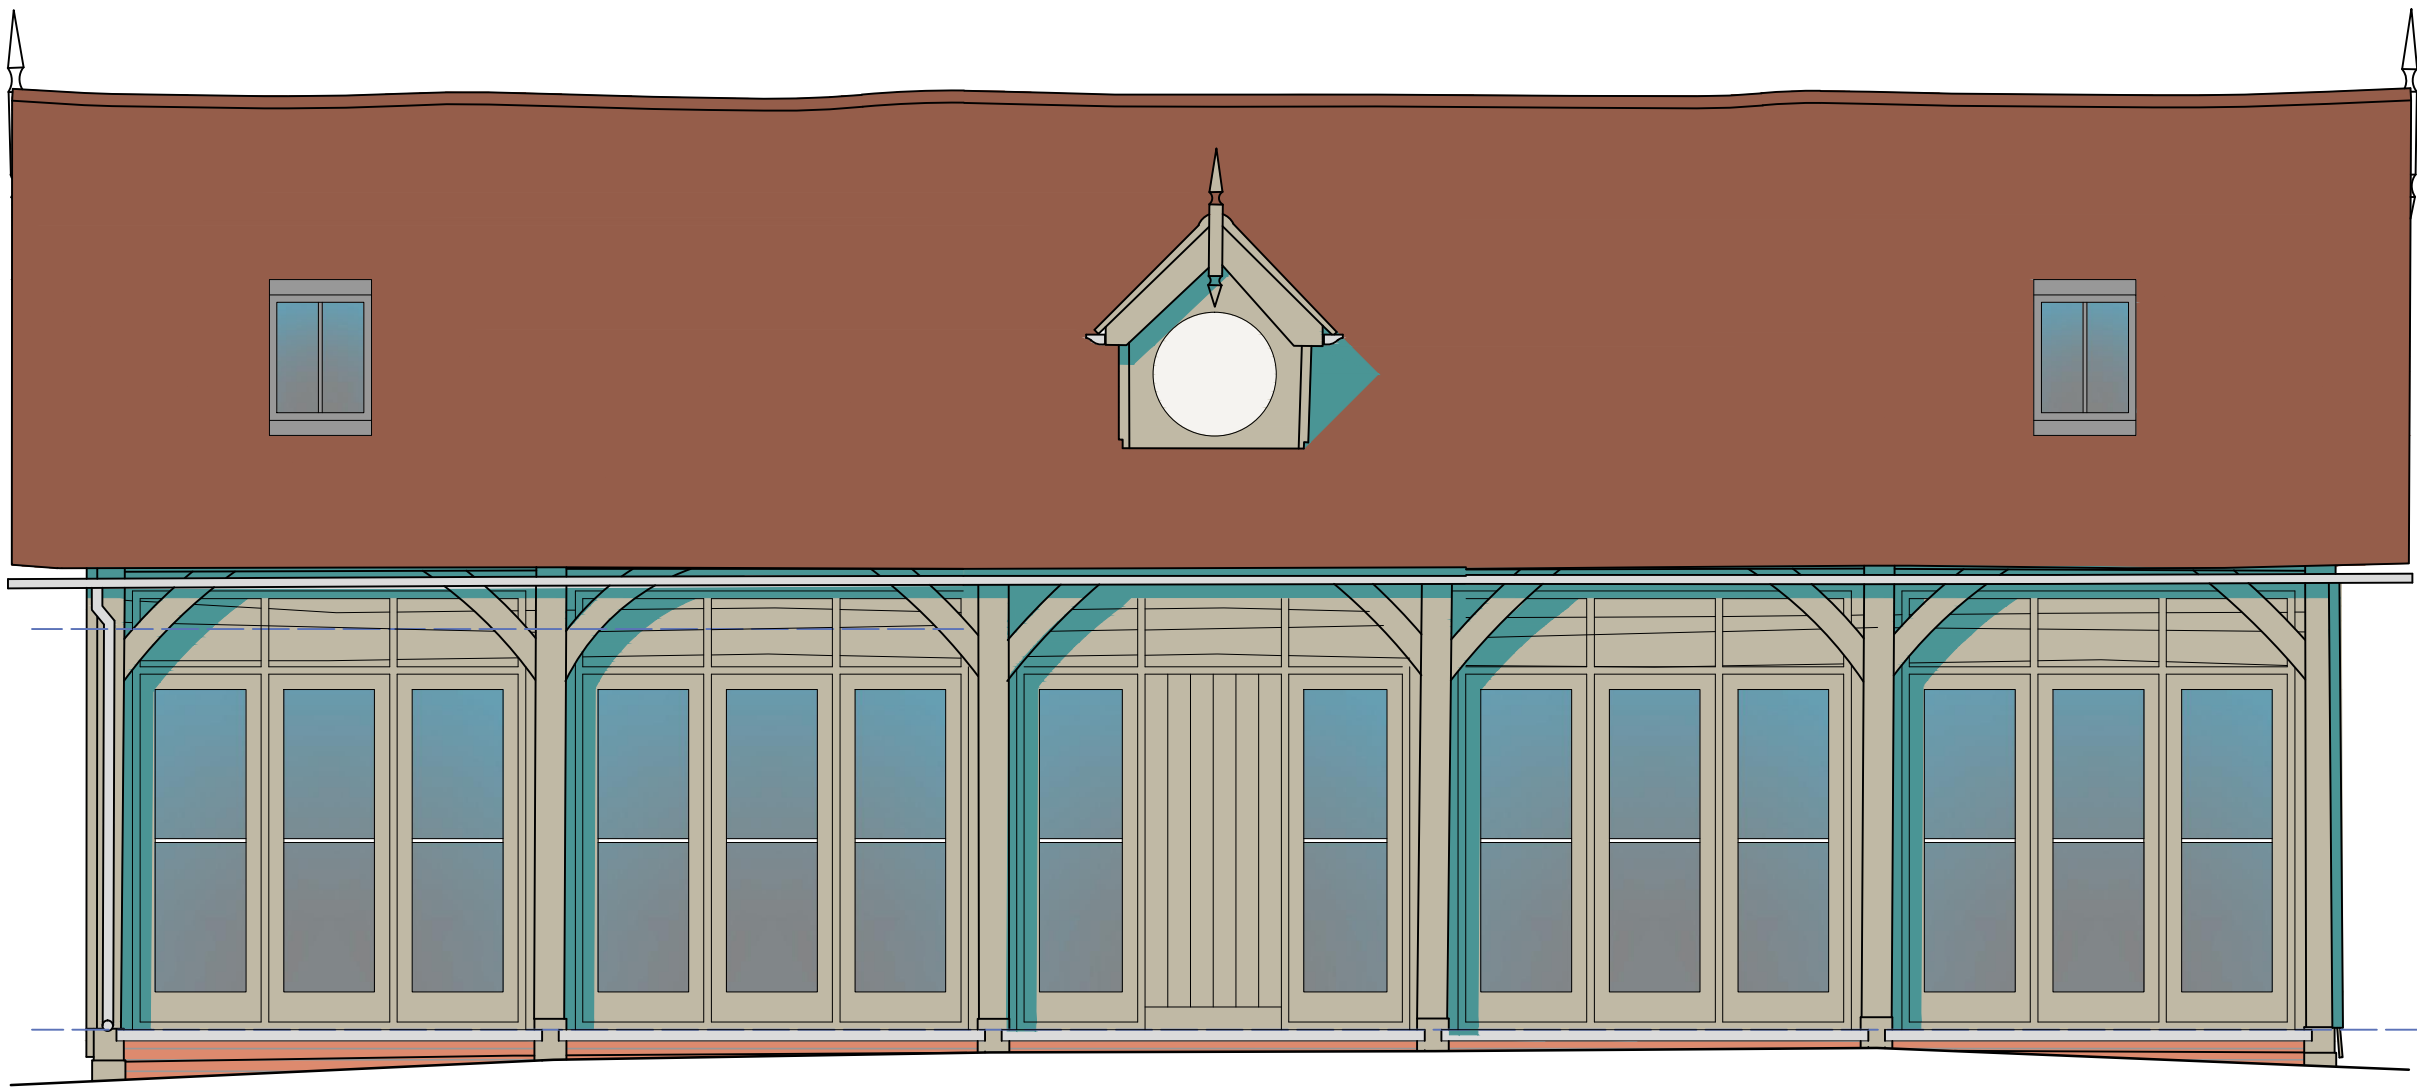


Existing / As built Eastern elevation Scale 1:50 @A1

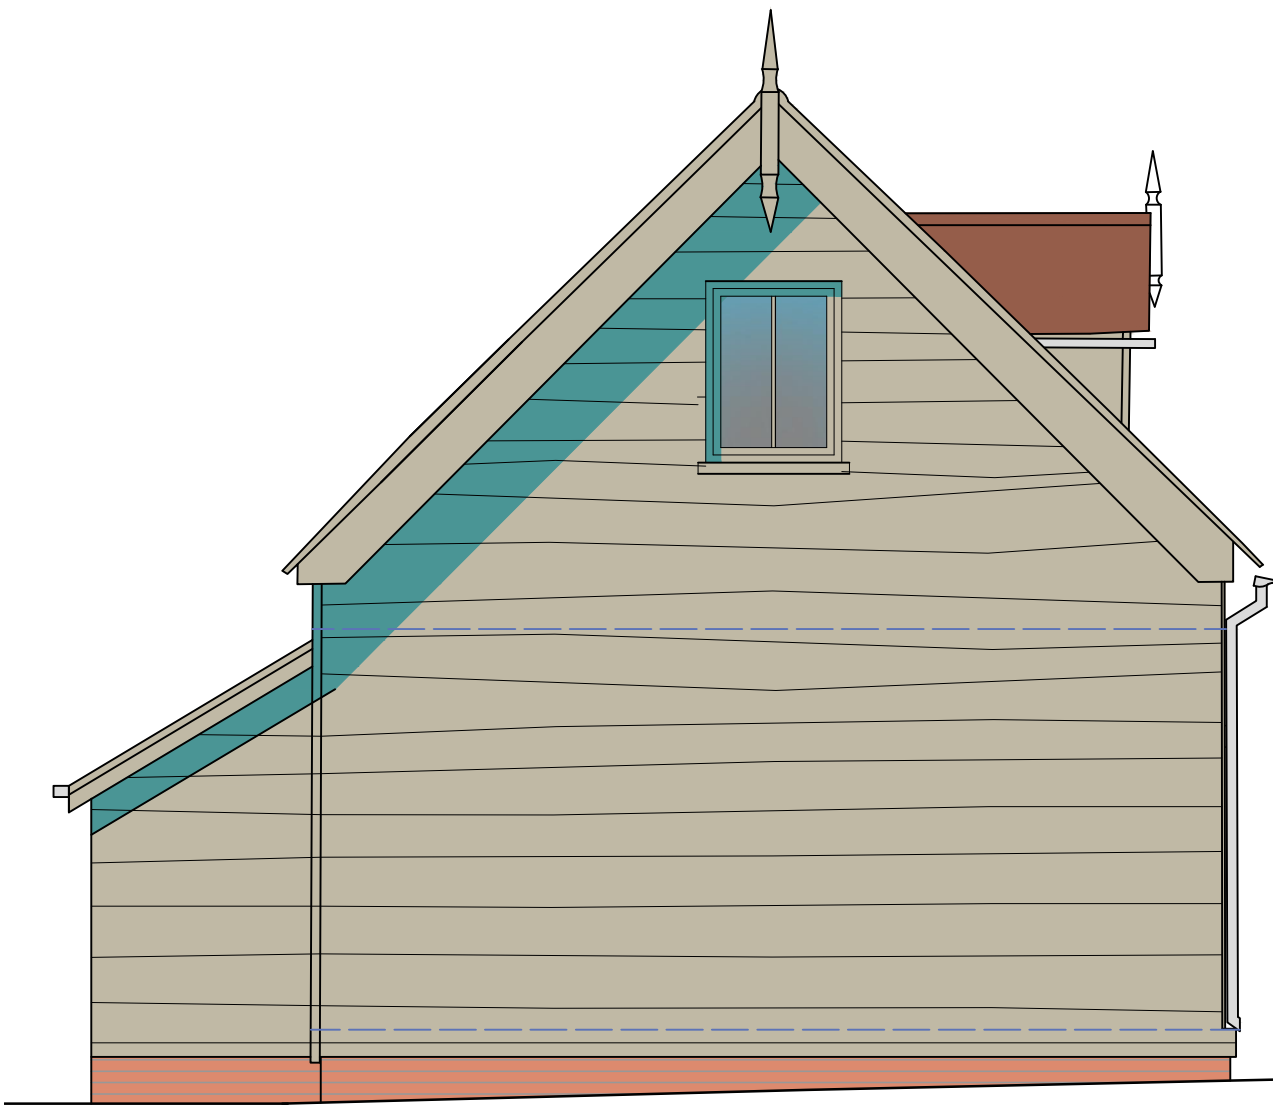


Existing / As built Southern elevation Scale 1:50 @A1

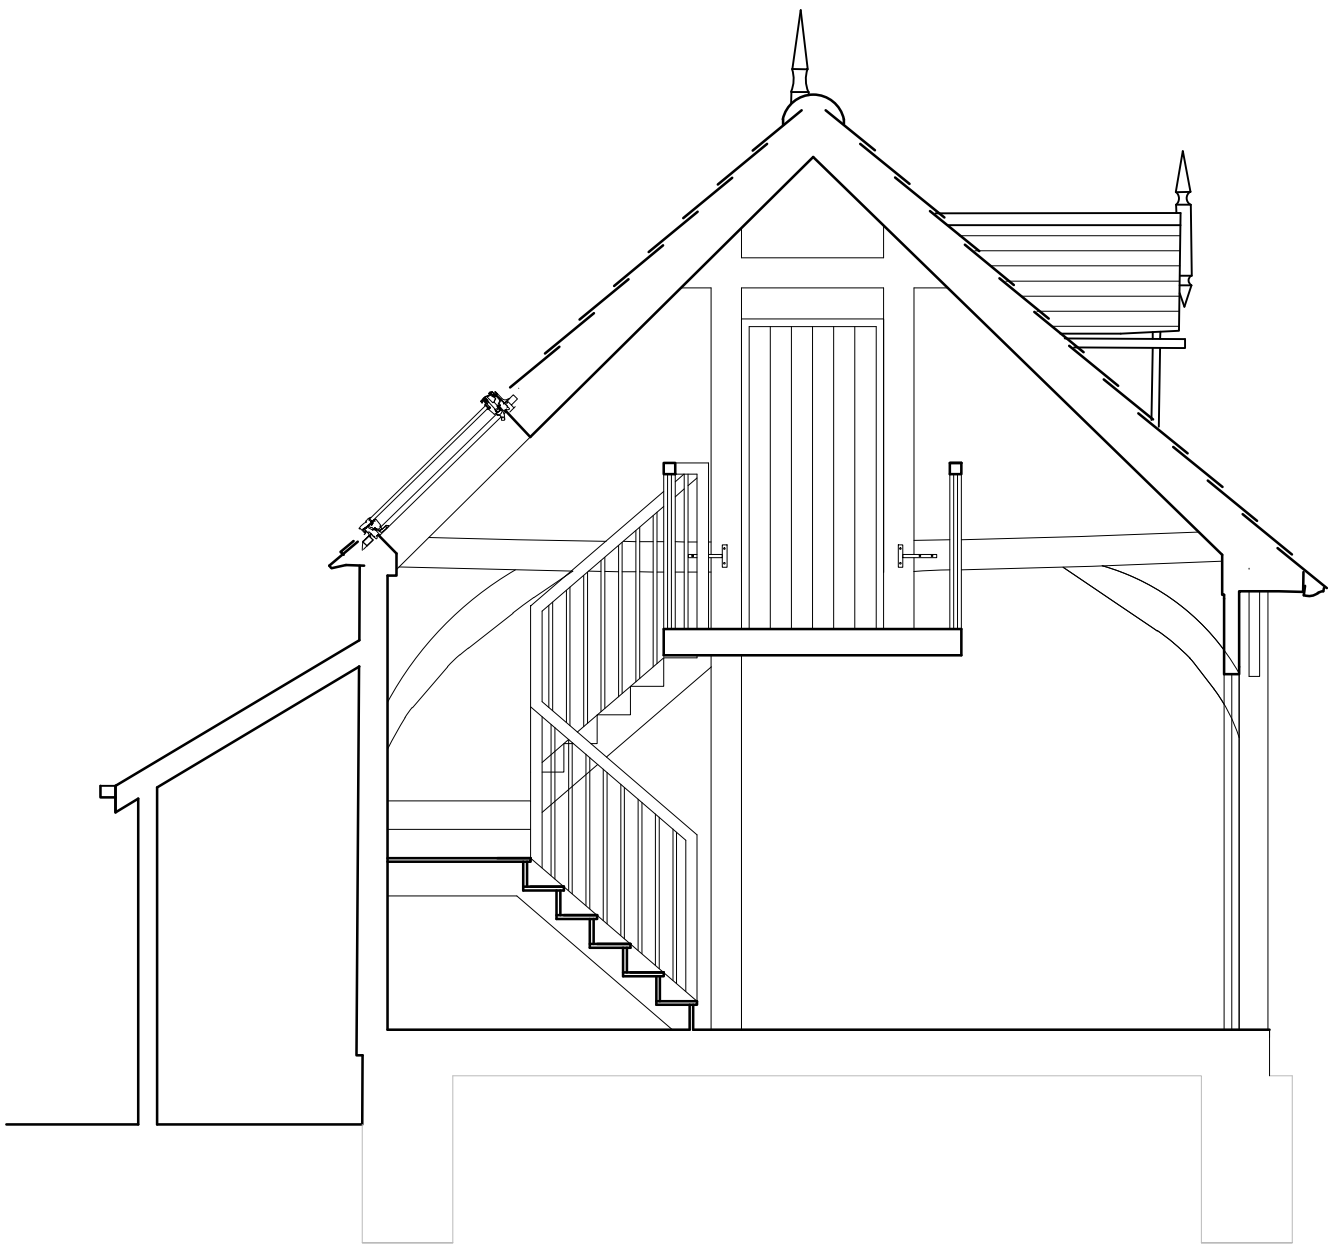


Existing / As built Section AA Scale 1:50 @A1

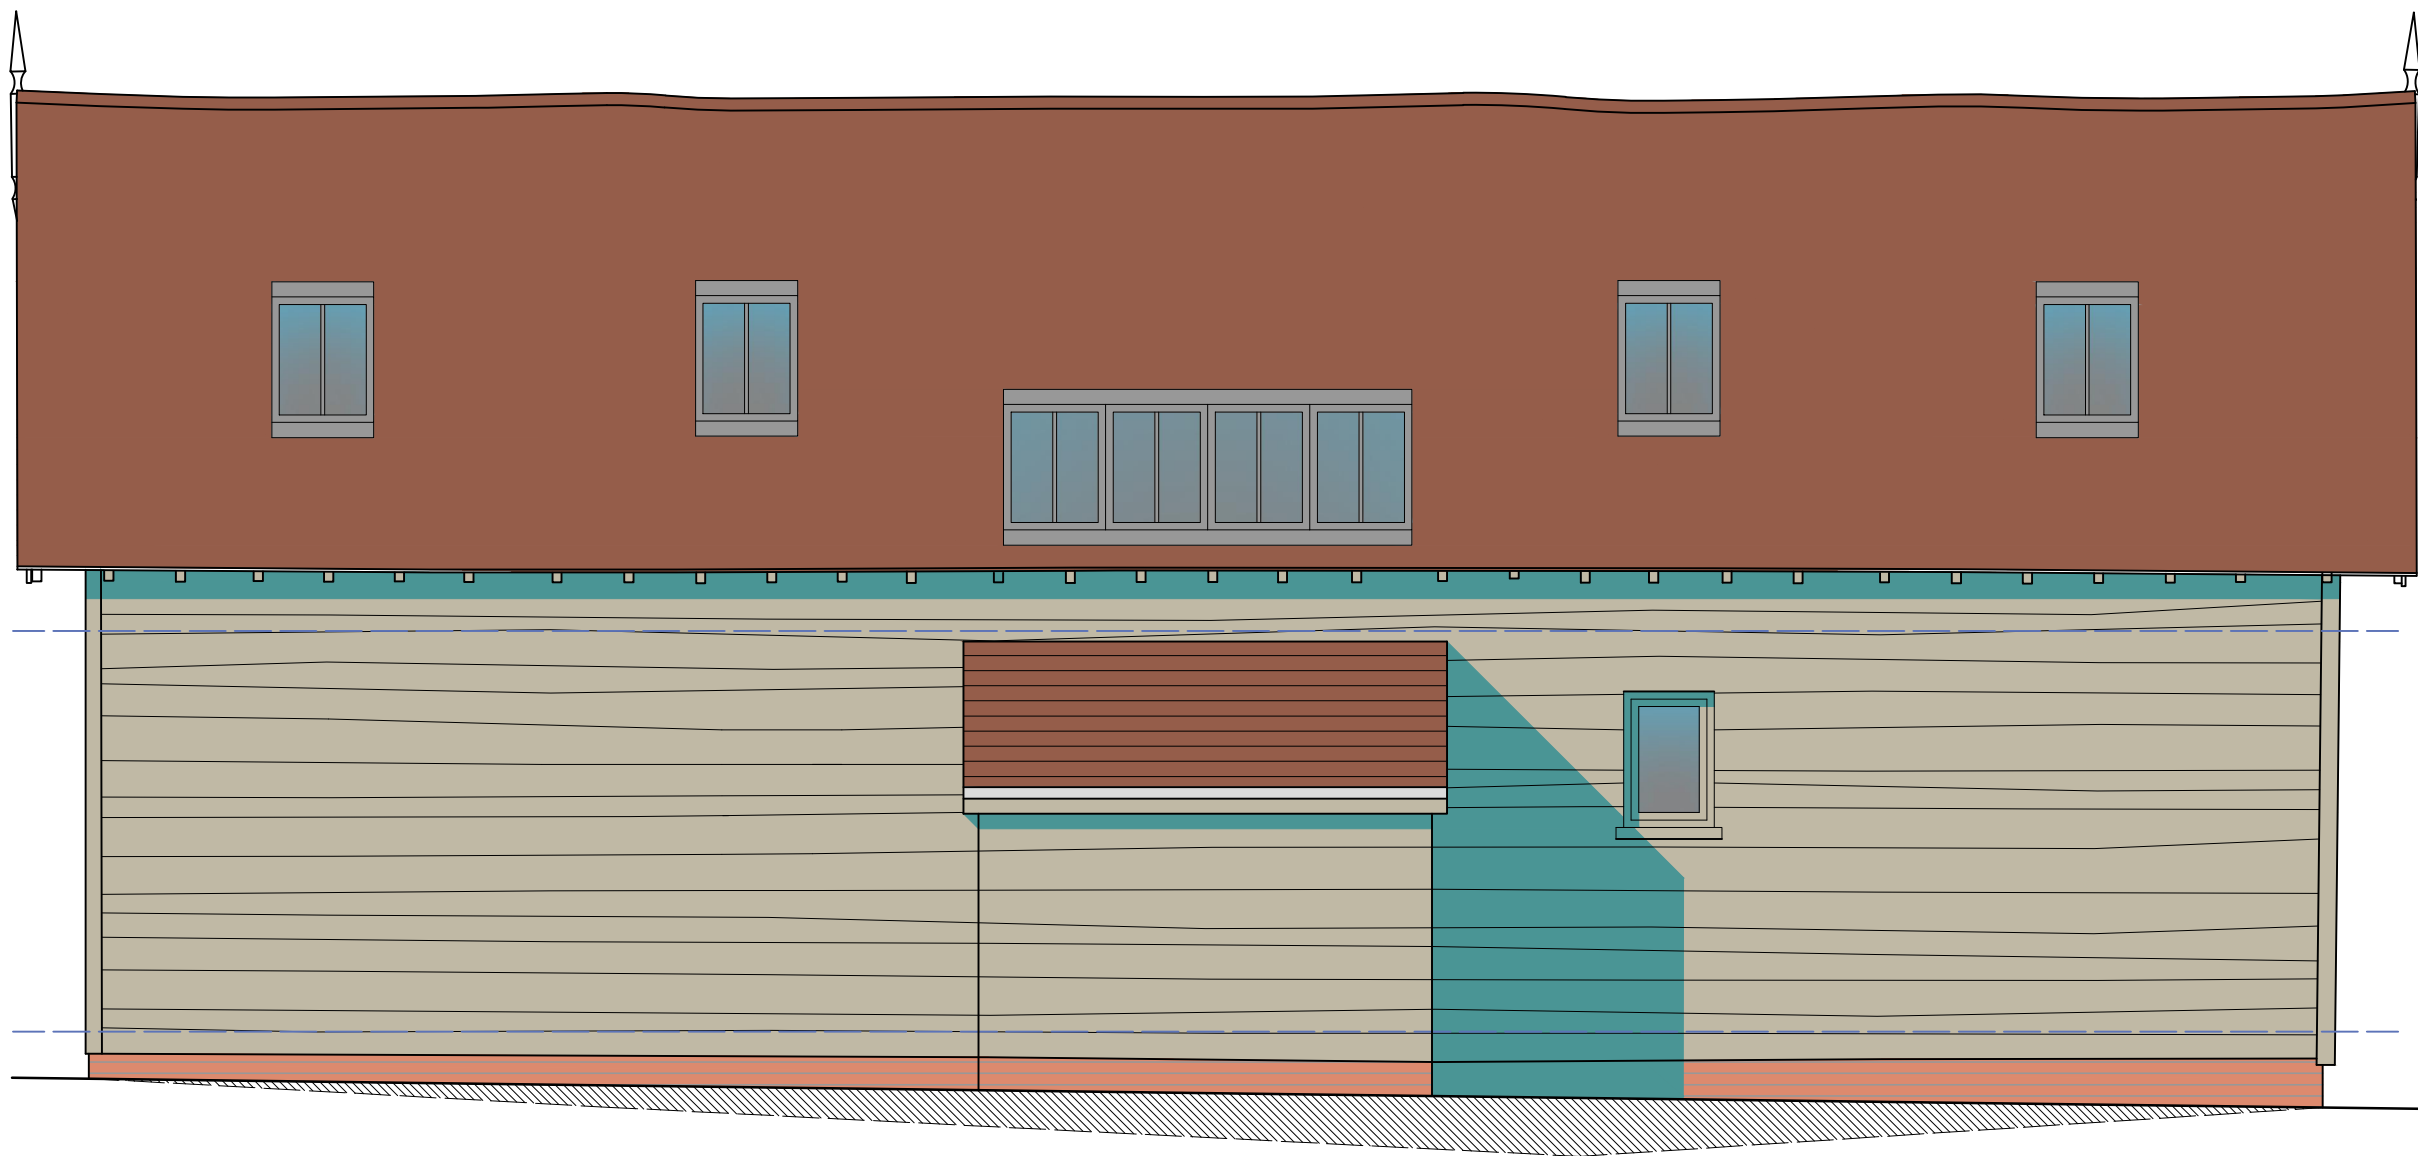




Existing / As built Western elevation Scale 1:50 @A1

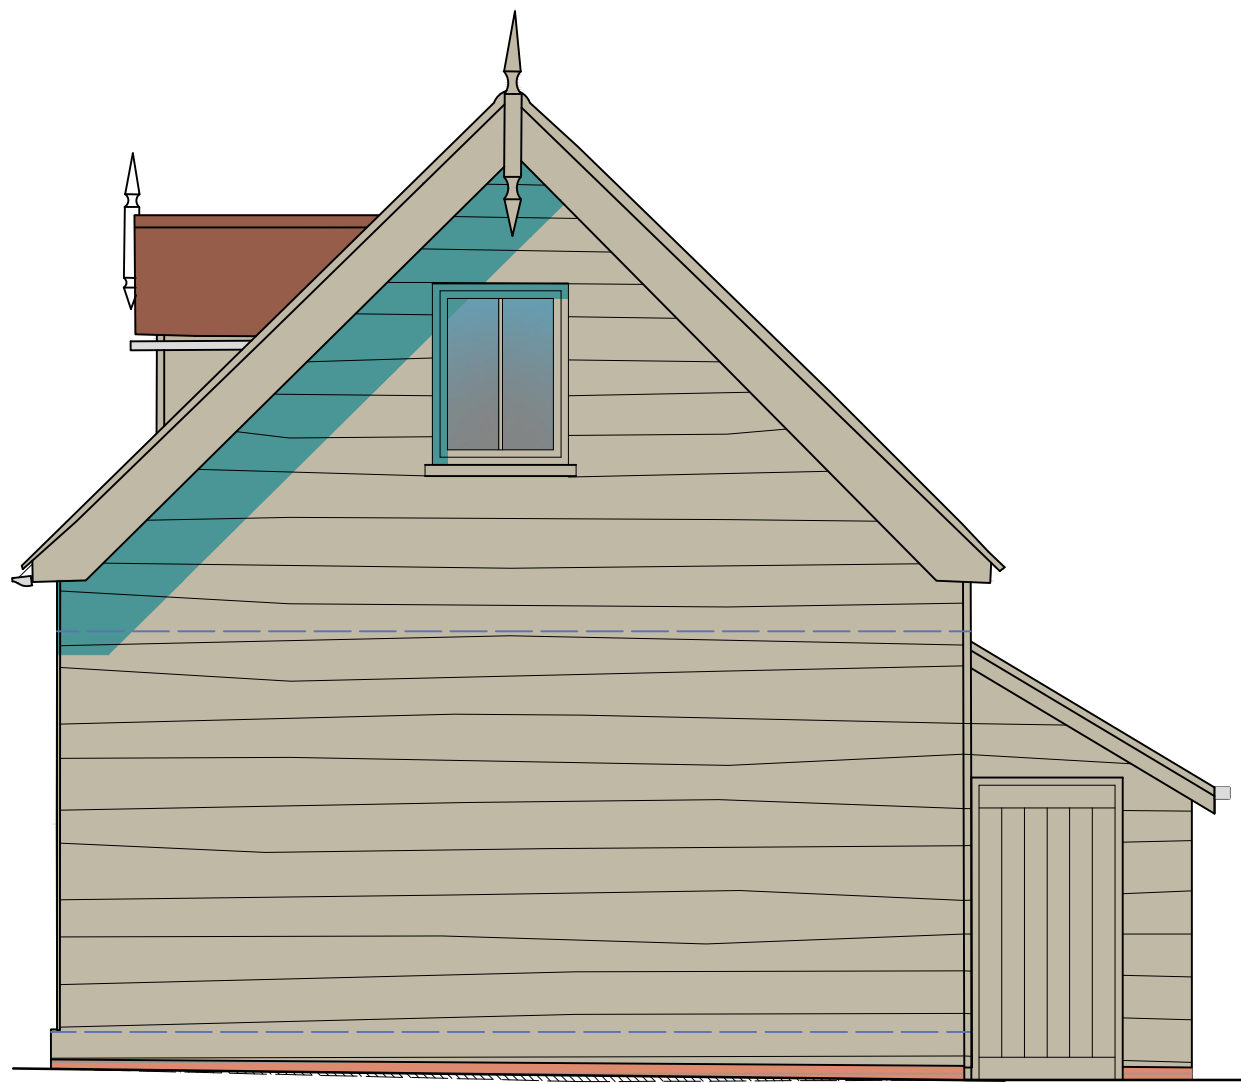

Existing / As built Northern elevation Scale 1:50 @A1

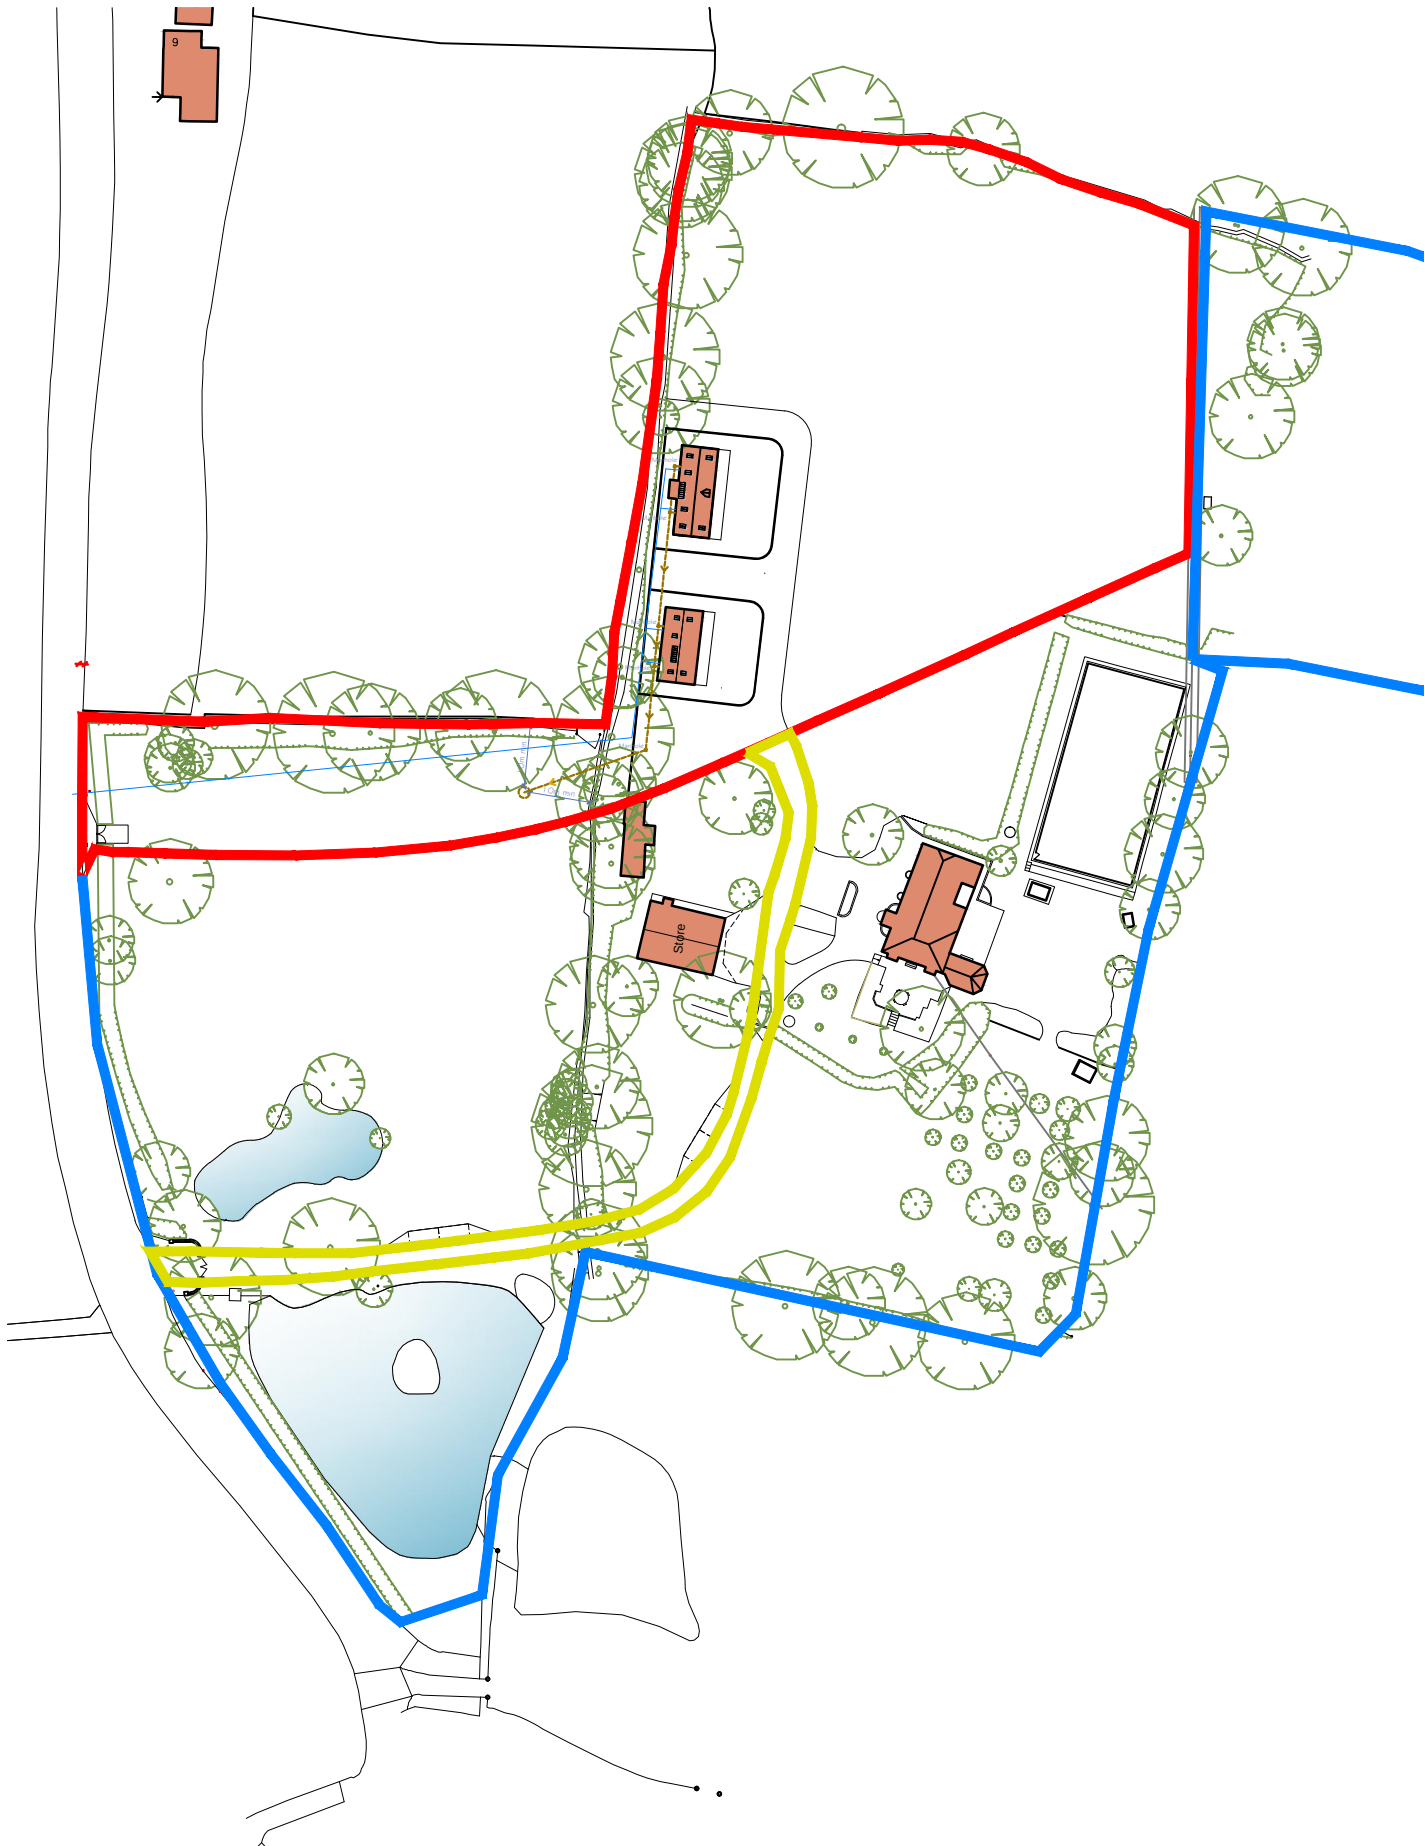

Existing Location Plan Scale 1:1250 @A1

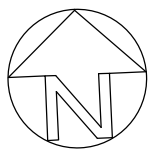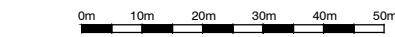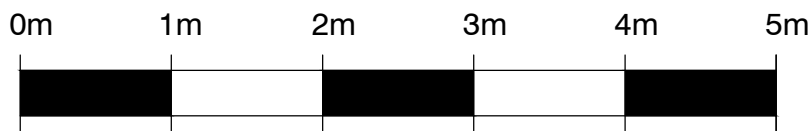

Reapplication set - 100425

rev.	date		

Client: Mr & Mrs Perver Project: Barn extension, Providence Farm, Warminglid

Drawing: Existing / as-built elevations, sections & Plan Scale: 1:50 & 1:1250@A1 Date: Nov 2024

FRFC_Wrngld_O4_BR_EX_O2

No dimensions to be scaled from this drawing. All dimensions to be checked on site, and works completed by competent and qualified personnel.
This drawing is copyright and should not be reproduced without the permission of the Draftsman.

Fergus Carr, RIBA
ARB Reg No.089563F
07899995111
ferguscarr@gmail.com

Carr Architecture
Pear Tree Cottage, Circular Road
Seaview, Isle of Wight, PO34 5ET