




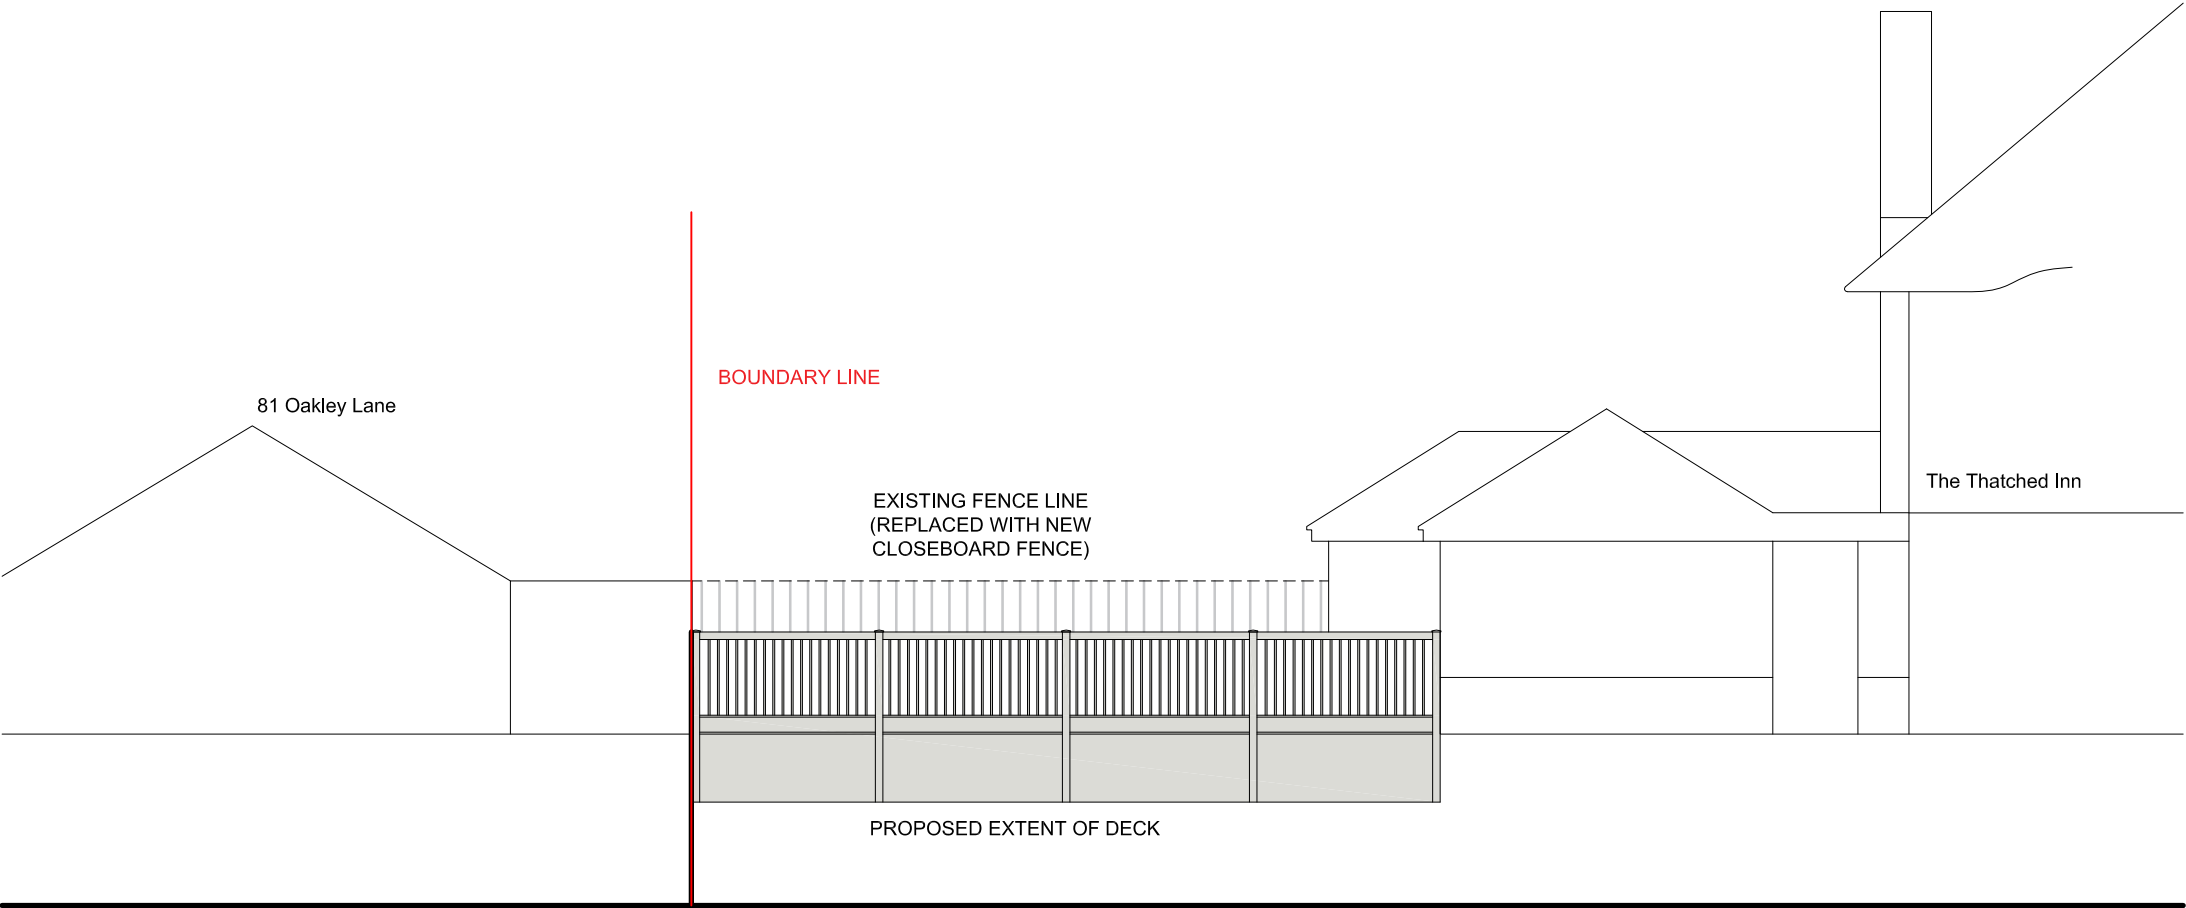

Proposed Elevation East (Oakley Lane)
SCALE 1:100

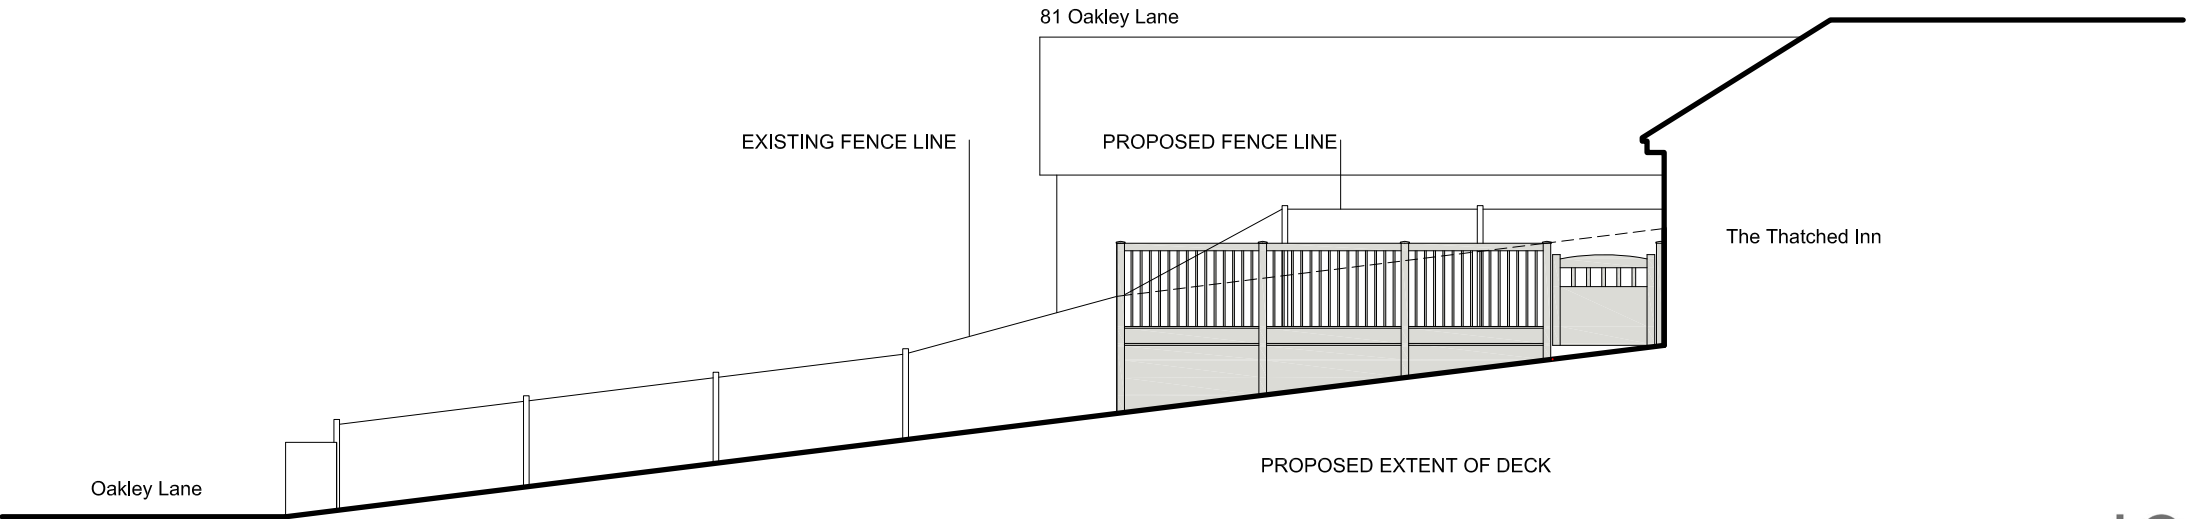

Proposed Elevation North
SCALE 1:100

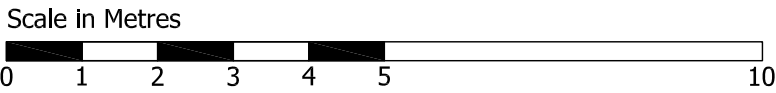

As Constructed - VIEW FROM DECK LOOKING WEST



As Constructed - VIEW OF EAST DECK BALUSTRADE



As Constructed - VIEW OF NORTH DECK BALUSTRADE

A	UPDATED ELEVATIONS	30/06/25	GE	BH
rev	description	date	dwn	chk

1 : 100 @ A3 | drawn : GE | check : BH | issued : 23/06/25



Client : James Fitzgerald	
Project : The Thatched Inn	
Drawing Name : Proposed Elevations	
Drawing No. : 25006-PA-006	Rev : A