



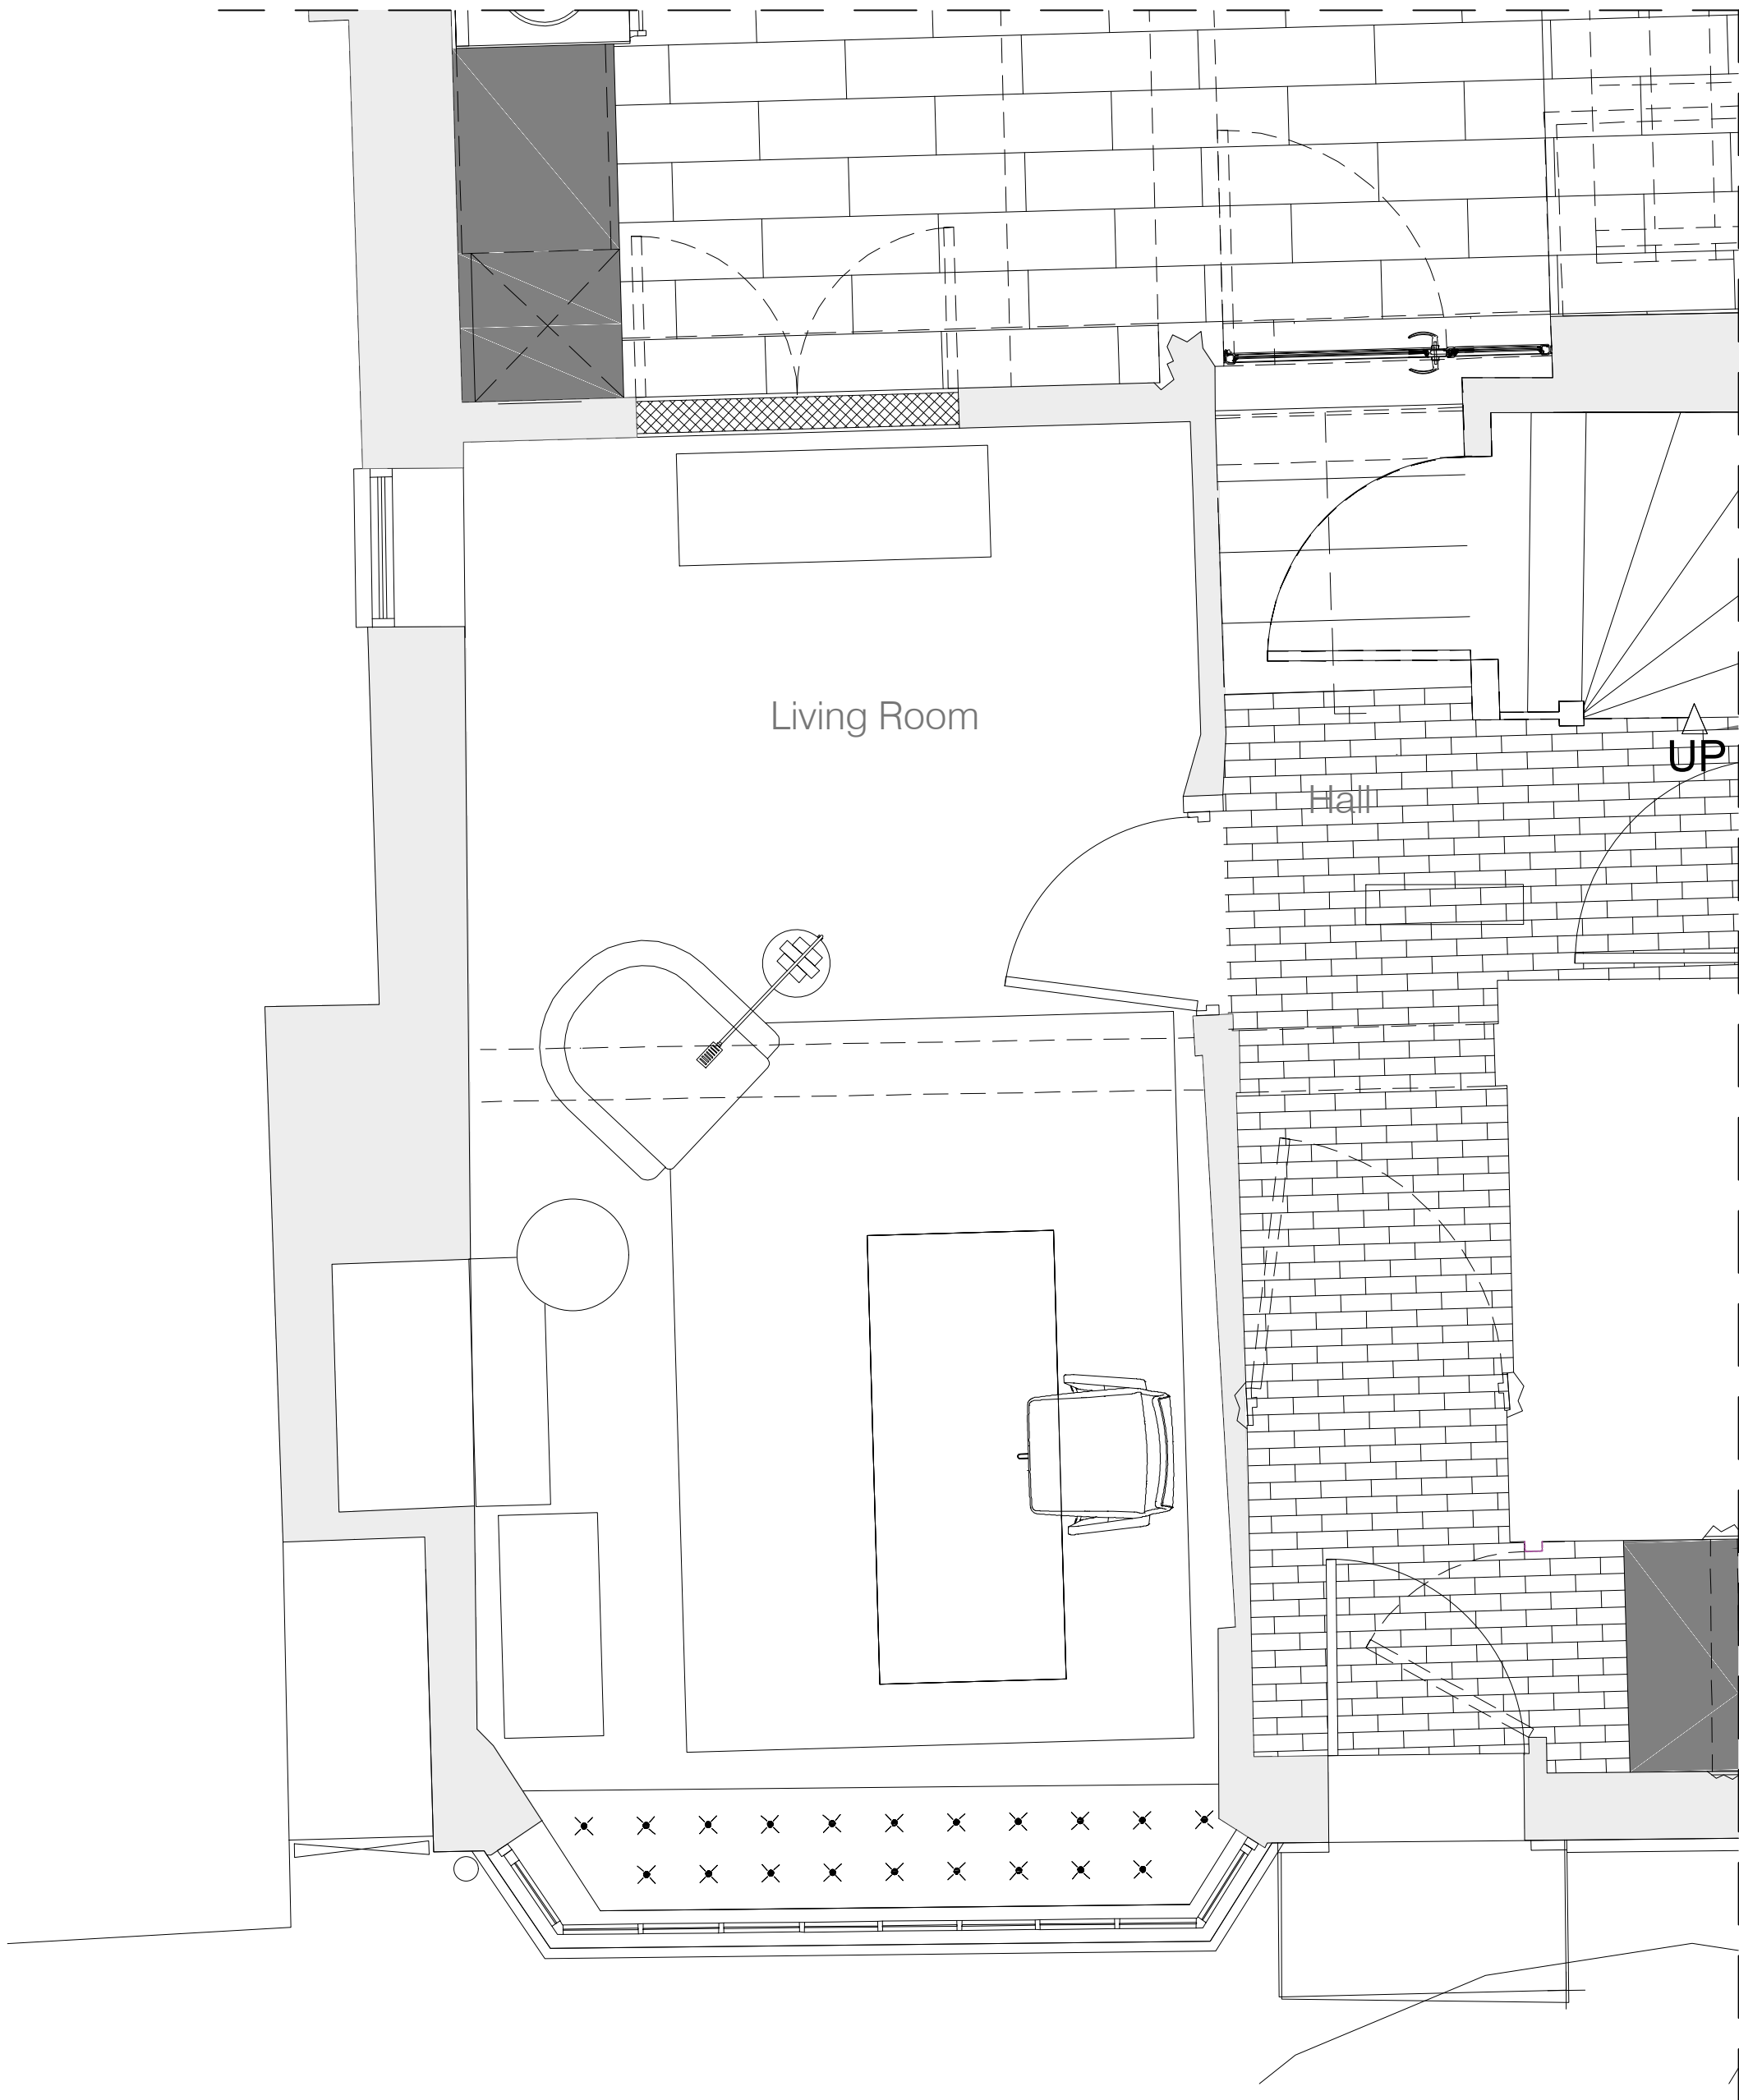


Approved Scheme
Ground Floor Plan
Scale 1:25@A1 , 1:50@A3

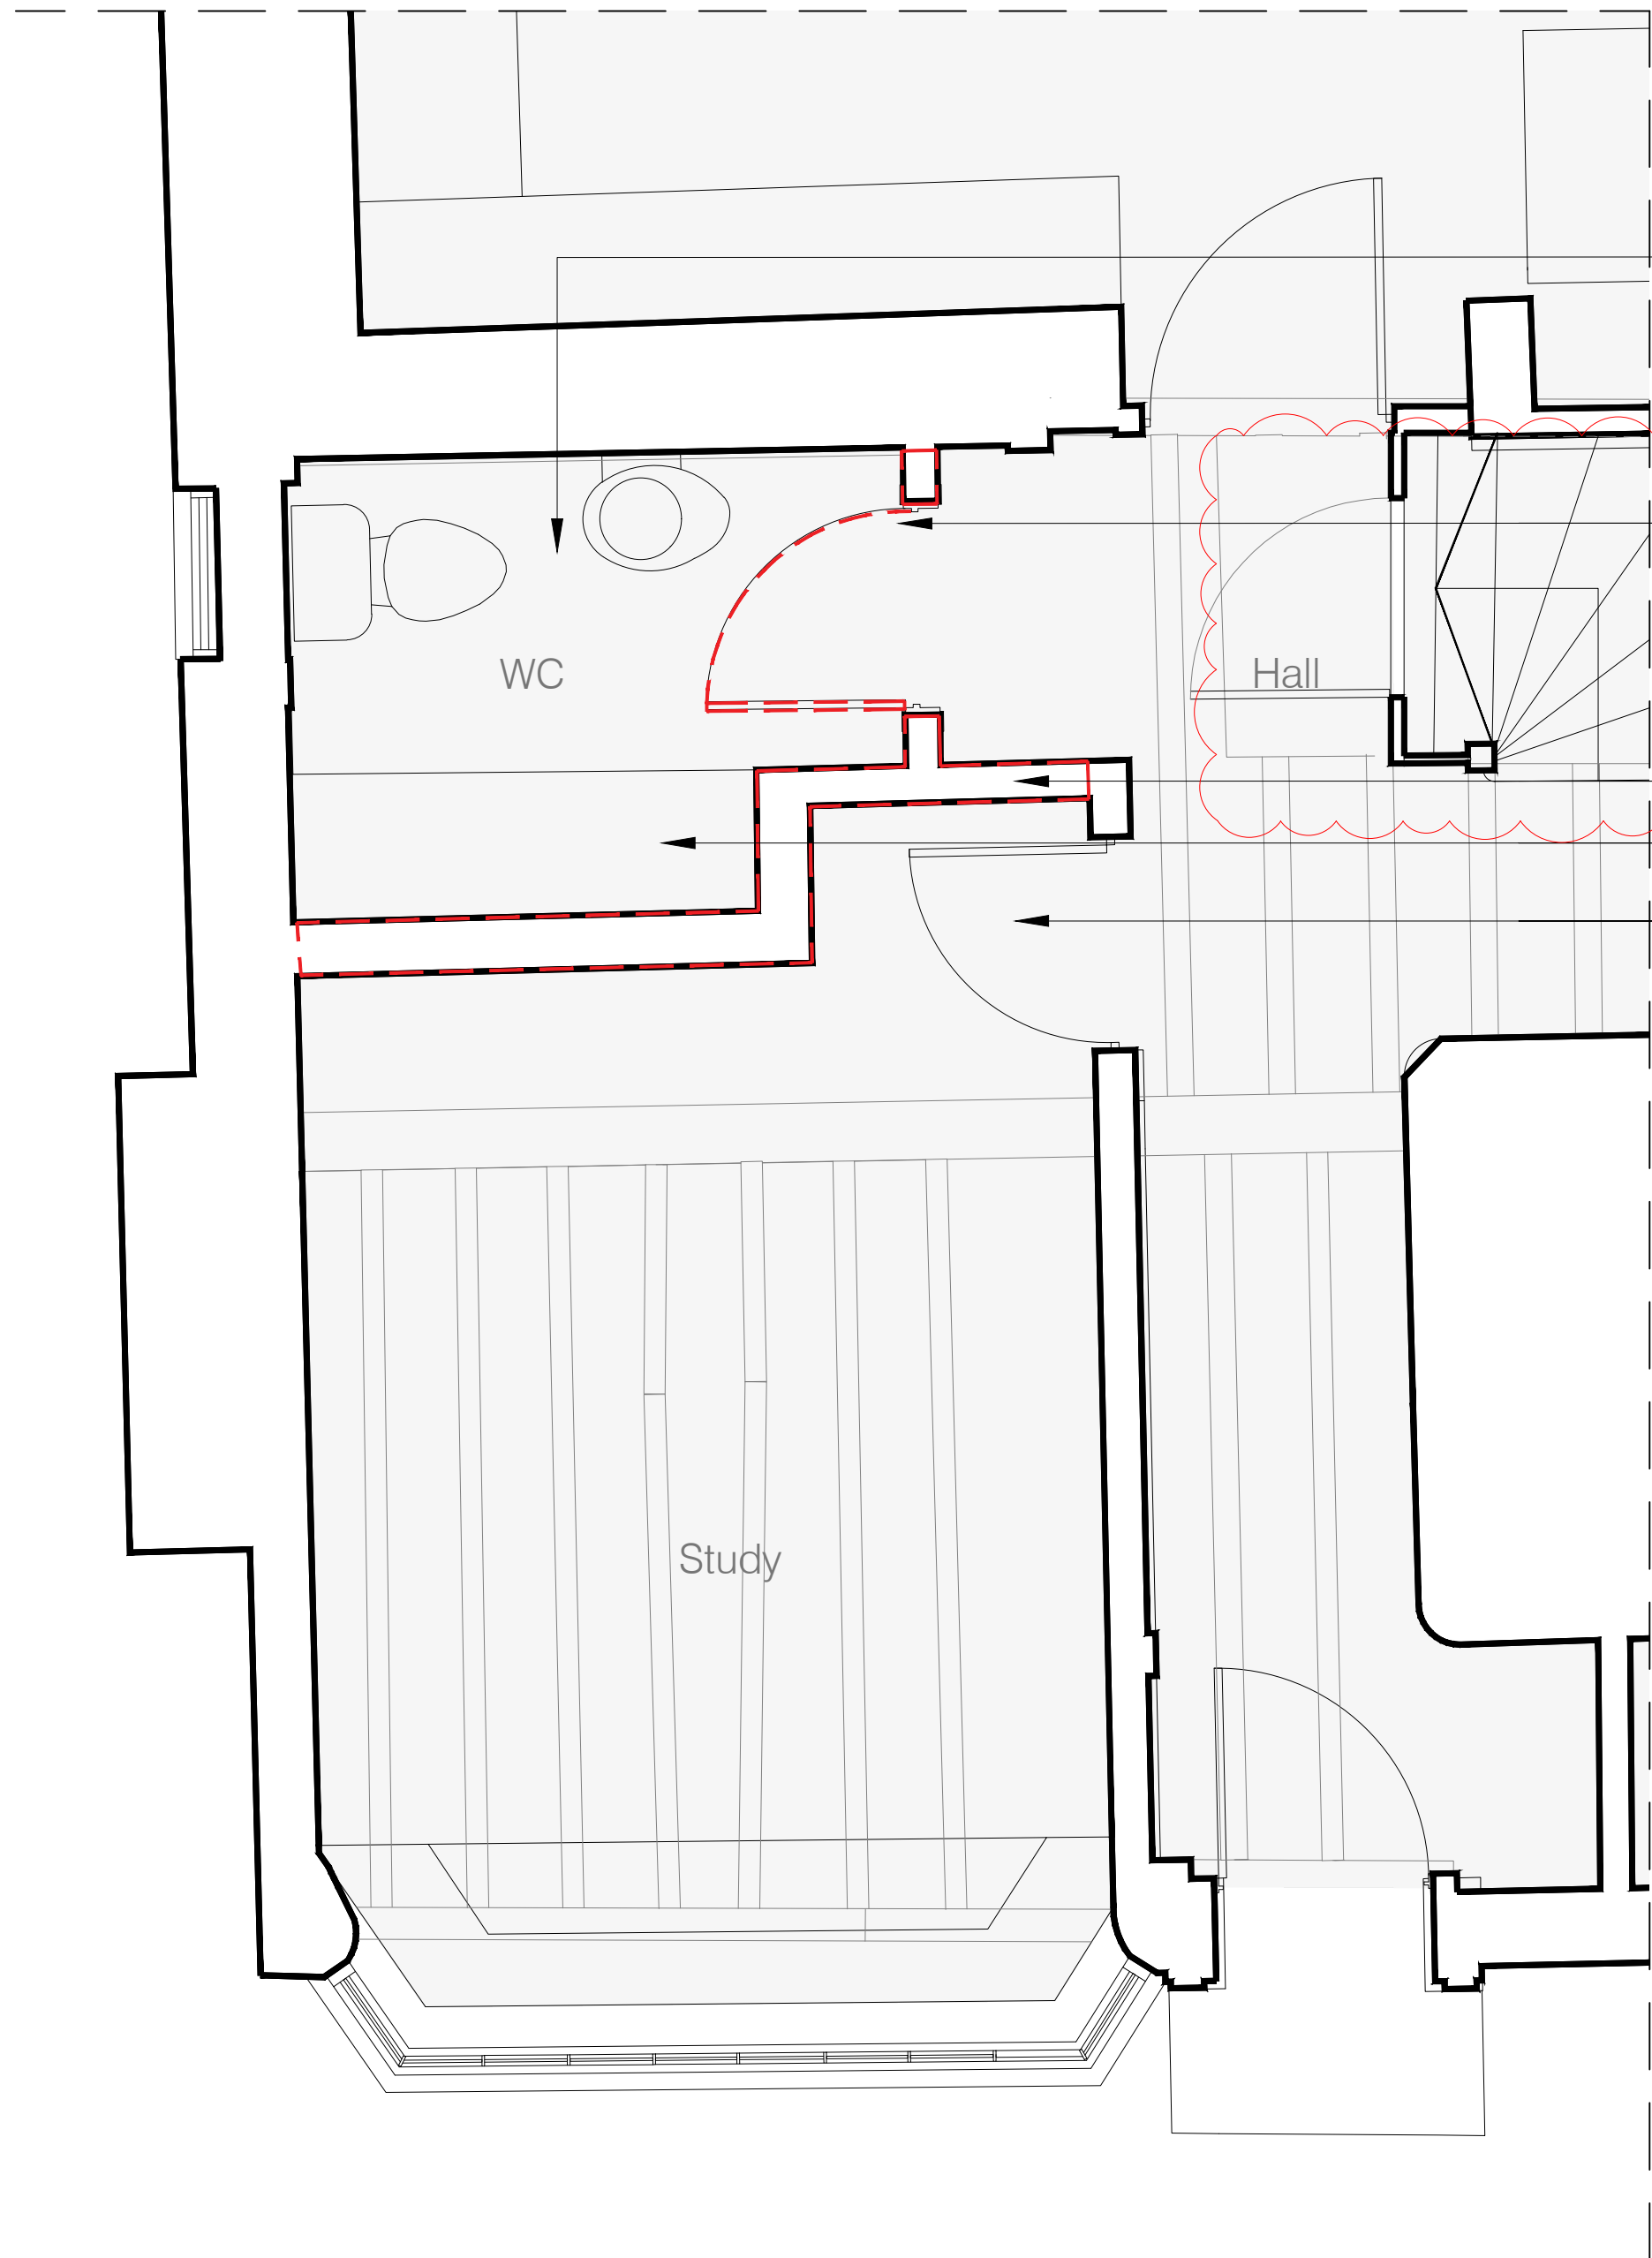

'As Built' and Proposed
Ground Floor Plan
Scale 1:25@A1 , 1:50@A3


- WC installed in accordance with proposals outlined in planning statement as approved in application DM/22/3695
- New door constructed by re-using spare floorboards found in the attic, finished in a manner to compliment the character of the listed building
- New lath and plaster partition wall
- Fitted joinery to provide essential cloaks storage
- Door handed in existing frame to make better use of the space

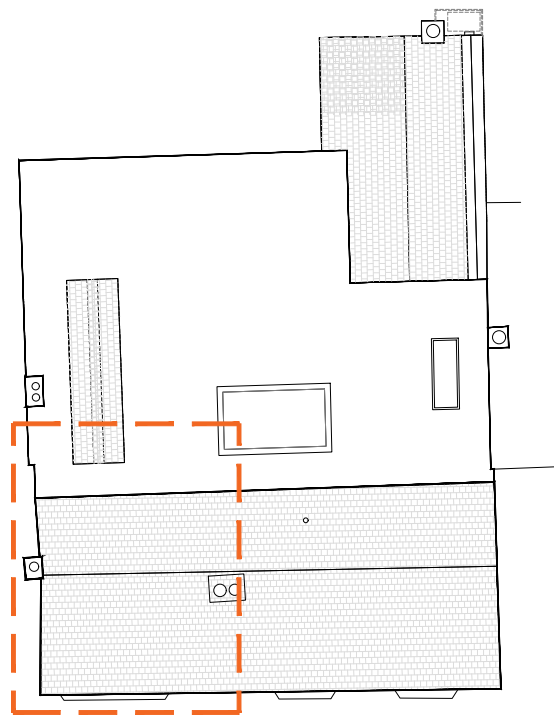

Key Plan 1:200@A1, 1:400@A3

NOTE
DRAWINGS TO BE READ IN CONJUNCTION WITH SUBMITTED
DESIGN&ACCESS STATEMENT AND HERITAGE STATEMENT
MATERIALS INSTALLED IN ACCORDANCE WITH THOSE
OUTLINED IN CONDITION #9 OF APPROVAL DM/23/1605

KEY:
Highlighted difference between Approved Scheme and 'As-Built'/Proposed Scheme

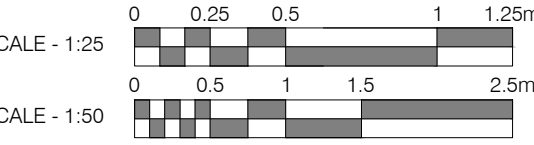

Rev.	Comments:	By:	Date:
A	Amendments as clouded.	KN	Nov 25

Do not scale this drawing All dimensions must be checked on site
All rights reserved. No reproduction in any material form is permitted without consent.

LISTED BUILDING CONSENT			
Client: Mr. Simon Dougall			
Project Title: 107 High St, Lindfield, Haywards Heath, West Sussex, RH16 2HR			
Drawing Title: Detail Drawings: Partition for ground floor WC			
Scale: 1:25@A1 1:50@A3	Date: Apr 25	Drawn: KN	Checked: KW

kyson ^{studio}		
Studio 28 Scrutton Street London UK EC2A 4RP T: +44(0) 20 7247 2462 E: enquiries@kyson.co.uk W: www.kyson.co.uk		
Project No.: 900-25	Drawing No.: 5004	Revision: A