




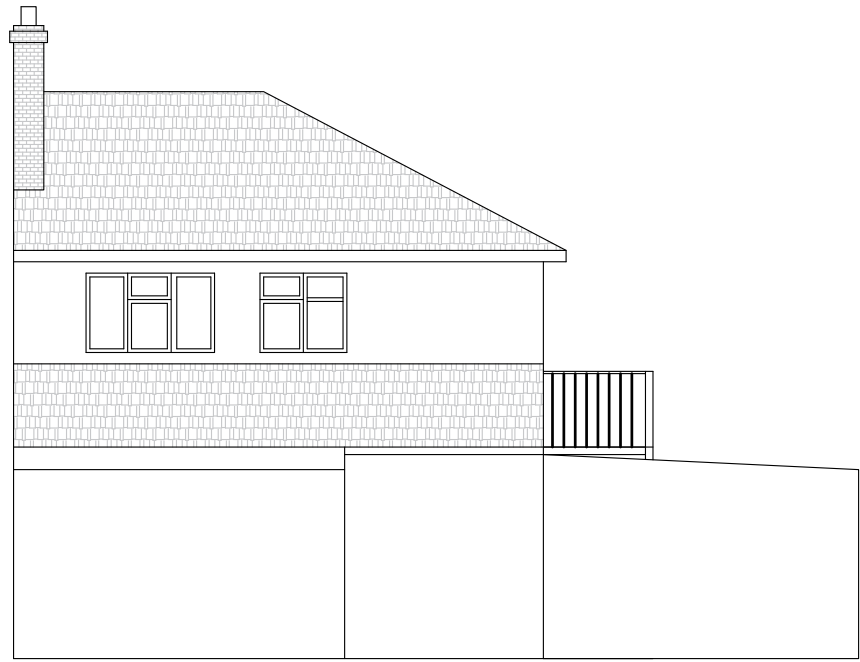

ASBUILT REAR ELEVATION

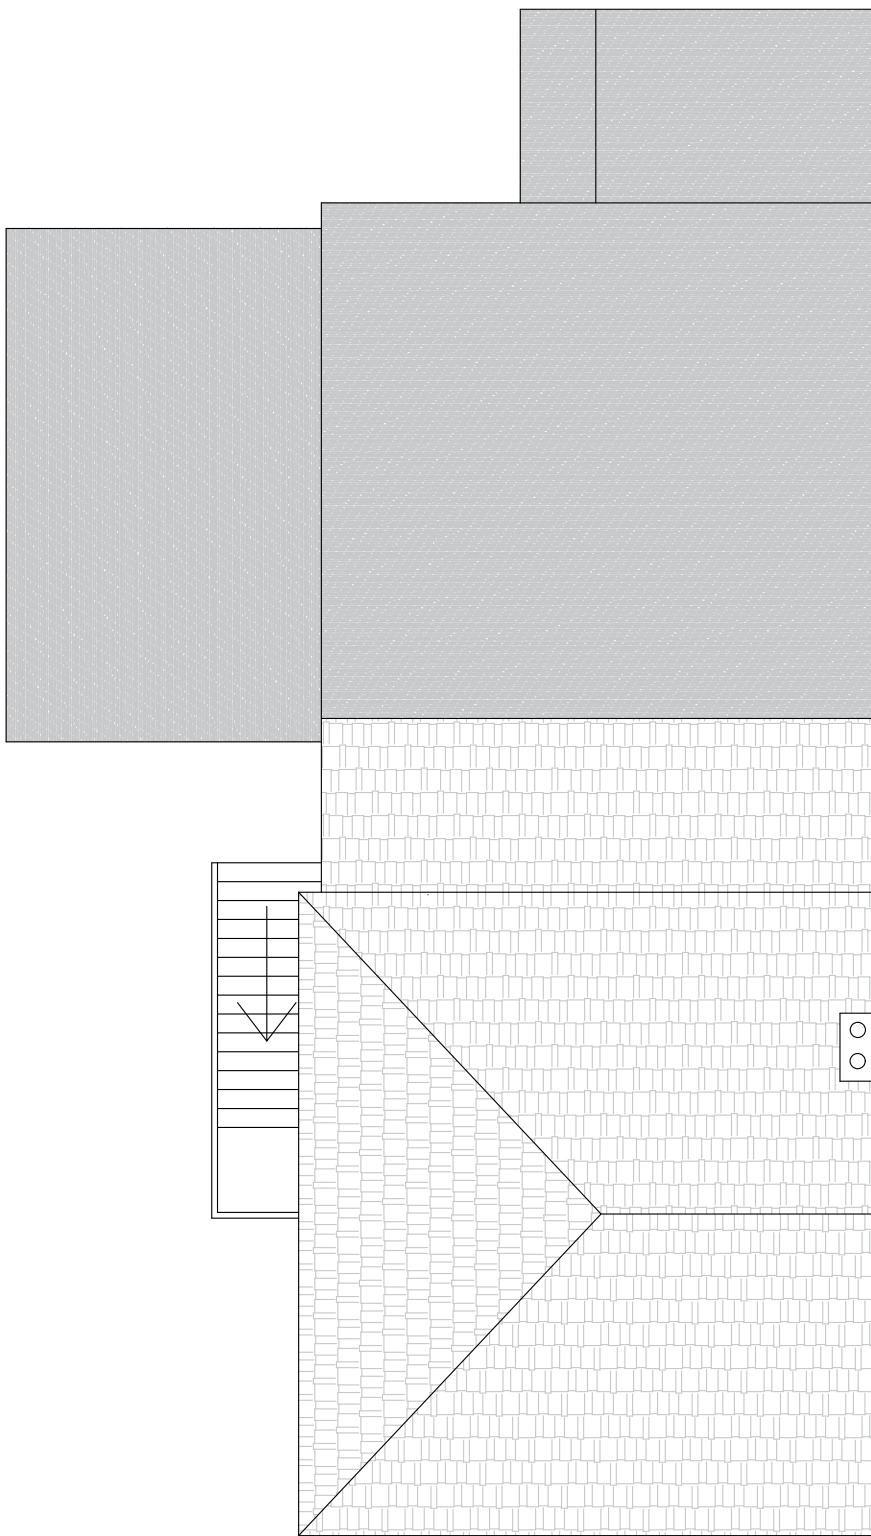


ASBUILT ROOF PLAN

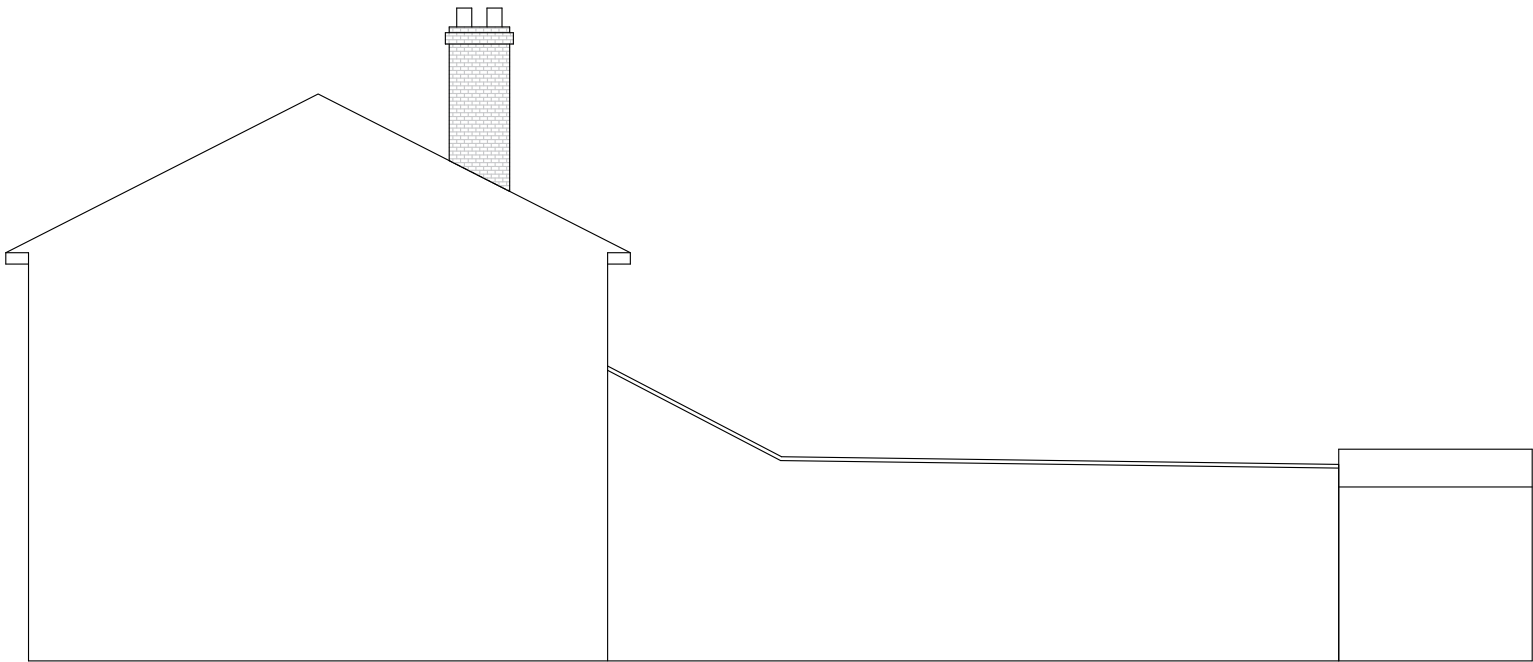


EXISTING END ELEVATION




ASBUILT SHOP FLOOR PLAN

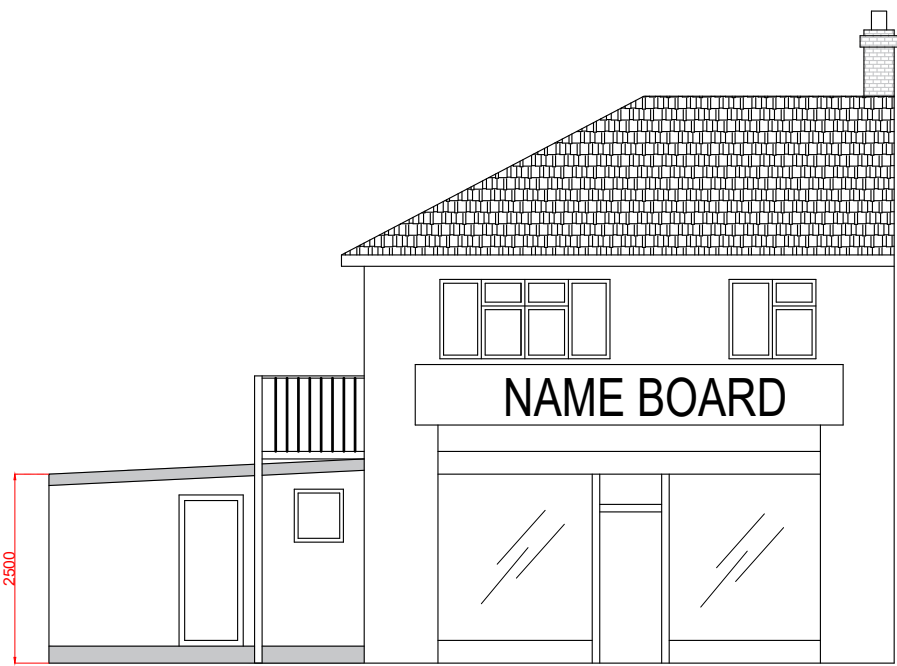


ASBUILT FRONT ELEVATION

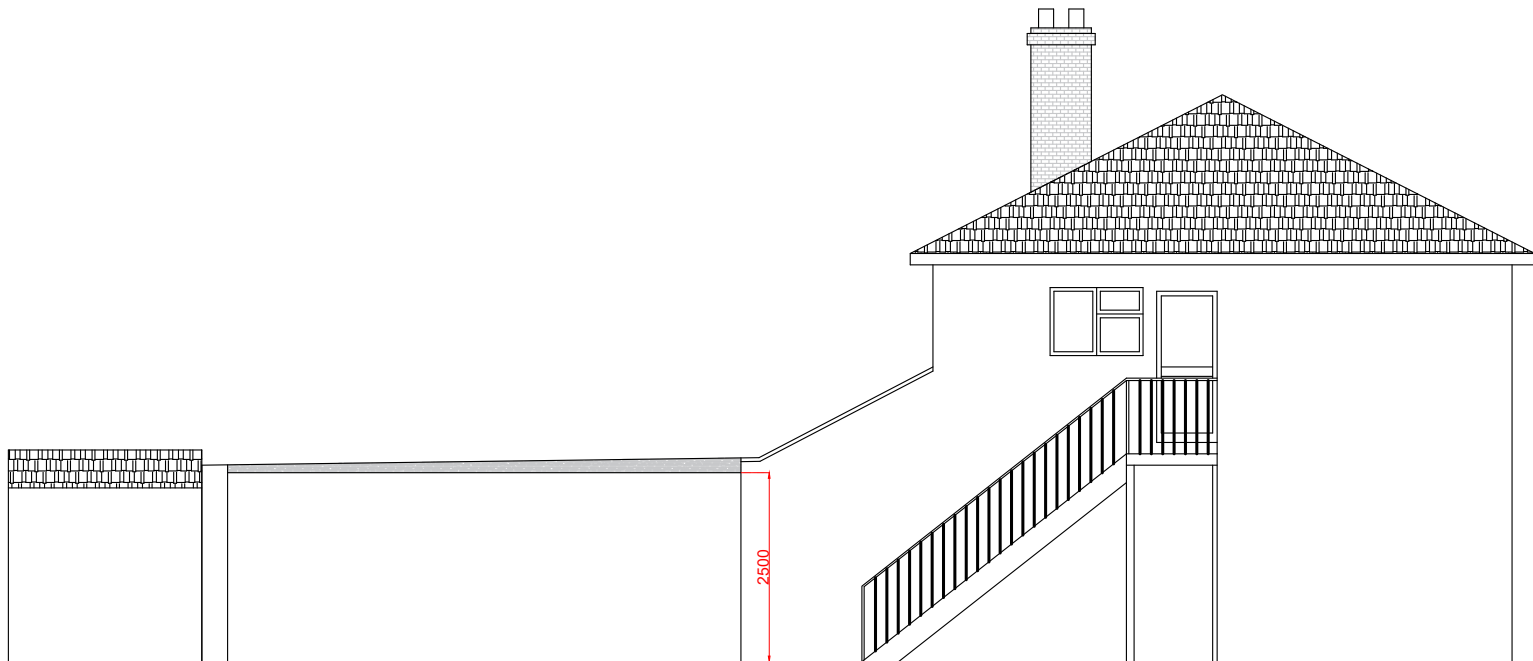

ASBUILT SIDE ELEVATION

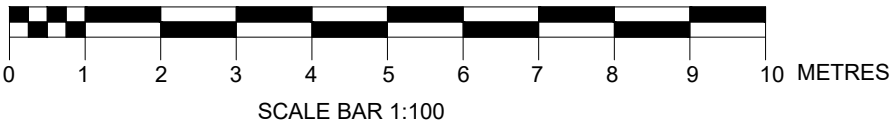

NOTES:
All dimensions are to be checked on site and measurements checked prior to works being carried out.
Contractor and Client are to ensure Compliance with C.D.M. Health and Safety Regulations and with C.D.M. Health and Safety Regulations and Party Wall Agreements where Applicable and to ensure all permissions have been obtained prior to any works commencing.
Any works carried out prior to necessary approvals being obtained will be at the owner's own risk and expense.

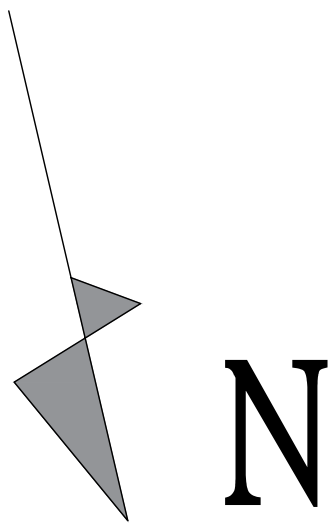

Rev	Date	By	Chkd	Description

Client
**6, Copthorne Bank, Crawley,
RH10 3QX**

Job Title
Erection of Storage Out Building



**KOVIL
CONSULTANCY**

KOVIL CONSULTANCY
172, Blackfen Road,
Sidecup, Kent
DA15 8PT
Mob: 07507236300
sutha@kovilgroups.co.uk

Scale :
1:100 @ A1

Date :
12/10/2024

Drawing Title :
**ASBUILT FLOOR PLAN,
ELEVATIONS & ROOF PLAN
AFTER ERECTED OUT BUILDING**

Drawing No : 06- RH10 3QX - 000002	Rev. C 01
--	---------------------