




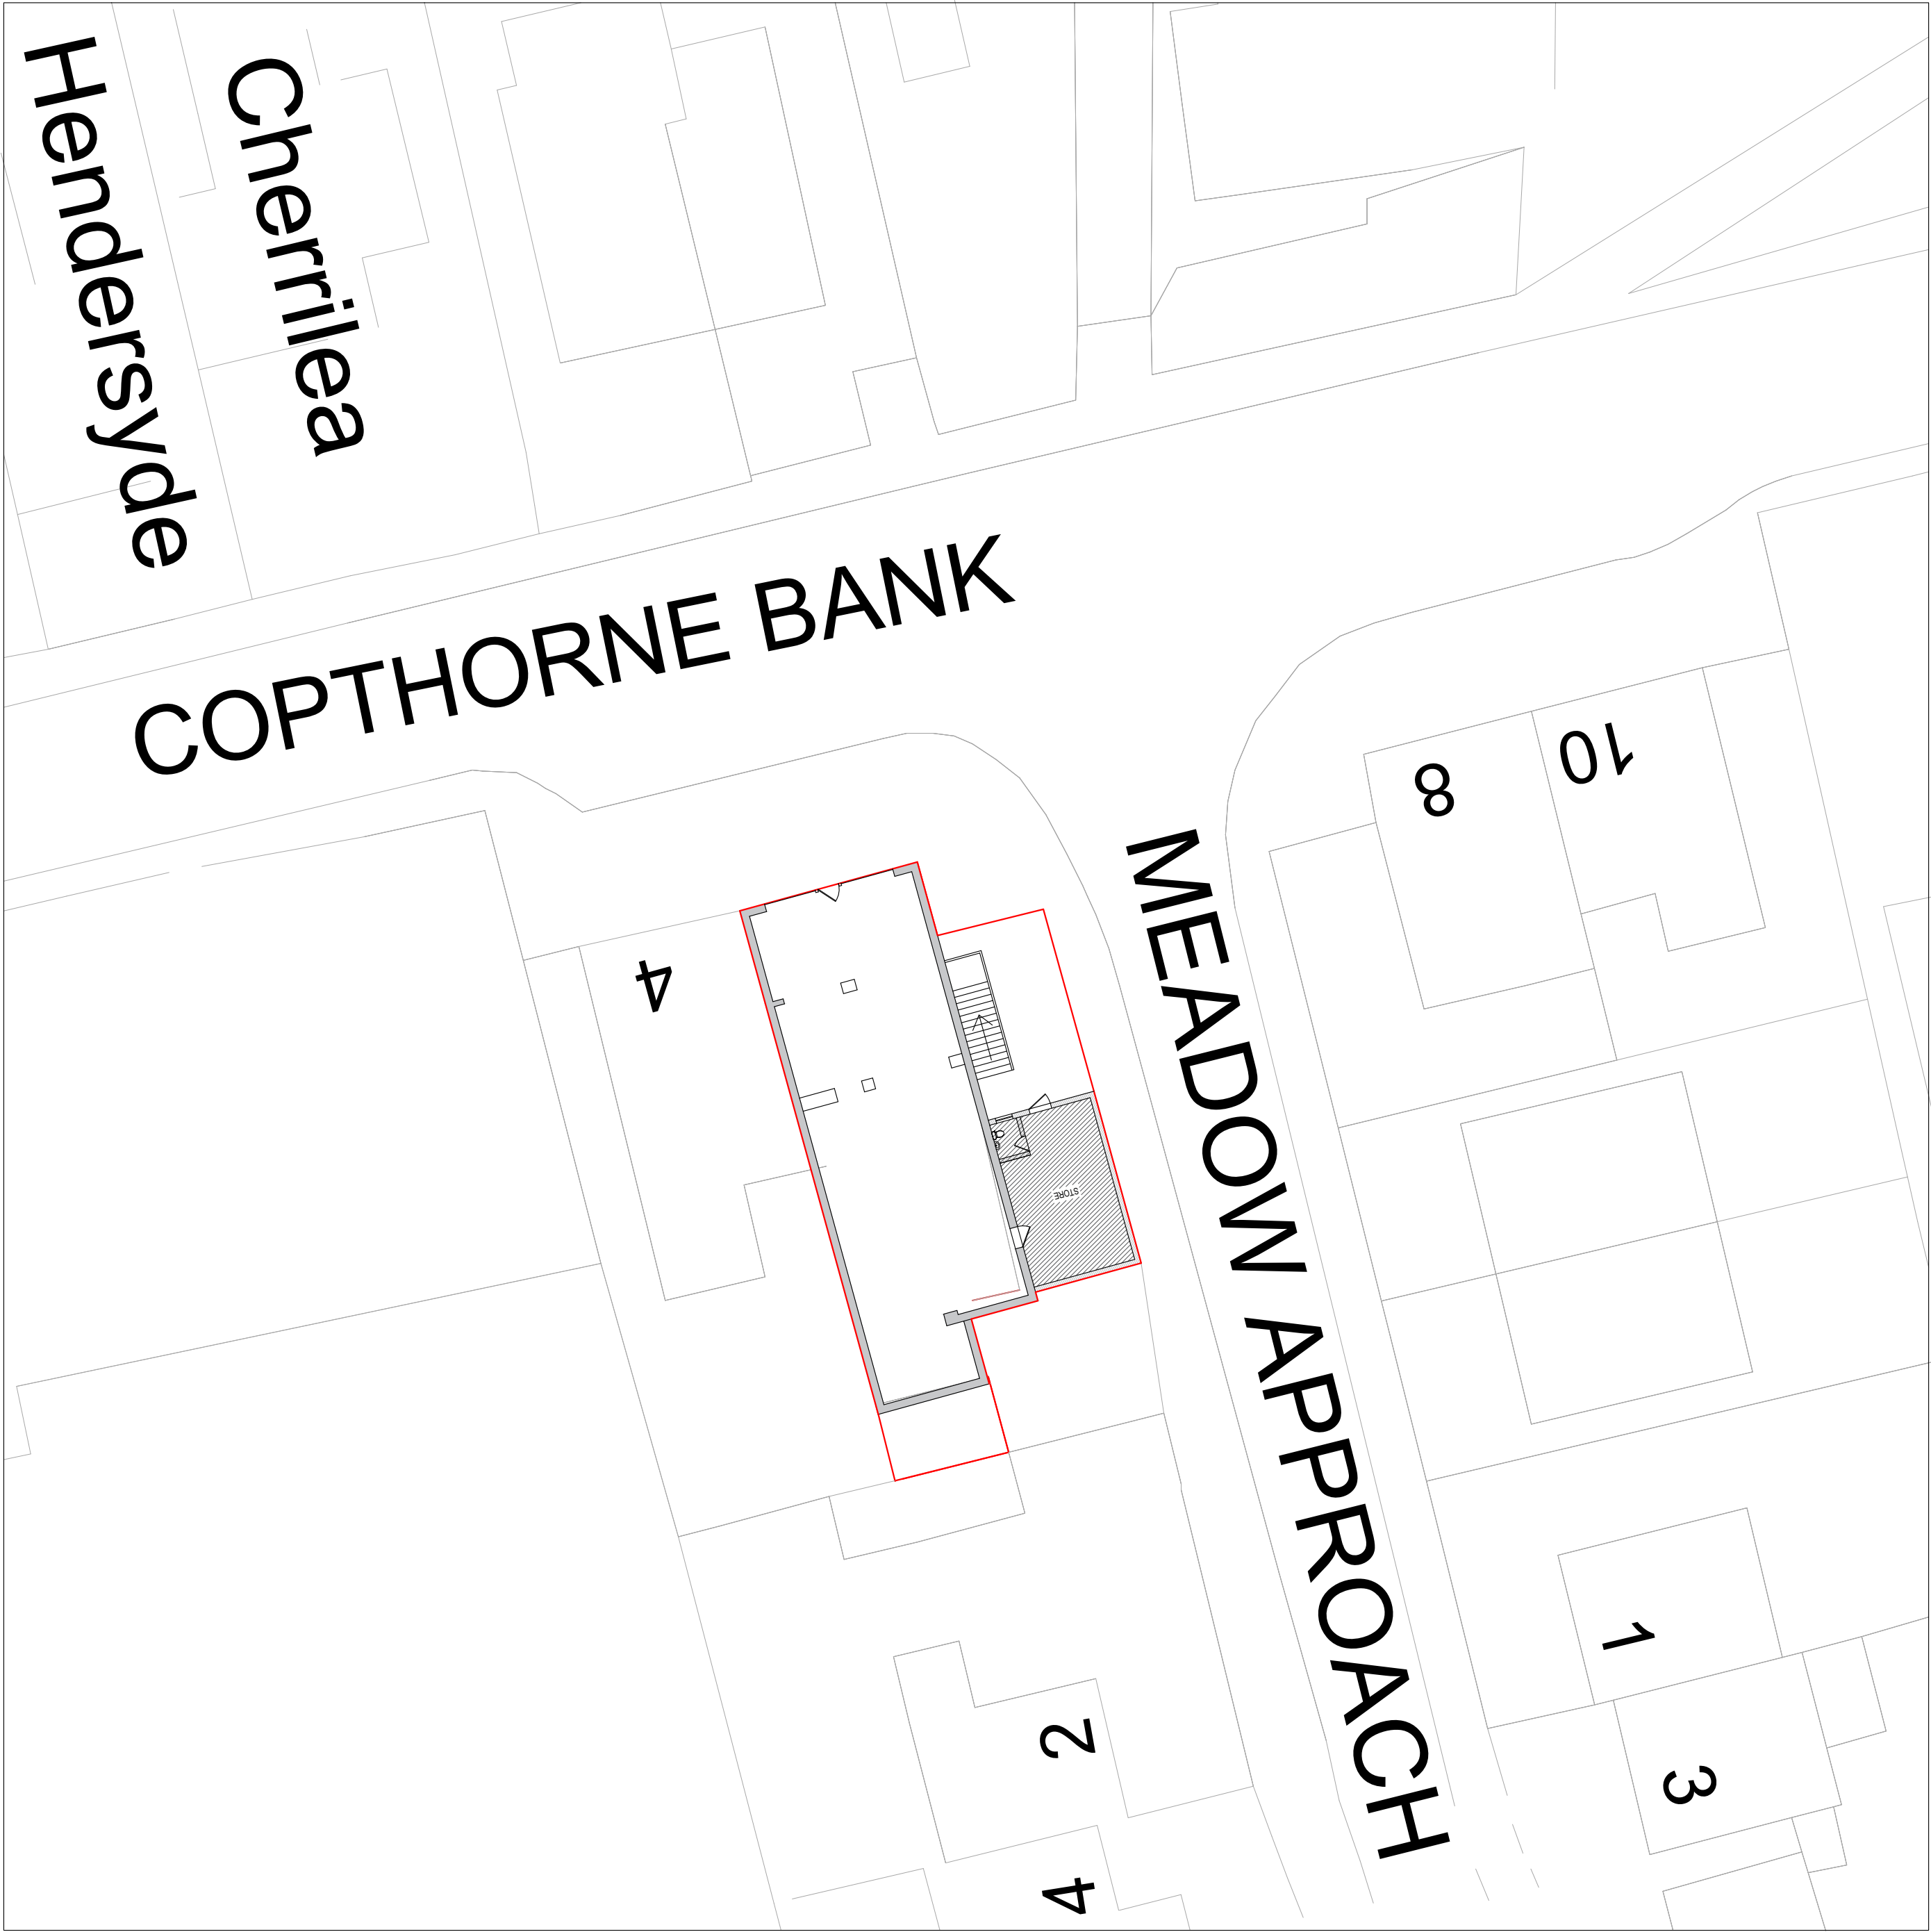


BLOCK PLAN
Scale 1:200 @ A1

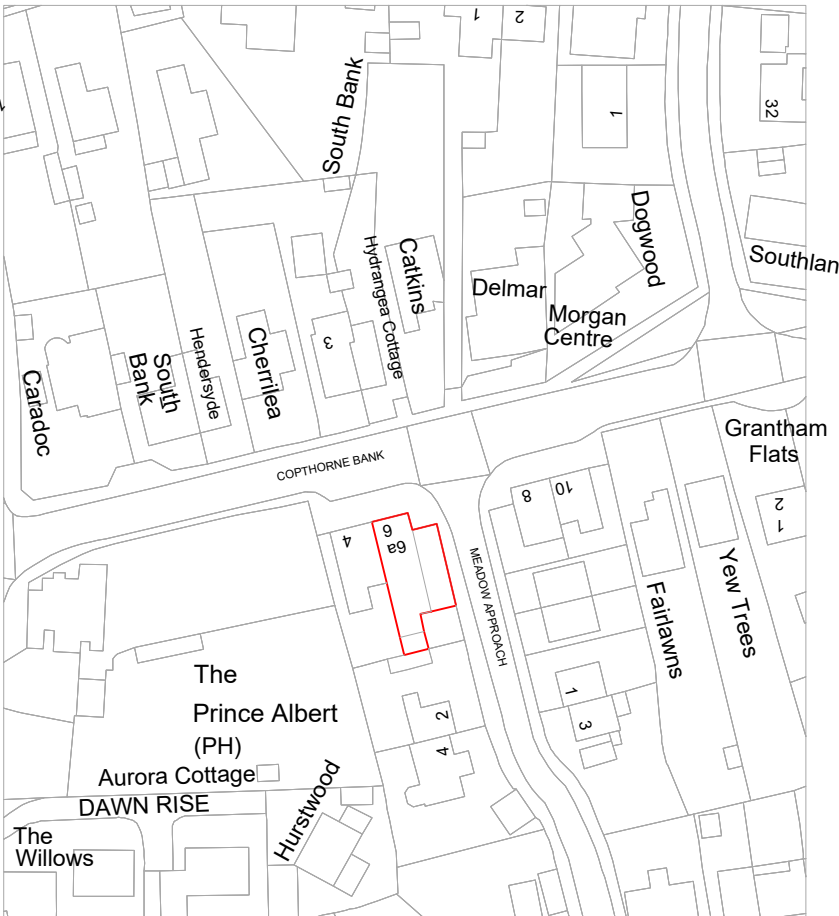

LOCATION PLAN
Scale 1:1250 @ A1

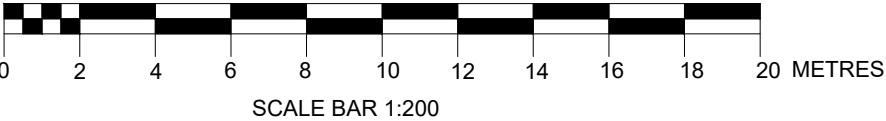

NOTES:
All dimensions are to be checked on site and measurements checked prior to works being carried out.
Contractor and Client are to ensure Compliance with C.D.M. Health and Safety Regulations and with C.D.M. Health and Safety Regulations and Party Wall Agreements where Applicable and to ensure all permissions have been obtained prior to any works commencing.
Any works carried out prior to necessary approvals being obtained will be at the owner's own risk and expense.

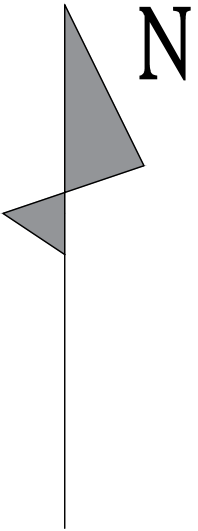

Rev	Date	By	Chkd	Description	
Client					
6, Copthorne Bank, Crawley, RH10 3QX					
Job Title					
Erection of Storage Out Building					
 KOVIL CONSULTANCY KOVIL CONSULTANCY 172, Blackfen Road, Sidecup, Kent DA15 8PT Mob: 07507236300 sutha@kovilgroups.co.uk					
Scale :				Date :	
				12/11/2024	
Drawing Title :					
ASBUILT BLOCK & LOCATION PLAN					
Drawing No :					Rev.
06- RH10 3QX - 000003					C 02