
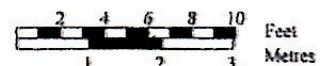
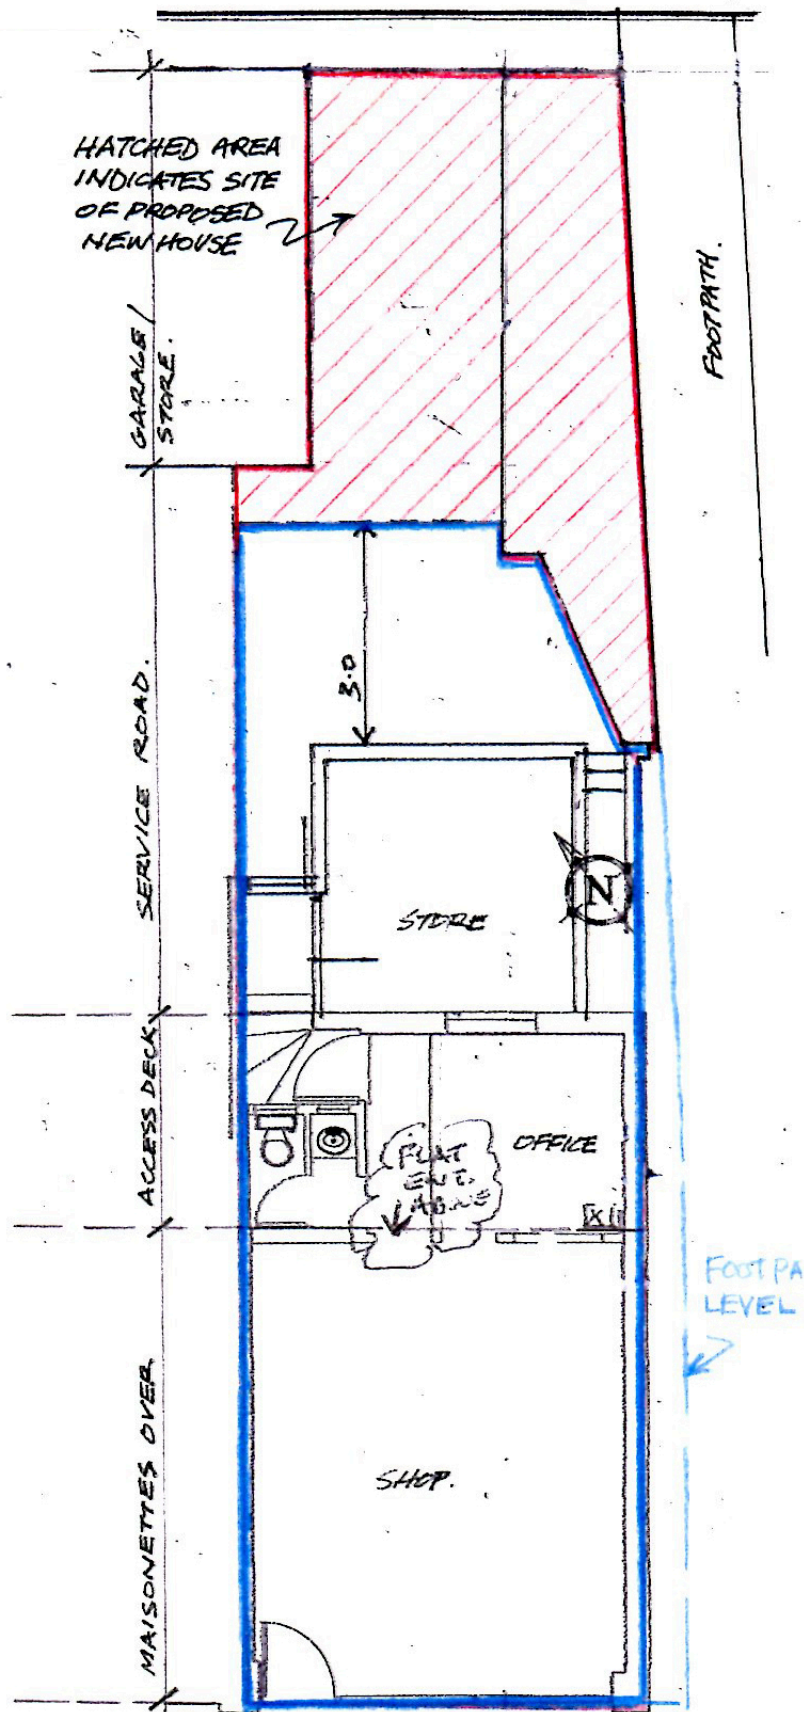
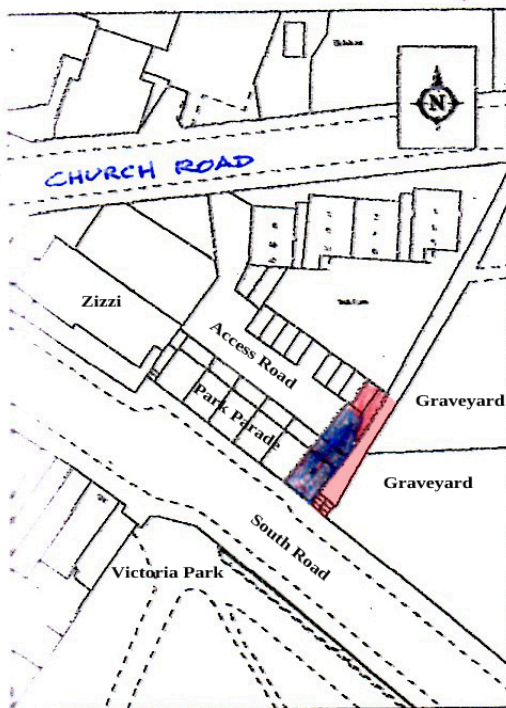


Note: The Red line has been extended to include the footpath at the request of MSCC. The footpath is unadopted according to the Land Registry. The footpath is only included to show access to South Road at the request of MSCC planning department.

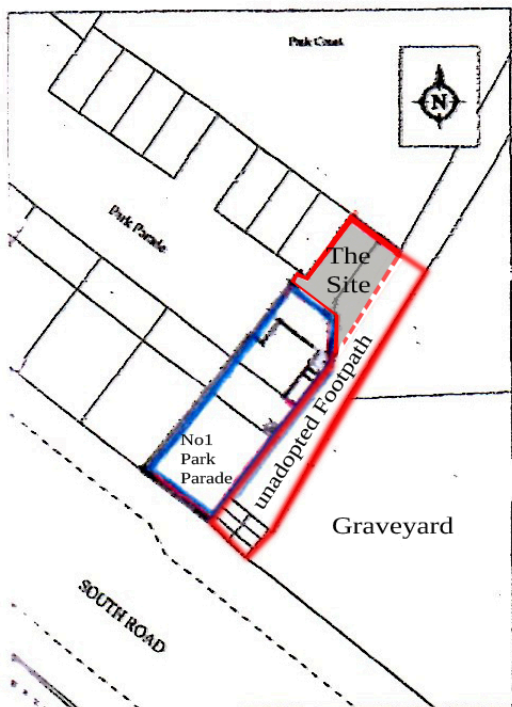

Trueplan (UK) Ltd
Bank Chambers
35 Mount Pleasant
Tunbridge Wells
Kent TN11 1RB

Land NE of No1,
Park Parade, South Road,
Haywards Heath,
West Sussex, RH16 4LX

Scale 1:100 @A4
Drawing No. 25/LP1
Revision 01A