



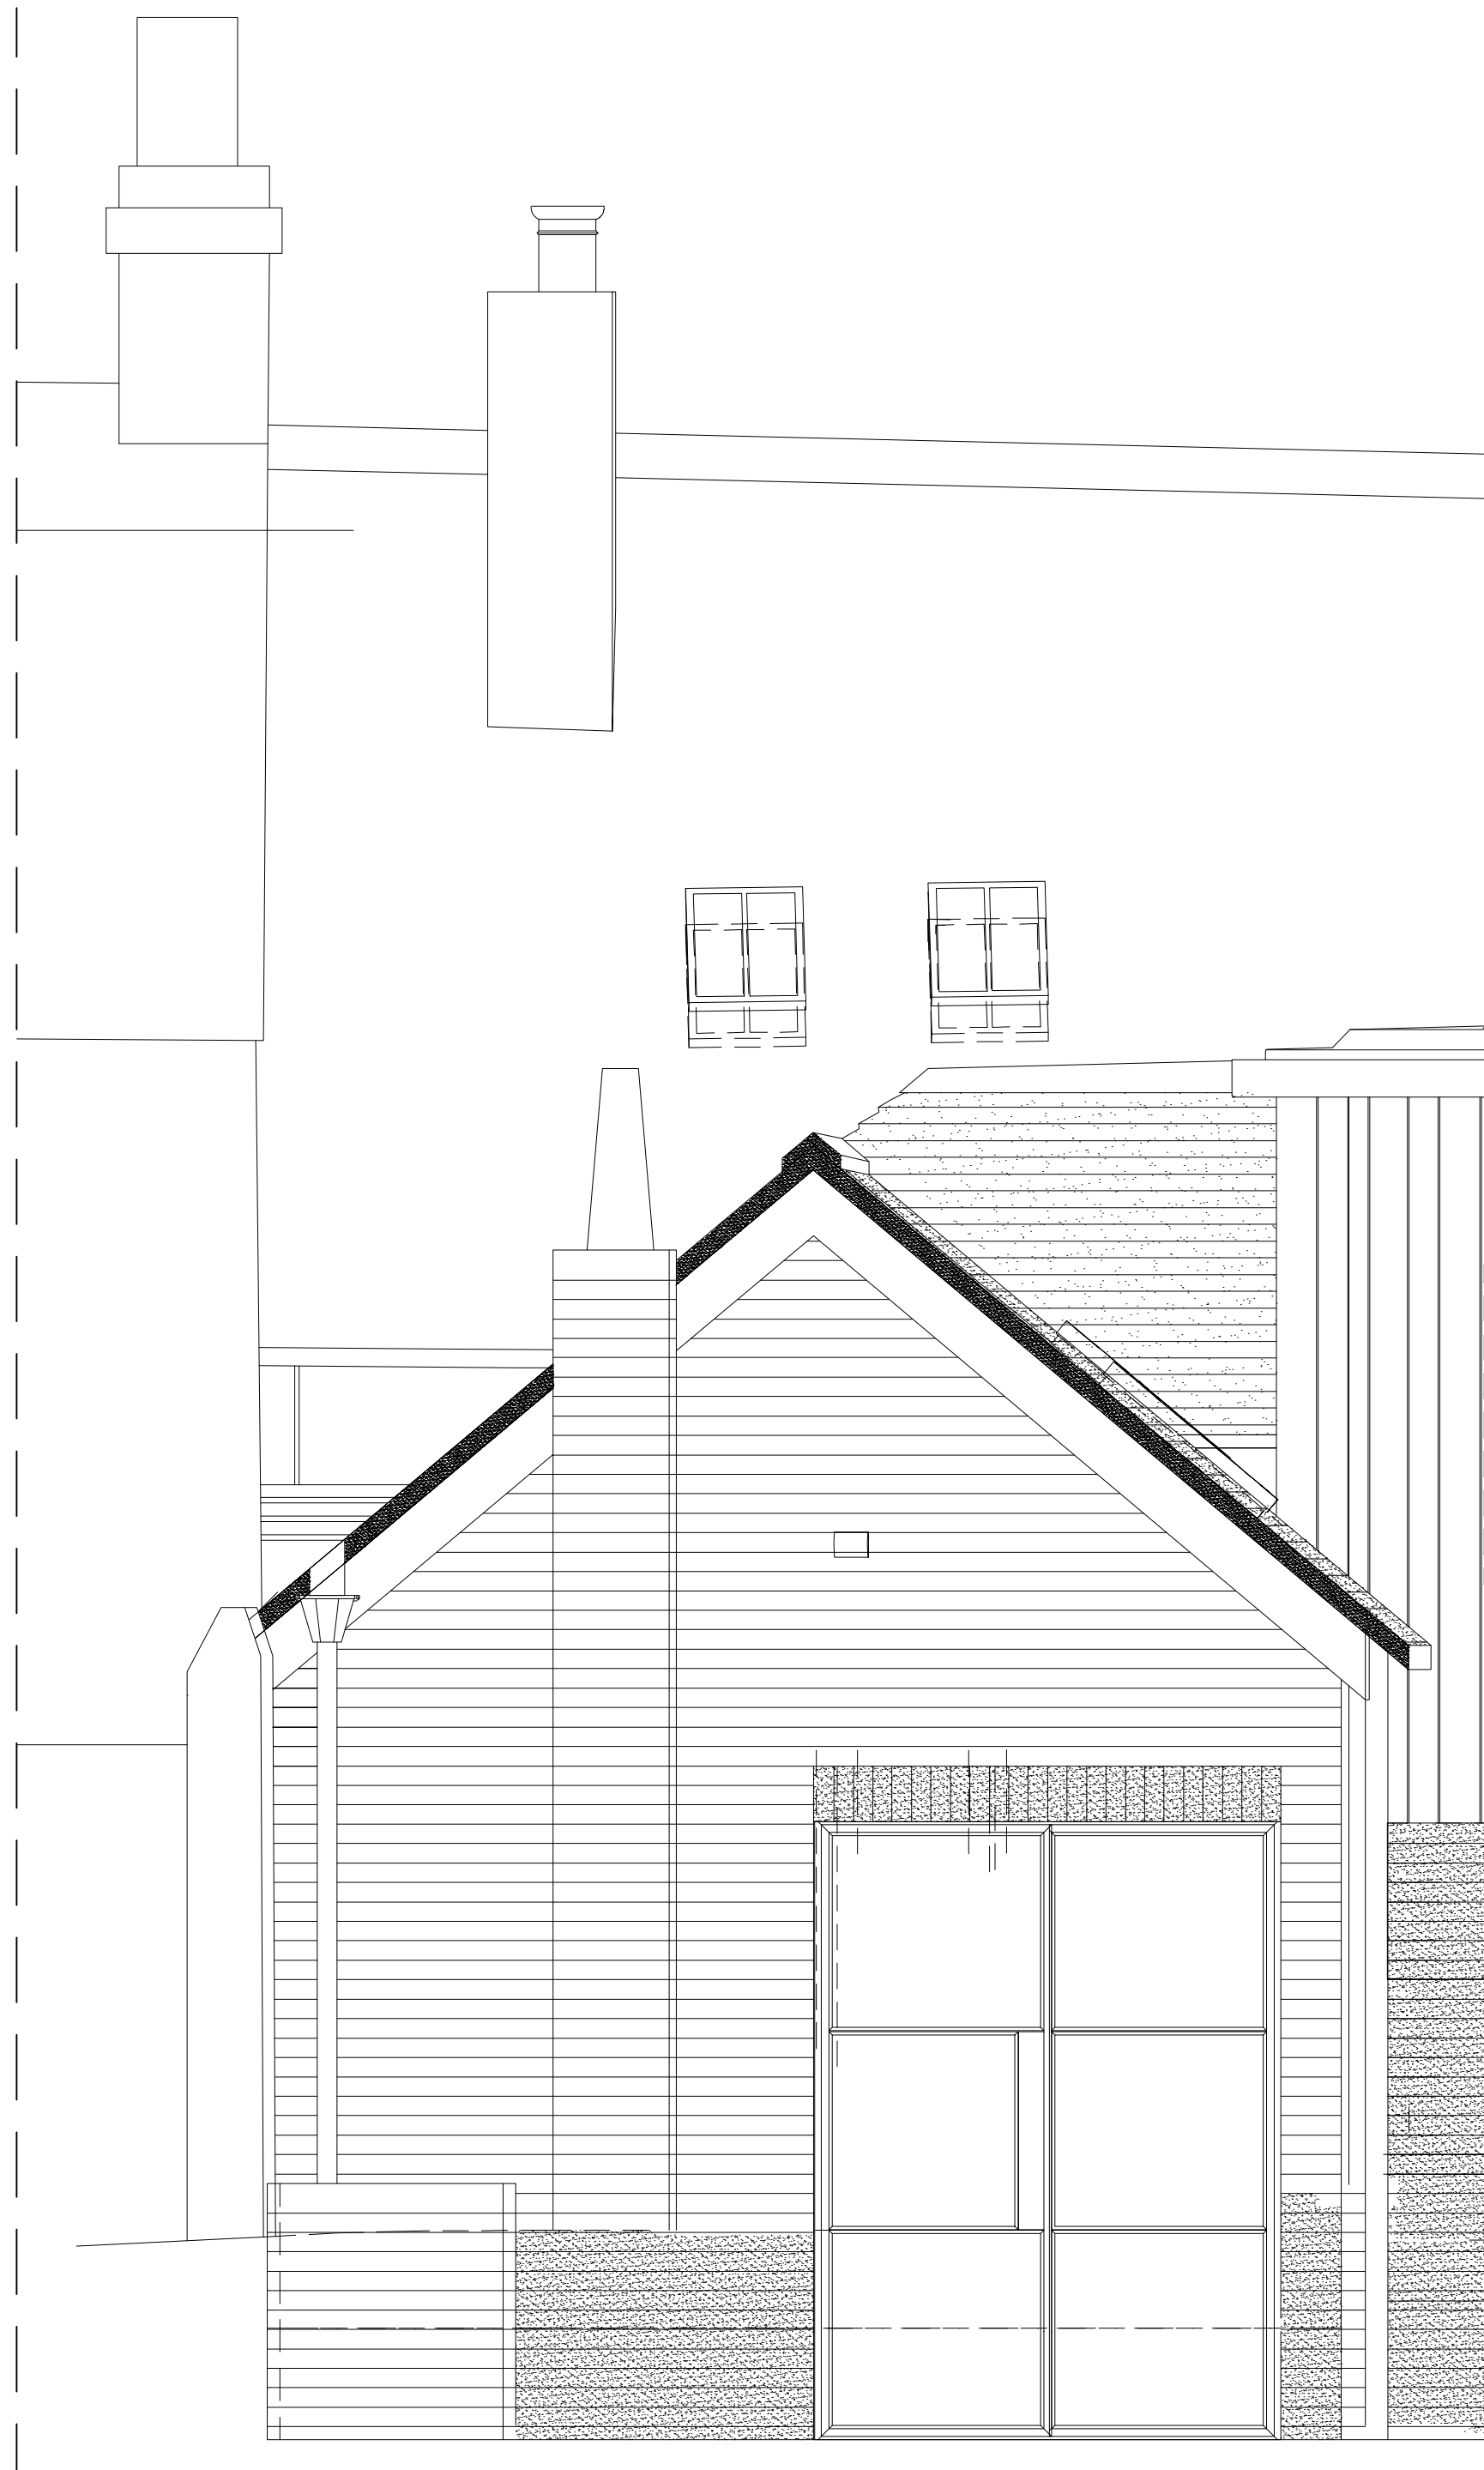

Approved Scheme West Elevation
Scale 1:25@A1
1:50@A3

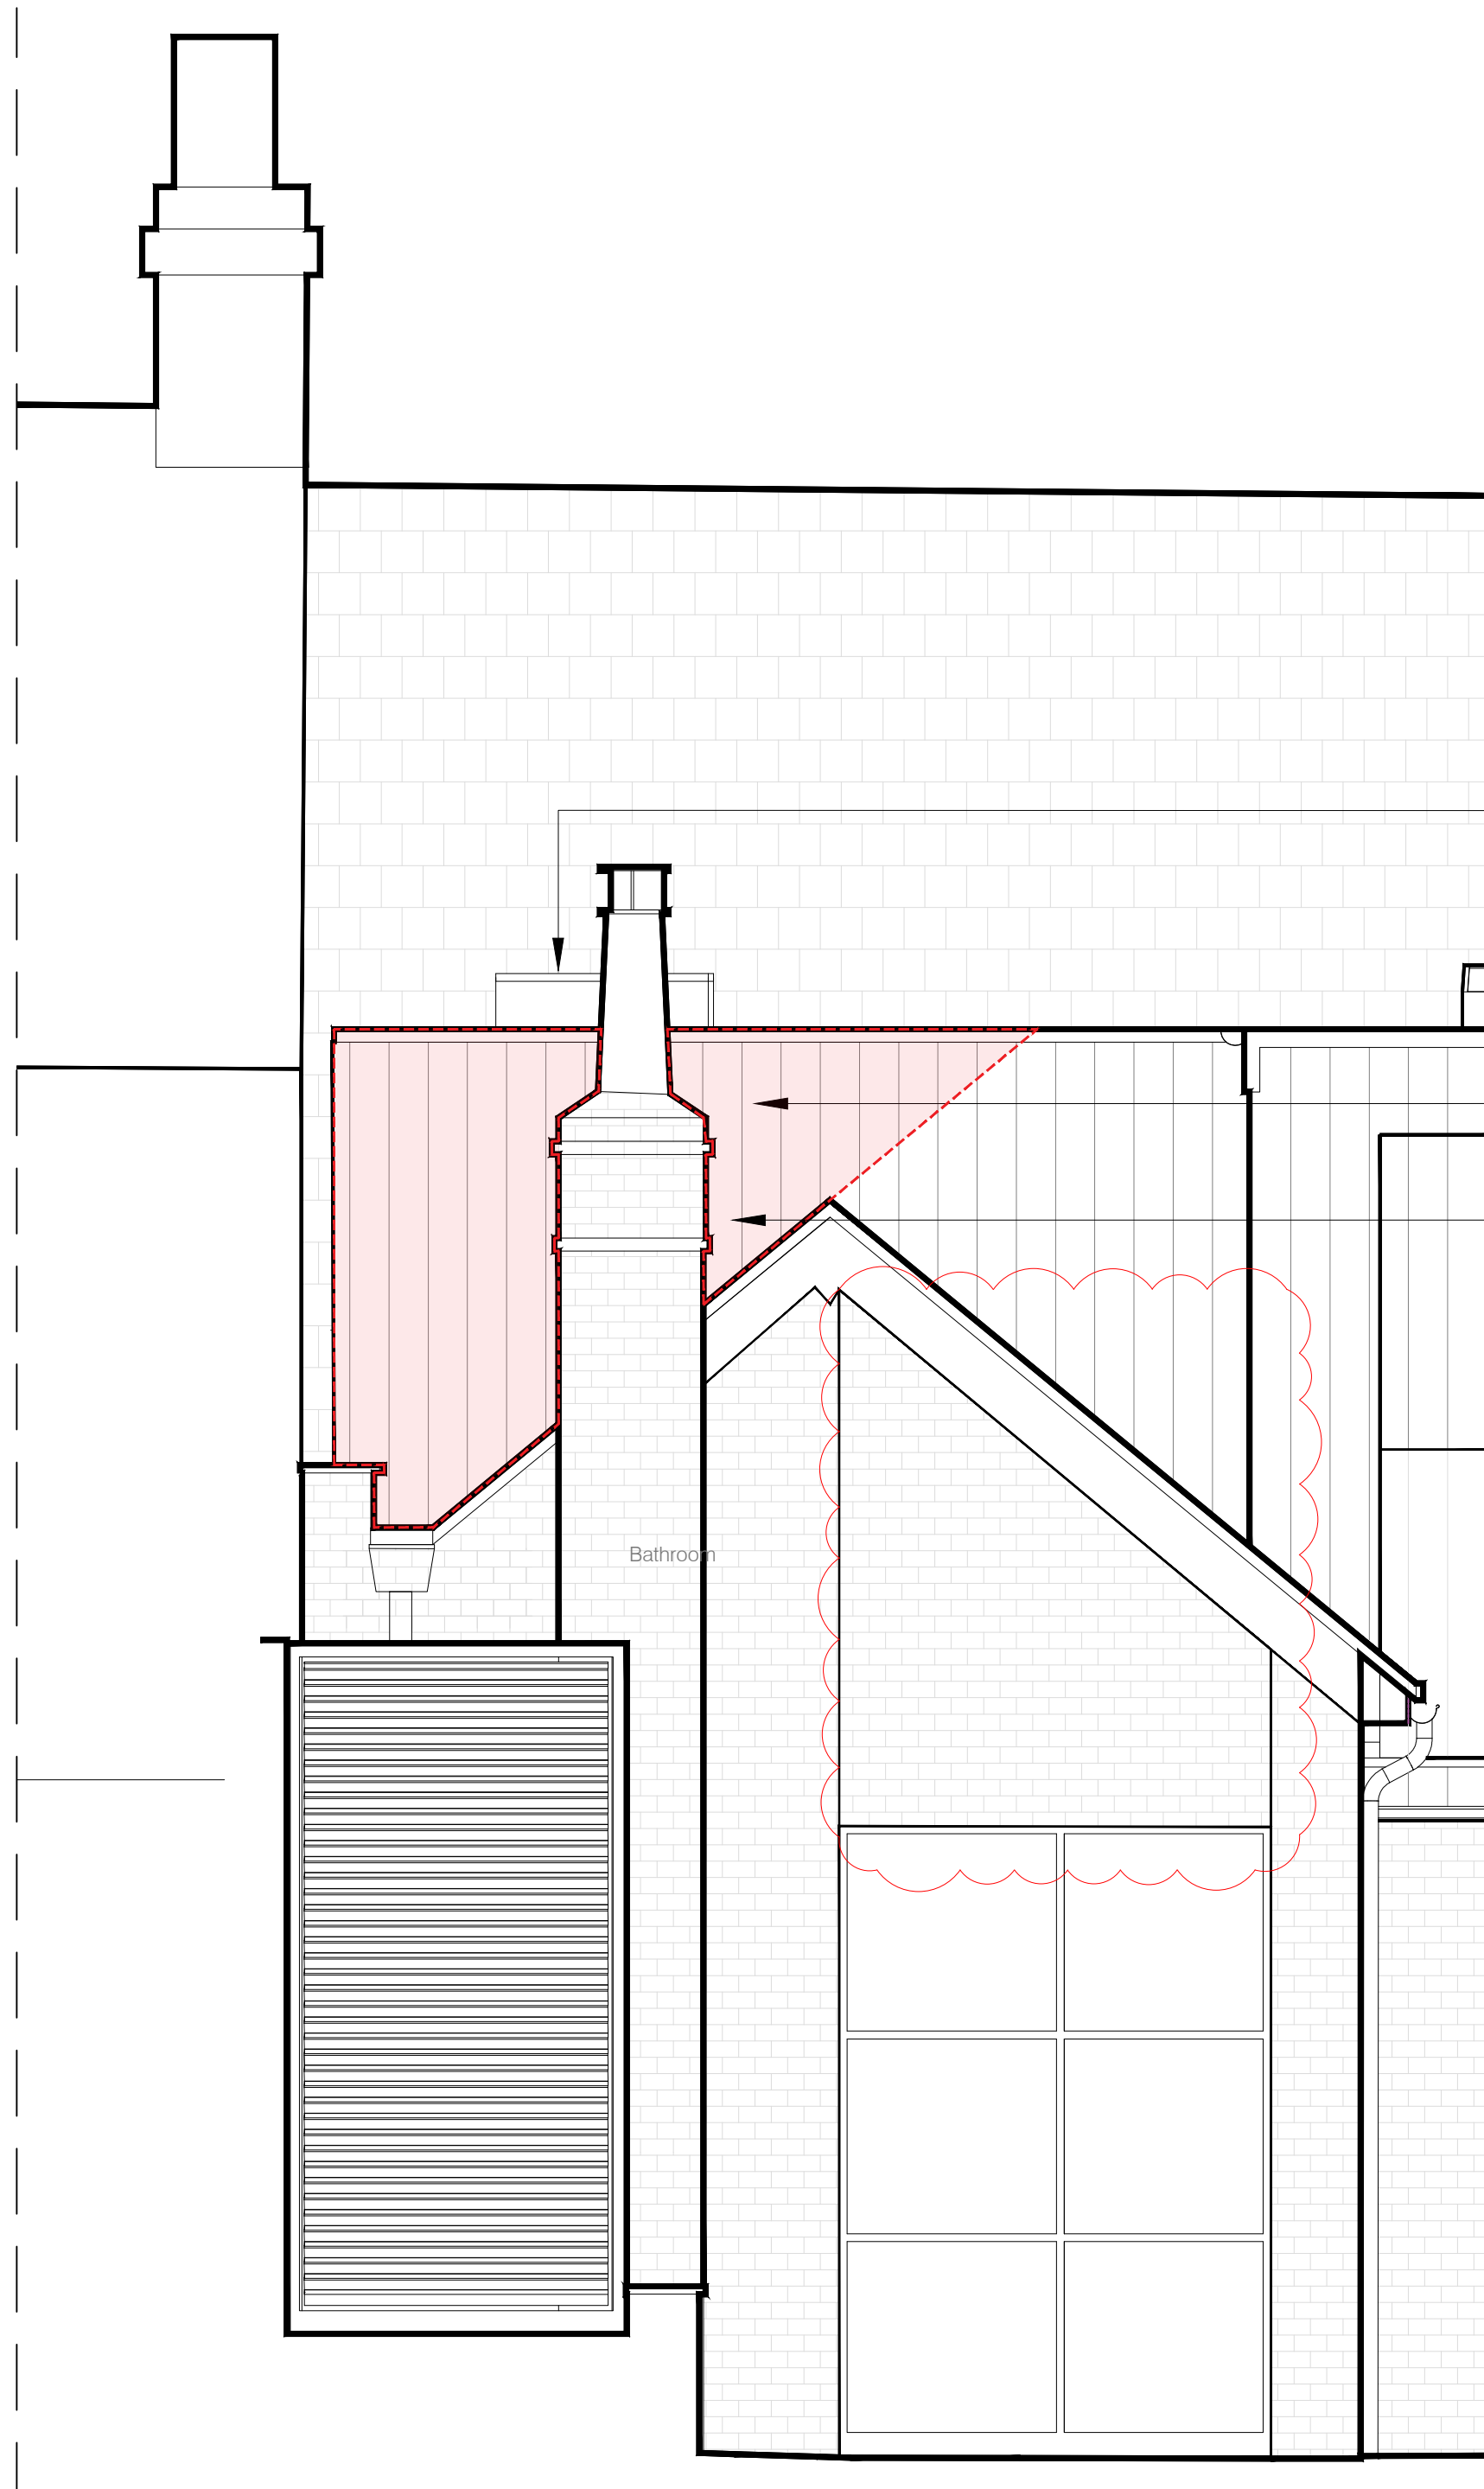

Proposed West Elevation
Scale 1:25@A1
1:50@A3

- Rooflight by Duplus, SB Opener (Elec) + Cover Frame, 1970mm x 810mm
Frame colour: Internal 9910 Matt White / External 7016 Matt Grey
Glazing Spec: 6mm Clear TGH & Heatsoaked/16mm Black warm edge spacer
argon gas filled silicone (DC3362) seal/6mm Clear soft coat 1.0 (Low E) TGH & Heatsoaked
- Flat roof infill above en-suite to match the same style and construction as the approved extension
- PeraChar Charred Timber Claddin (Larch) - Crushed Berry. Square-edged boards (PAR - planed all round)

KEY:
Highlighted difference between Approved Scheme and 'As-Built'/Proposed Scheme

Rev:	Comments:	By:	Date:
A	Amendments as clouded.	KN	Nov 25

Do not scale this drawing All dimensions must be checked on site
All rights reserved. No reproduction in any material form is permitted without consent.

LISTED BUILDING
CONSENT

Client:
Mr. Simon Dougall

Project Title:
107 High St, Lindfield, Haywards Heath, West Sussex, RH16 2HR

Drawing Title:
Detail Drawings:
Flat Roof Infill - Sheet 2 of 2

Scale:	Date:	Drawn:	Checked:
1:25@A1 1:50@A3	Apr 25	KN	KW

NOTE
DRAWINGS TO BE READ IN CONJUNCTION WITH SUBMITTED
DESIGN&ACCESS STATEMENT AND HERITAGE STATEMENT
MATERIALS INSTALLED IN ACCORDANCE WITH THOSE
OUTLINED IN CONDITION #9 OF APPROVAL DM/23/1605

kyson⁺
Studio

28 Scrutton Street
London
UK
EC2A 4RP

T: +44(0) 20 7247 2462
E: enquiries@kyson.co.uk
W: www.kyson.co.uk

Project No.:	Drawing No.:	Revision:
900-25	5011	A

SCALE - 1:25
0 0.25 0.5 1 1.25m
SCALE - 1:50
0 0.5 1 1.5 2.5m