




Approved Scheme
Ground Floor Plan
Scale 1:25@A1 , 1:50@A3

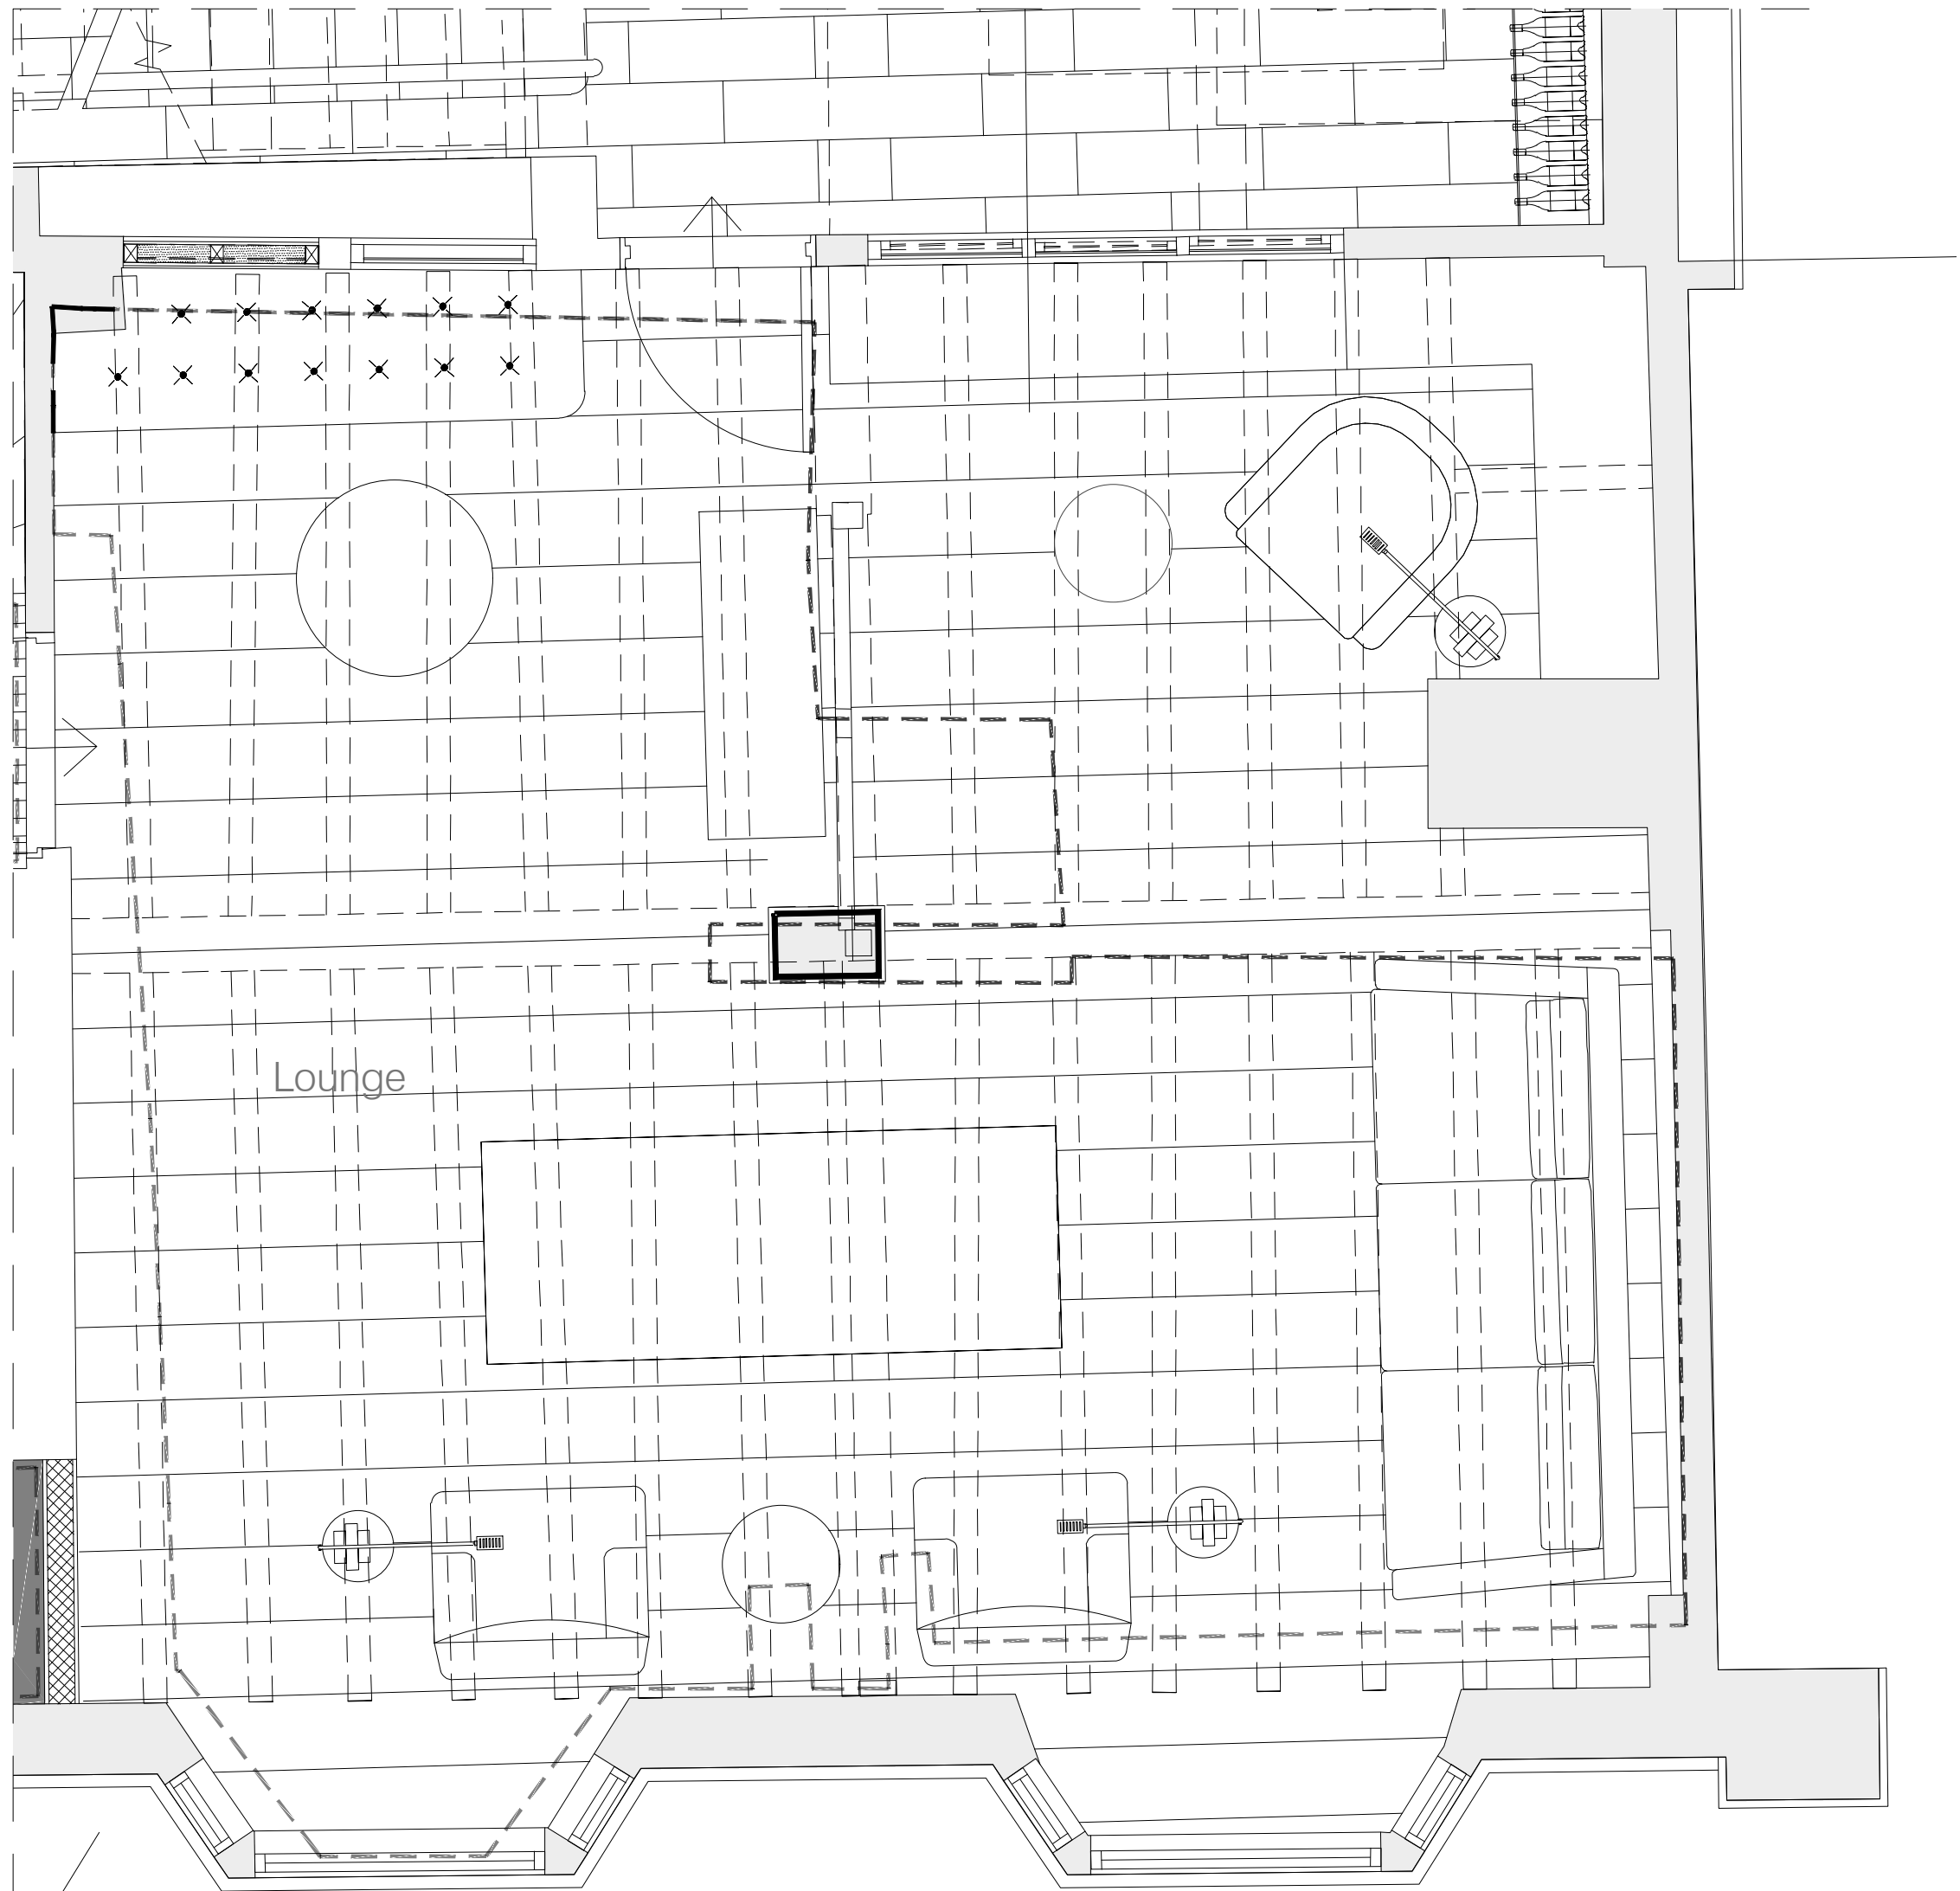

Proposed Scheme
Ground Floor Plan
Scale 1:25@A1 , 1:50@A3

Historic evidence of door hinges

Previously removed door jamb to be reinstated to make legible an original stud partition which was heavily altered in the 20th century..

Existing timber gunstock post



Historic evidence of door hinges




Internal lounge wall prior to changes.

Steel post previously replaced with timber gunstock post

Historic door jamb to be reinstated


Non-original decorative wall fillet element previously removed

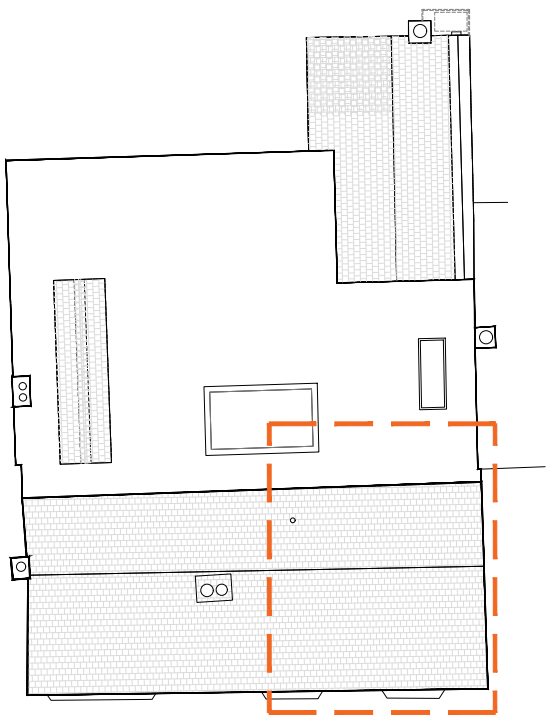

Key Plan 1:200@A1, 1:400@A3

NOTE
DRAWINGS TO BE READ IN CONJUNCTION WITH SUBMITTED
DESIGN&ACCESS STATEMENT AND HERITAGE STATEMENT
MATERIALS INSTALLED IN ACCORDANCE WITH THOSE
OUTLINED IN CONDITION #9 OF APPROVAL DM/23/1605

KEY:
Highlighted difference between Approved Scheme and 'As-Built'/Proposed Scheme

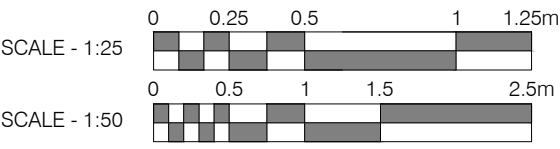

Rev.	Comments.	By:	Date:
-	-	-	-

Do not scale this drawing All dimensions must be checked on site
All rights reserved. No reproduction in any material form is permitted without consent.

LISTED BUILDING CONSENT			
Client: Mr. Simon Dougall			
Project Title: 107 High St, Lindfield, Haywards Heath, West Sussex, RH16 2HR			
Drawing Title: Detail Drawings: Ground Floor North Lounge Reinstated Door Jamb			
Scale: 1:25@A1 1:50@A3	Date: Aug 25	Drawn: KN	Checked: KW

kyson		
Studio		
28 Scrutton Street London UK EC2A 4RP		
T: +44(0) 20 7247 2462 E: enquiries@kyson.co.uk W: www.kyson.co.uk		
Project No.: 900-25	Drawing No.: 5026	Revision: -