


FOR PLANNING
AND LISTED
BUILDING CONSENT
PURPOSES ONLY


NOT FOR CONSTRUCTION

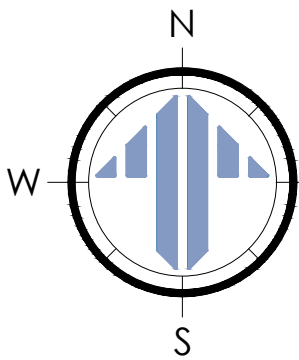


11 No sash windows to original building and 7 No casements to the historic extended portion are proposed to be renewed.

Windows proposed to be renewed are denoted in red on both plans and elevations. Renewed windows are to be like-for-like timber framed windows, with slim-profile double glazing.


See submitted information for further details.

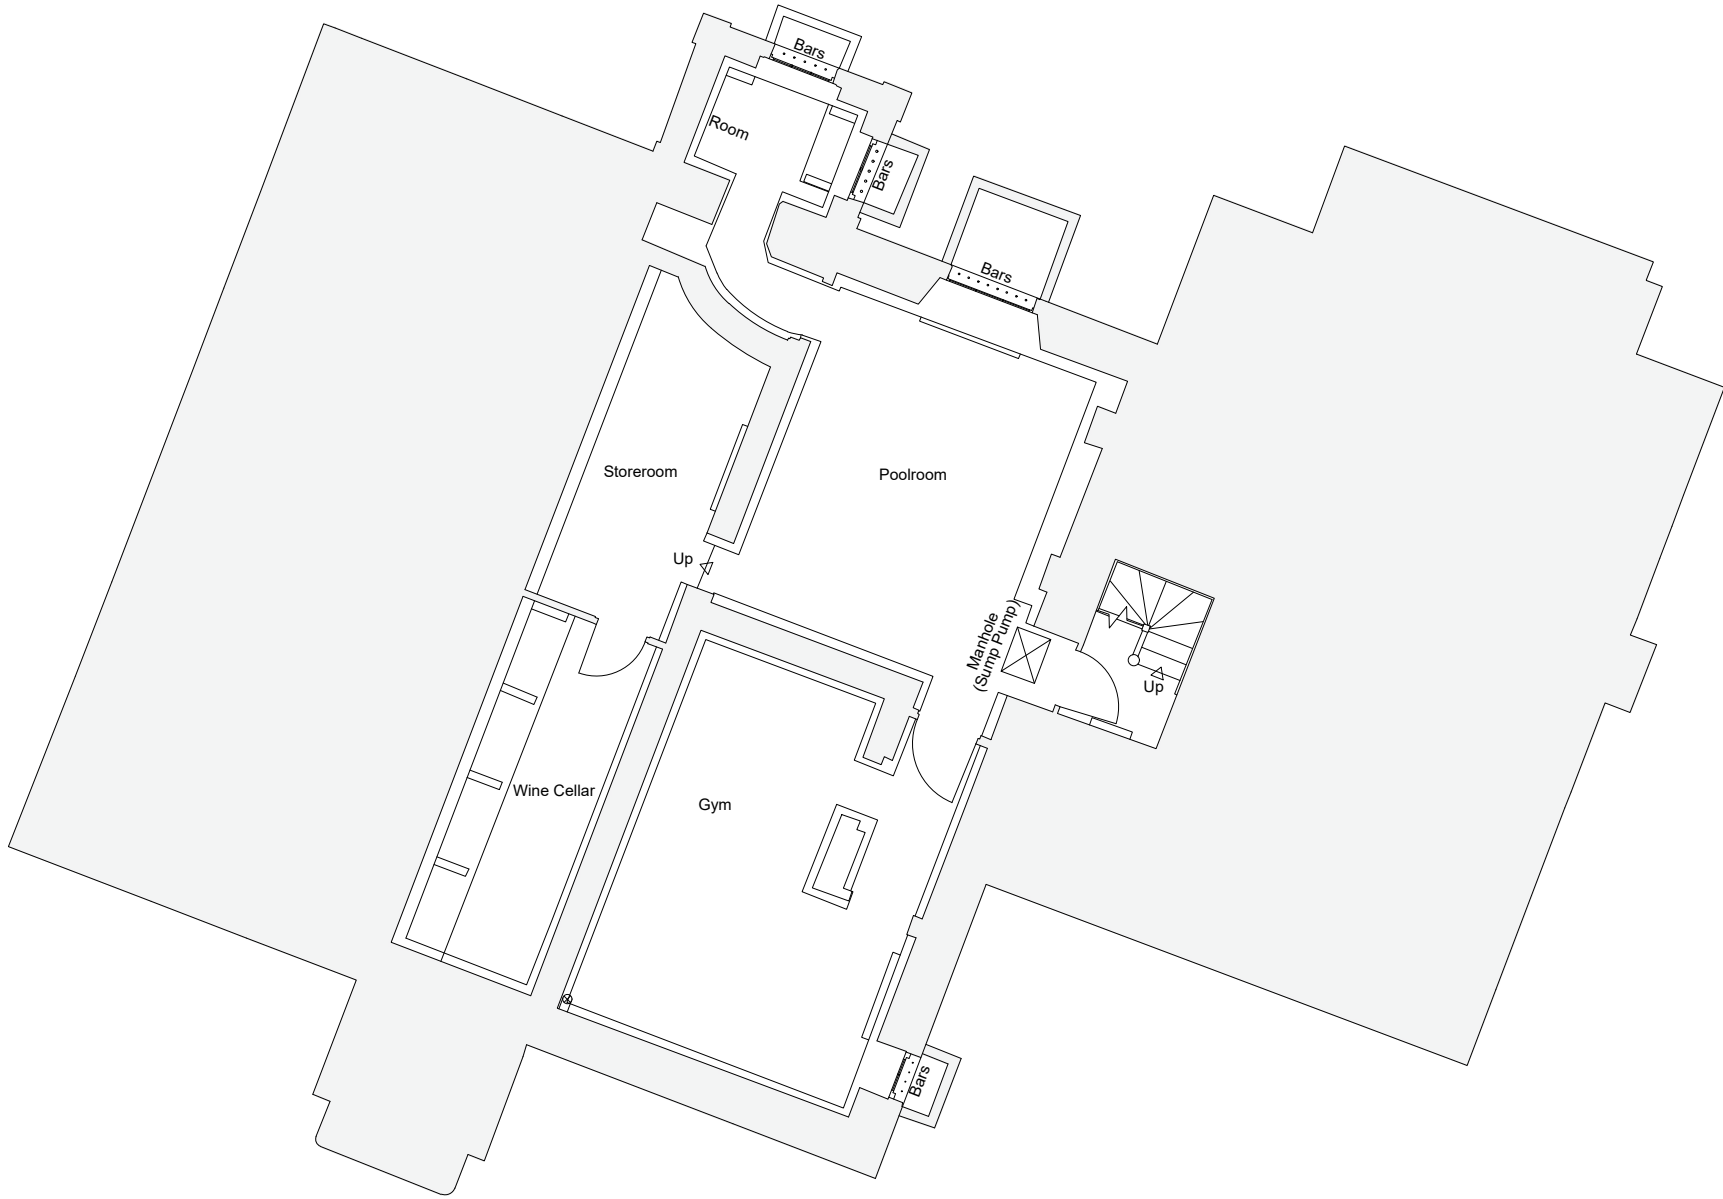


BASEMENT PLAN
SCALE @ 1:100 ON AN A1 SHEET

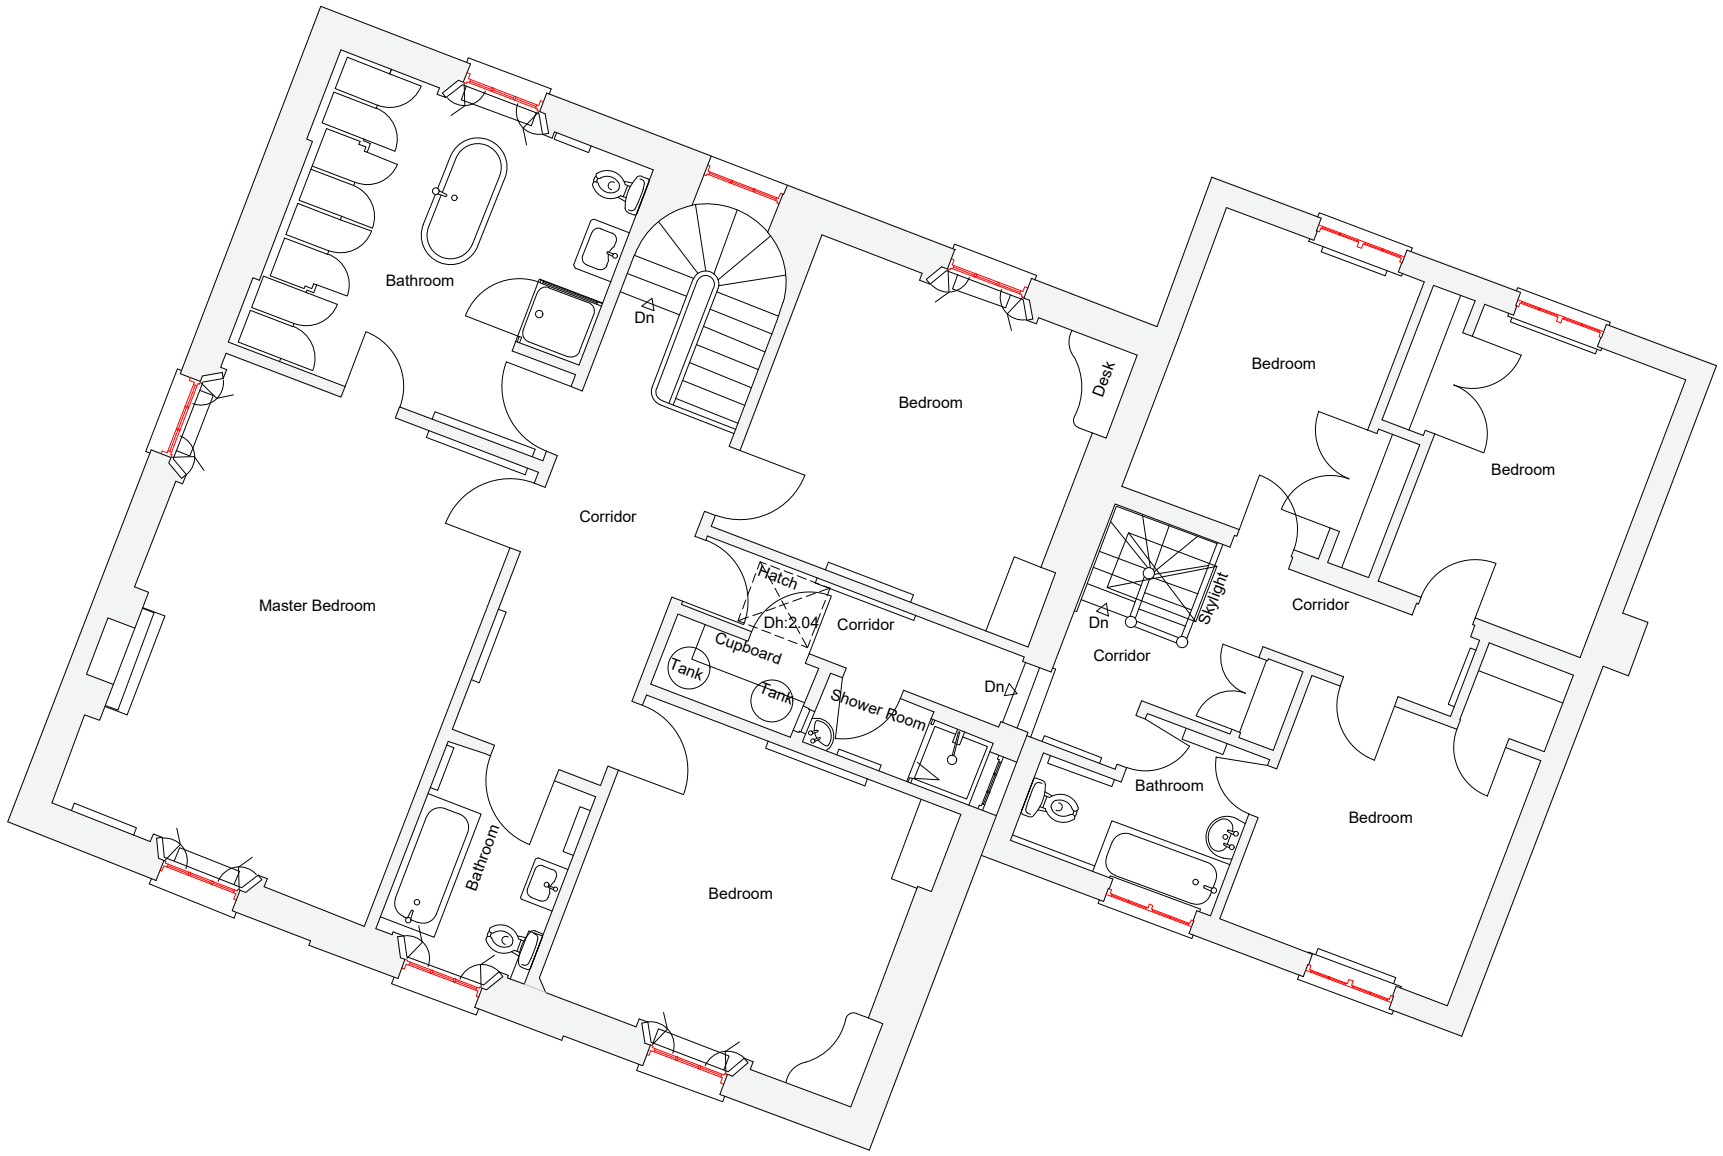


FIRST FLOOR PLAN
SCALE @ 1:100 ON AN A1 SHEET

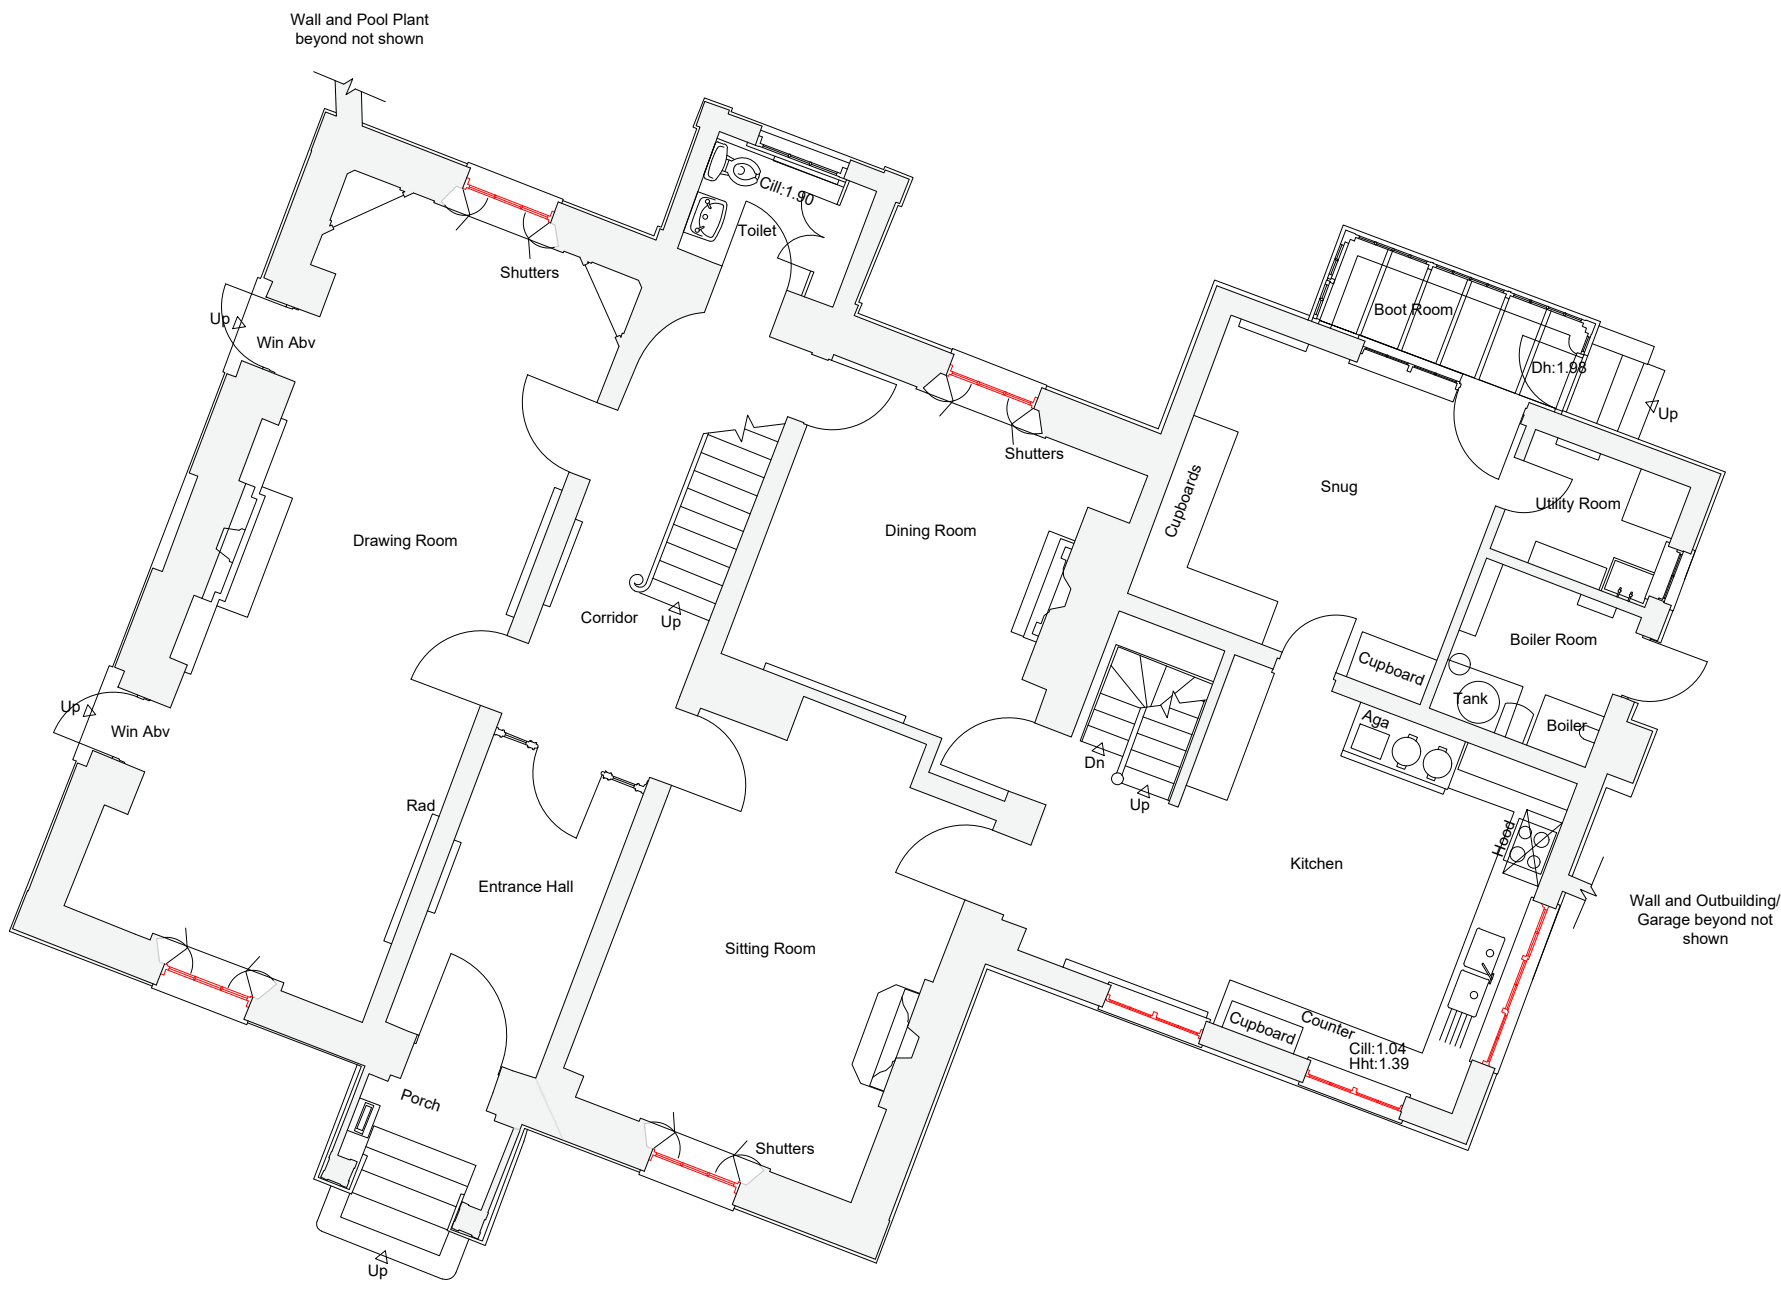

GROUND FLOOR PLAN
SCALE @ 1:100 ON AN A1 SHEET

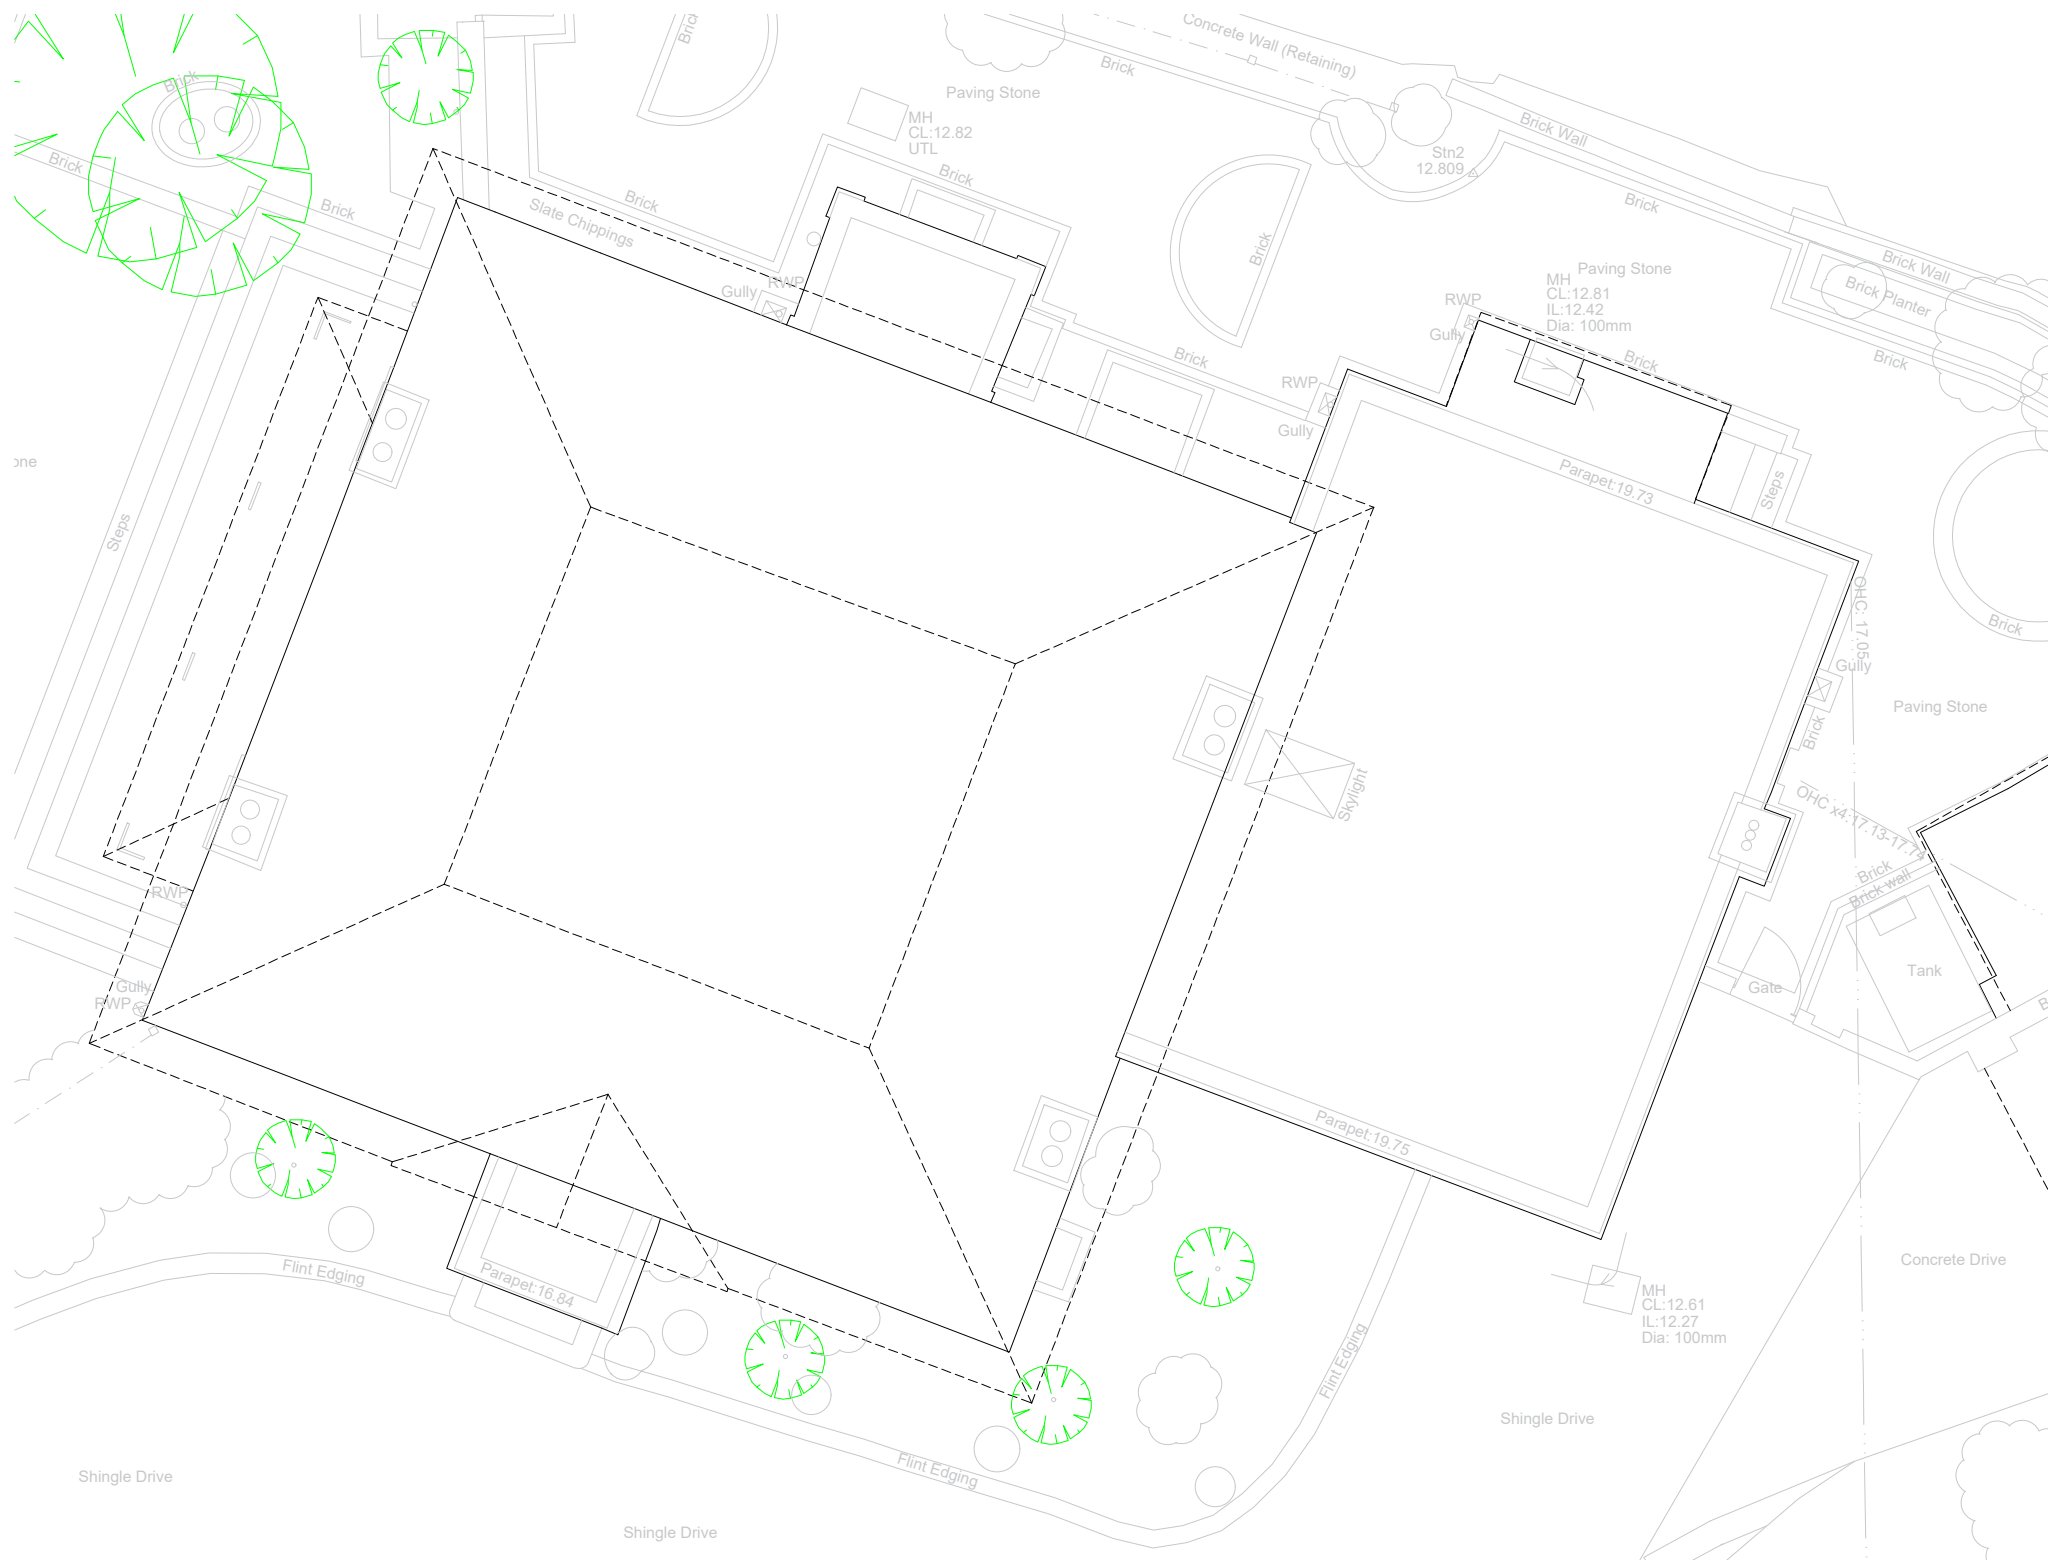

ROOF PLAN
SCALE @ 1:100 ON AN A1 SHEET

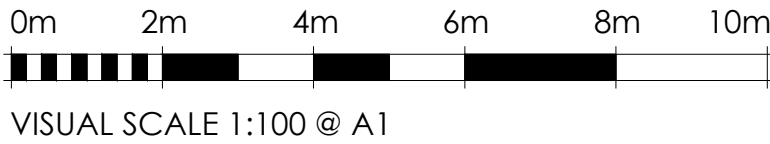

*	*	*	*	*	*
A	27.04.26	SM	Drawing number corrected	-	
REV.	DATE.	BY.	AMENDMENT.		CHK.

PLANNING



2 Lucastes Mews, Paddockhall Road,
Haywards Heath,
West Sussex, RH16 1HE
(01444) 452604
hb@gouldbaxter.co.uk
www.gouldbaxter.co.uk

NOTES:
DO NOT SCALE OFF THIS DRAWING UNLESS FOR PLANNING PURPOSES.
CHECK ALL DIMENSIONS ON SITE BEFORE ANY WORK IS COMMENCED.
ALL GOODS MATERIALS AND WORKMANSHIP MUST CONFORM WITH
CURRENT BUILDING REGULATIONS, BRITISH STANDARDS AND CODES OF
PRACTICE.

COPYRIGHT OF THIS DRAWING IS RETAINED BY GOULD PROPERTY
CONSULTANTS LTD T/A GOULD BAXTER AND IT MUST NOT BE REPRODUCED
WITHOUT WRITTEN CONSENT.

CLIENT:
Mr & Mrs Hatcher

PROJECT:
Old Rectory,
Church Lane,
Twineham,
RH17 5NR

DRAWING:
Floor Plans - As Proposed

DATE.	SCALE AT A1.	DRAWN BY.
24.04.2026	1:100	SM
		CHECKED BY. -

JOB NO.	DRAWING NO.	REV.
GH1169	PL.10	A