


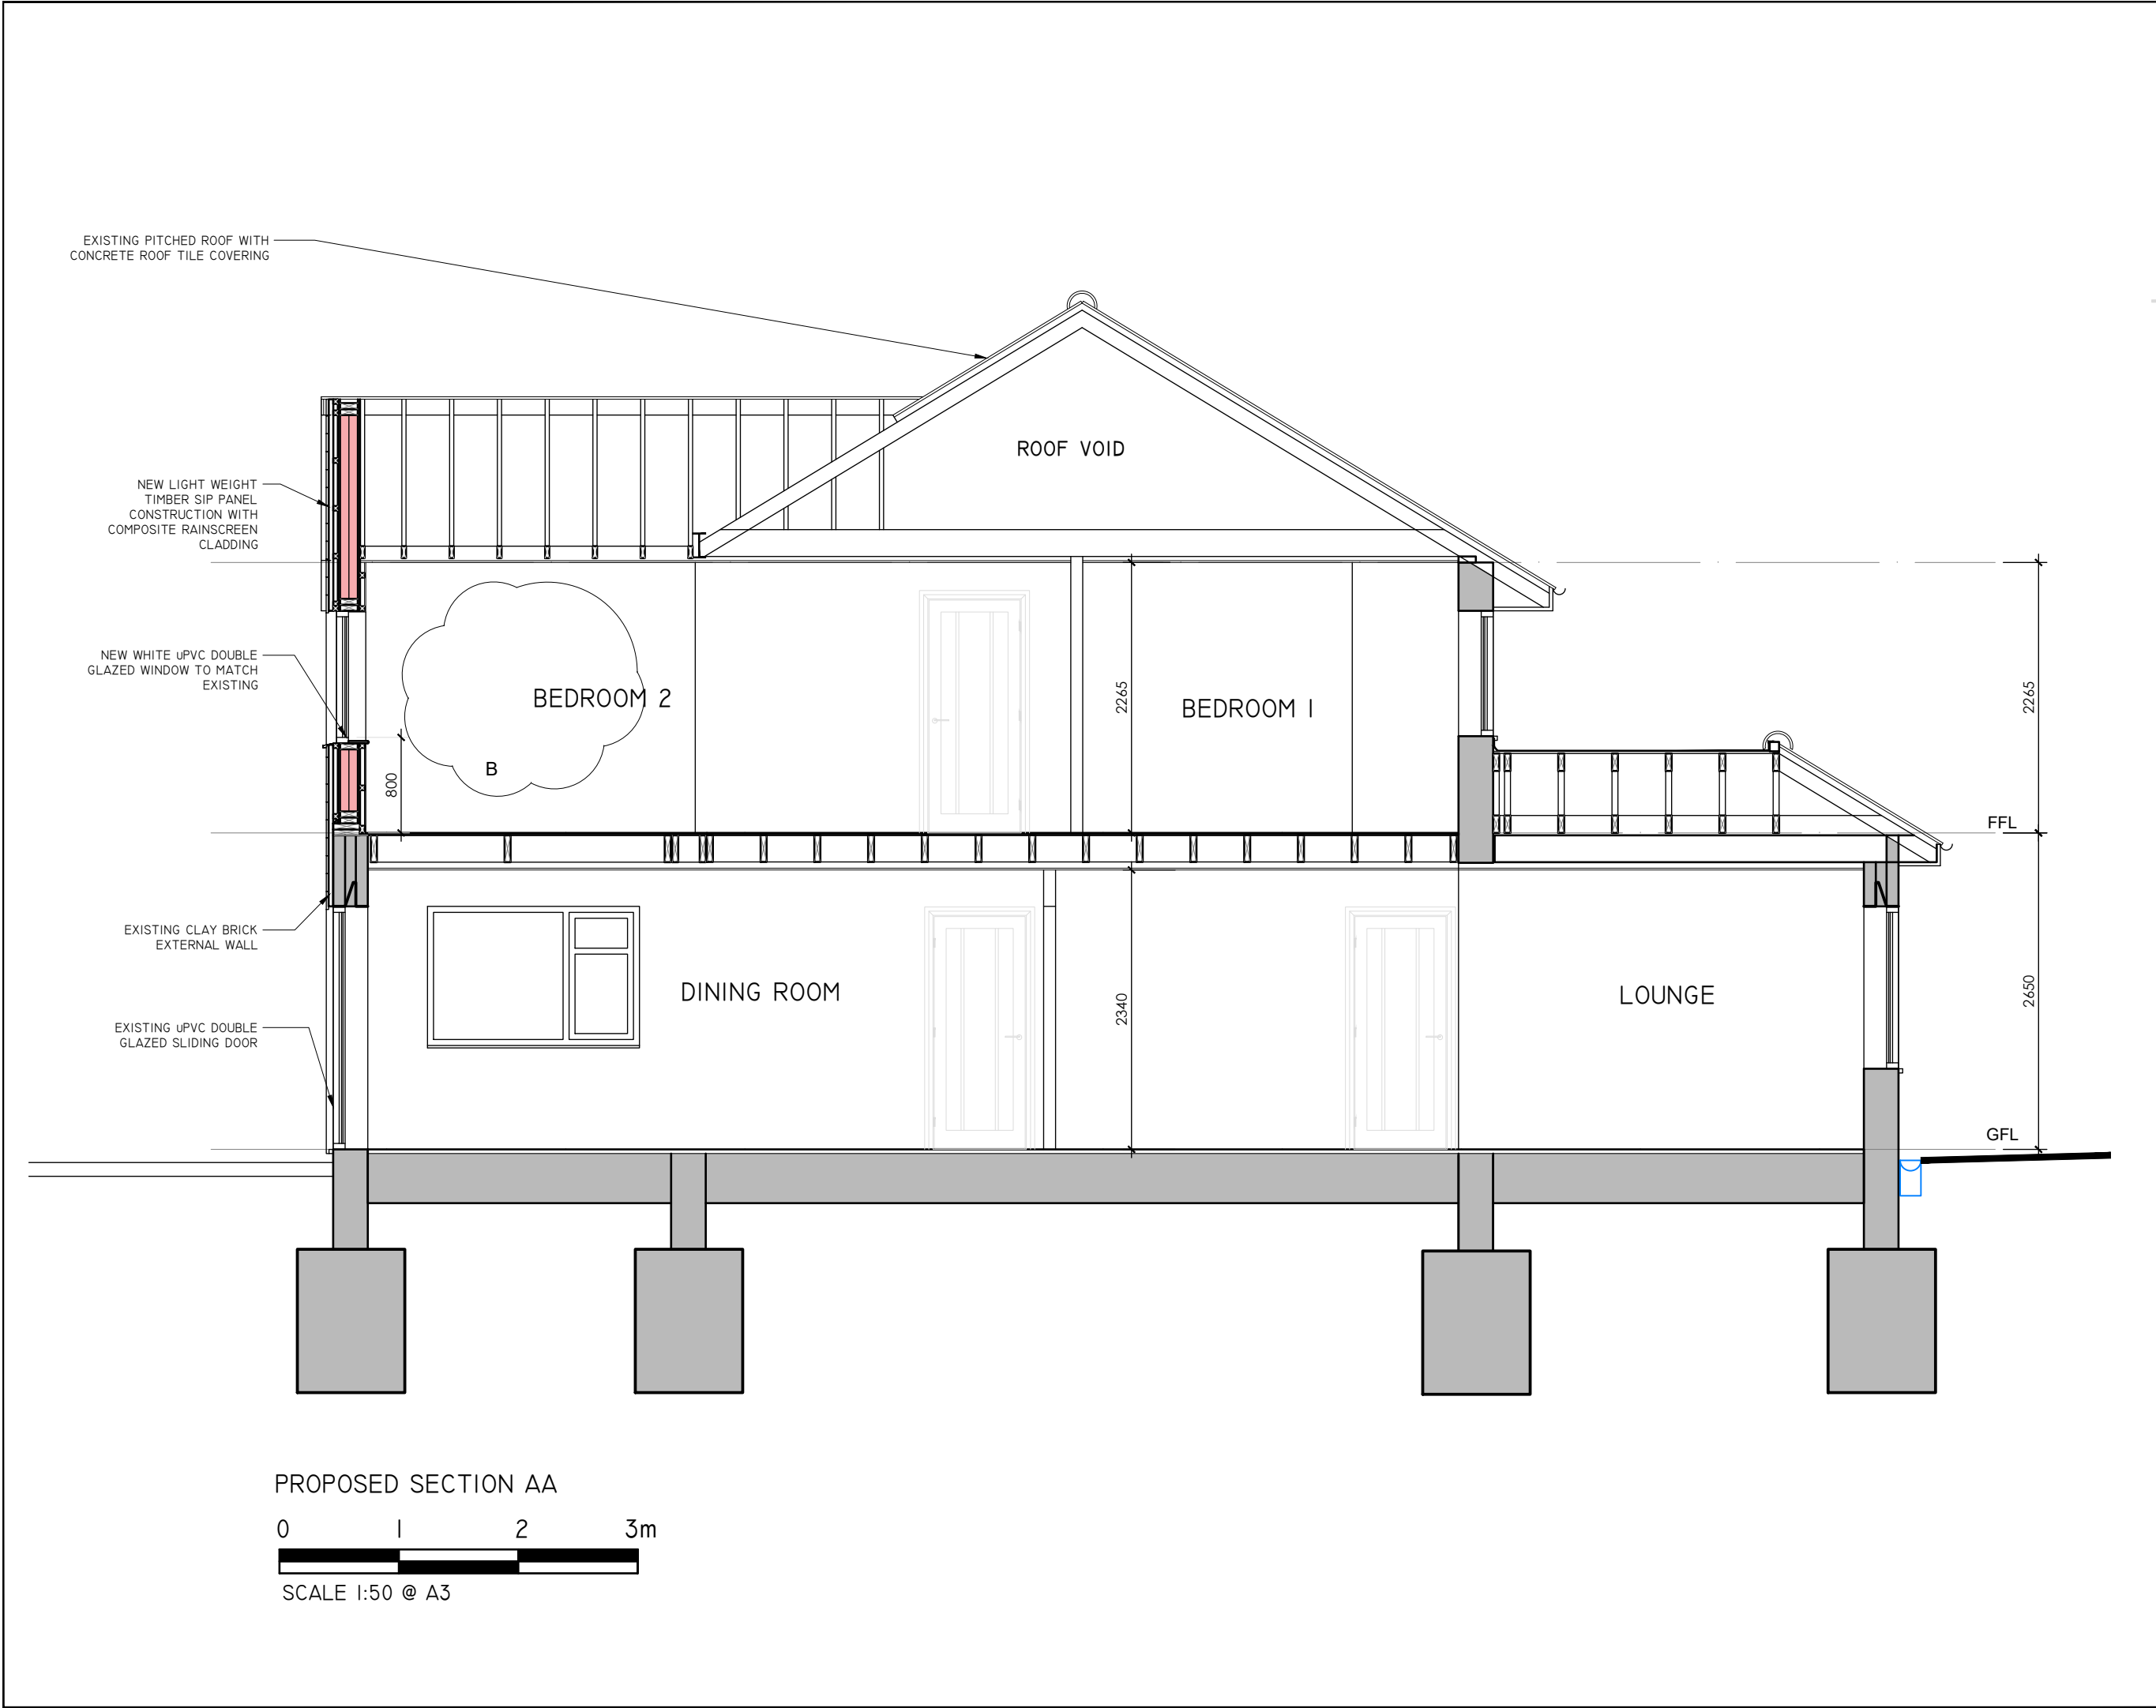

THIS DRAWING IS COPYRIGHT AND MUST NOT BE REISSUED, LOANED OR COPIED WITHOUT THE WRITTEN CONSENT OF PAUL WILLIAMS.

ALL DIMENSIONS MUST BE CHECKED ON SITE BEFORE PROCEEDING AND ANY DISCREPANCIES NOTIFIED IMMEDIATELY.

ALL SETTING OUT ON SITE IS THE RESPONSIBILITY OF THE CONTRACTOR

Notes:

AS BUILT

CONSTRUCTION

TENDER

BUILDING CONTROL

PLANNING

DESIGN

B	18.10.25	Removed window
		Removed skylight
A	15.10.25	and added window
Rev:	Date:	Amendment:



PAUL RICHARD WILLIAMS
DESIGN AND BUILD
CONSULTANCY

42 Mill Green Road
Haywards Heath
West Sussex
RH16 1XQ

0773 245 1708

Client
George Couchman

Project Address:
3
Sheppards Walk
Hassocks
WEST SUSSEX
BN6 8EA

Project Title:
HSE Couchman
Alterations and extension

Drawing Title:
PROPOSED SECTION A-A

Drawing Ref:
D006

Scale	: AS SHOWN @ A3
Date	: Oct 2025
Rev	: B
Drawn By	: PRW