
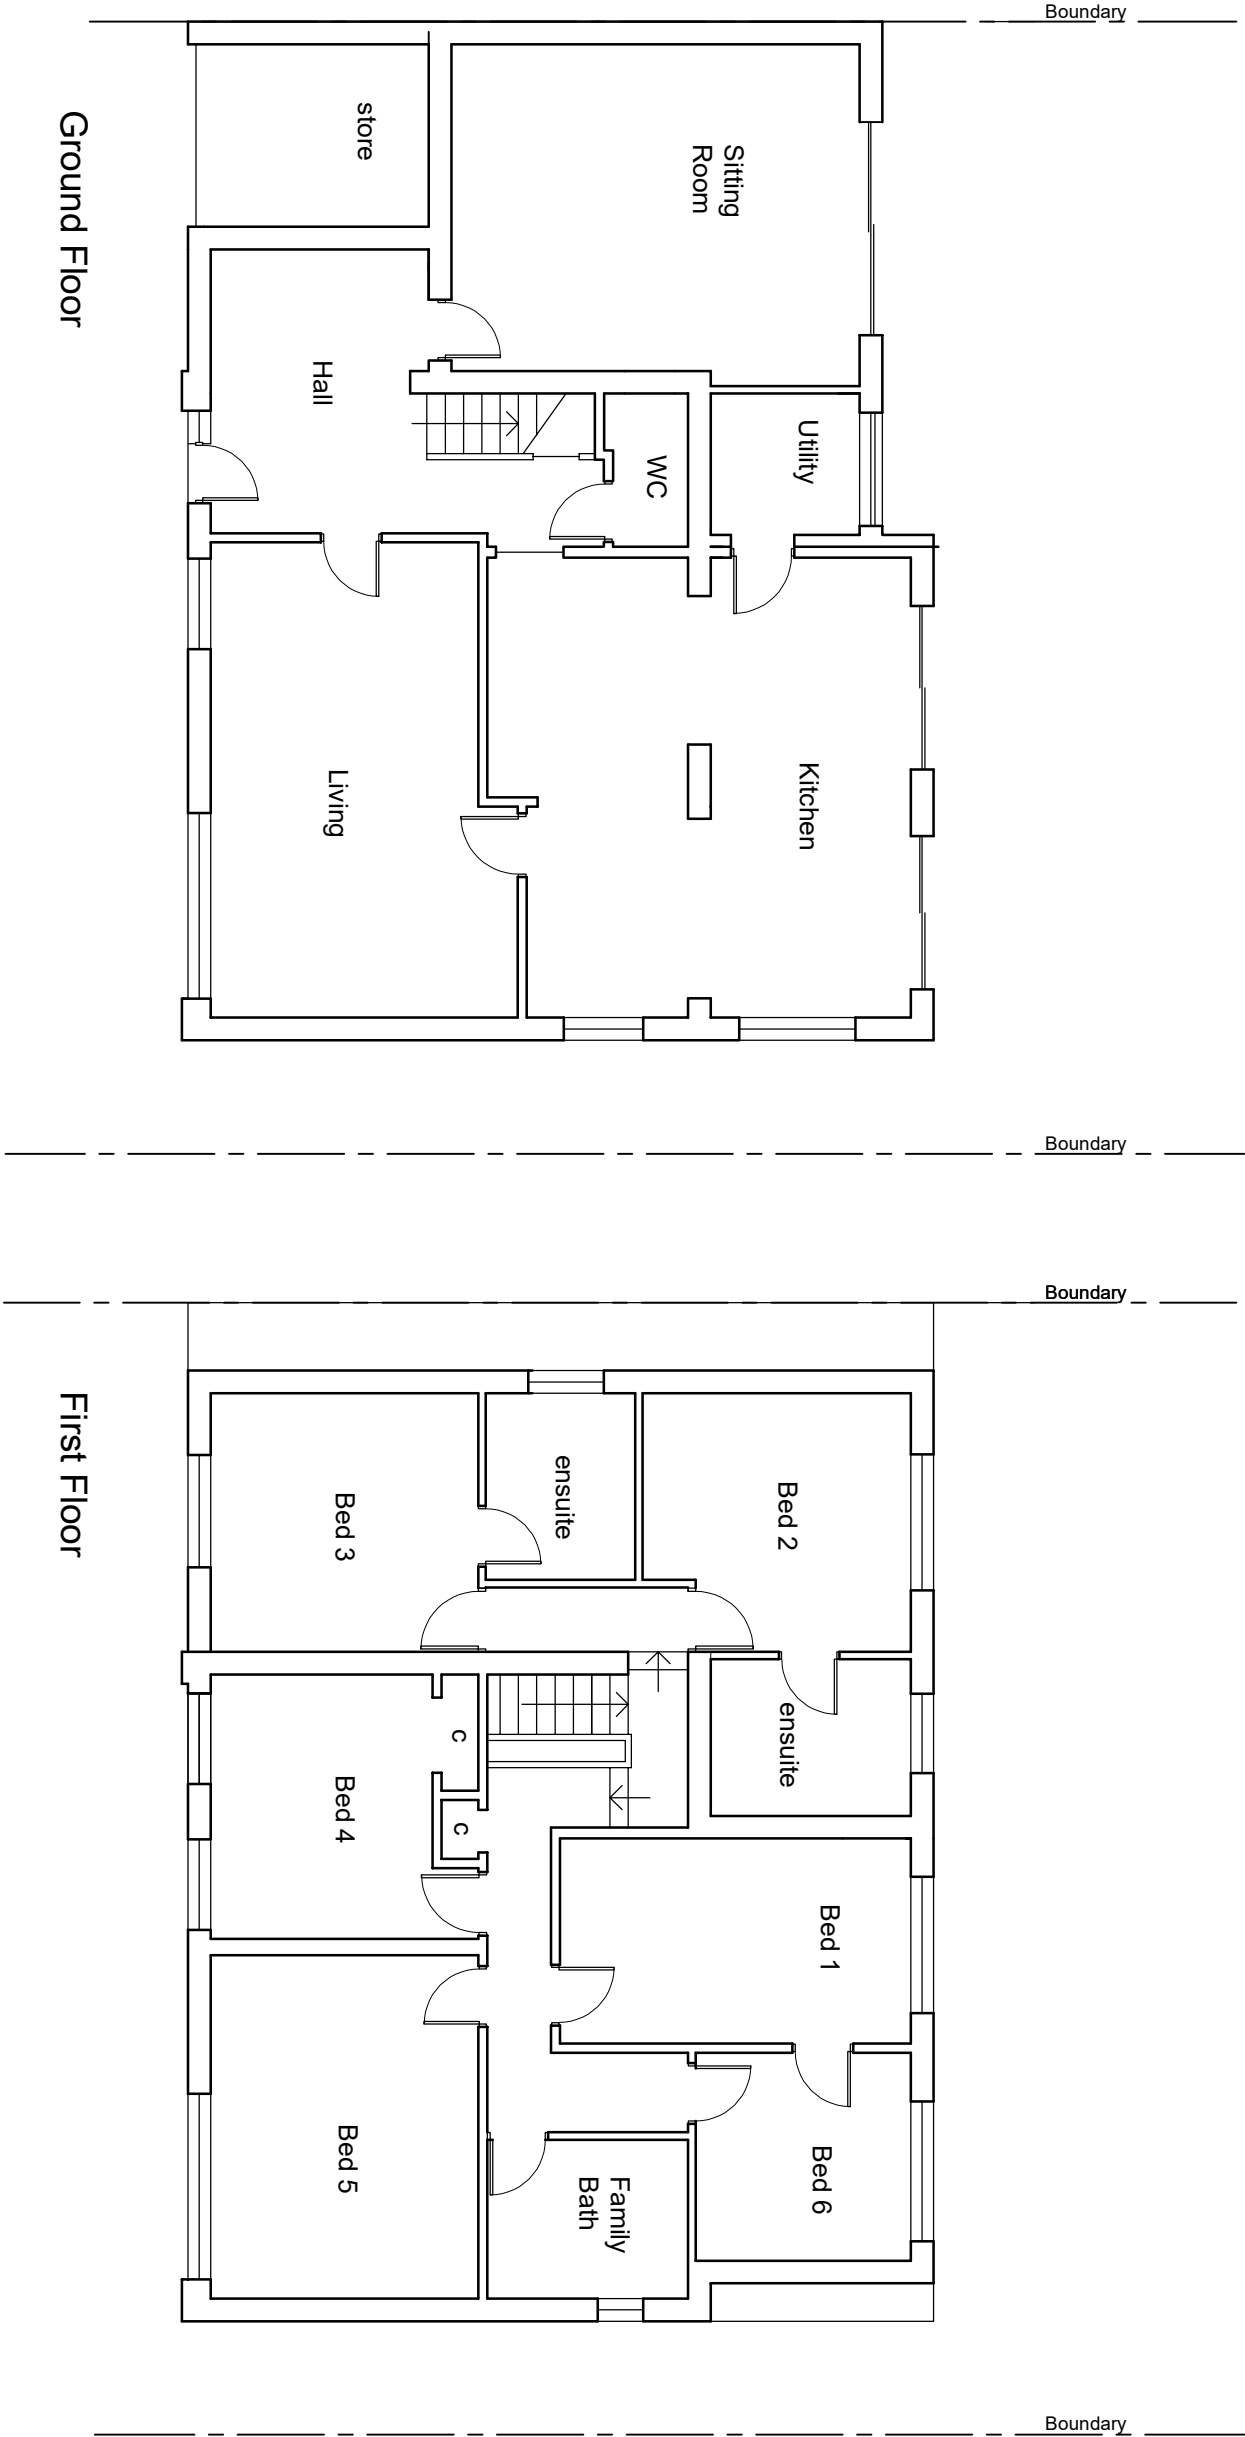


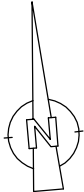

Project

43 Wilderness Road, Hurstpierpoint

Drawing Title

As Built Floor Plans

Project No.

WR43

Drawing No.

SK11

Scale

1:100 @ A3

Date

Drawn