




Side - North

Side - Rear

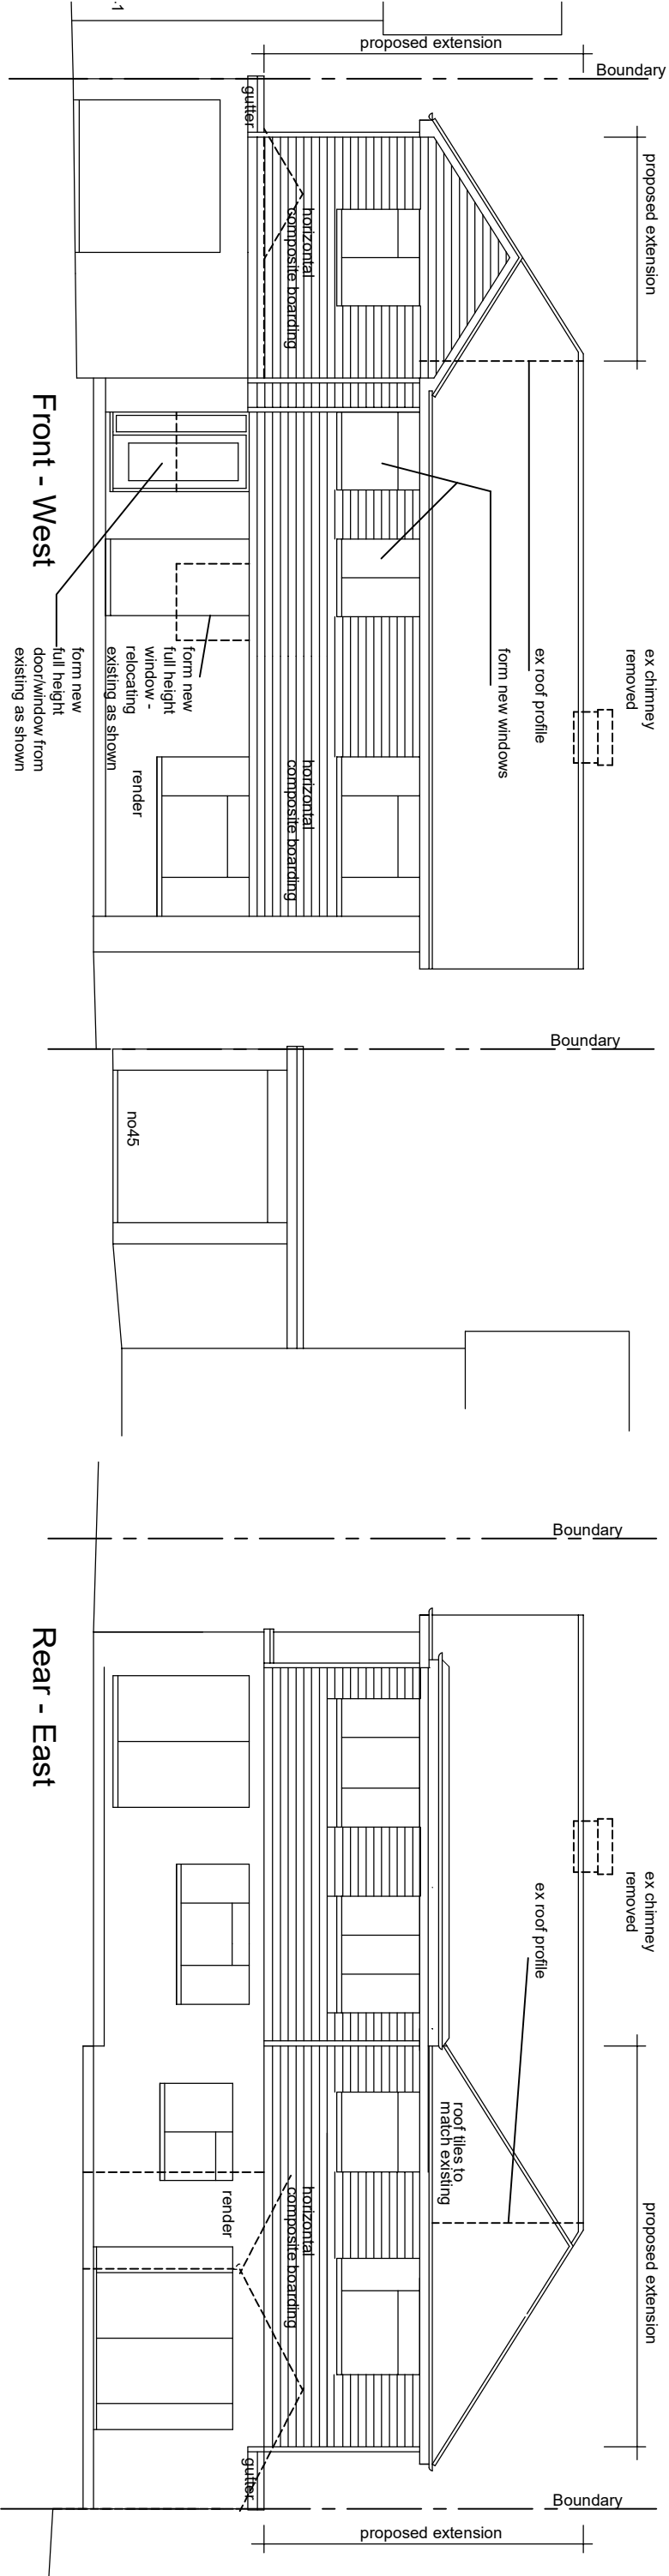

Project

43 Wilderness Road, Hurstpierpoint

Drawing Title

As Built Elevations

Project No.

WR43

Drawing No.

sk02 B

Scale

1:100 @ A3

Date

Drawn