
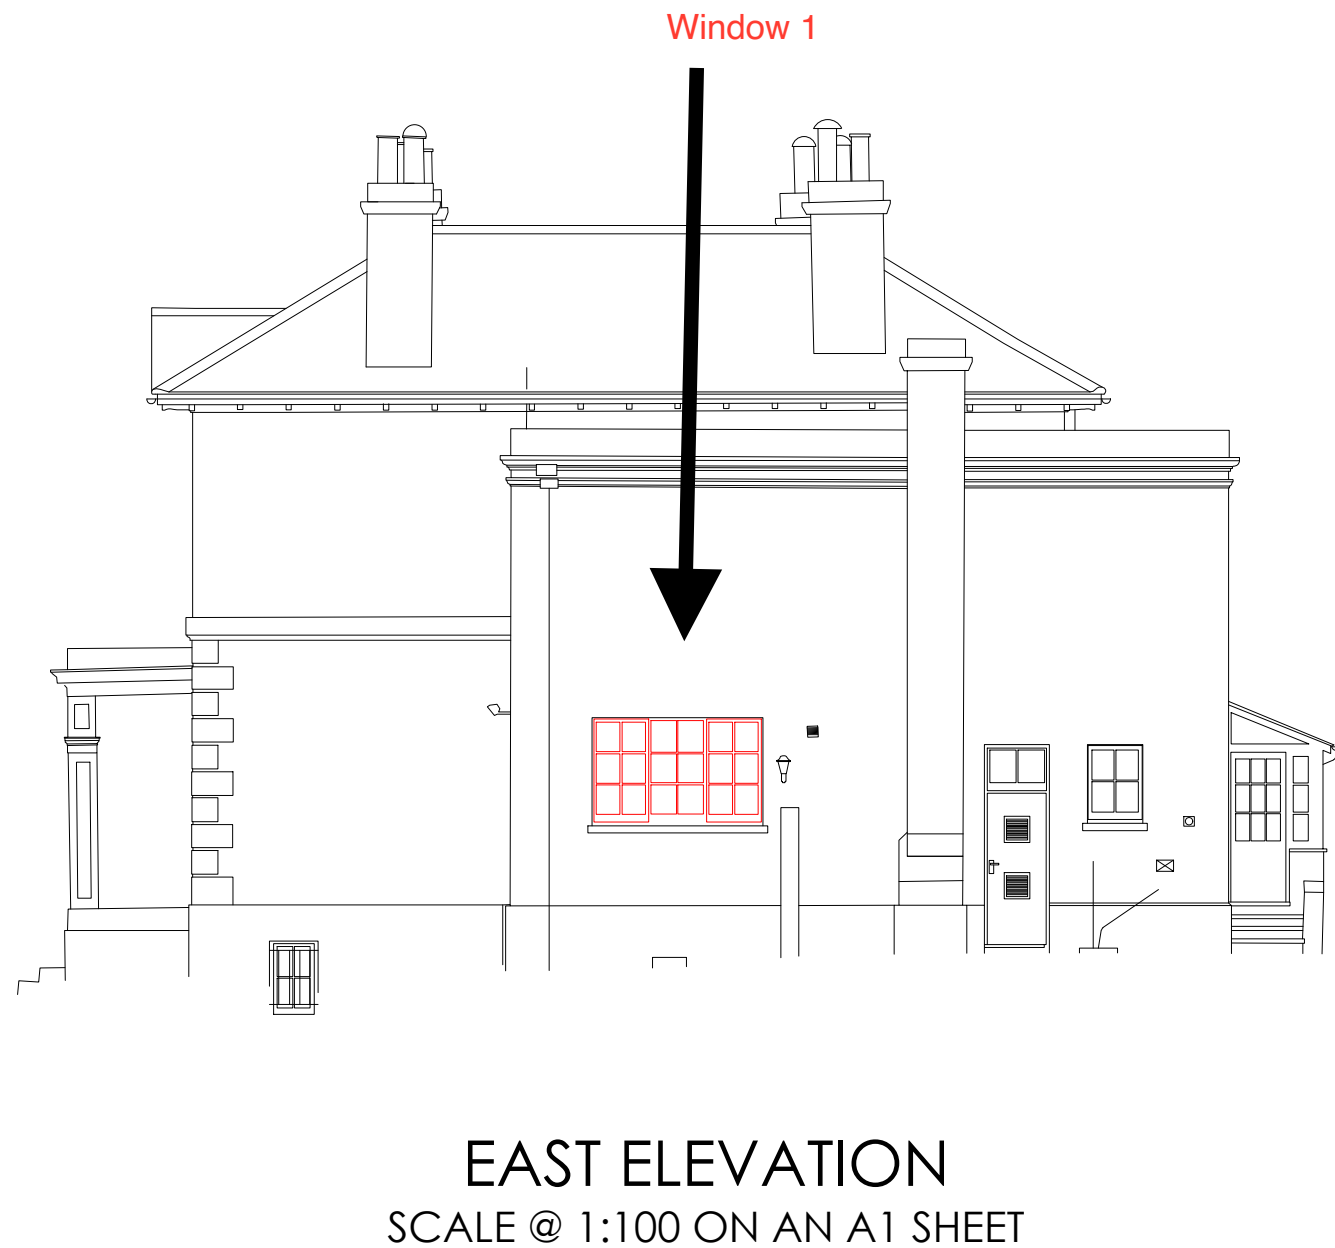
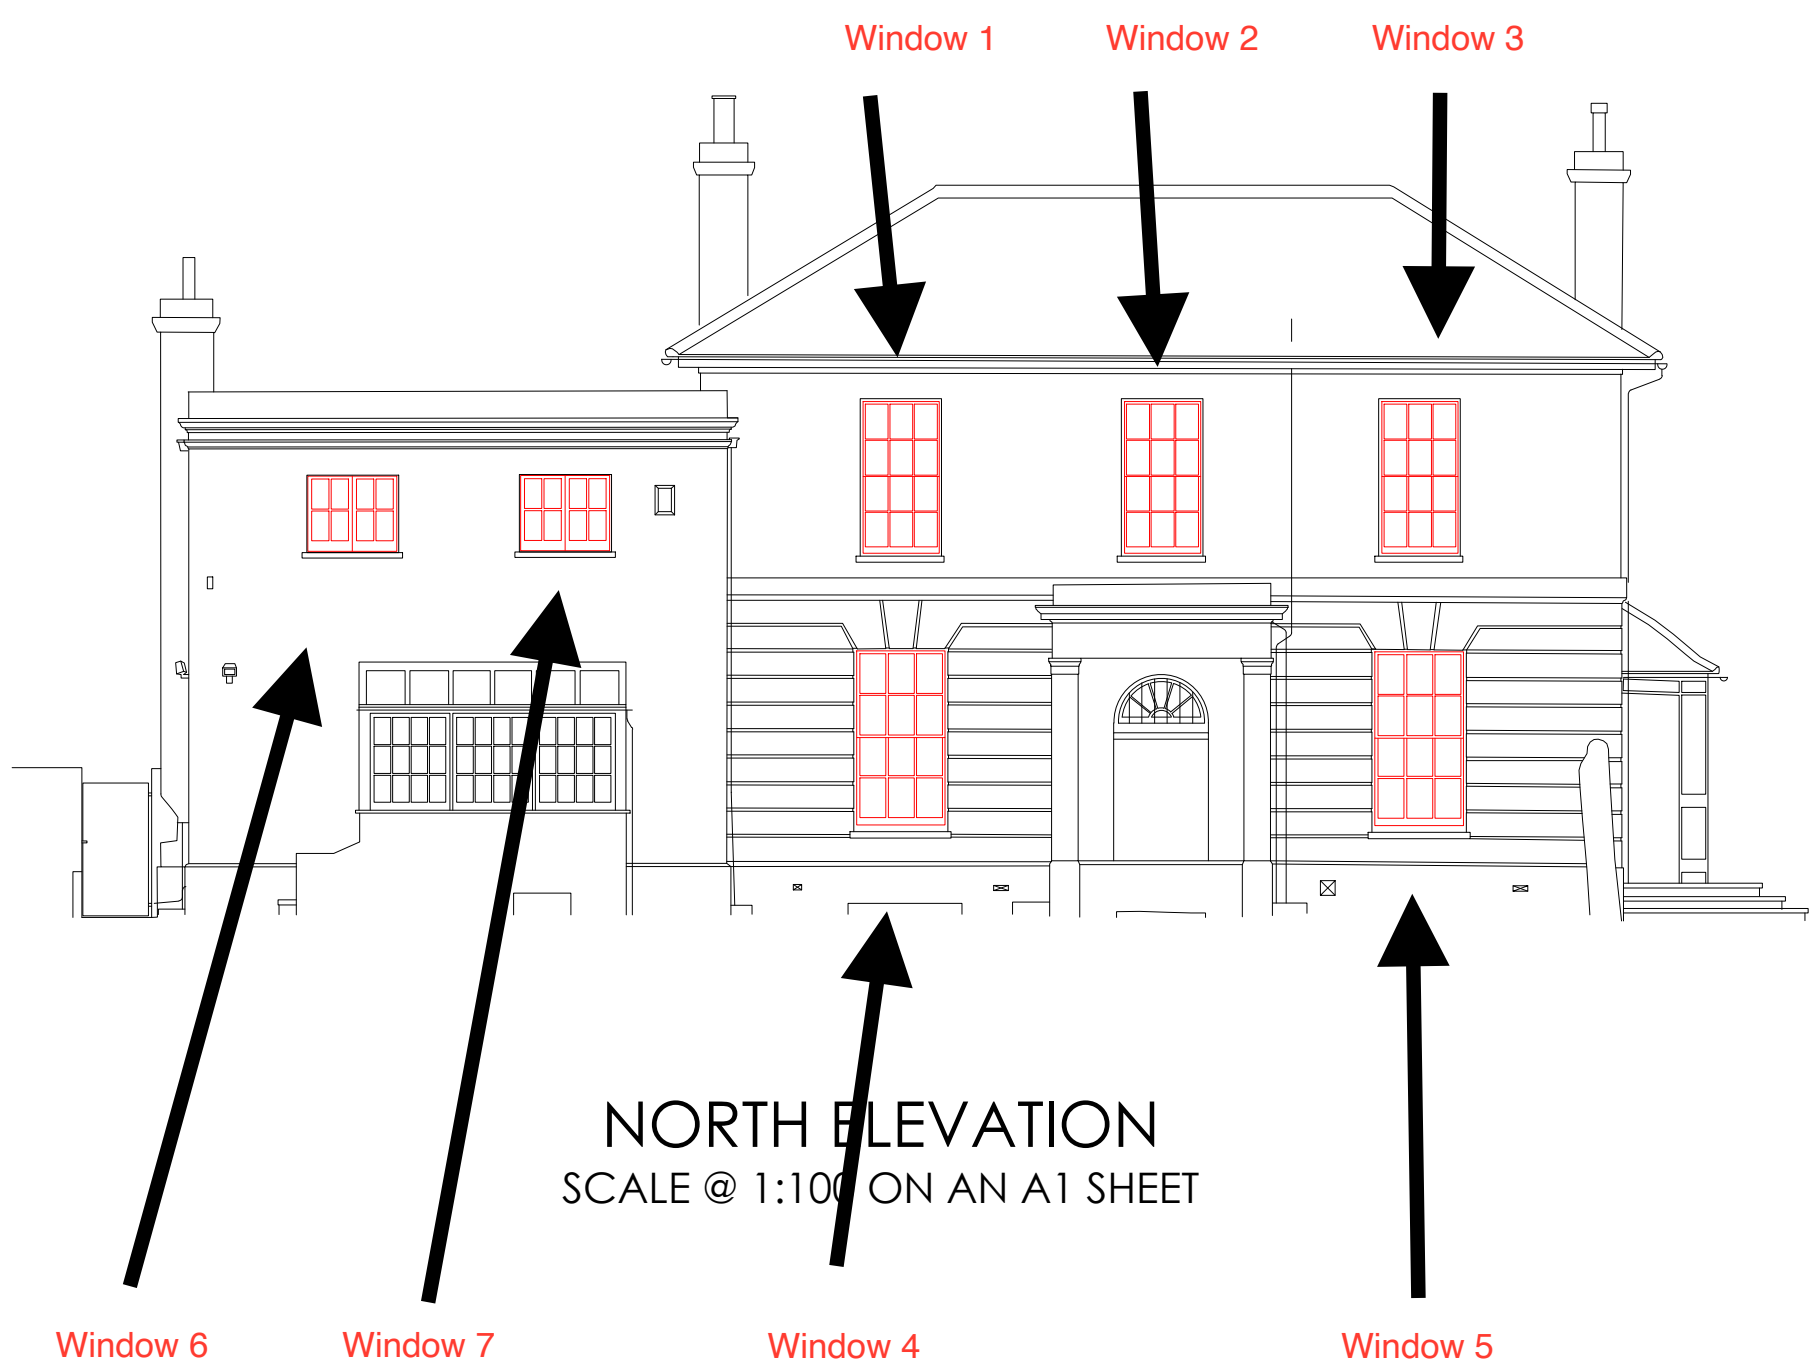


FOR PLANNING
AND LISTED
BUILDING CONSENT
PURPOSES ONLY

NOT FOR CONSTRUCTION

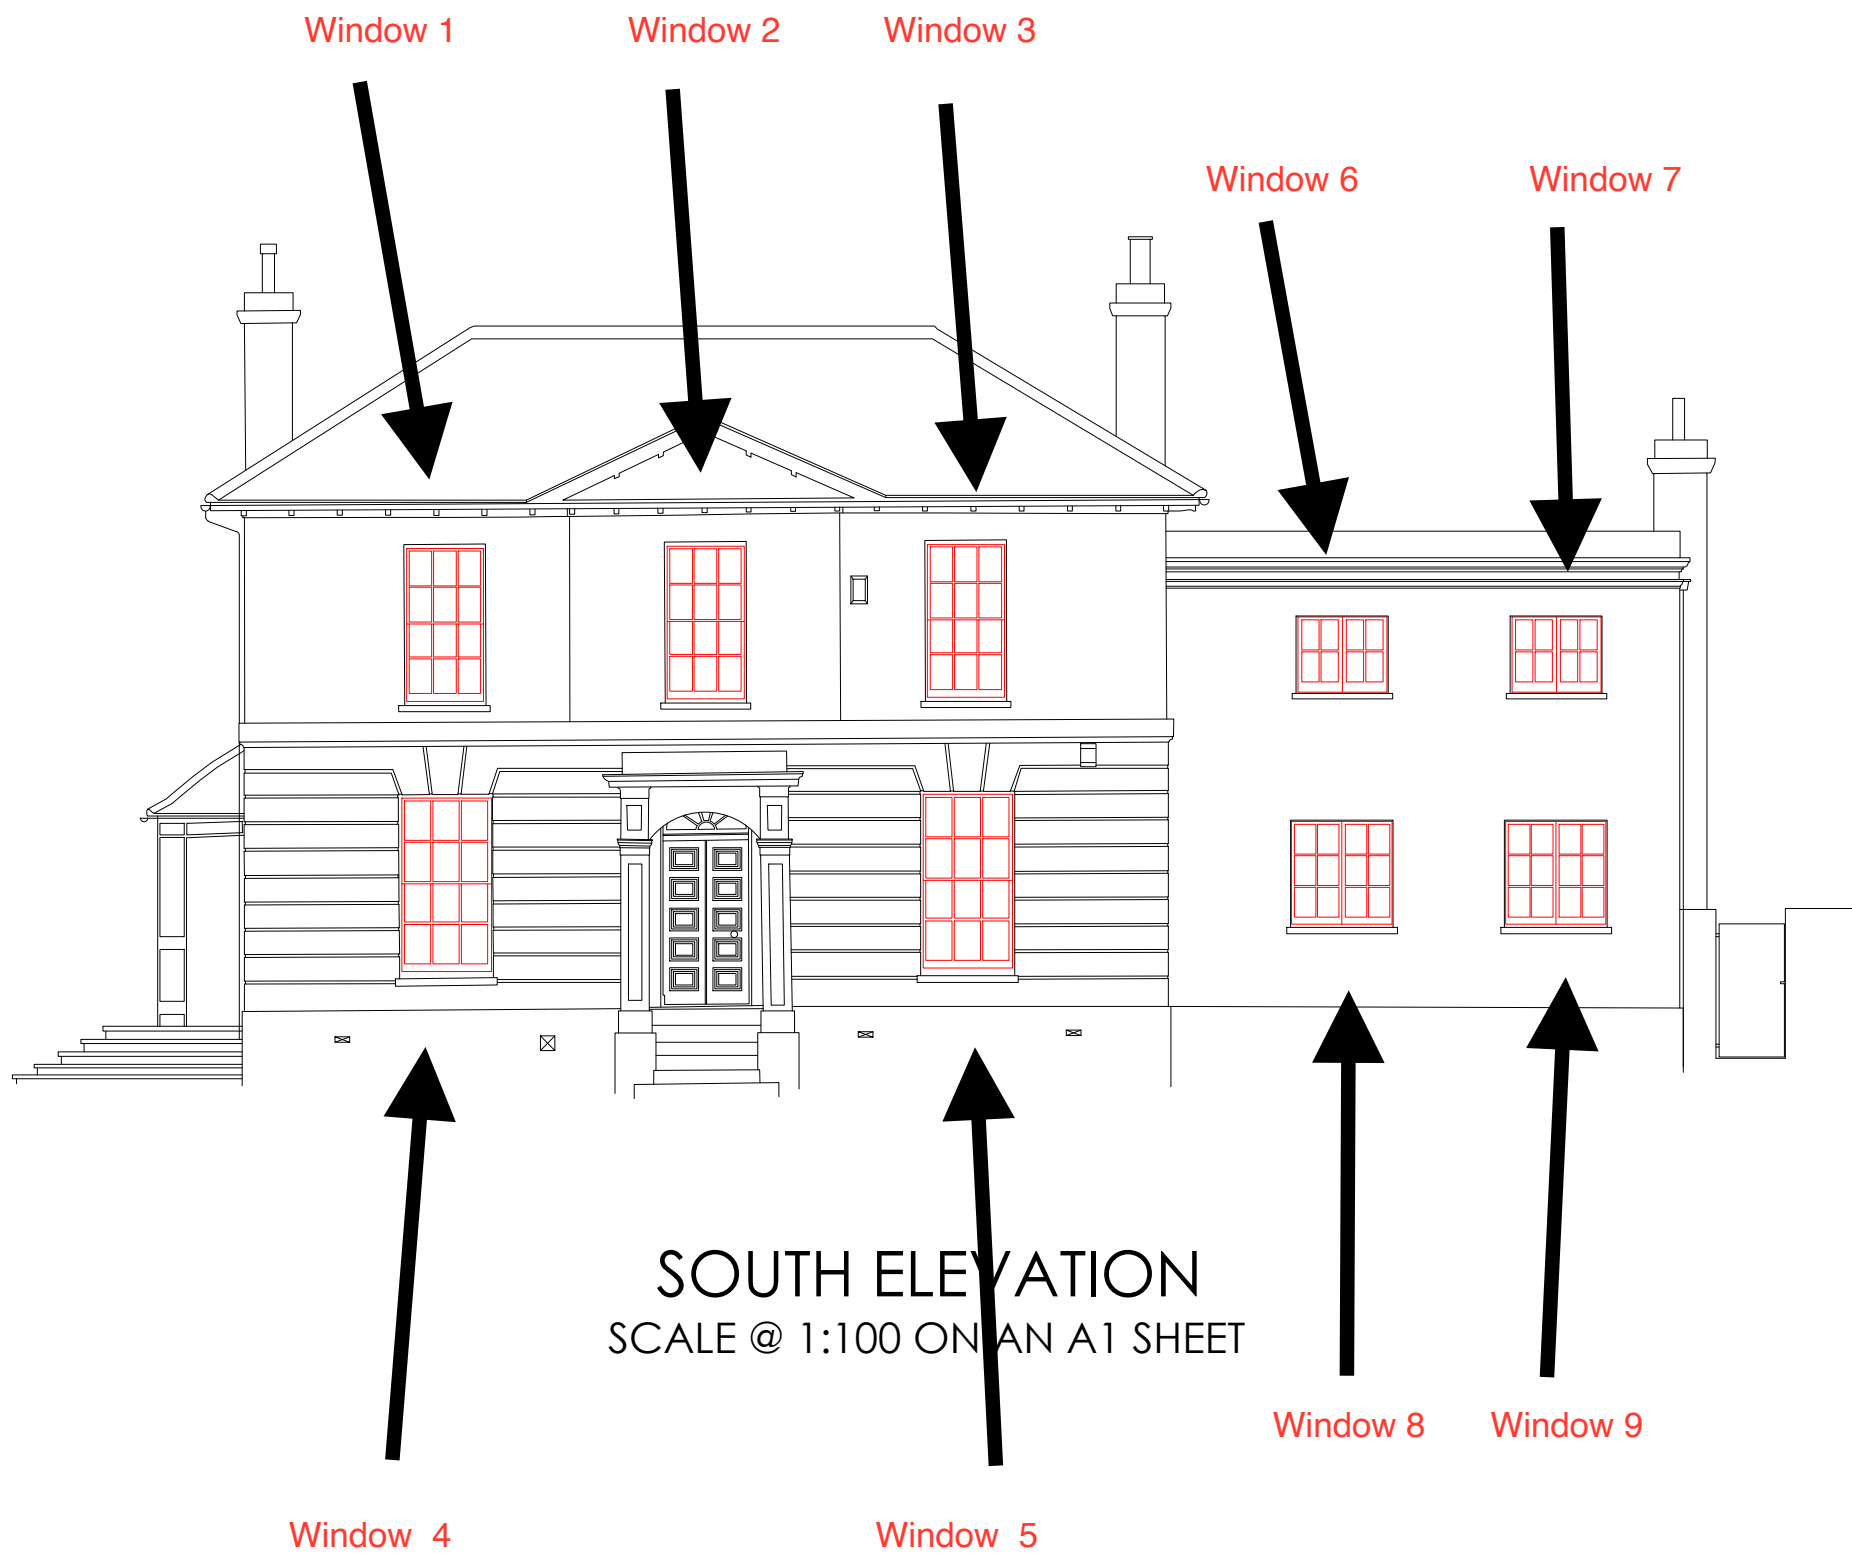

11 No sash windows to original building and 7 No casements to the historic extended portion are proposed to be renewed.

Windows proposed to be renewed are denoted in red on both plans and elevations. Renewed windows are to be like-for-like timber framed windows, with slim-profile double glazing.

See submitted information for further details.

*	*	*	*		*
REV.	DATE.	BY.	AMENDMENT.		CHK.
PLANNING					
					
2 Lucastes Mews, Paddockhall Road, Haywards Heath, West Sussex, RH16 1HE (01444) 452604 hb@gouldbaxter.co.uk www.gouldbaxter.co.uk					
NOTES: DO NOT SCALE OFF THIS DRAWING UNLESS FOR PLANNING PURPOSES. CHECK ALL DIMENSIONS ON SITE BEFORE ANY WORK IS COMMENCED. ALL GOODS MATERIALS AND WORKMANSHIP MUST CONFORM WITH CURRENT BUILDING REGULATIONS, BRITISH STANDARDS AND CODES OF PRACTICE. COPYRIGHT OF THIS DRAWING IS RETAINED BY GOULD PROPERTY CONSULTANTS LLP T/A GOULD BAXTER AND IT MUST NOT BE REPRODUCED WITHOUT WRITTEN CONSENT.					
CLIENT: Mr & Mrs Hatcher					
PROJECT: Old Rectory, Church Lane, Twineham, RH17 5NR					
DRAWING: Elevations - As Proposed					
DATE: 24.04.2026	SCALE AT A1: 1:100	DRAWN BY: SM CHECKED BY: -			
JOB NO. GH1169	DRAWING NO. PL.11	REV. *			

