



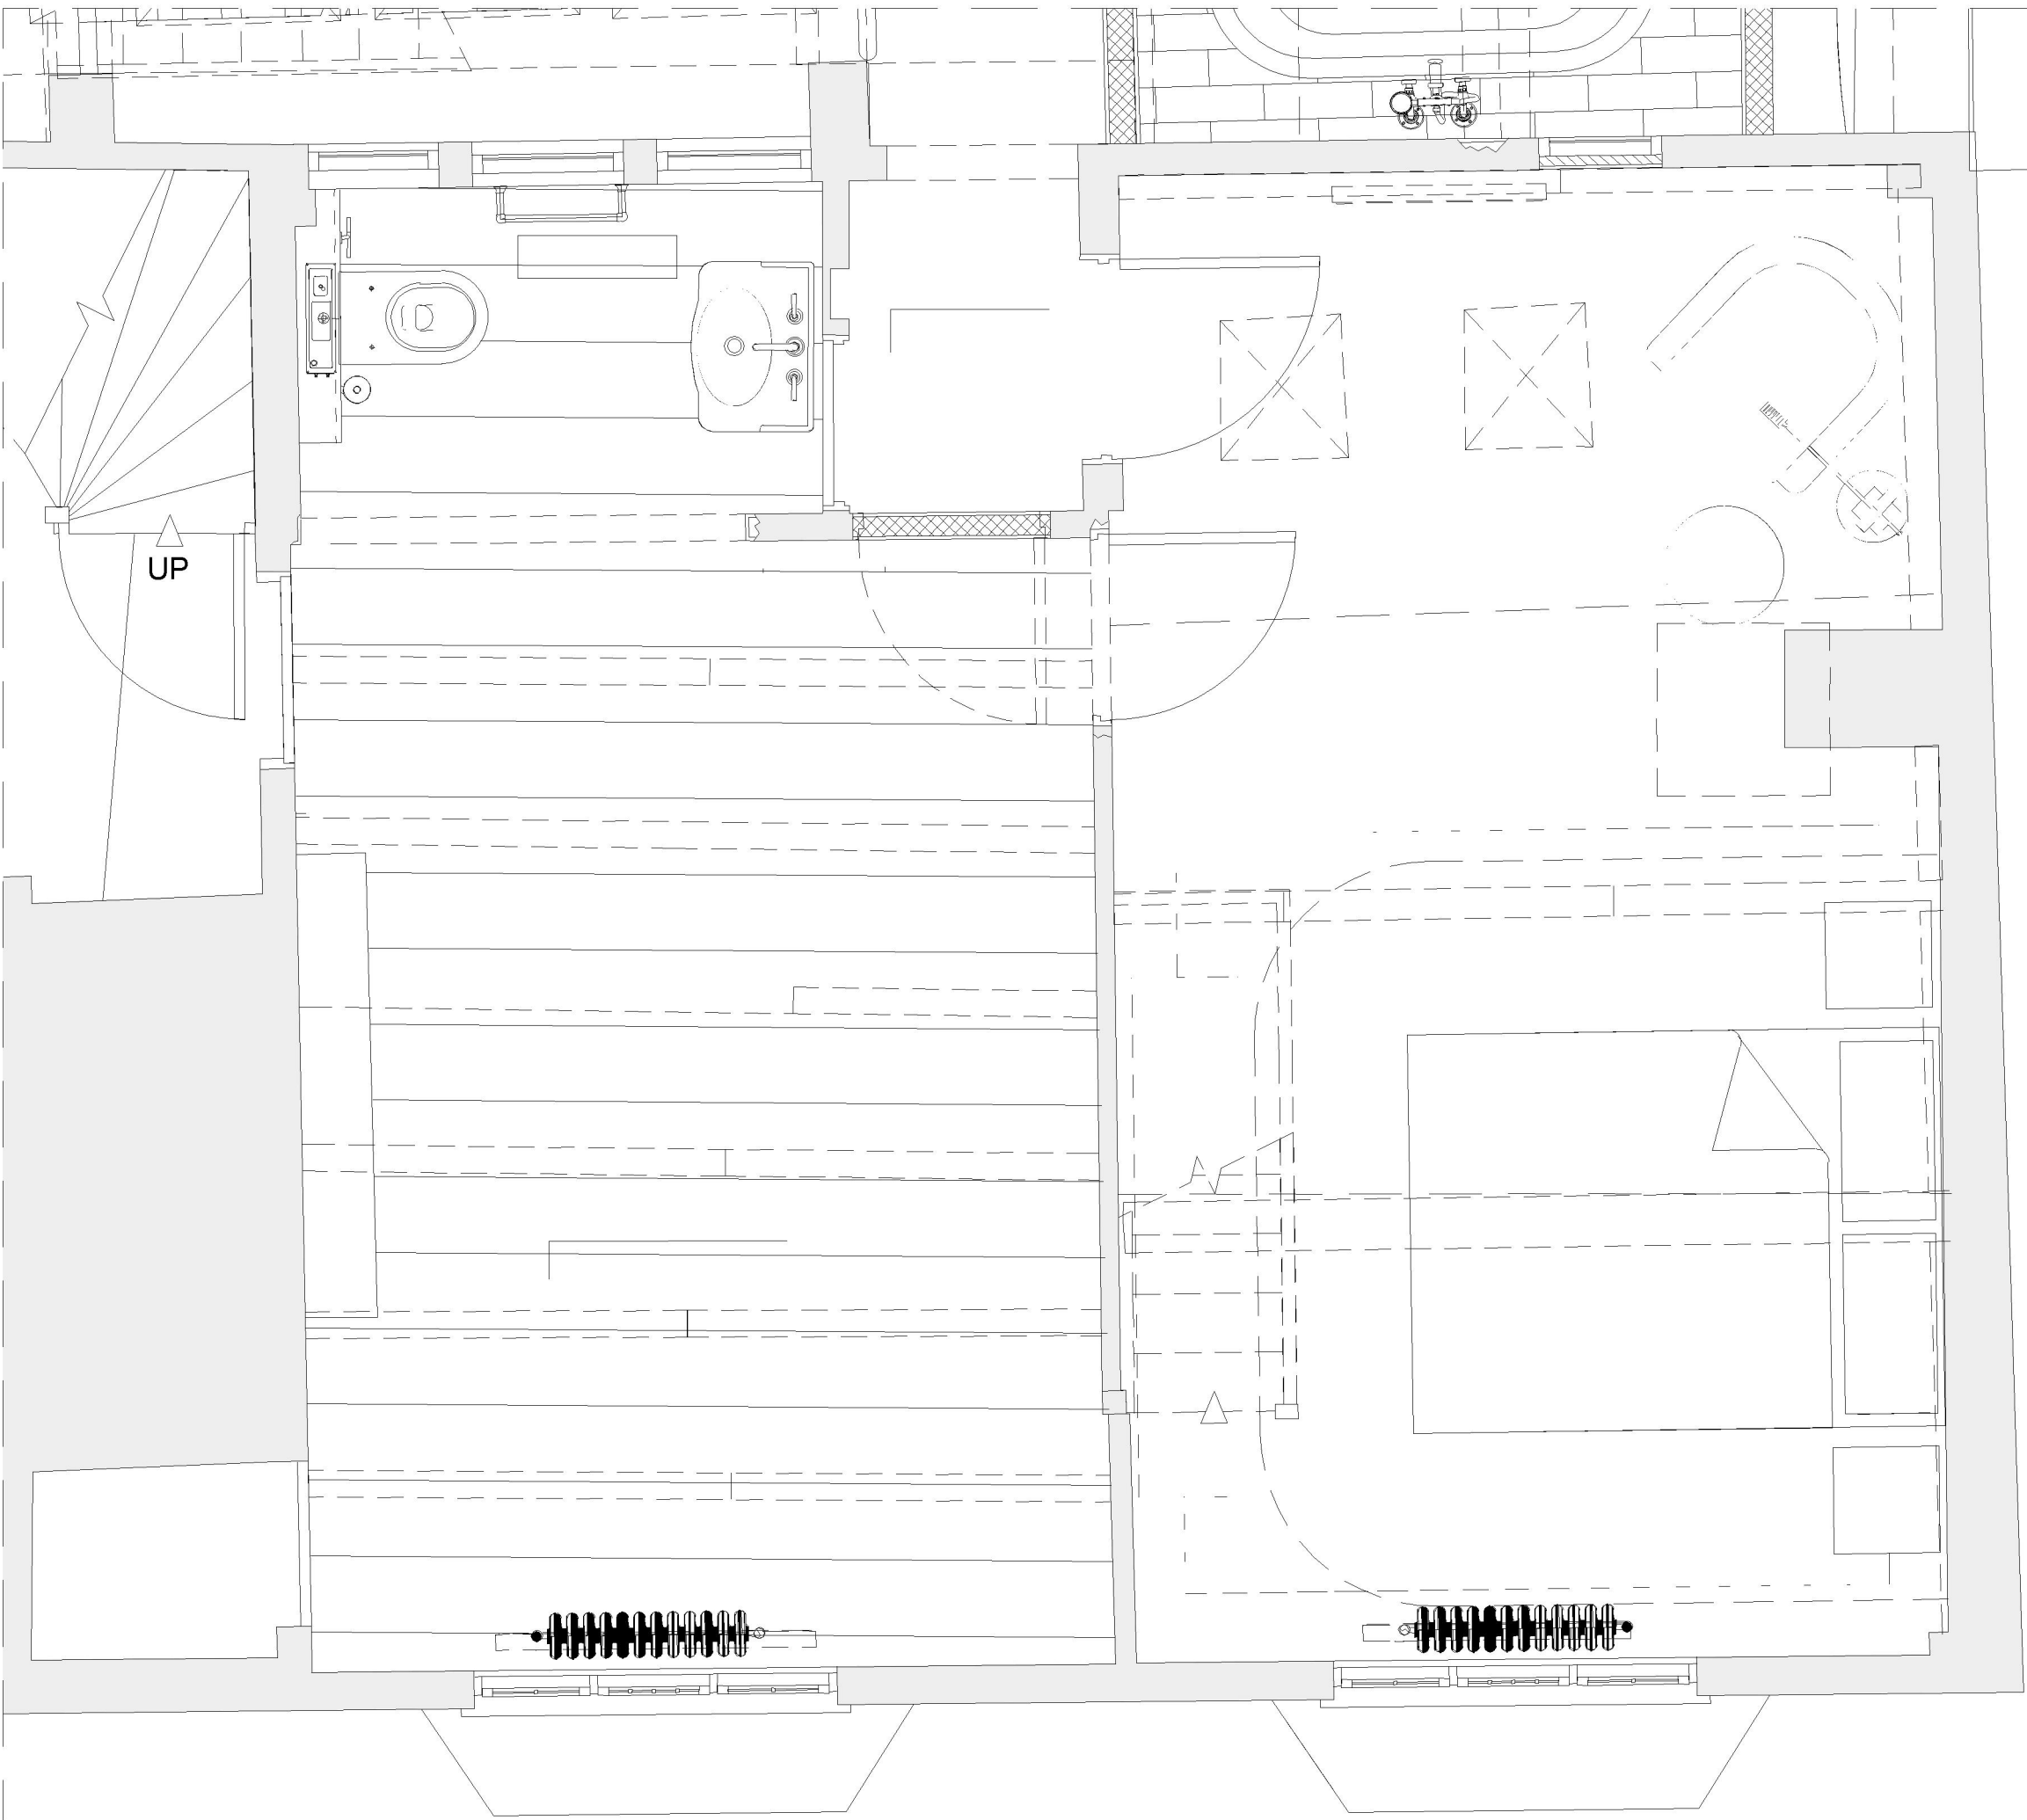

Approved Scheme First Floor Plan
Scale 1:25@A1
1:50@A3

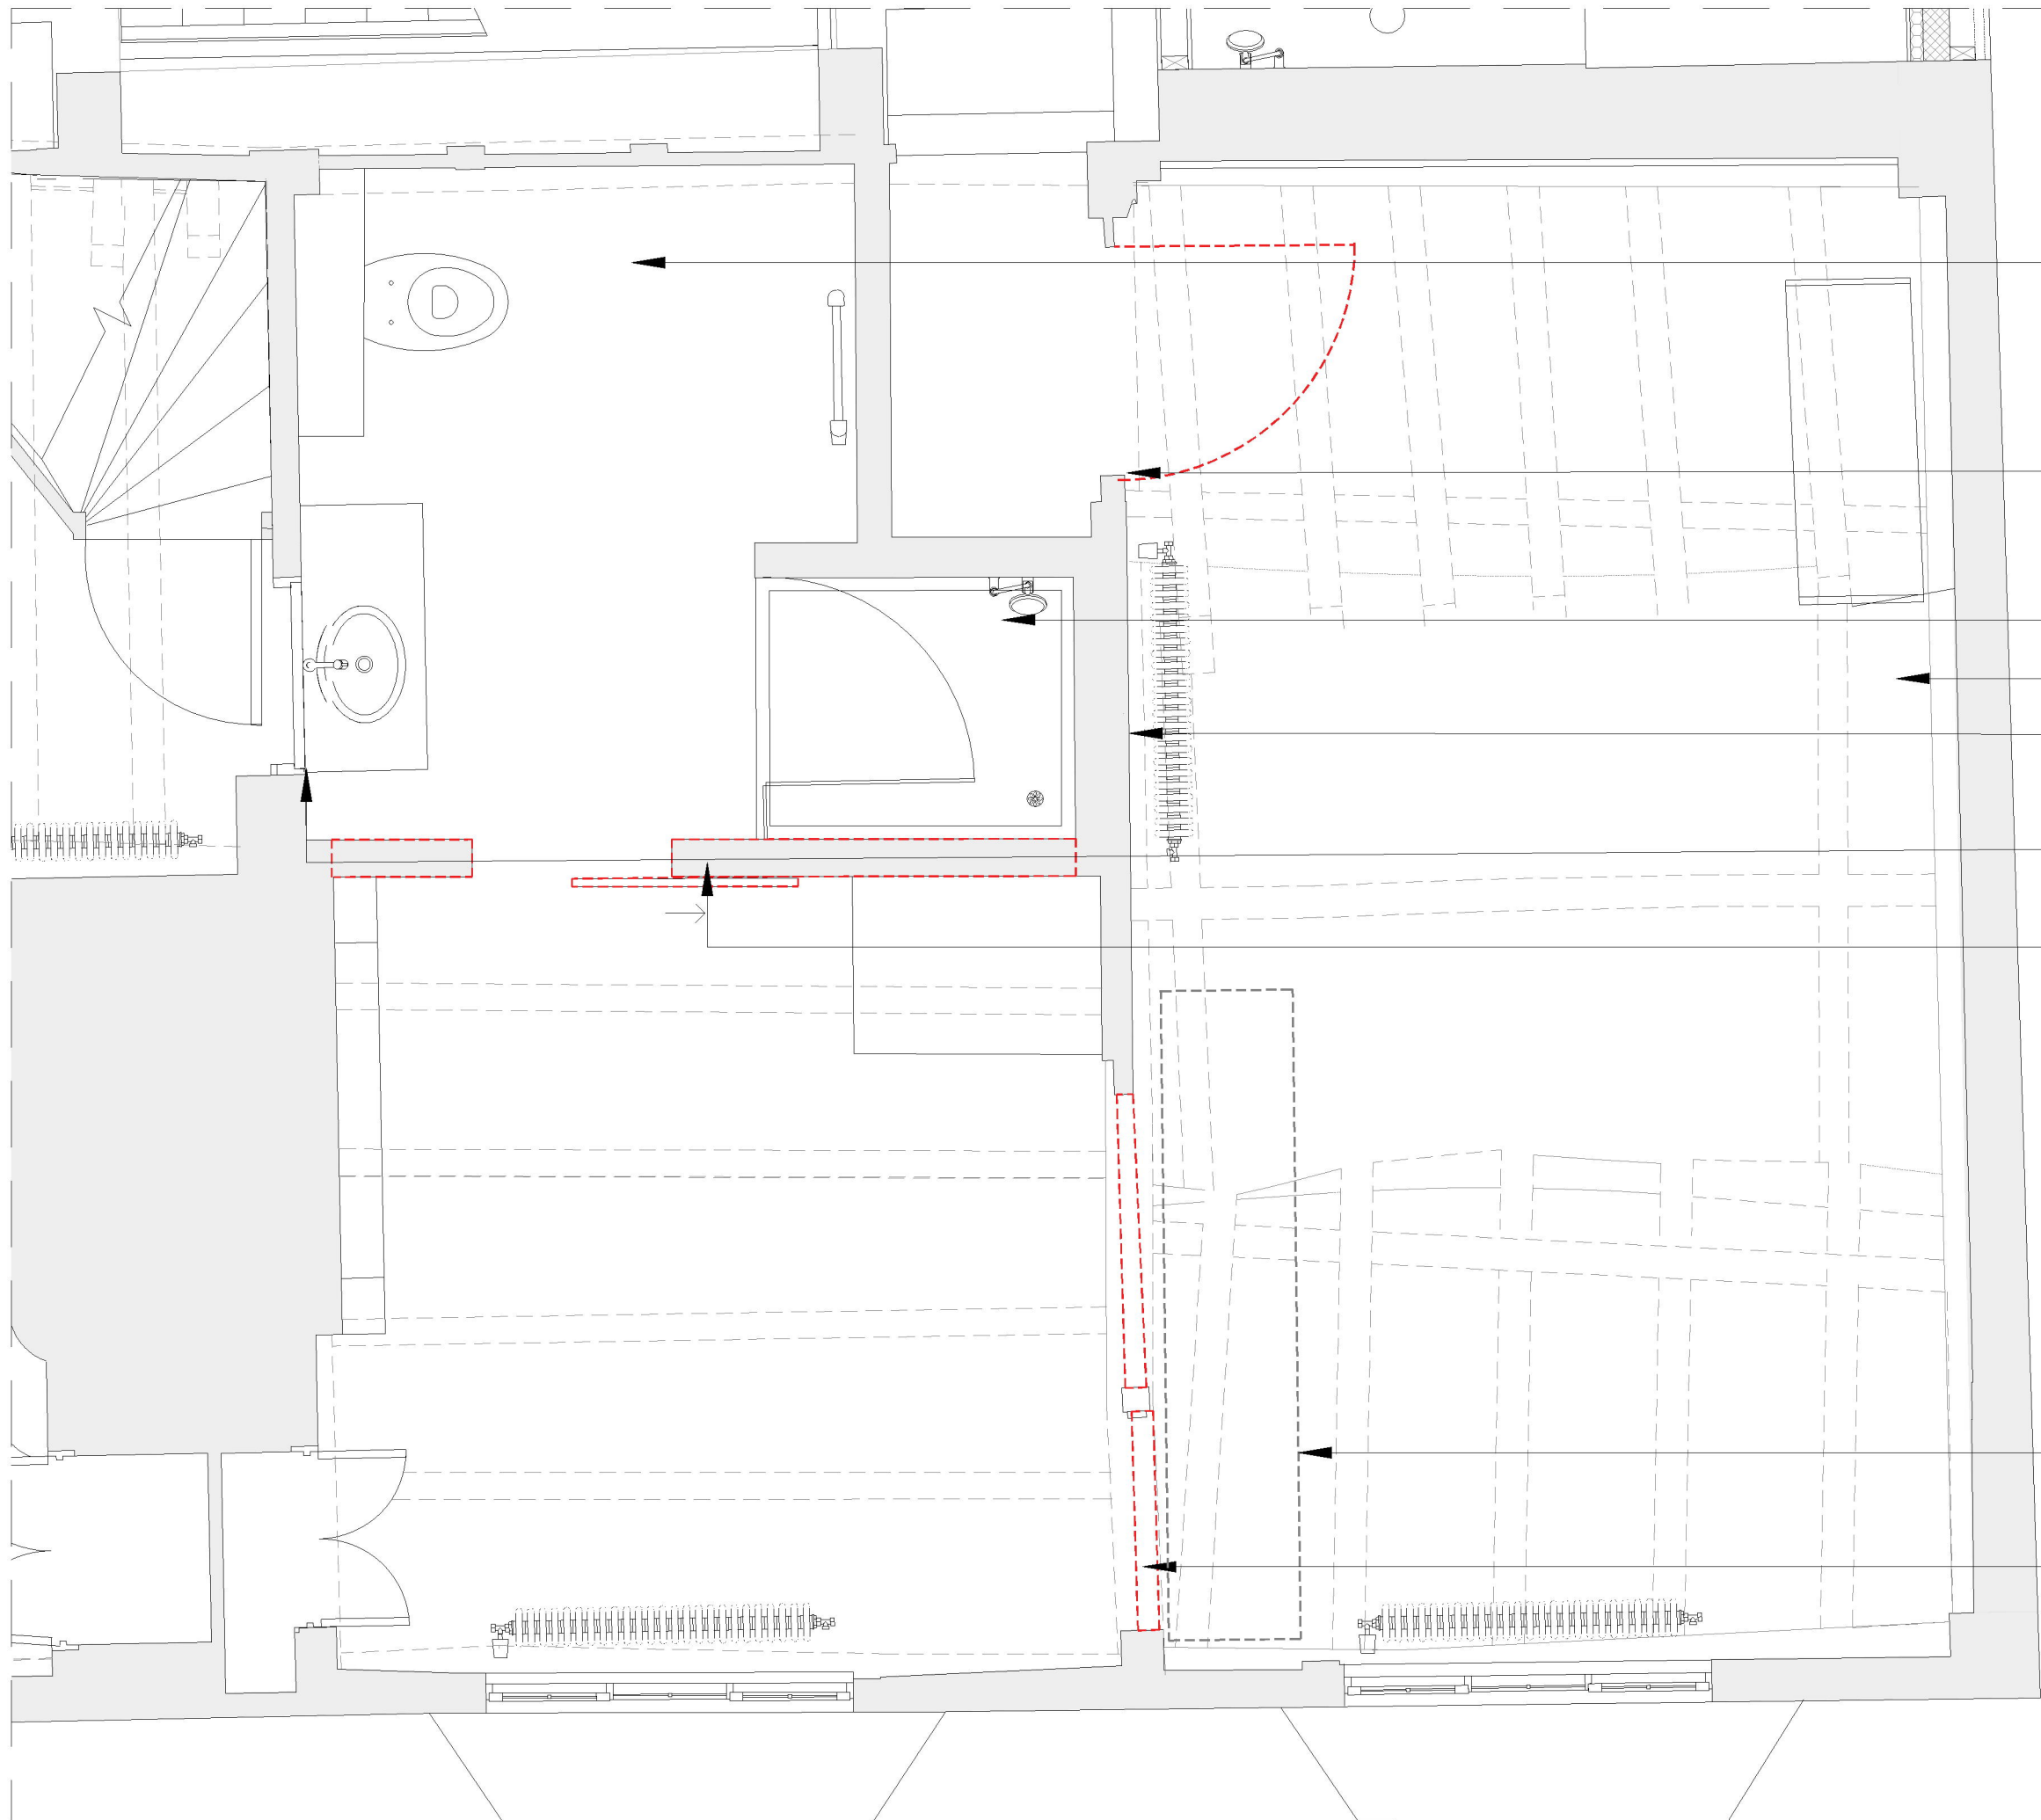

Proposed First Floor Plan
Scale 1:25@A1
1:50@A3

- Altered bathroom layout
- Approved opening and door - not implemented
- New shower cabin
- Chimney removal, refer to details 5005, 5006
- Approved door opening omitted, original timber frame retained
- Door reinstated, refer to detail 5013
- New partition wall and re-instated sliding door enclosing en-suite
- Existing staircase removed as approved
- Modern infill paneling removed, timber framing retained in-situ, exposed and restored



Northern bedroom - view towards wall with removed infill paneling and retained timber framing



Northern bedroom - new partition wall and sliding door to en-suite

KEY:
Highlighted difference between Approved Scheme and 'As-Built'/Proposed Scheme

Rev.	Comments:	By:	Date:
-	-	-	-

Do not scale this drawing. All dimensions must be checked on site.
All rights reserved. No reproduction in any material form is permitted without consent.

LISTED BUILDING CONSENT			
Client: Mr. Simon Dougal			
Project Title: 107 High St, Lindfield, Haywards Heath, West Sussex, RH16 2HR			
Drawing Title: Detail Drawings: First Floor Layout Changes - North Bedroom			
Scale: 1:25@A1 1:50@A3	Date: Mar 25	Drawn: KN	Checked: KW

kyson ⁺		
Studio		
28 Scrutton Street London UK EC2A 4RP		
T: +44(0) 20 7247 2462 E: enquiries@kyson.co.uk W: www.kyson.co.uk		
Project No.: 900-25	Drawing No.: 5018	Revision: -

