



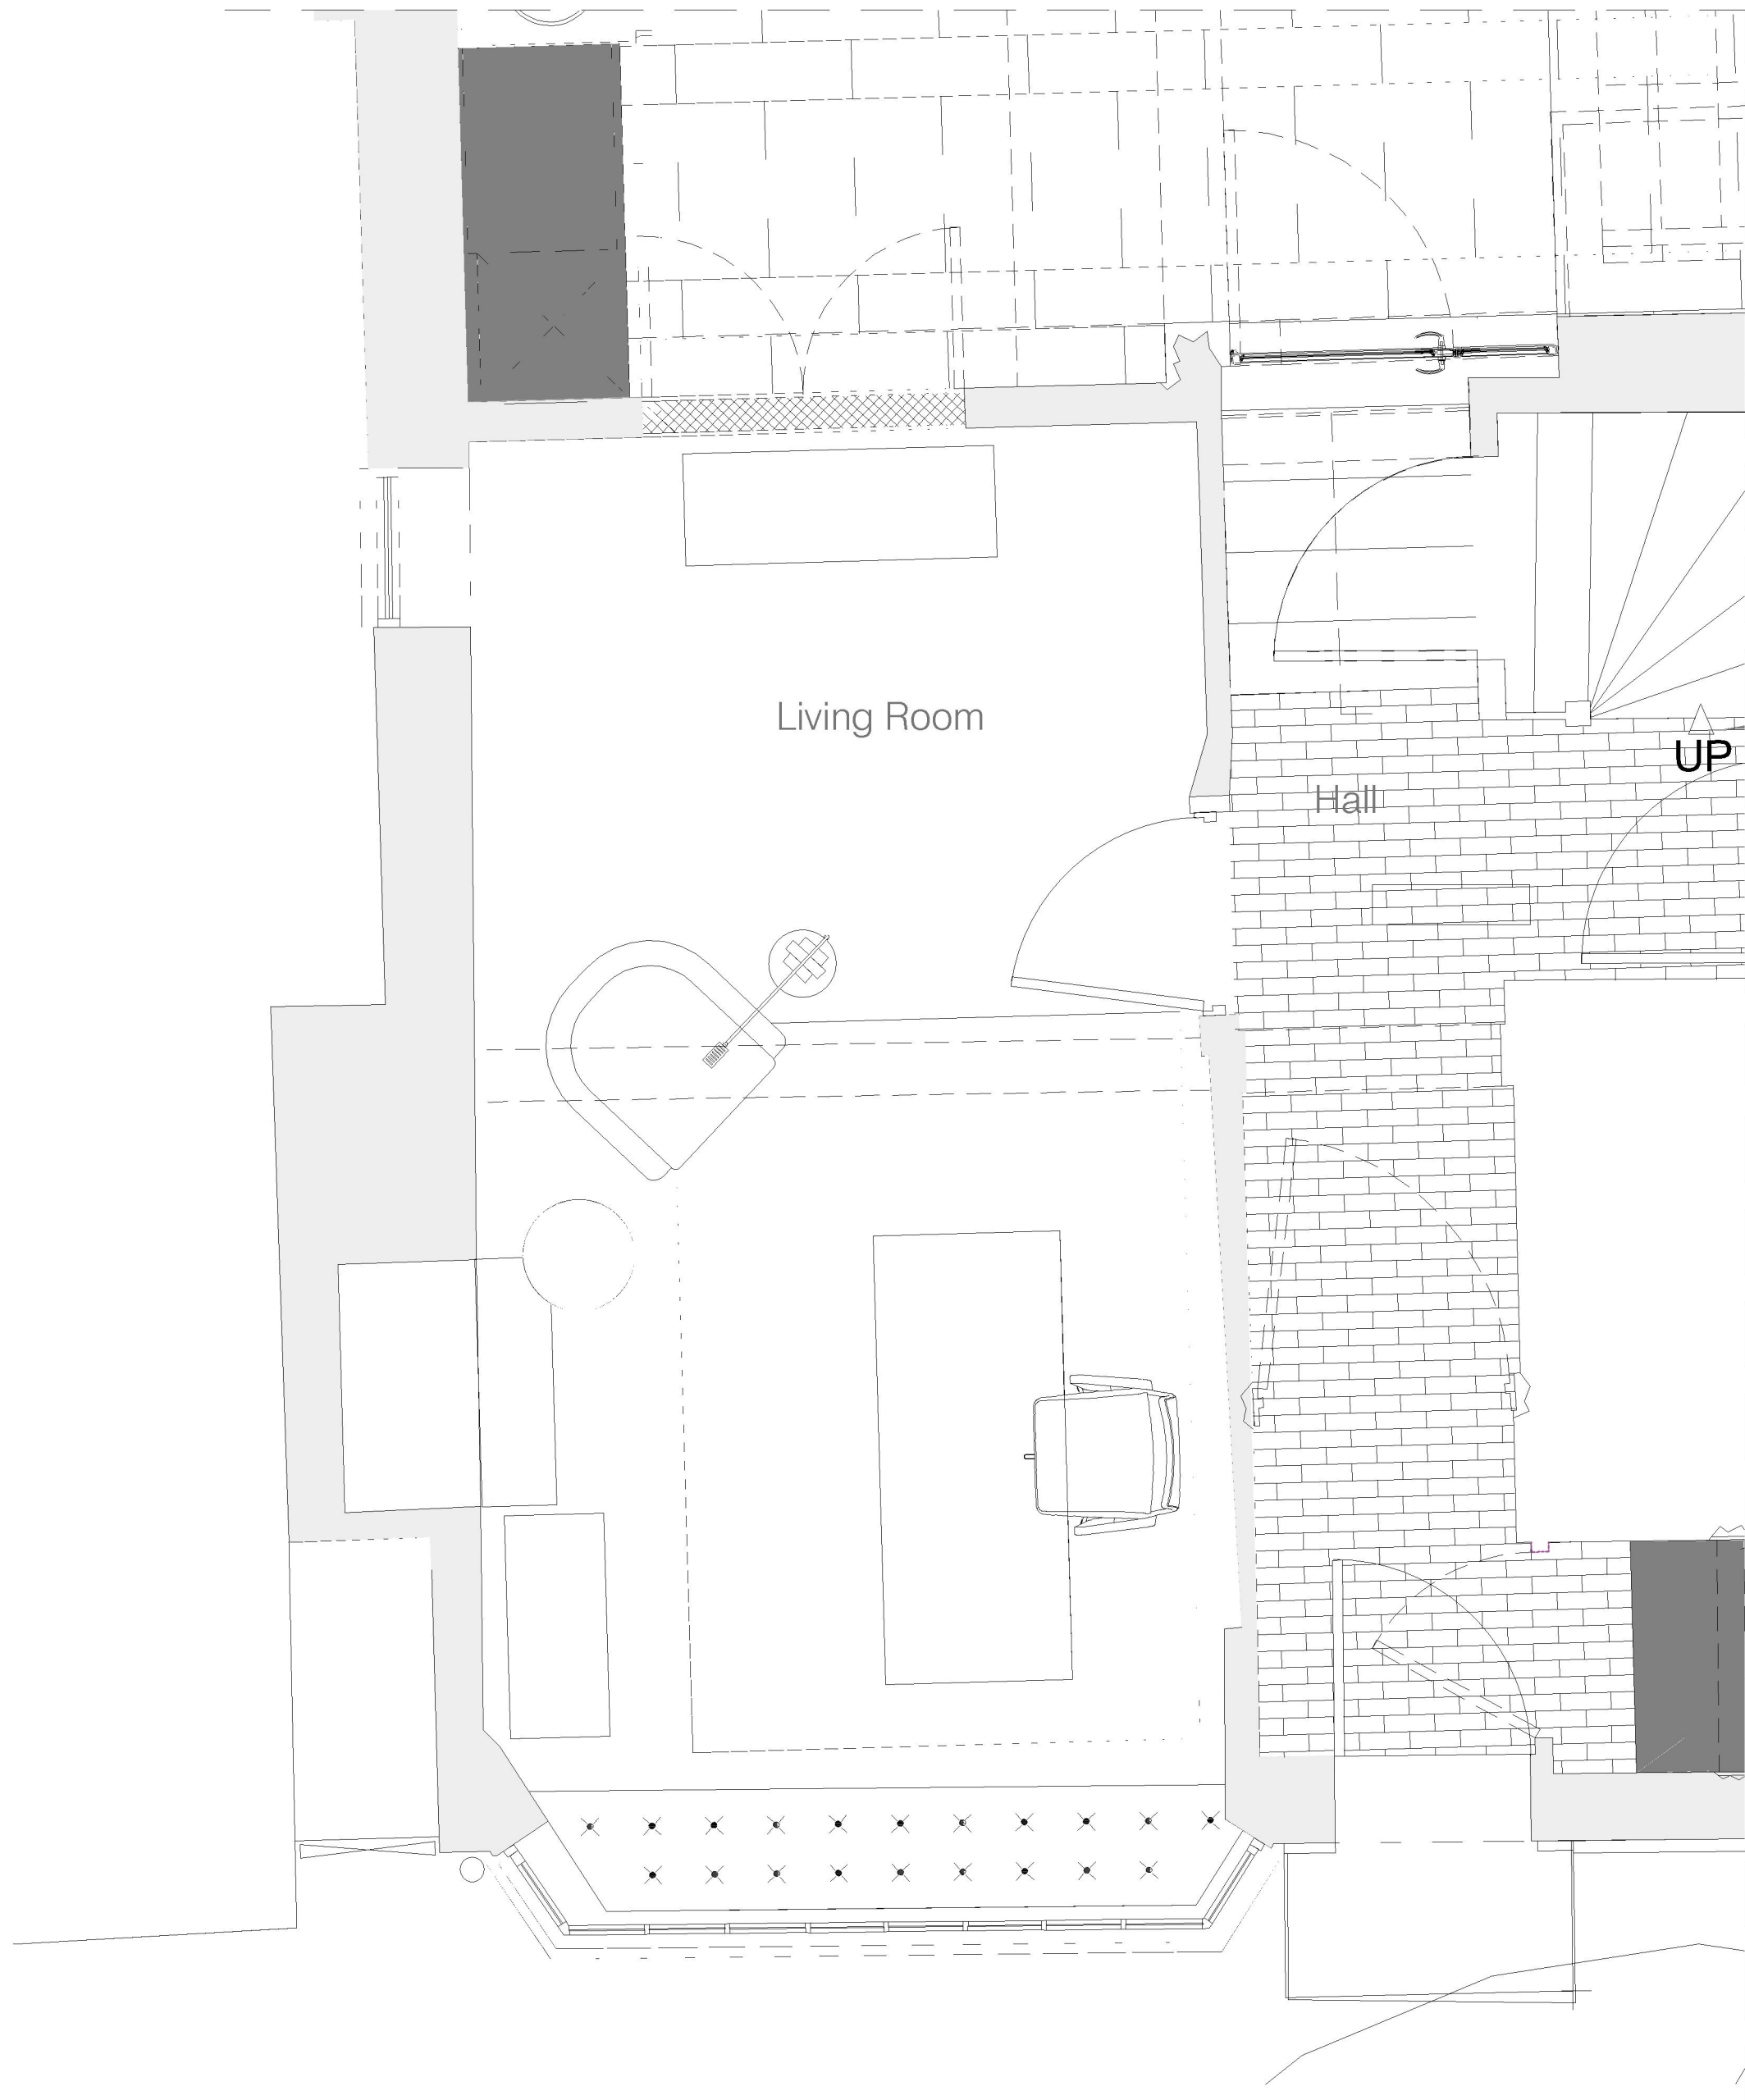


Approved Scheme
Ground Floor Plan
Scale 1:25@A1 , 1:50@A3

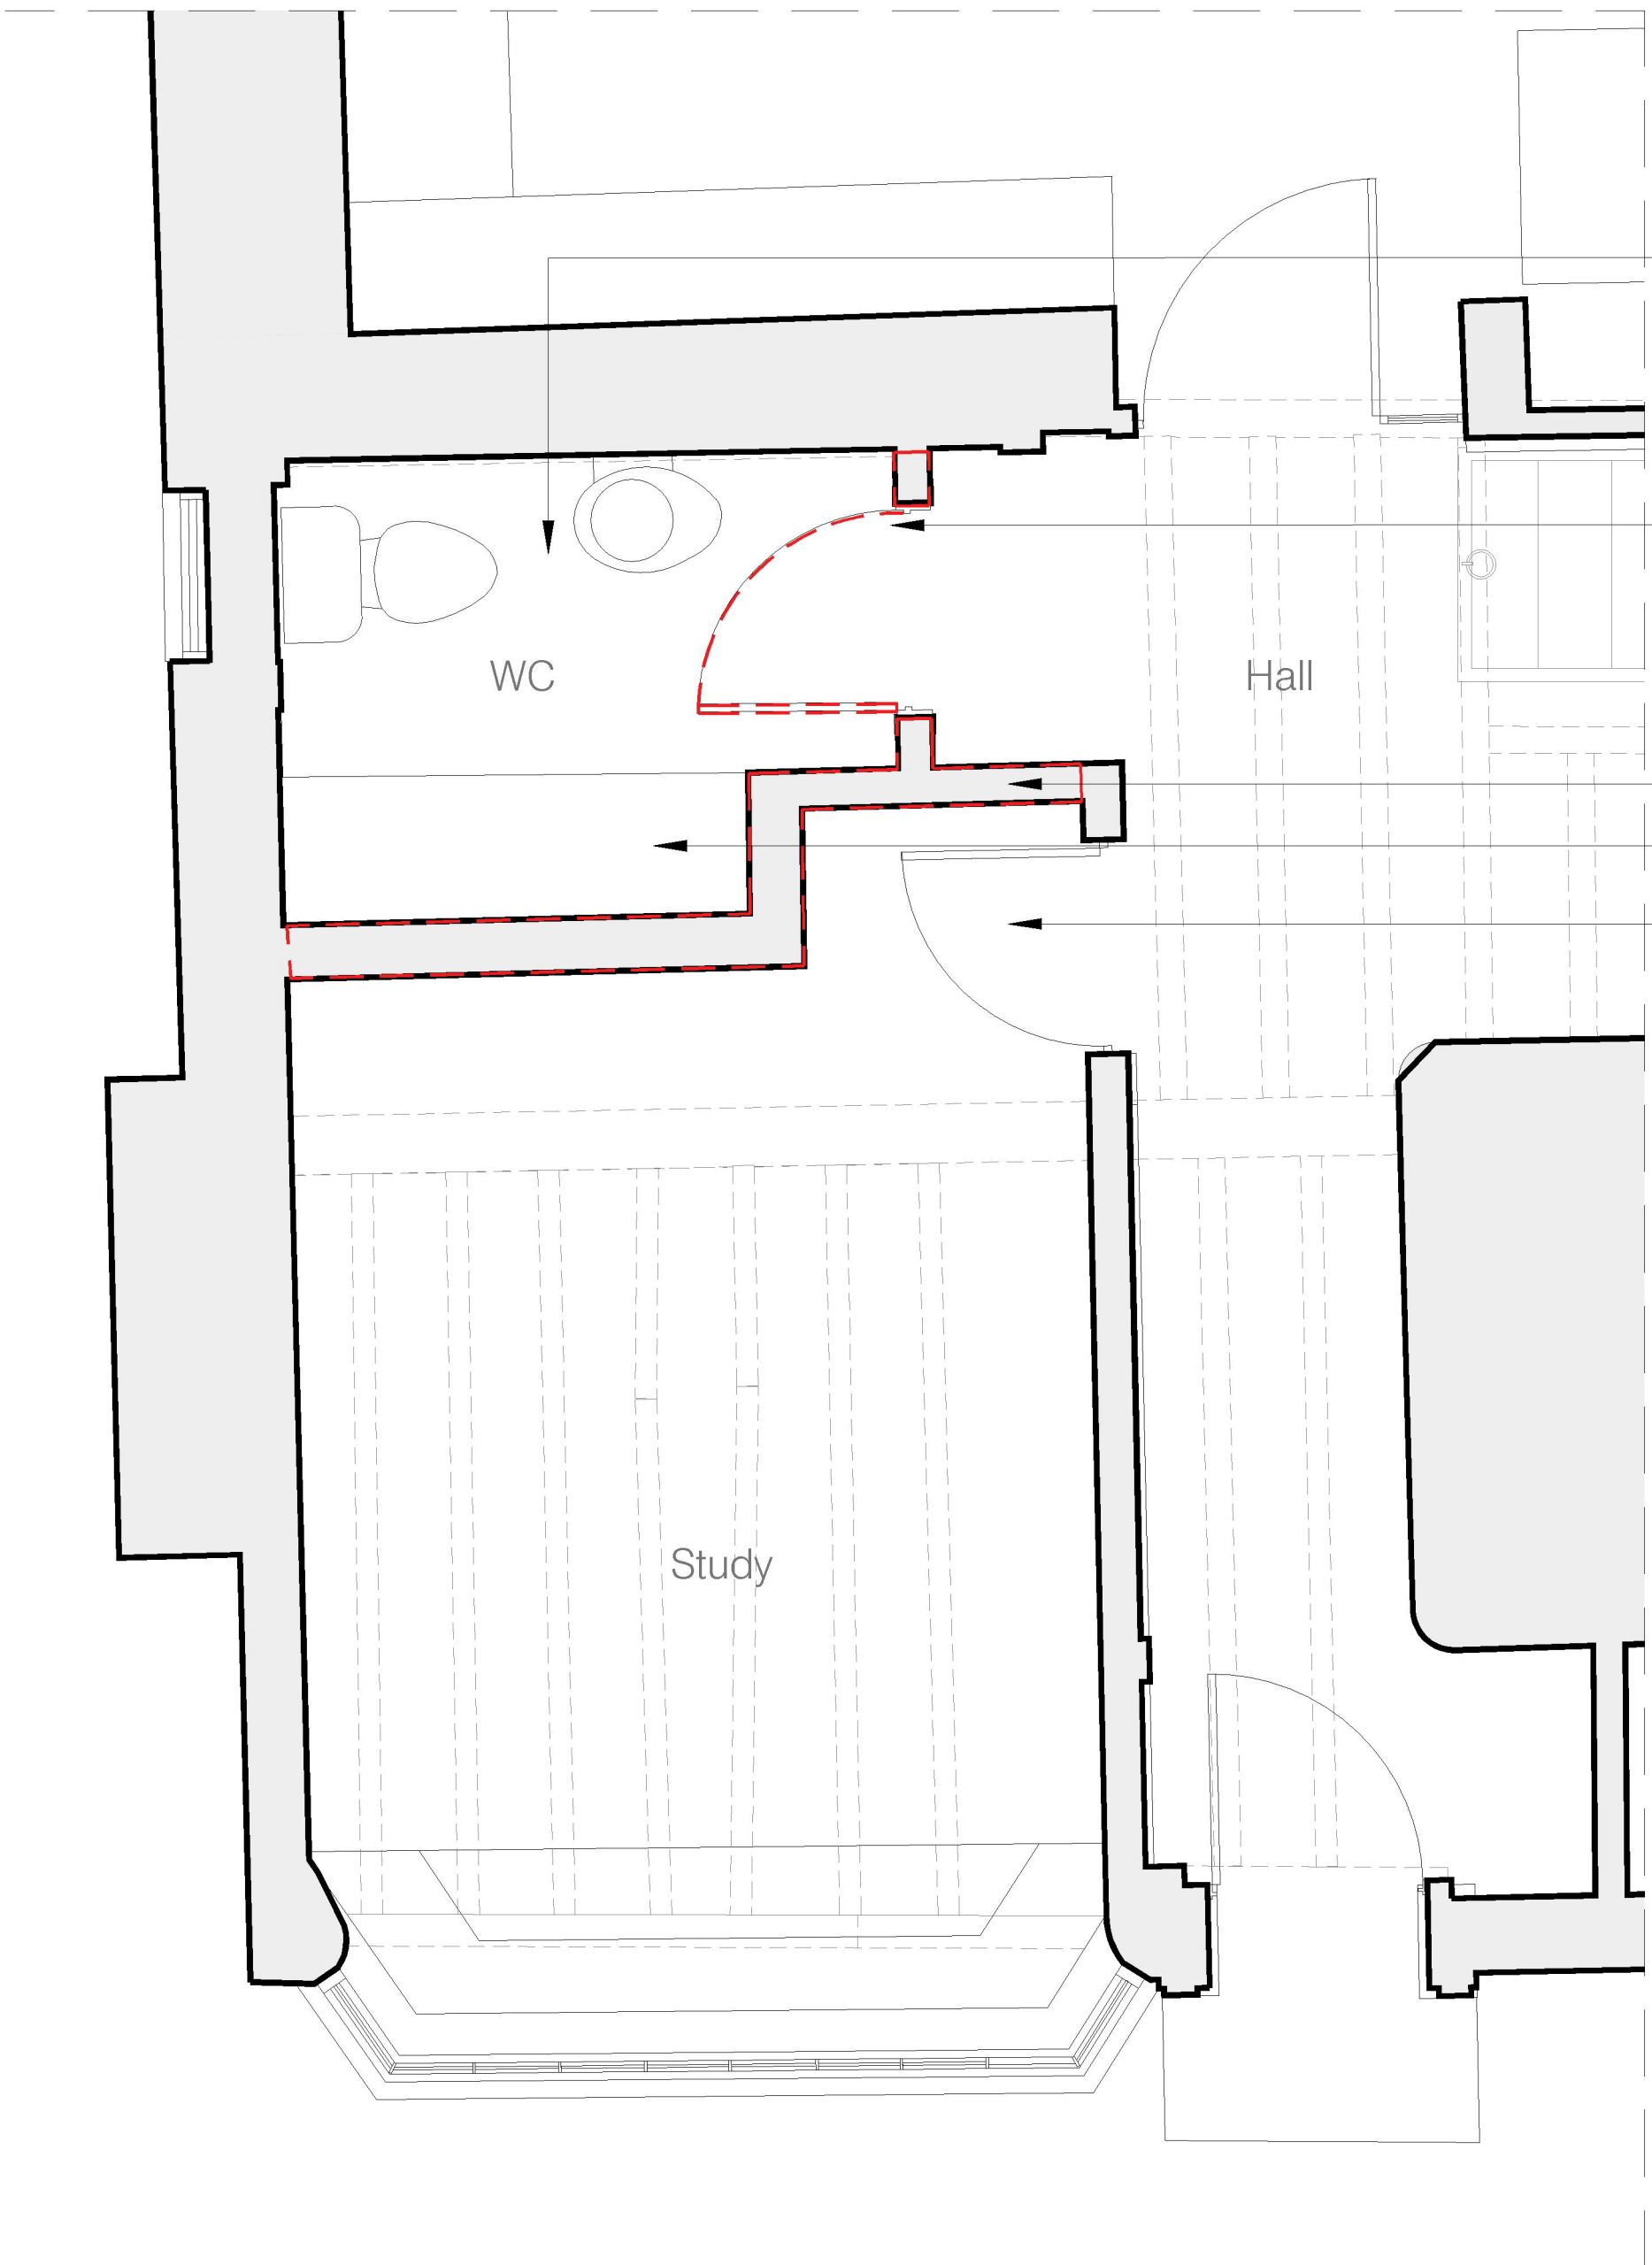

'As Built' and Proposed
Ground Floor Plan
Scale 1:25@A1 , 1:50@A3


- WC installed in accordance with proposals outlined in planning statement as approved in application DM/22/3695
- New door constructed by re-using spare floorboards found in the attic, finished in a manner to compliment the character of the listed building
- New lath and plaster partition wall
- Fitted joinery to provide essential cloaks storage
- Door handed in existing frame to make better use of the space

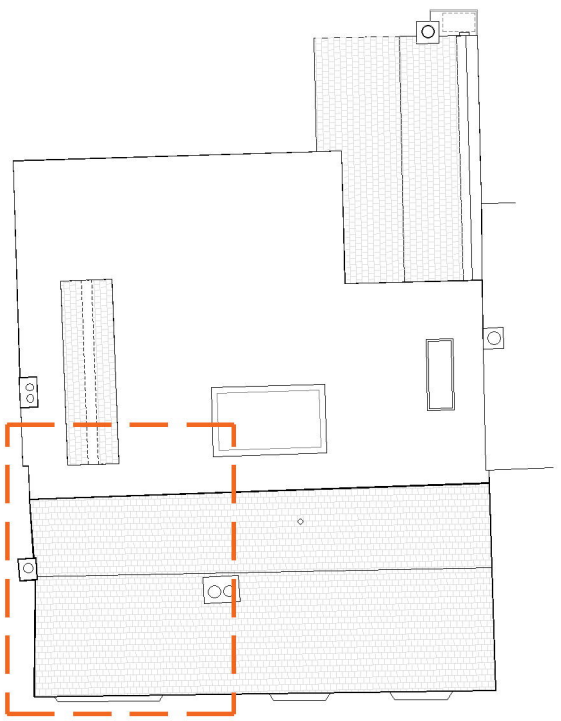

Key Plan 1:200@A1, 1:400@A3

NOTE
DRAWINGS TO BE READ IN CONJUNCTION WITH SUBMITTED
DESIGN&ACCESS STATEMENT AND HERITAGE STATEMENT
MATERIALS INSTALLED IN ACCORDANCE WITH THOSE
OUTLINED IN CONDITION #9 OF APPROVAL DM/23/1605

KEY:
Highlighted difference between Approved Scheme and 'As-Built'/Proposed Scheme

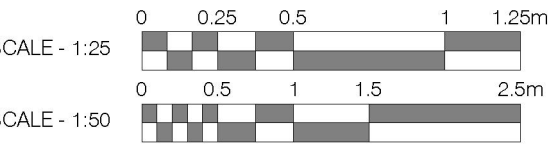

Rev.	Comments:	By:	Date:
-	-	-	-

Do not scale this drawing. All dimensions must be checked on site.
All rights reserved. No reproduction in any material form is permitted without consent.

LISTED BUILDING CONSENT			
Client: Mr. Simon Dougal			
Project Title: 107 High St, Lindfield, Haywards Heath, West Sussex, RH16 2HR			
Drawing Title: Detail Drawings: Partition for ground floor WC			
Scale: 1:25@A1 1:50@A3	Date: Apr 25	Drawn: KN	Checked: KW

kyson ⁺ Studio		
28 Scrutton Street London UK EC2A 4RP		
T: +44(0) 20 7247 2462 E: enquiries@kyson.co.uk W: www.kyson.co.uk		
Project No.: 900-25	Drawing No.: 5004	Revision: -