




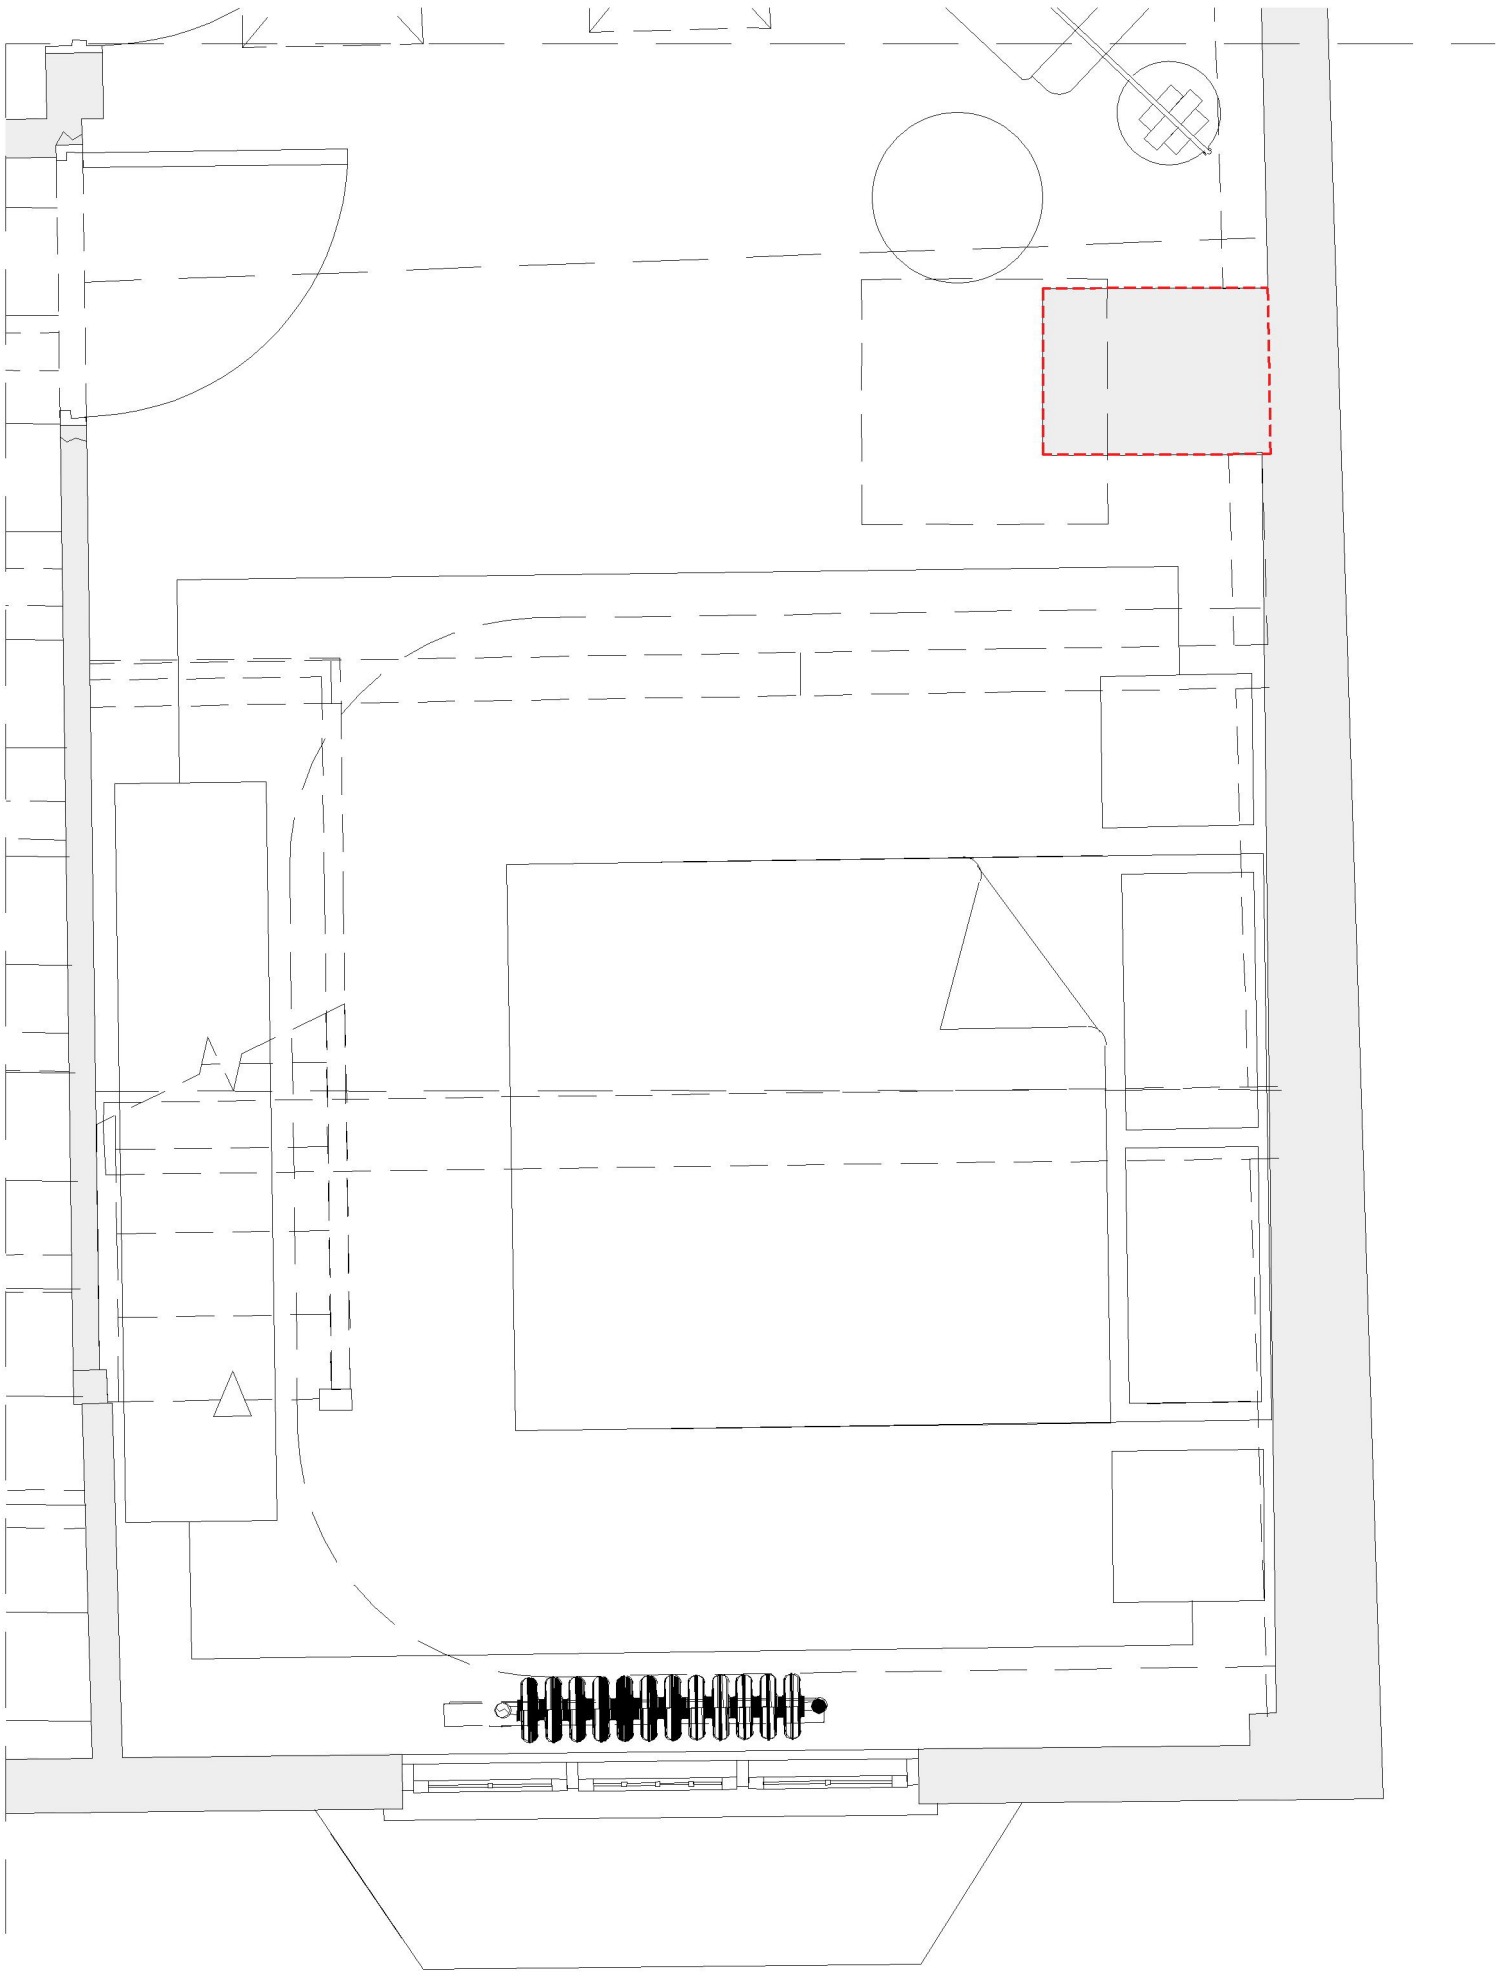

Approved Scheme First Floor Plan
Scale 1:25@A1
1:50@A3

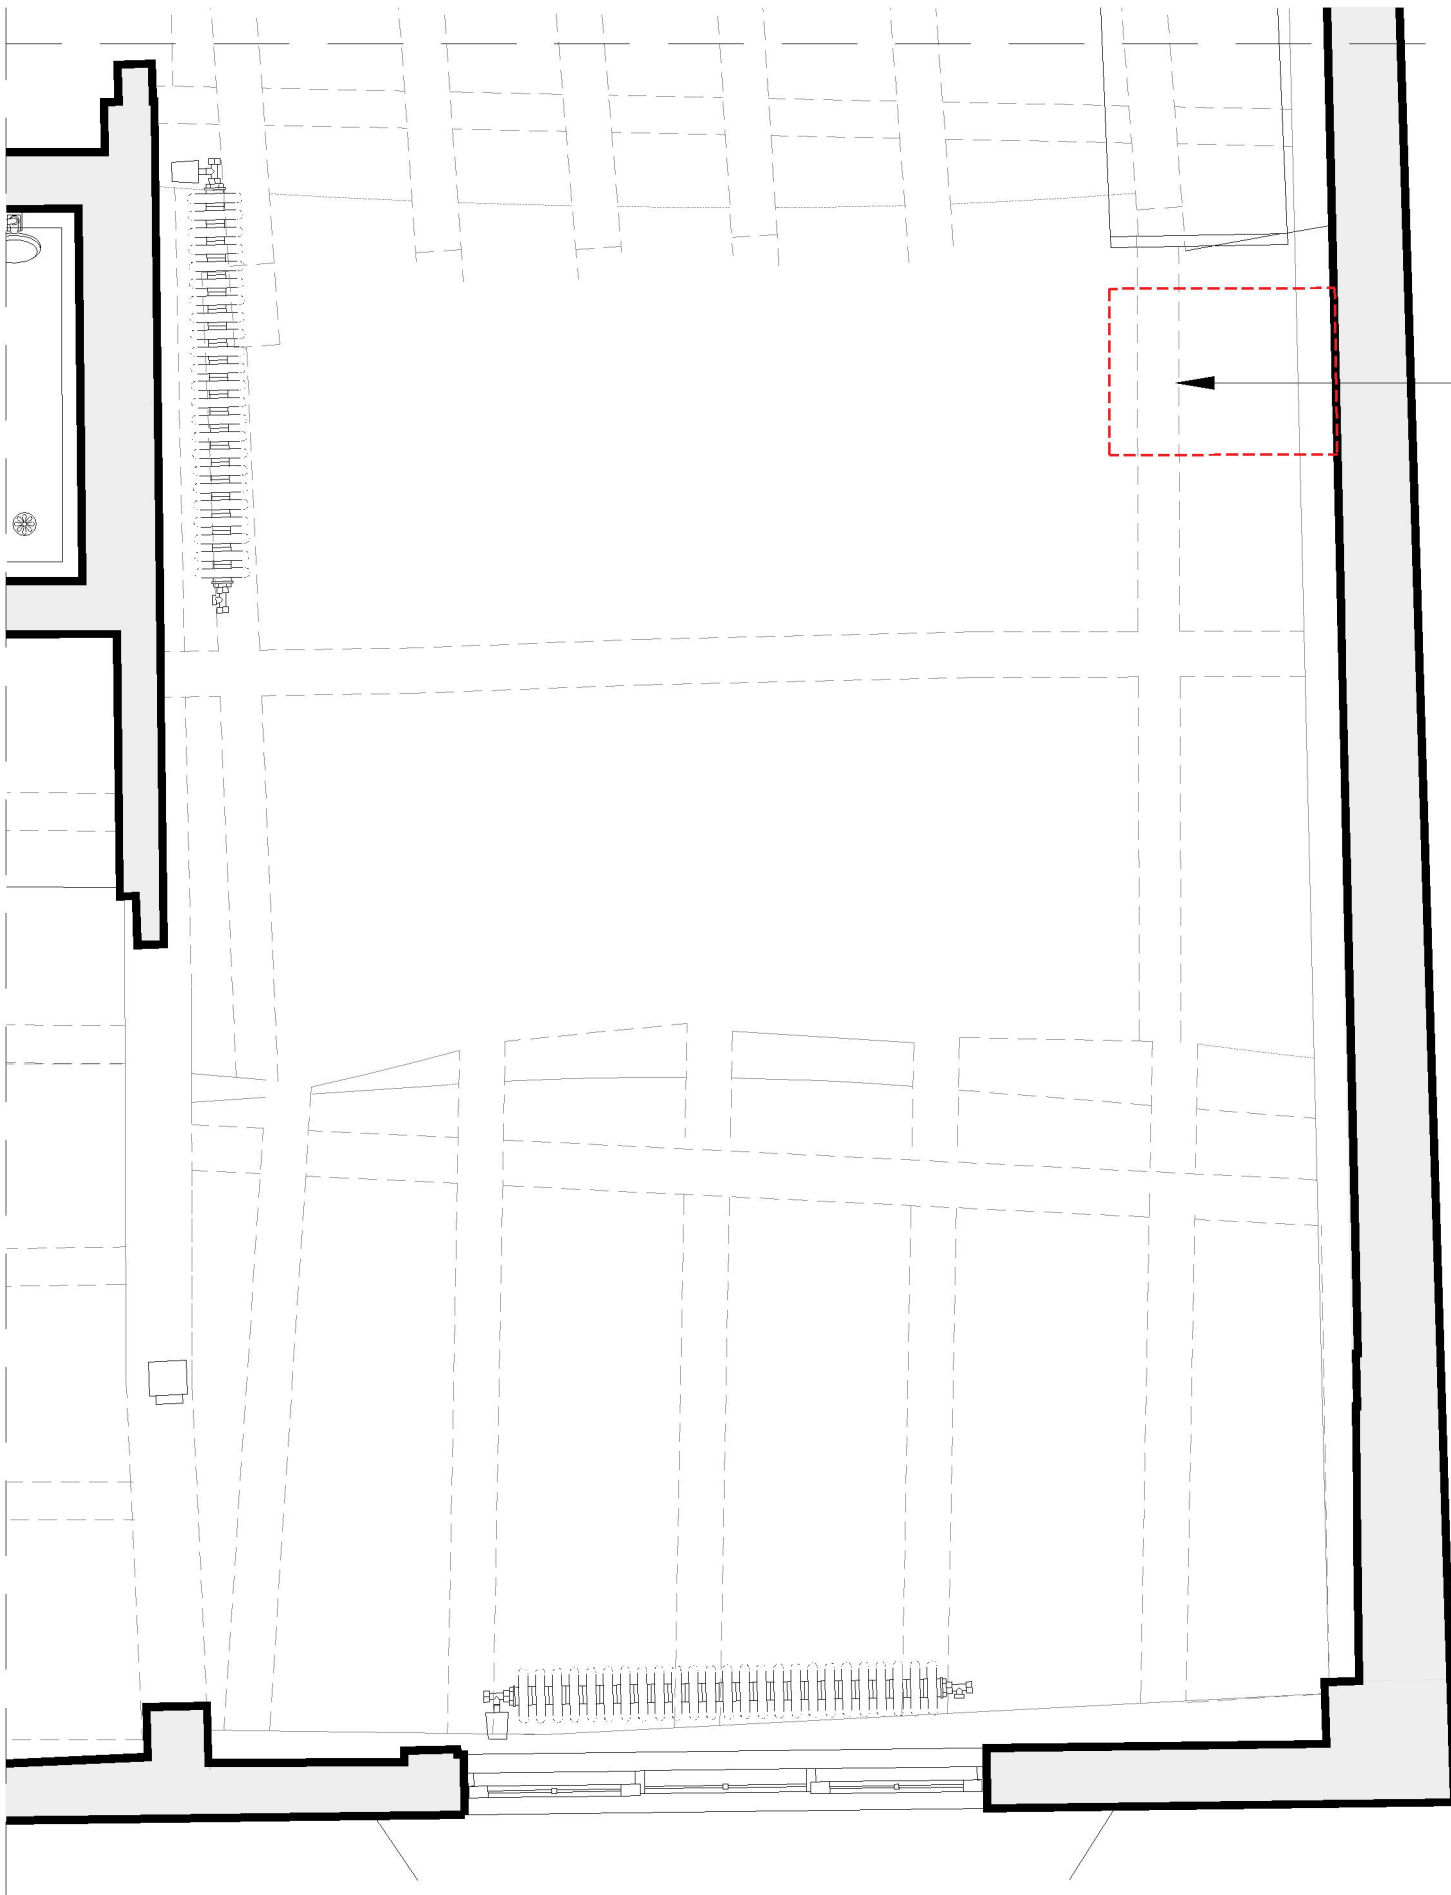

'As Built' / Proposed First Floor Plan
Scale 1:25@A1
1:50@A3

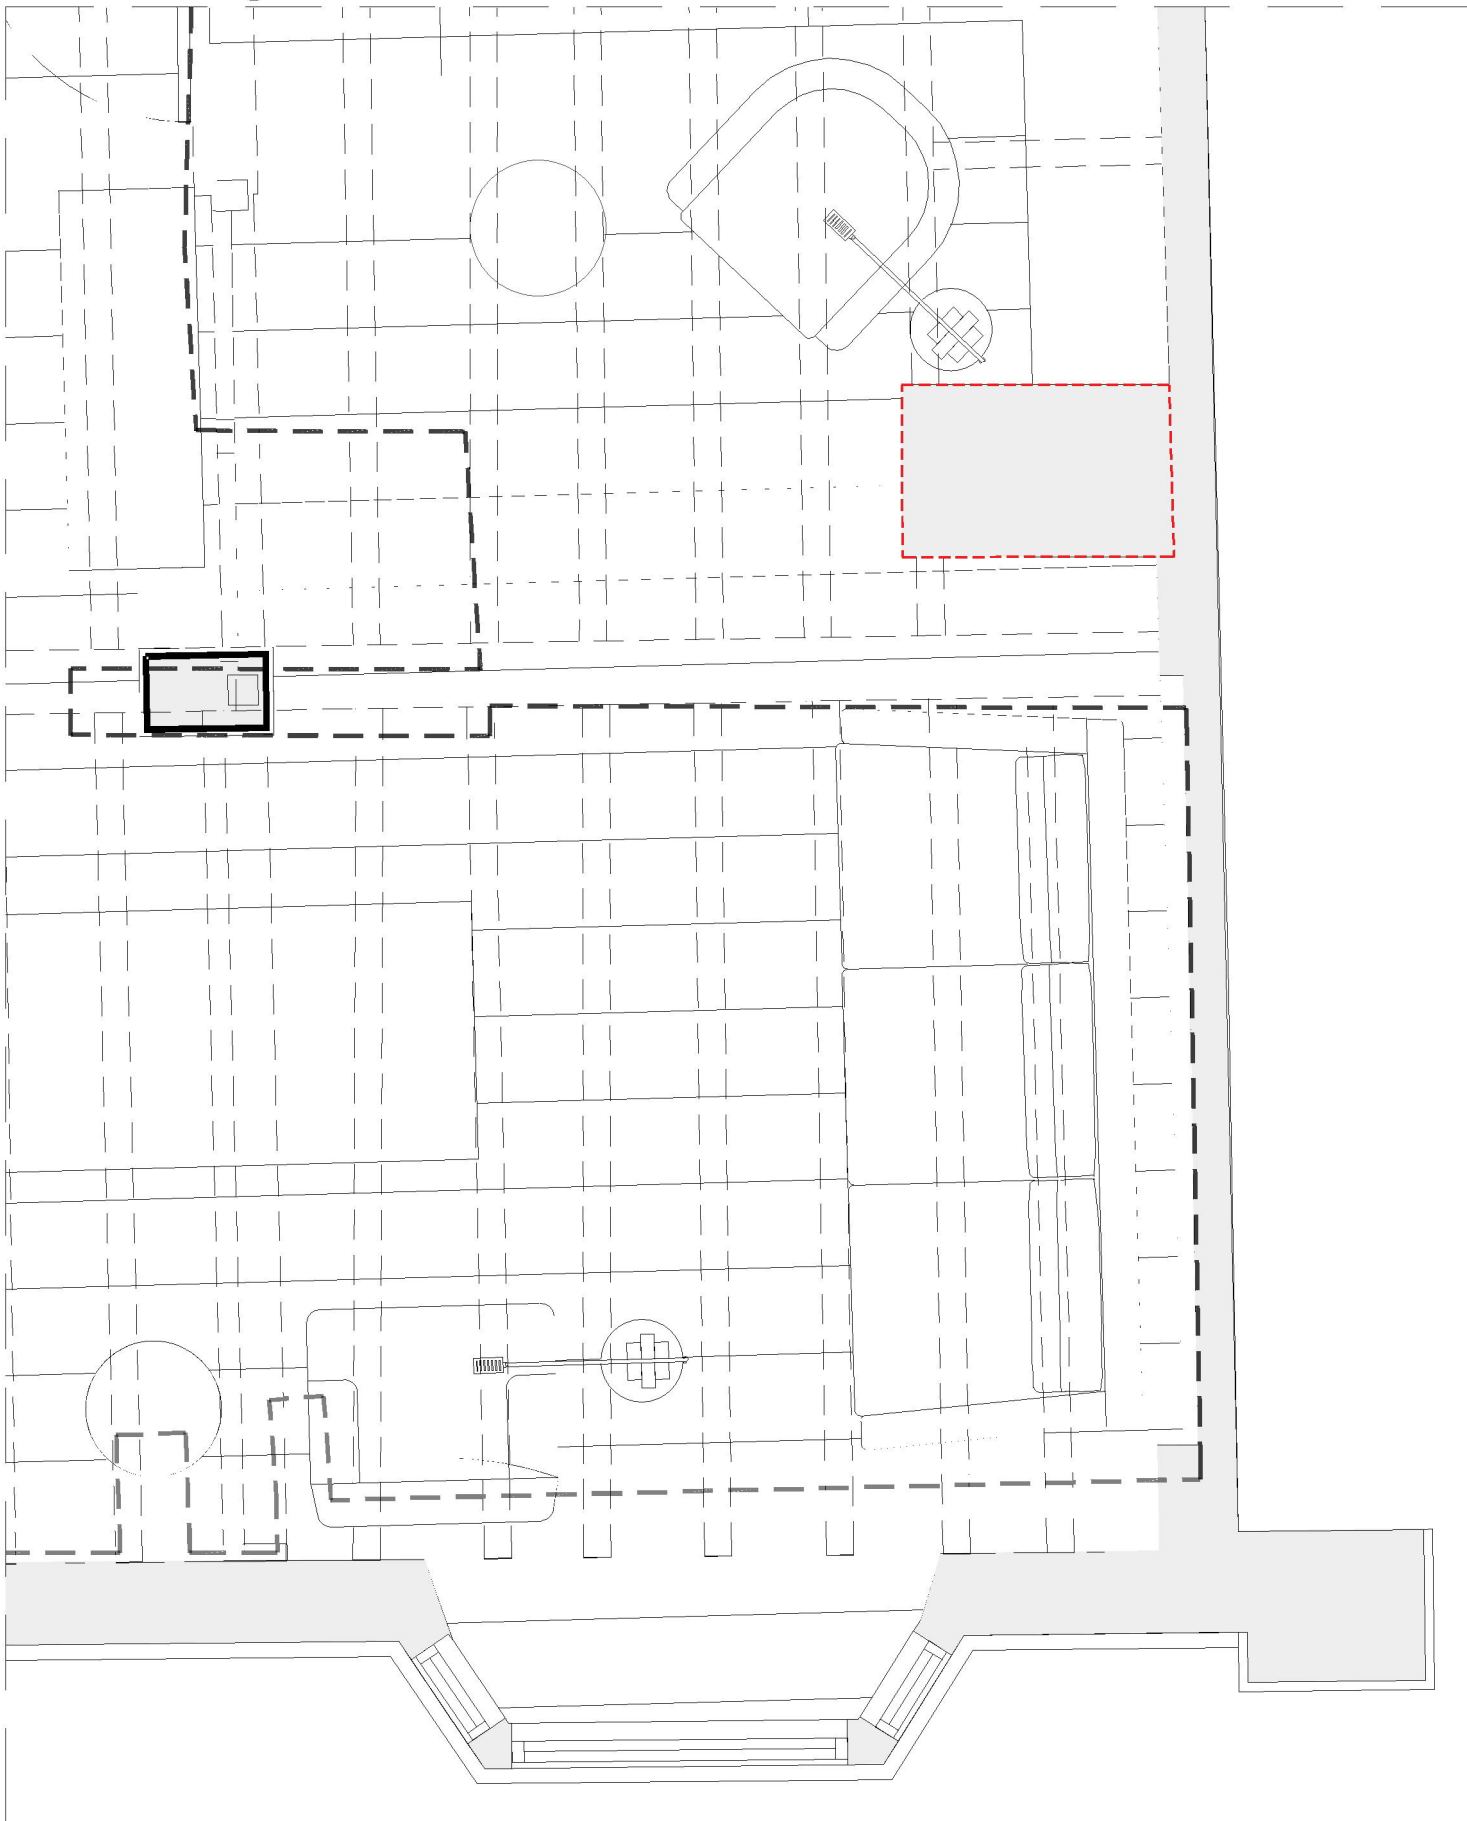


Approved Scheme Ground Floor Plan
Scale 1:25@A1
1:50@A3



'As Built' / Proposed Ground Floor Plan
Scale 1:25@A1
1:50@A3

19th century chimney stack removed, timber floor and lathe and plaster ceiling made good

19th century chimney stack removed, timber floor and lathe and plaster ceiling made good

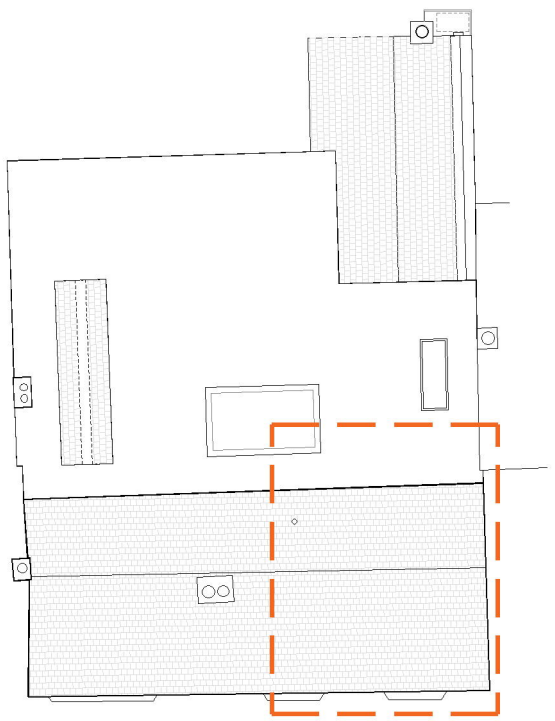

Key Plan 1:200@A1, 1:400@A3

KEY:
Highlighted difference between Approved Scheme and 'As-Built'/Proposed Scheme

NOTE
DRAWINGS TO BE READ IN CONJUNCTION WITH SUBMITTED DESIGN&ACCESS STATEMENT AND HERITAGE STATEMENT MATERIALS INSTALLED IN ACCORDANCE WITH THOSE OUTLINED IN CONDITION #9 OF APPROVAL DM/23/1605

LISTED BUILDING CONSENT

Rev: - Comments: - By: - Date: -

Client: Mr. Simon Dougall

Project Title: 107 High St, Lindfield, Haywards Heath, West Sussex, RH16 2HR

Drawing Title: Detail Drawings: Removal of chimney - Sheet 1 of 2

Scale: 1:25@A1 1:50@A3 Date: Apr 25 Drawn: KN Checked: KW



Studio
28 Scrutton Street
London
UK
EC2A 4RP
T: +44(0) 20 7247 2462
E: enquiries@kyson.co.uk
W: www.kyson.co.uk

Project No.: 900-25 Drawing No.: 5005 Revision: -

Do not scale this drawing All dimensions must be checked on site All rights reserved. No reproduction in any material form is permitted without consent.