



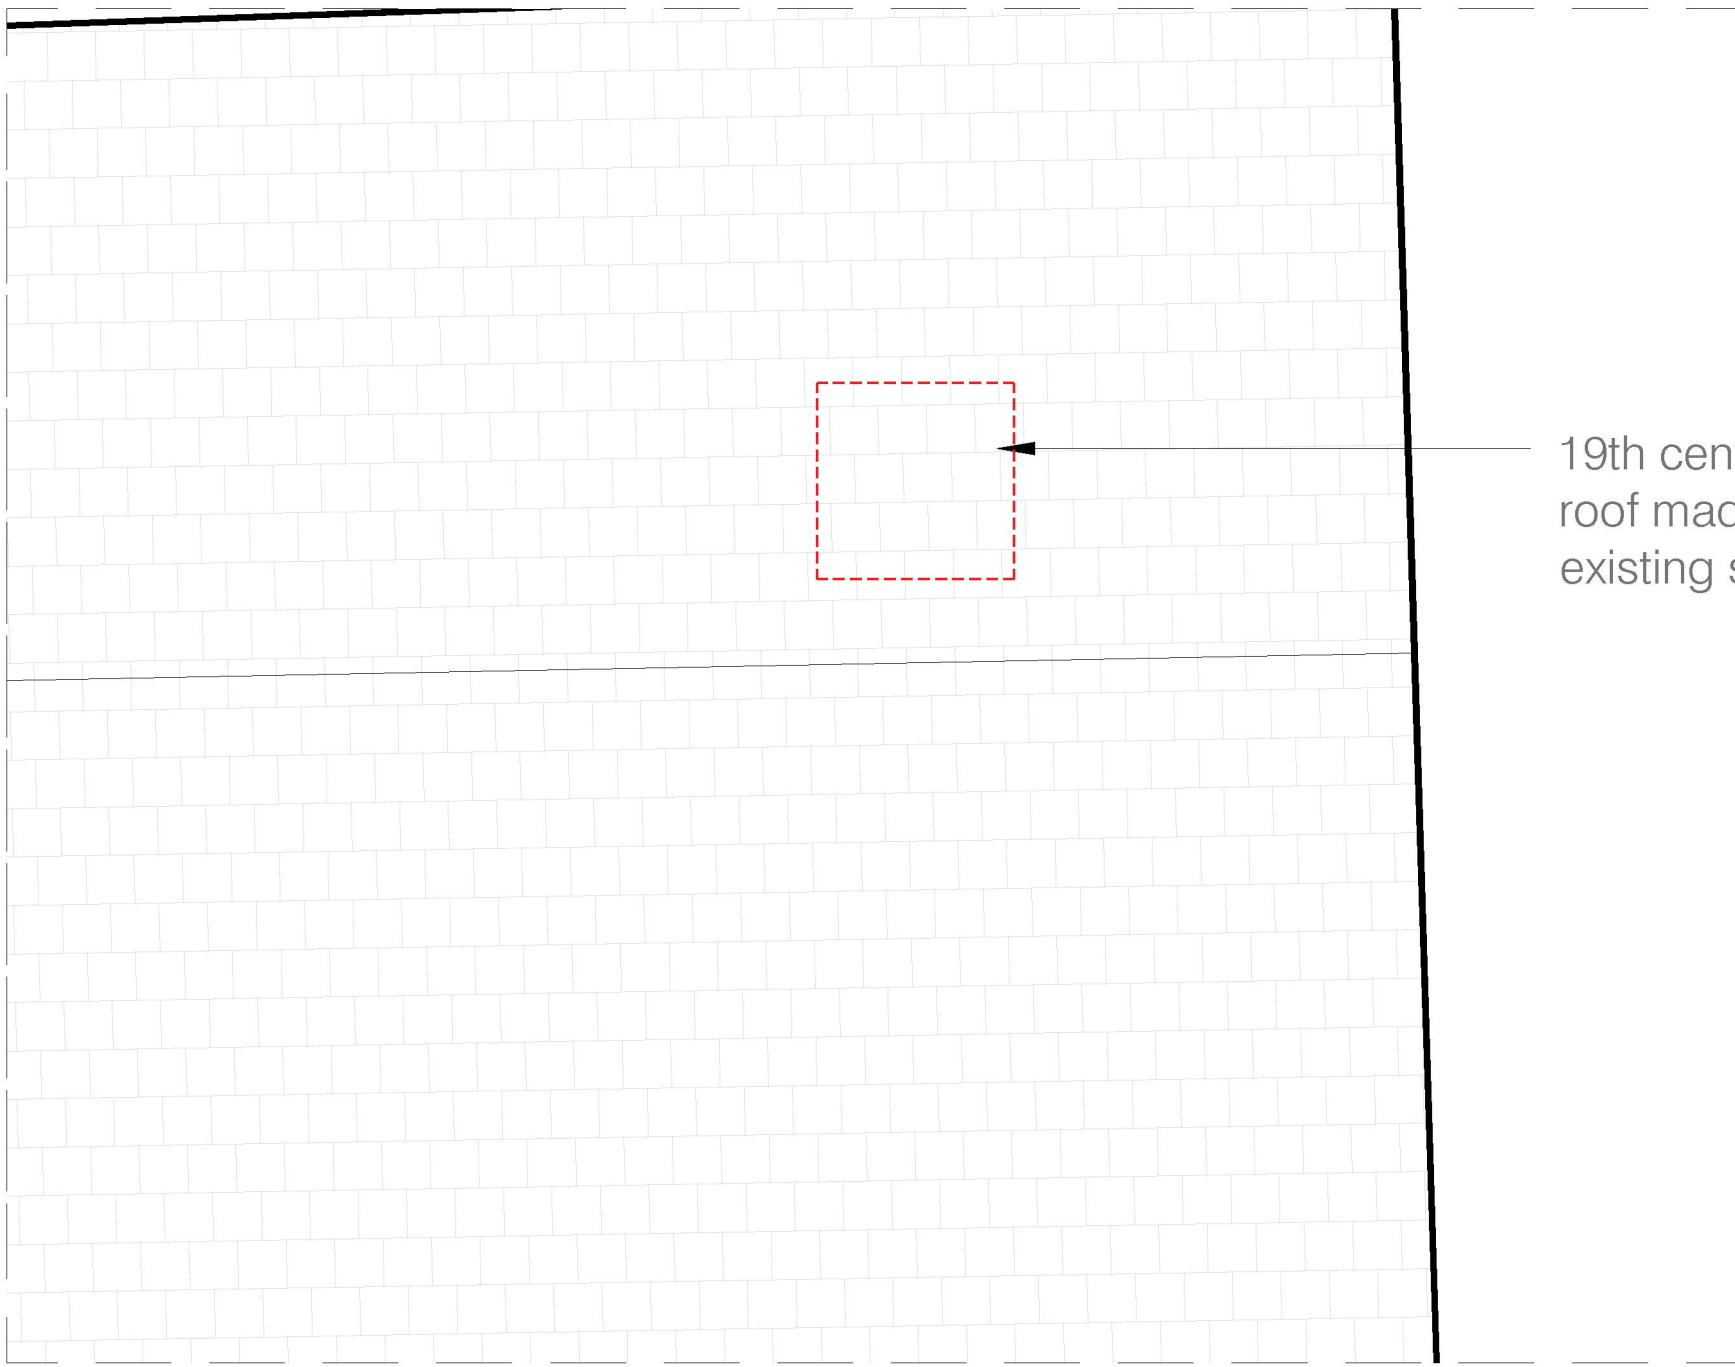


Approved Scheme Roof Plan
Scale 1:25@A1
1:50@A3

'As Built' / Proposed Roof Plan
Scale 1:25@A1
1:50@A3

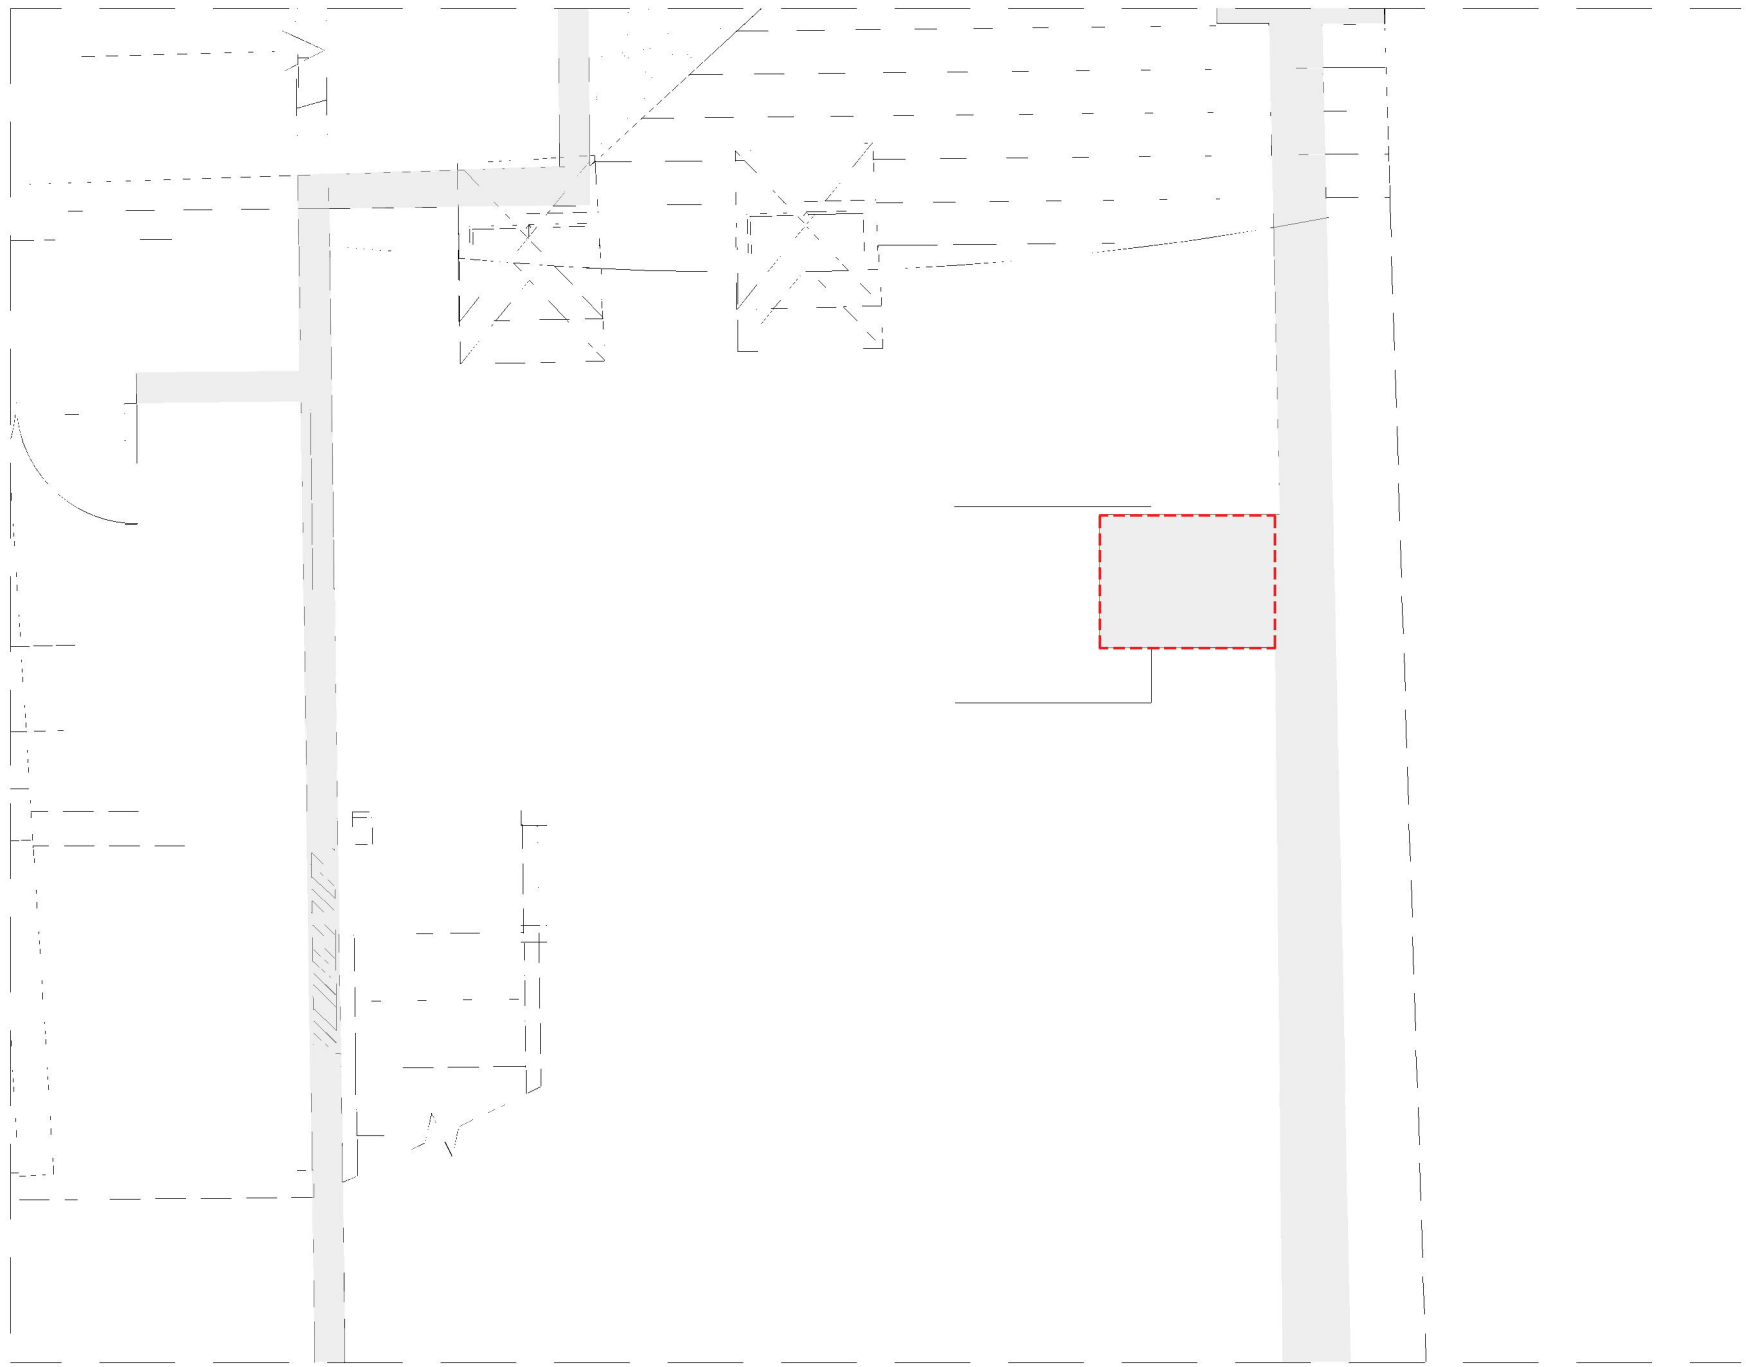

Approved Scheme Second Floor Plan
Scale 1:25@A1
1:50@A3

'As Built' / Proposed Second Floor Plan
Scale 1:25@A1
1:50@A3

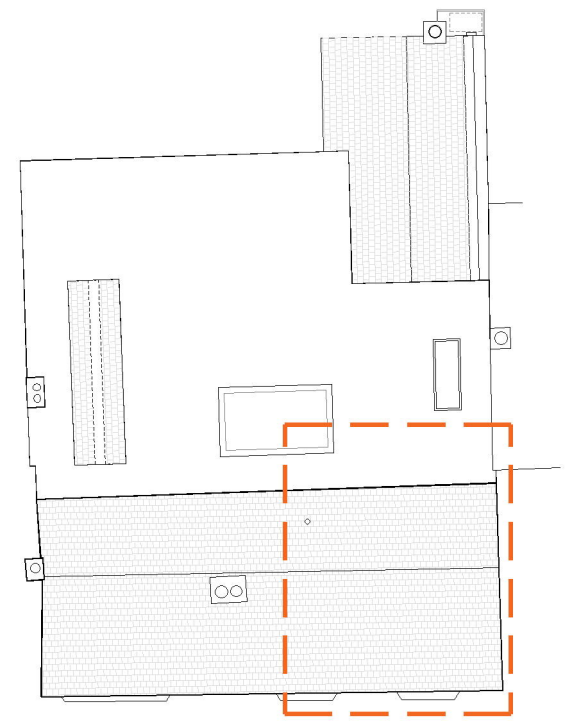

Key Plan 1:200@A1, 1:400@A3

KEY:
Highlighted difference between Approved Scheme and 'As-Built'/Proposed Scheme

NOTE
DRAWINGS TO BE READ IN CONJUNCTION WITH SUBMITTED DESIGN&ACCESS STATEMENT AND HERITAGE STATEMENT MATERIALS INSTALLED IN ACCORDANCE WITH THOSE OUTLINED IN CONDITION #9 OF APPROVAL DM/23/1605

Rev.	Comments	By:	Date:
-	-	-	-

Do not scale this drawing All dimensions must be checked on site
All rights reserved. No reproduction in any material form is permitted without consent.

LISTED BUILDING CONSENT			
Client: Mr. Simon Dougall			
Project Title: 107 High St, Lindfield, Haywards Heath, West Sussex, RH16 2HR			
Drawing Title: Detail Drawings: Removal of chimney - Sheet 2 of 2			
Scale: 1:25@A1 1:50@A3	Date: Apr 25	Drawn: KN	Checked: KW

kyson ⁺ Studio		
28 Scrutton Street London UK EC2A 4RP		
T: +44(0) 20 7247 2462 E: enquiries@kyson.co.uk W: www.kyson.co.uk		
Project No.: 900-25	Drawing No.: 5006	Revision: -

