




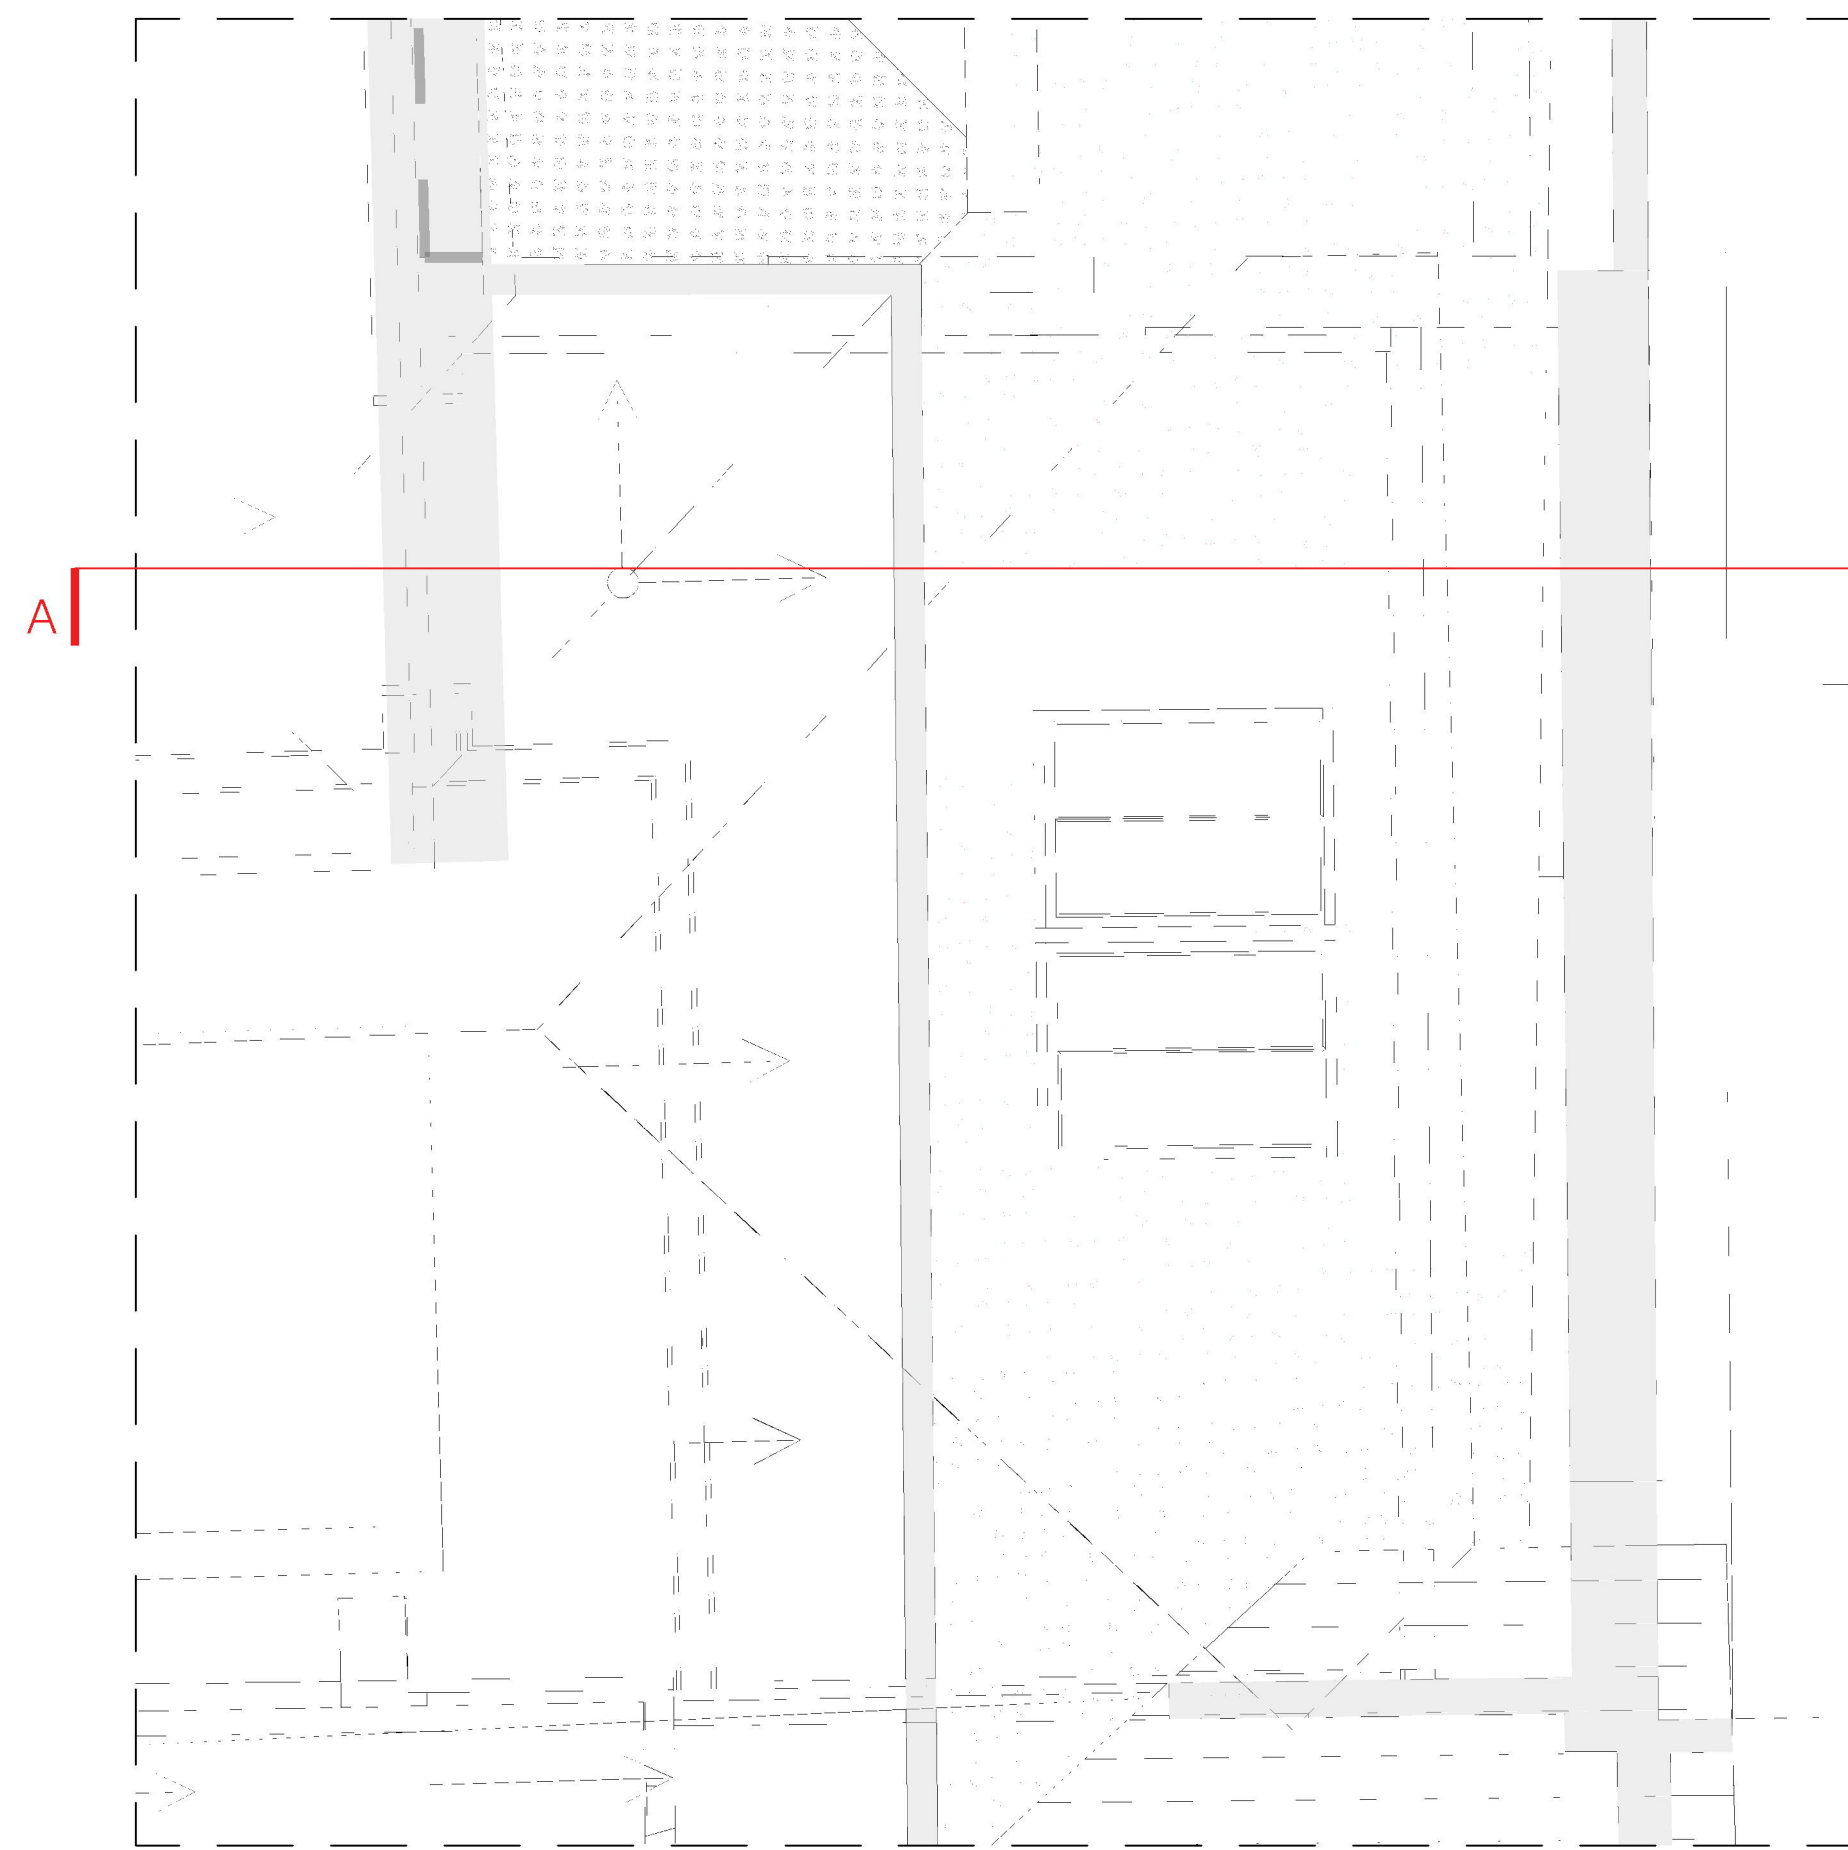


Approved Scheme Roof Plan
Scale 1:25@A1
1:50@A3

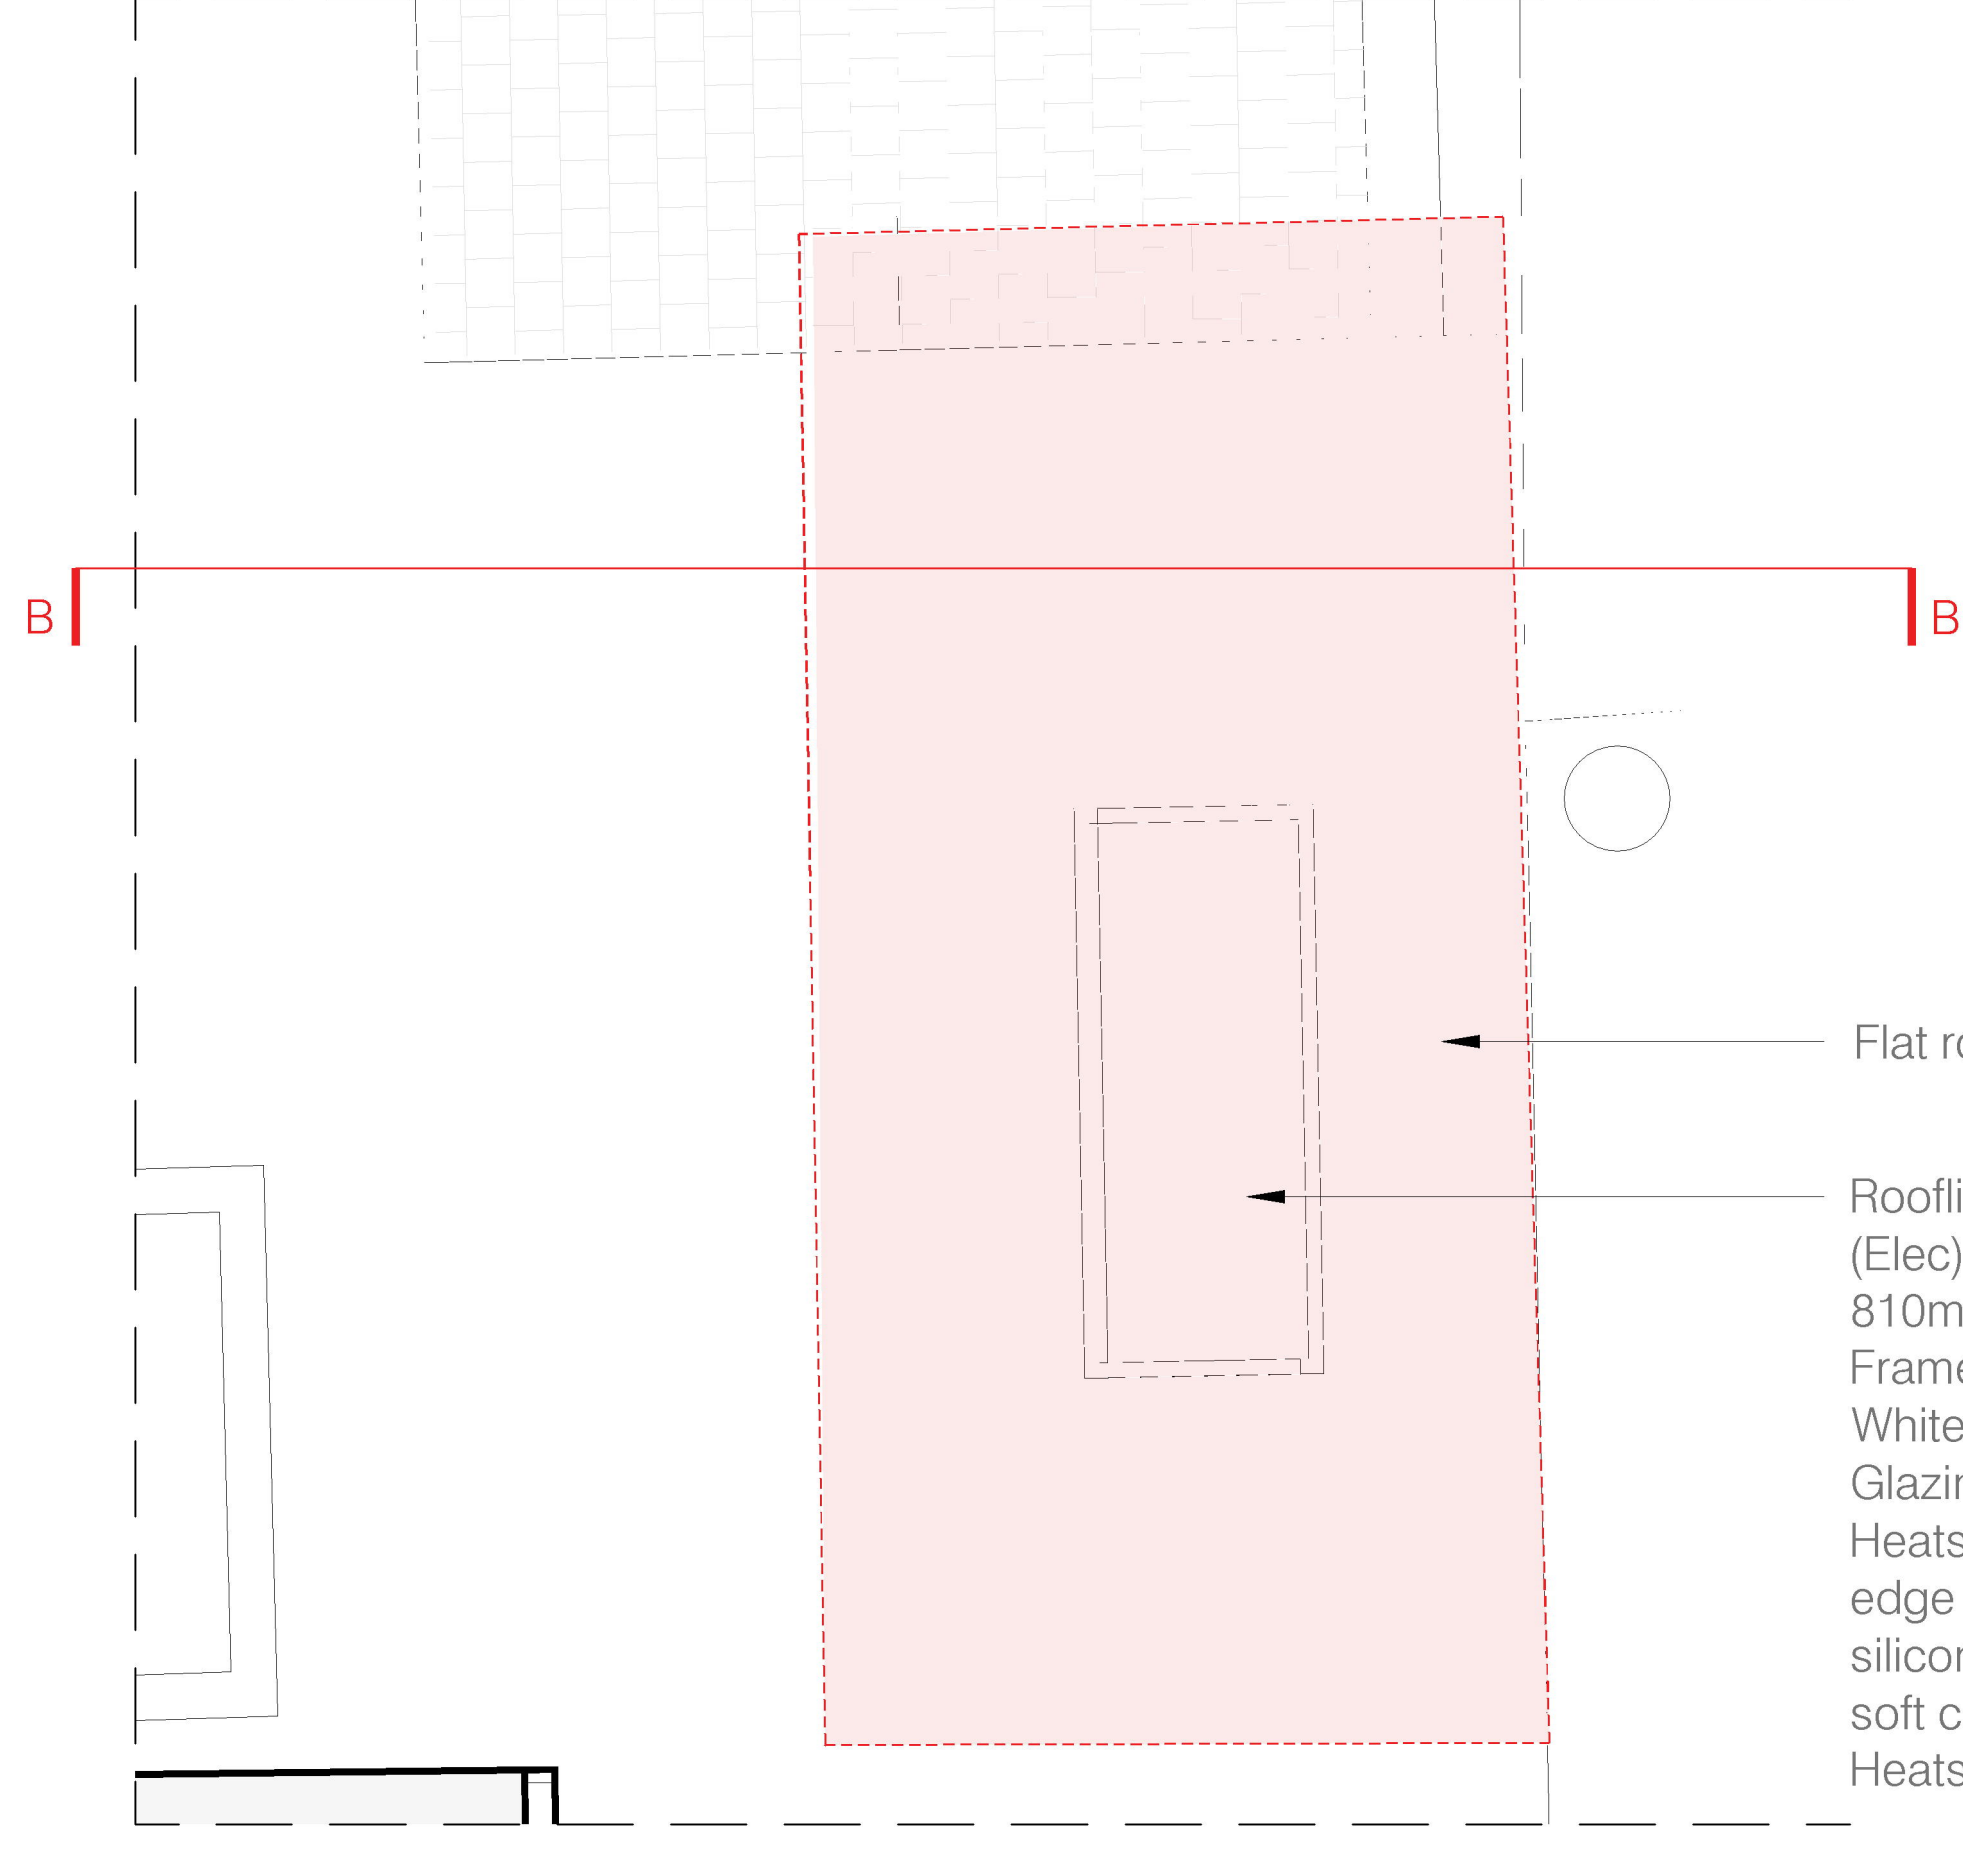

Proposed Roof Plan
Scale 1:25@A1
1:50@A3

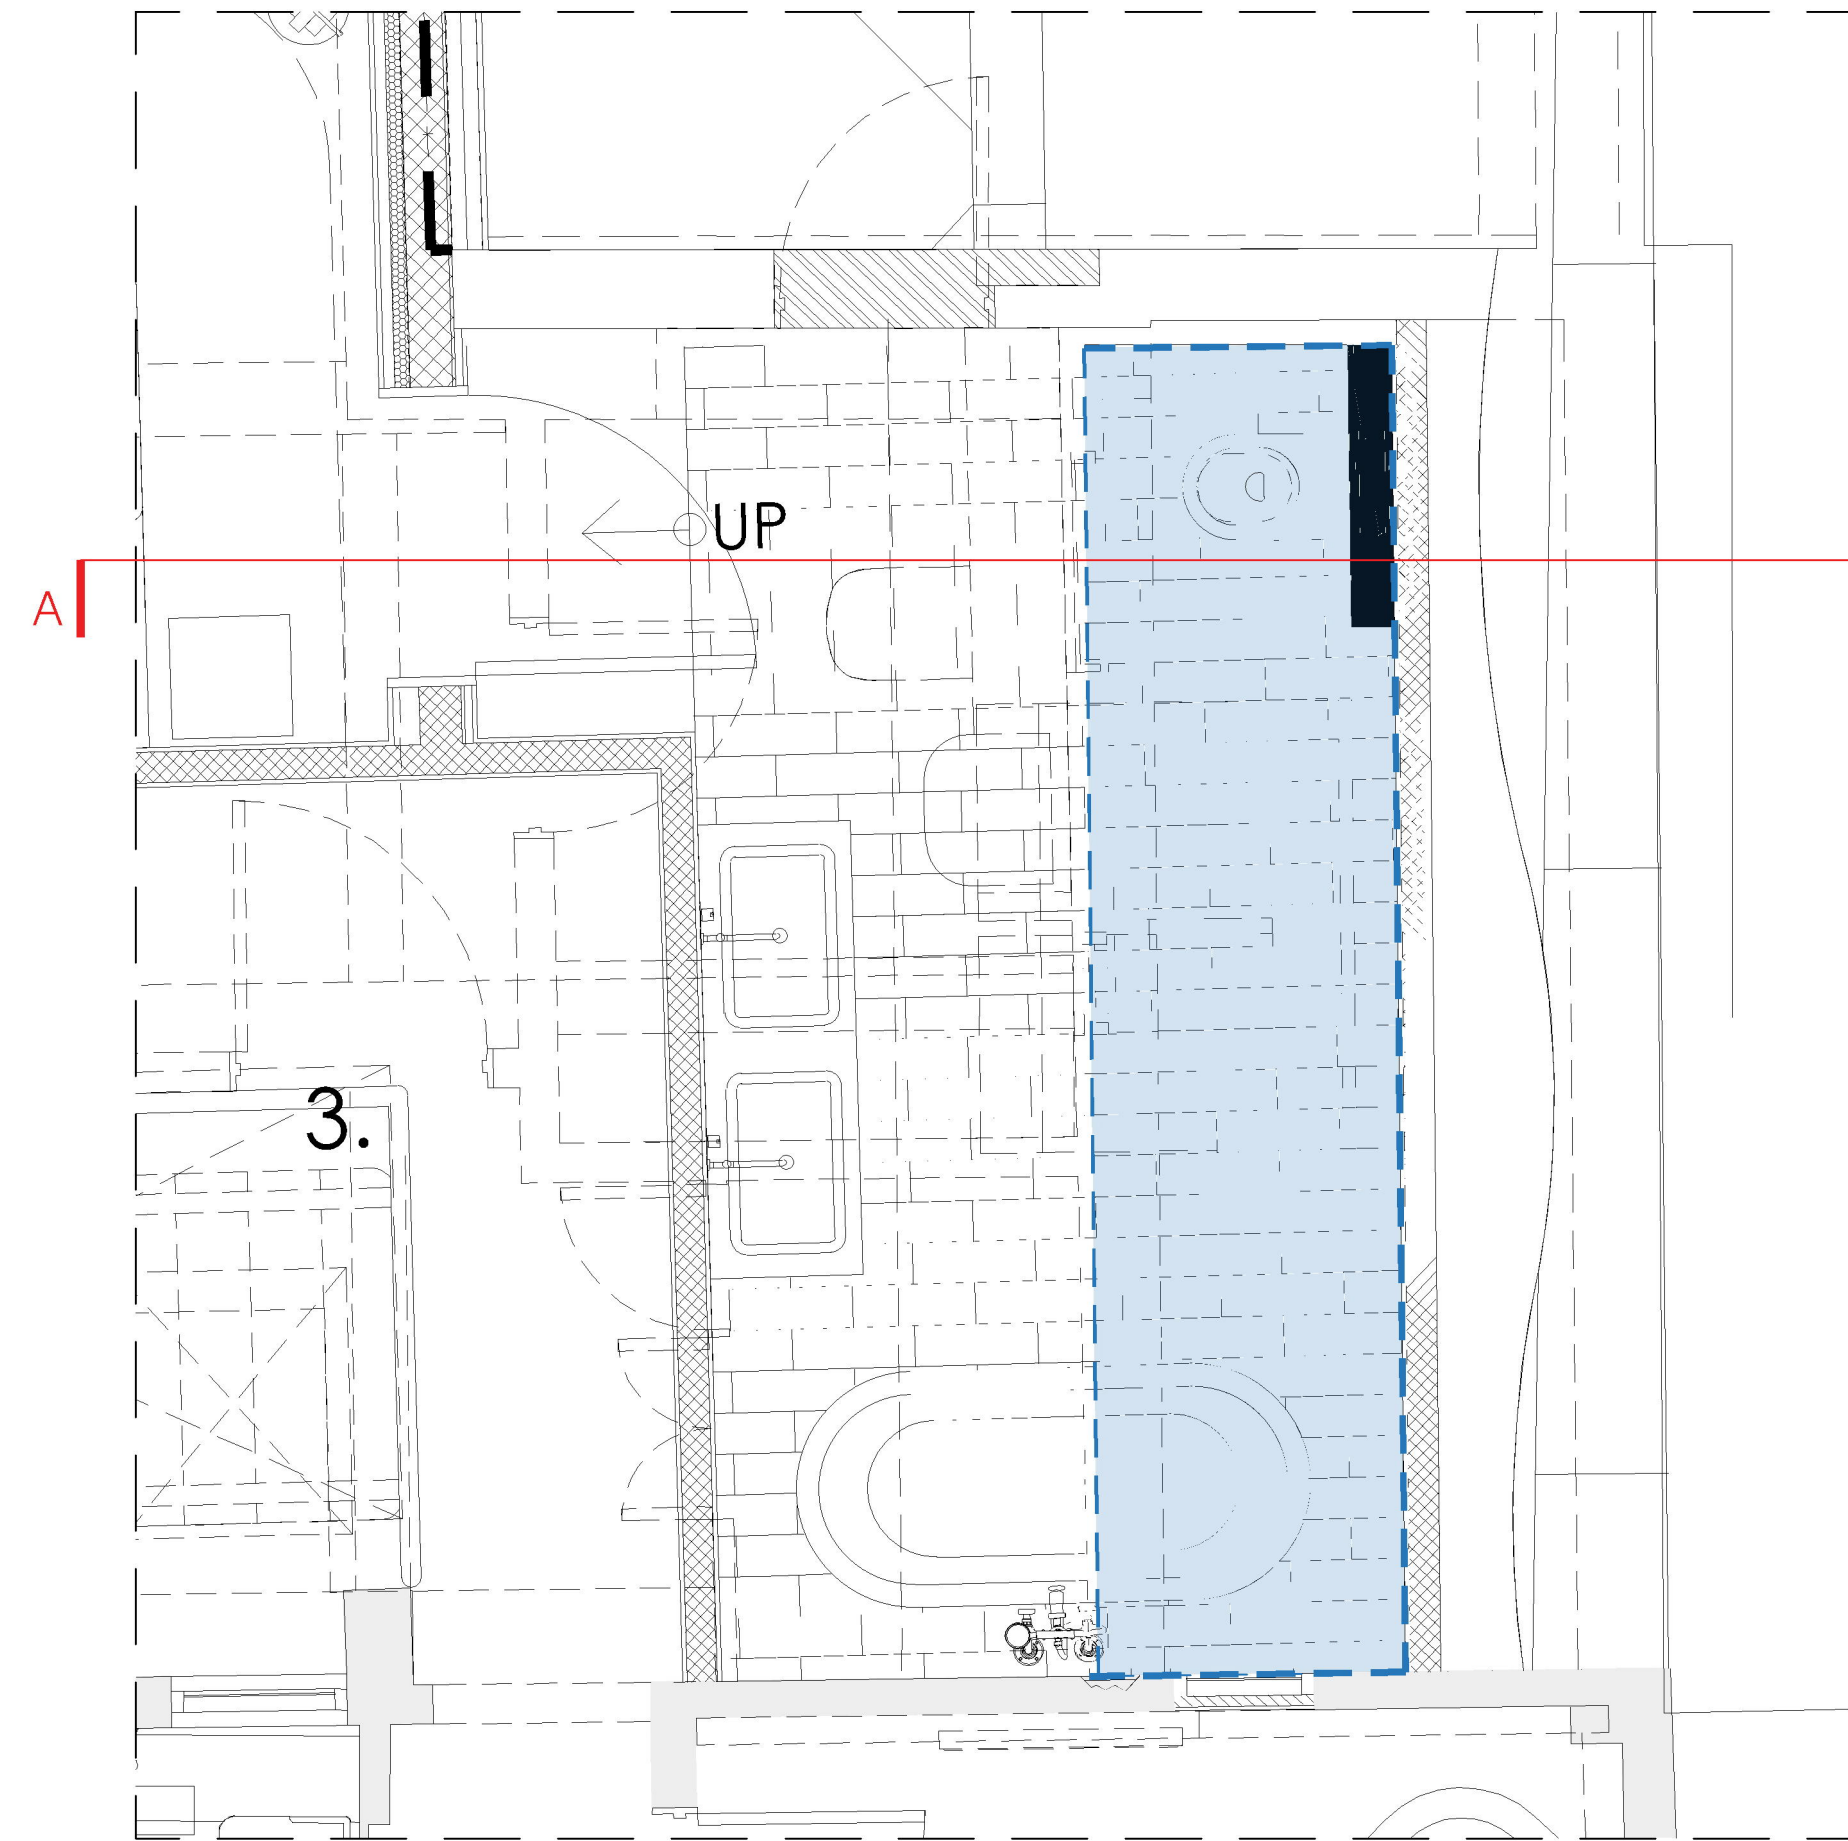

Approved Scheme First Floor Plan
Scale 1:25@A1
1:50@A3

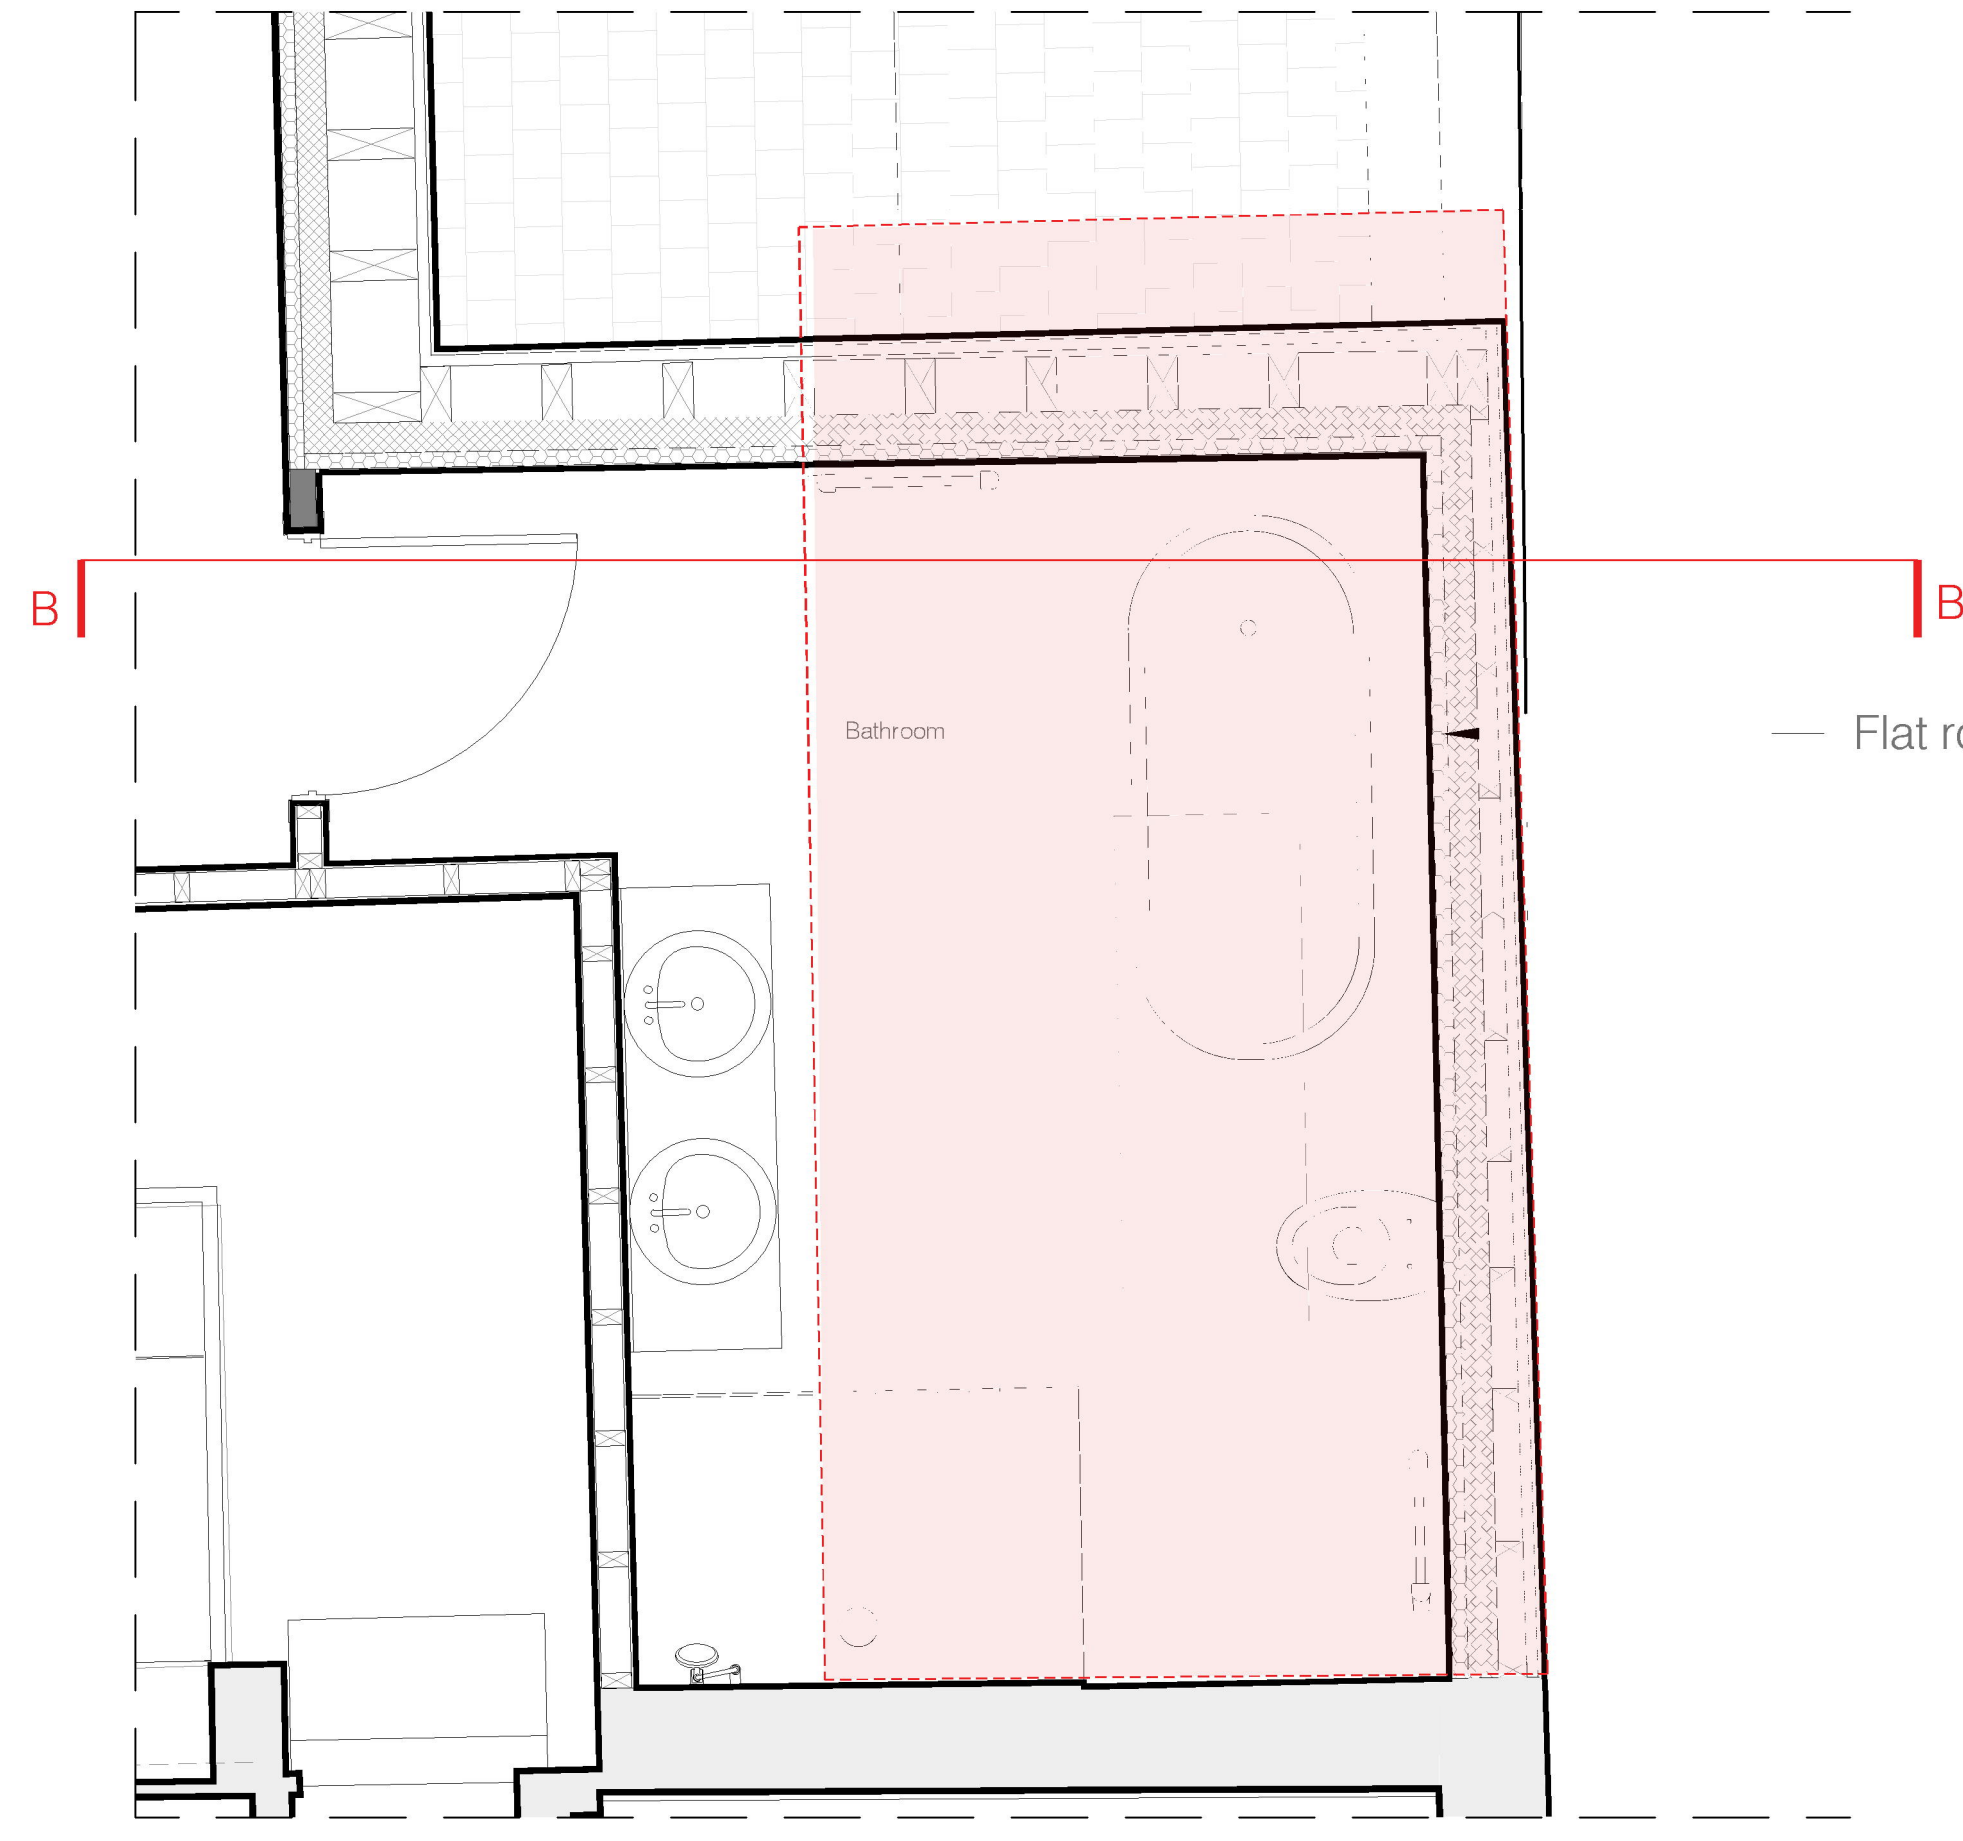

Proposed First Floor Plan
Scale 1:25@A1
1:50@A3


Flat roof infill above en-suite

Rooflight by Duplus, SB Opener (Elec) + Cover Frame, 1970mm x 810mm
Frame colour: Internal 9910 Matt White / External 7016 Matt Grey
Glazing Spec: 6mm Clear TGH & Heatsoaked/16mm Black warm edge spacer argon gas filled silicone (DC3362) seal/6mm Clear soft coat 1.0 (Low E) TGH & Heatsoaked


Flat roof infill above en-suite

- KEY:
- Highlighted difference between Approved Scheme and 'As-Built'/Proposed Scheme
 - Area of unusable space, floor to ceiling height less than 1,5m


NOTE
DRAWINGS TO BE READ IN CONJUNCTION WITH SUBMITTED DESIGN&ACCESS STATEMENT AND HERITAGE STATEMENT MATERIALS INSTALLED IN ACCORDANCE WITH THOSE OUTLINED IN CONDITION #9 OF APPROVAL DM/23/1605

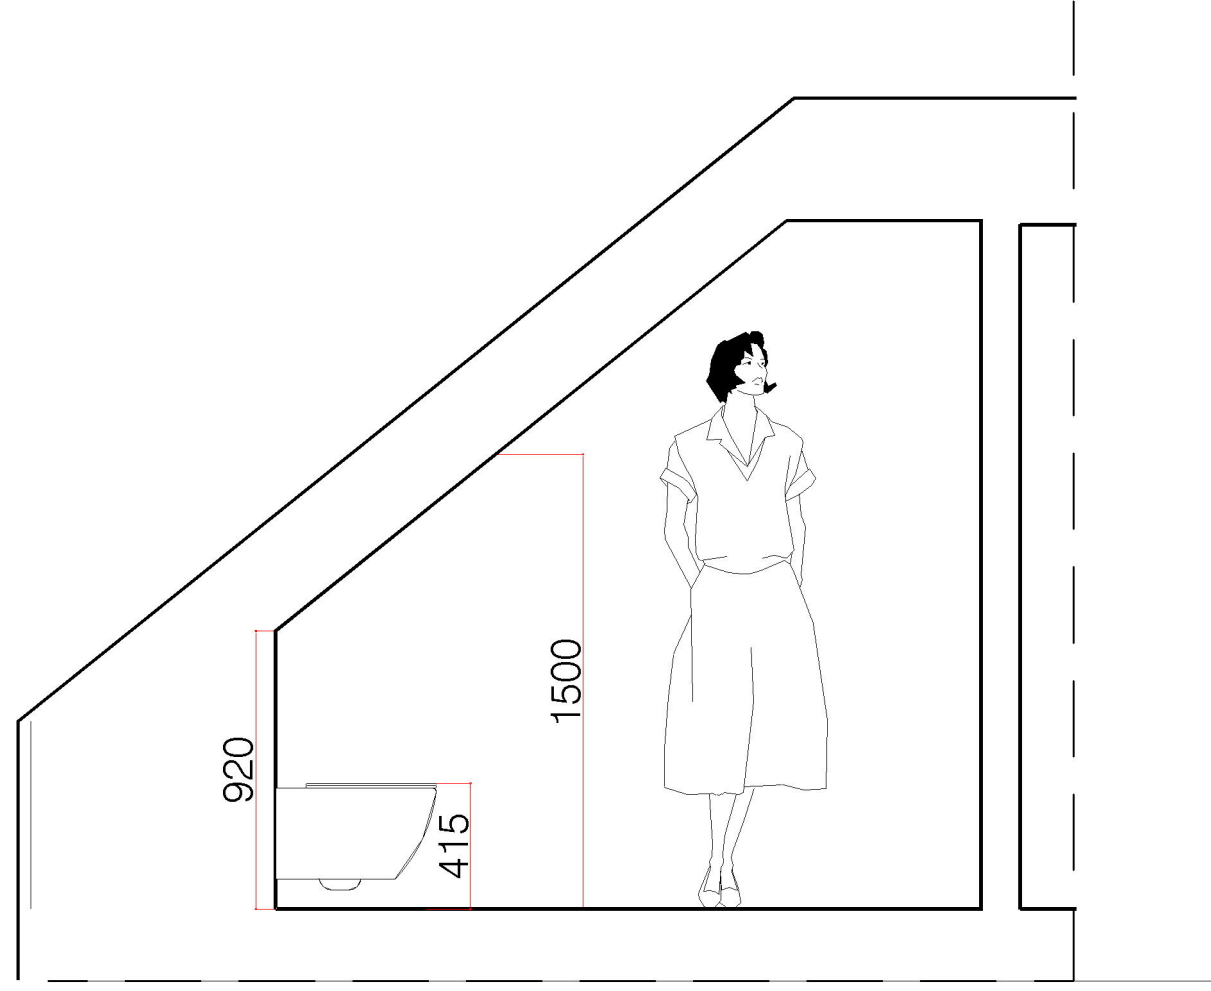

Proposed
First Floor En-Suite Section AA
Scale 1:25@A1
1:50@A3

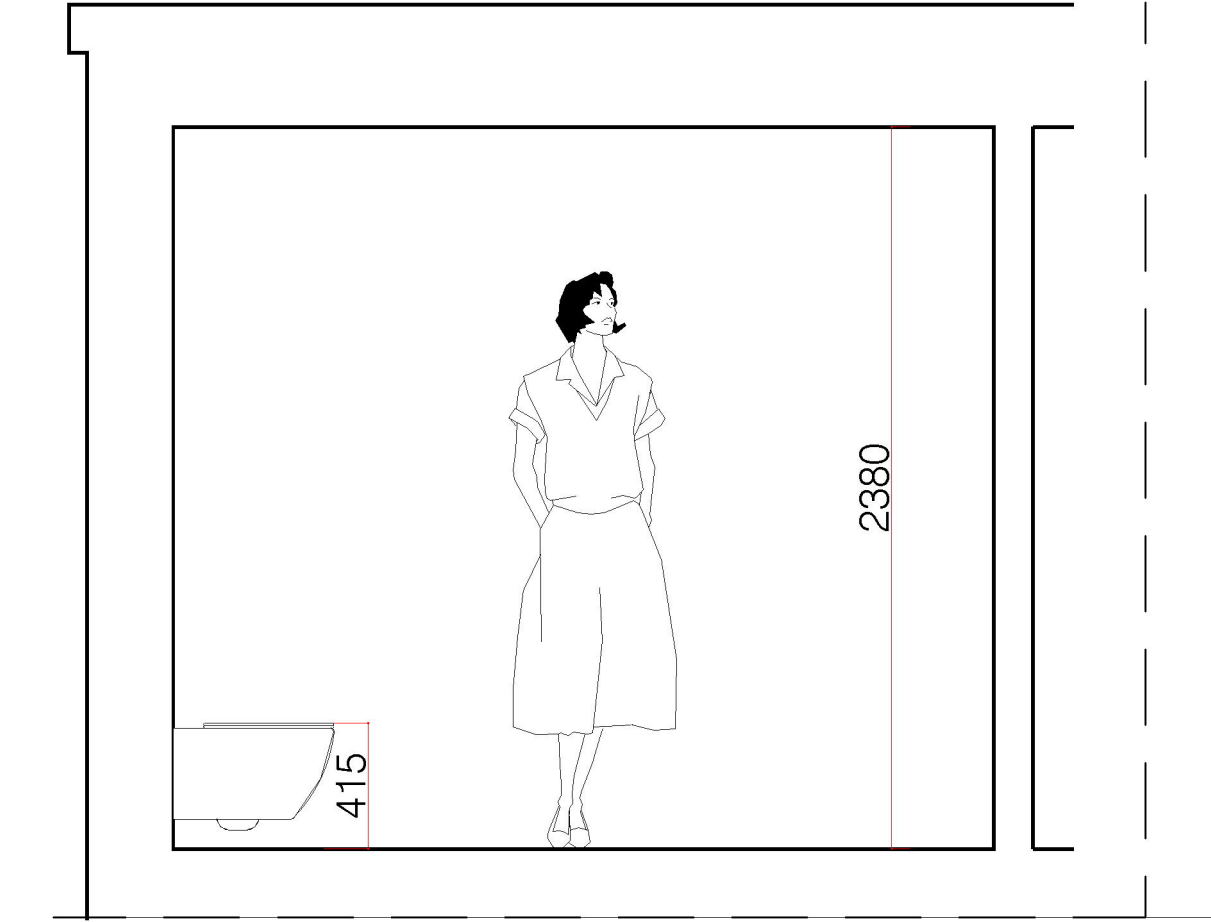

Approved Scheme
First Floor En-Suite Section BB
Scale 1:25@A1
1:50@A3

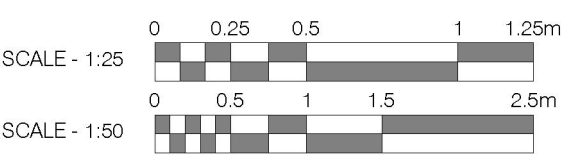

Do not scale this drawing. All dimensions must be checked on site. All rights reserved. No reproduction in any material form is permitted without consent.

LISTED BUILDING CONSENT

Client:
Mr. Simon Dougal

Project Title:
107 High St, Lindfield, Haywards Heath, West Sussex, RH16 2HR

Drawing Title:
Detail Drawings:
Flat Roof Infill - Sheet 1 of 2

Scale: 1:25@A1 1:50@A3
Date: Apr 25
Drawn: KN
Checked: KW

kyson

Studio
28 Scrutton Street
London
UK
EC2A 4RP

T: +44(0) 20 7247 2462
E: enquiries@kyson.co.uk
W: www.kyson.co.uk

Project No.: 900-25
Drawing No.: 5010
Revision: -