

PROPOSED SCHEME

'As Built' / Proposed Scheme - Driveway Gates Elevation
Scale 1:20


'As Built' / Proposed Scheme - Driveway Gates Elevation
Scale 1:20

APPROVED SCHEME

Approved Scheme - Driveway Gates Elevation
Scale 1:20

Approved Scheme - Driveway Gates Plan
Scale 1:20

KEY:
Highlighted difference between Approved Scheme and 'As-Built'/Proposed Scheme

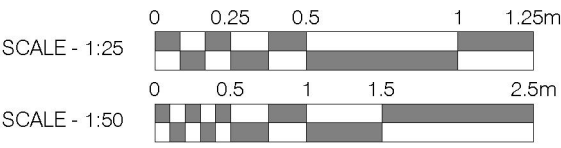

Haddonstone T301 onceweathered coping stone. Formed of Portland stone-coloured wet-cast reconstituted stone. Stonework mortar mix: 1:1:6 (Cement : Lime : Sand).

Brickwork wall

Brickwork gate post / pier

Gates by Creative Metal design Limited. Hand crafted oiled Balau hardwood clad double entrance gates with open bottom section. 60x40mm box section frame, solid 16mm round bar open section. Colour coded hinge brackets with integrated grease nipples and gate fitting shoes. All fixings are stainless steel. Fine texture powder coated finish.

Gates by Creative Metal design Limited. Hand crafted oiled Balau hardwood clad double entrance gates with open bottom section. 60x40mm box section frame, solid 16mm round bar open section. Colour coded hinge brackets with integrated grease nipples and gate fitting shoes. All fixings are stainless steel. Fine texture powder coated finish.

Brickwork gate post / pier with coping stone

Brickwork wall with coping stone

Bullnose brick detail omitted

Brick on edge detail with tile creasing omitted

Oiled timber gates in black metal frames


Side pedestrian gate omitted

Oiled timber gates in black metal frames

Side pedestrian gate omitted

Bullnose brick detail omitted

Side pedestrian gate omitted

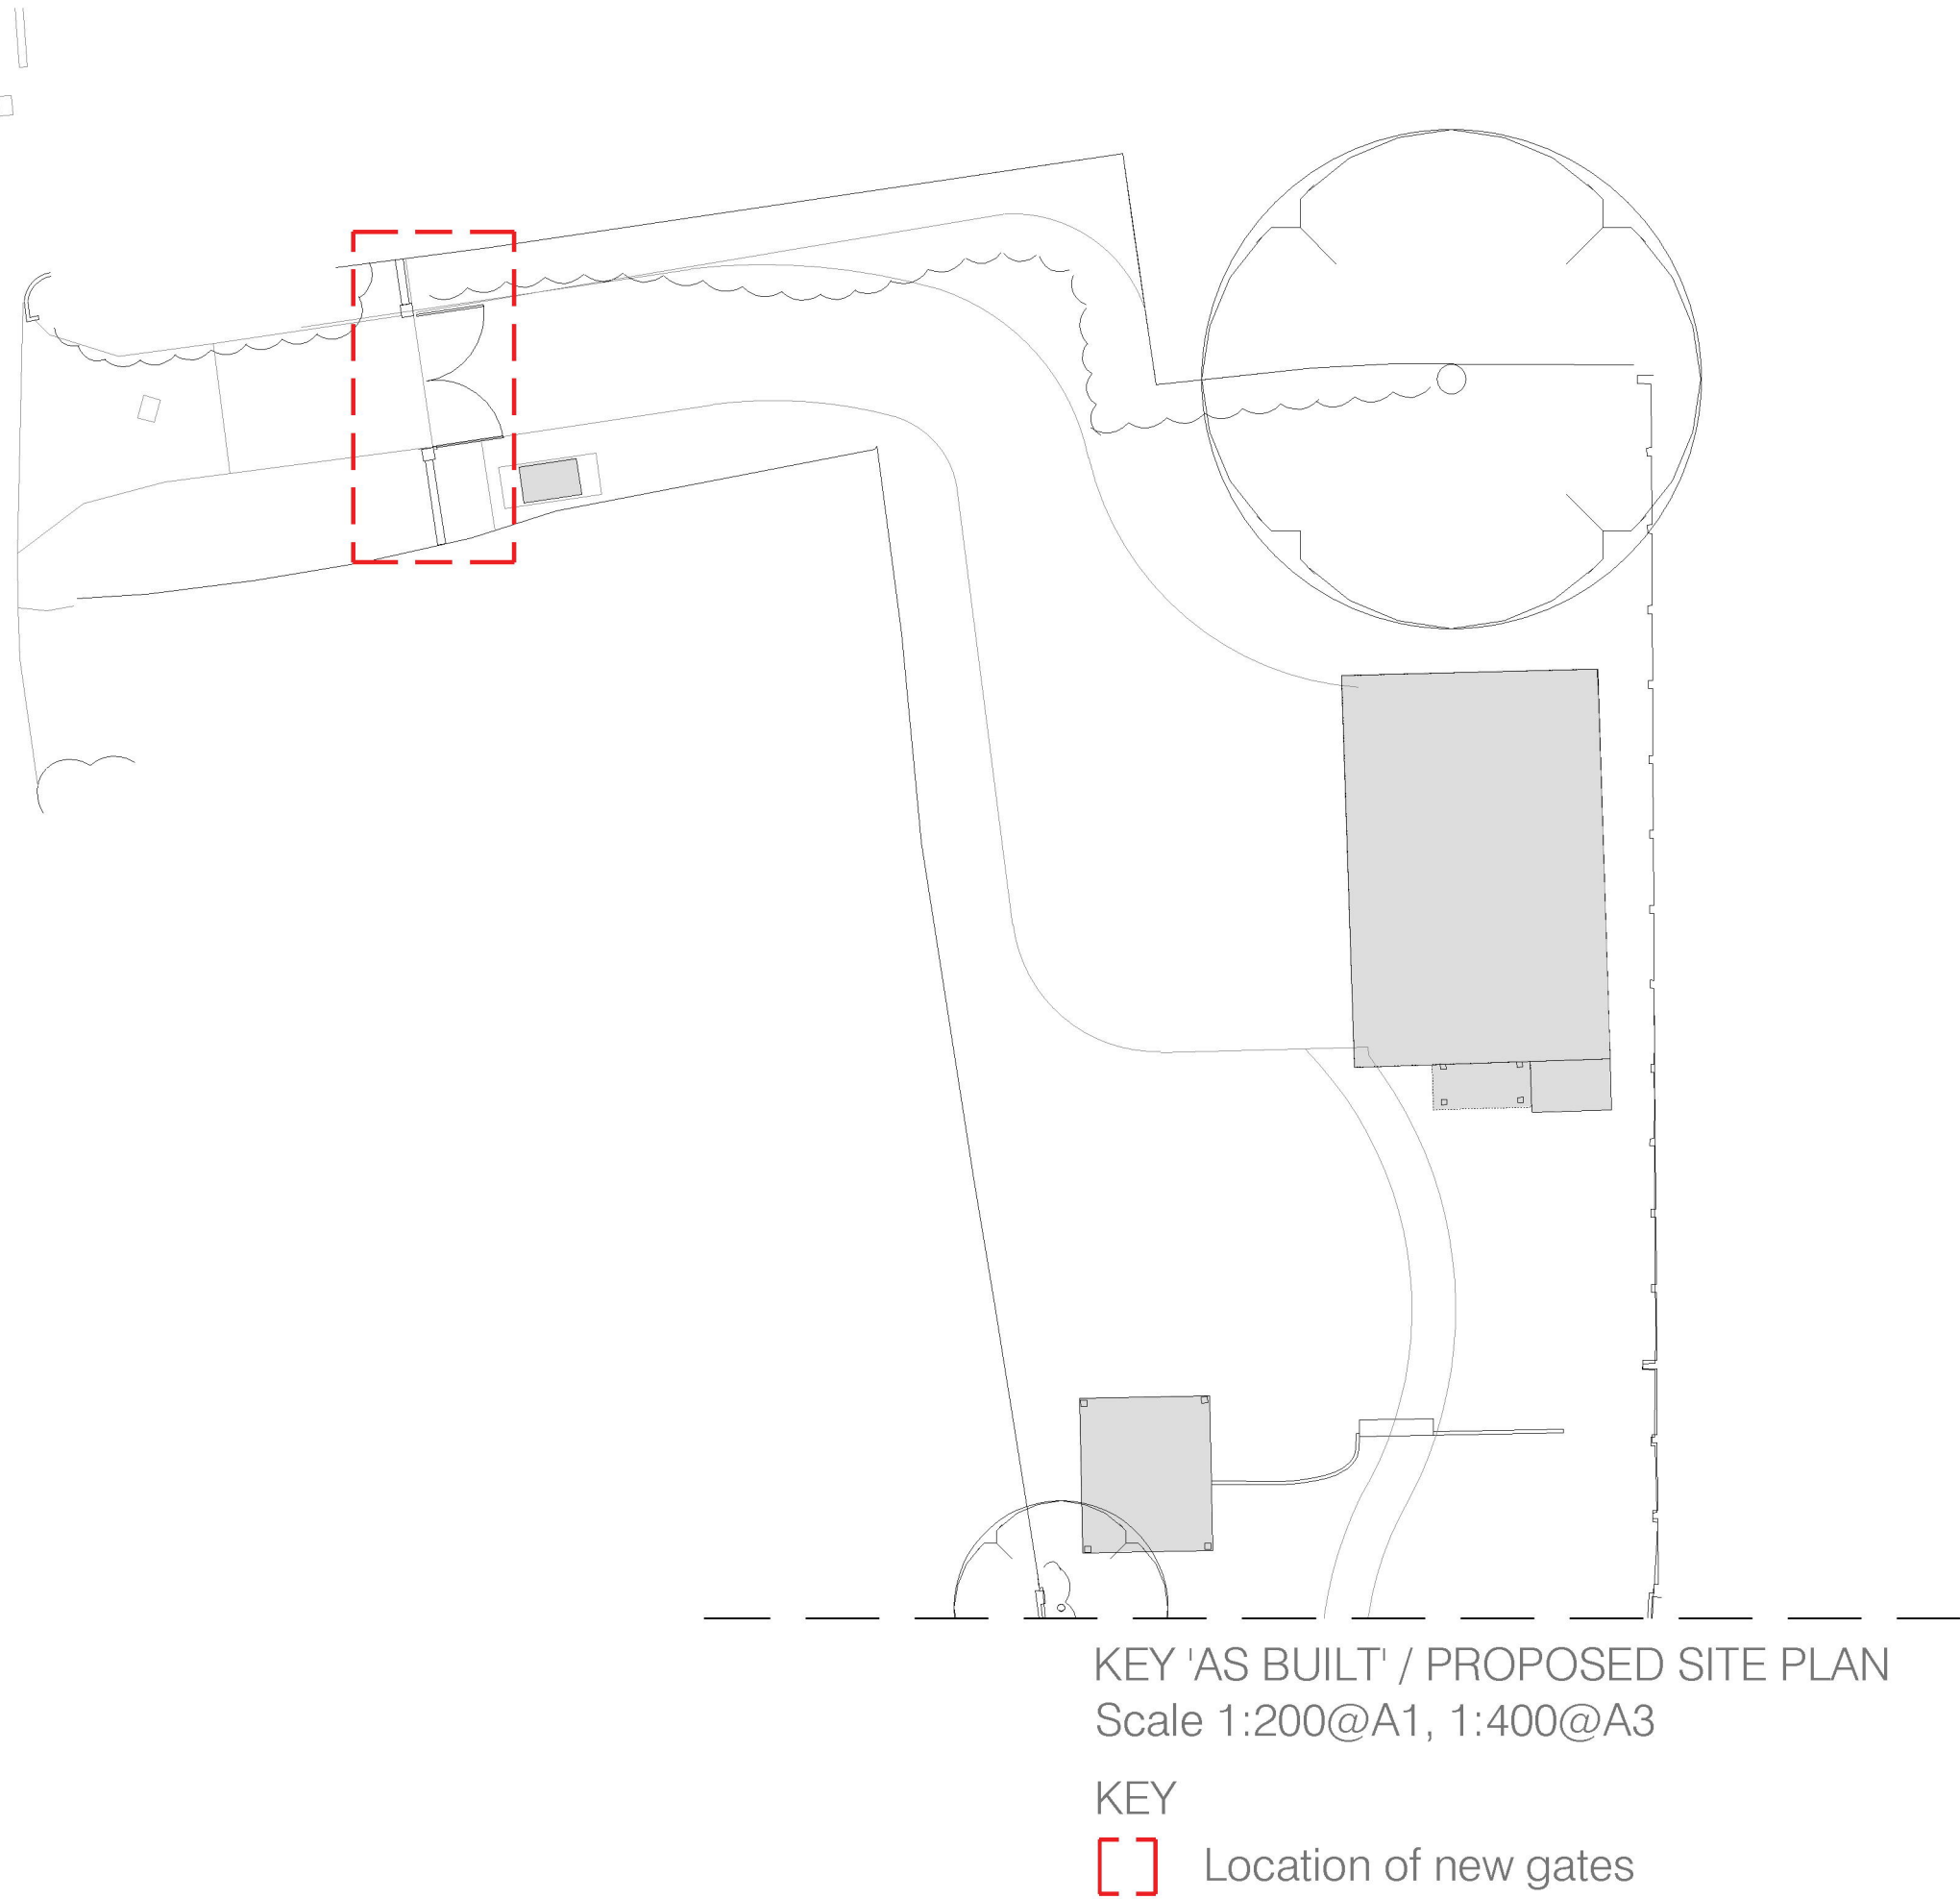

Recent photograph of built gates

NOTE
DRAWINGS TO BE READ IN CONJUNCTION WITH SUBMITTED DESIGN&ACCESS STATEMENT AND HERITAGE STATEMENT MATERIALS INSTALLED IN ACCORDANCE WITH THOSE OUTLINED IN CONDITION #9 OF APPROVAL DM/23/1605

Rev.	Comments:	By:	Date:
-	-	-	-

Do not scale this drawing All dimensions must be checked on site
All rights reserved. No reproduction in any material form is permitted without consent.

LISTED BUILDING CONSENT			
Client: Mr. Simon Dougall			
Project Title: 107 High St, Lindfield, Haywards Heath, West Sussex, RH16 2HR			
Drawing Title: Proposed GA Plans: Driveway Gates			
Scale: 1:25@A1 1:50@A3	Date: Apr 25	Drawn: KN	Checked: KW

kyson		
Studio		
28 Scrutton Street London UK EC2A 4RP		
T: +44(0) 20 7247 2462 E: enquiries@kyson.co.uk W: www.kyson.co.uk		
Project No.: 900-25	Drawing No.: 5012	Revision: -