



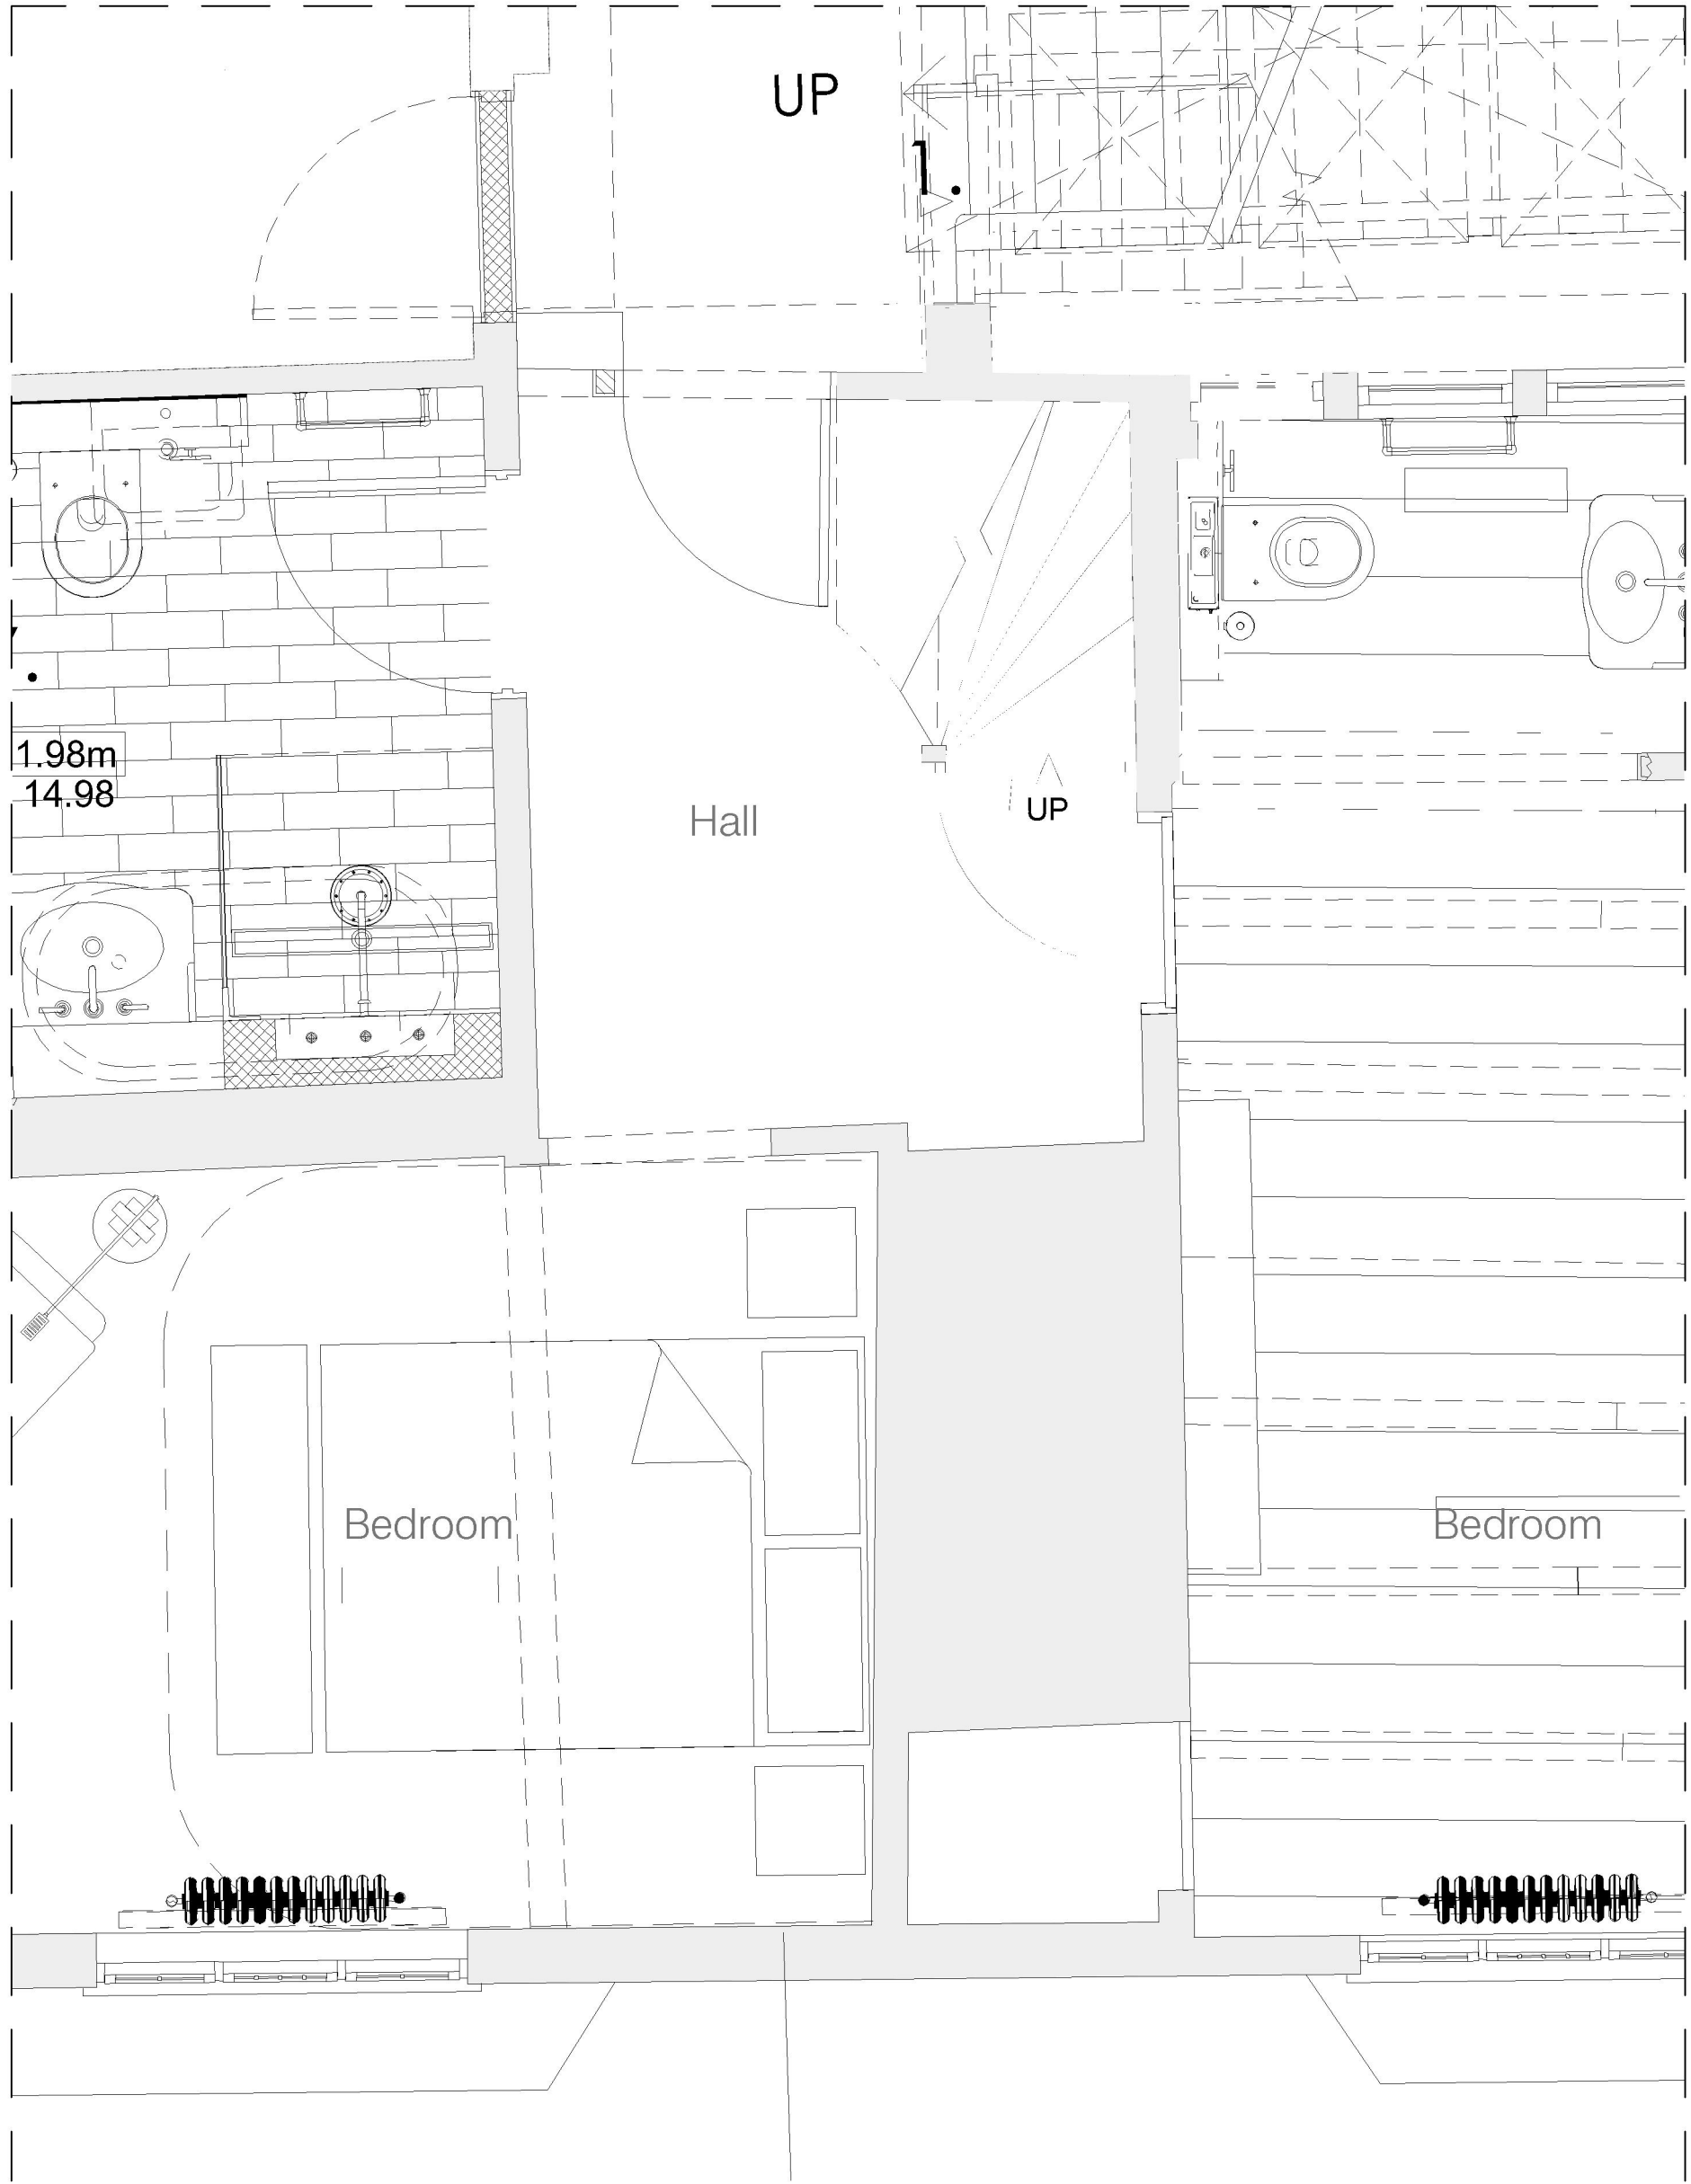

Approved Scheme First Floor Plan
Scale 1:25@A1
1:50@A3

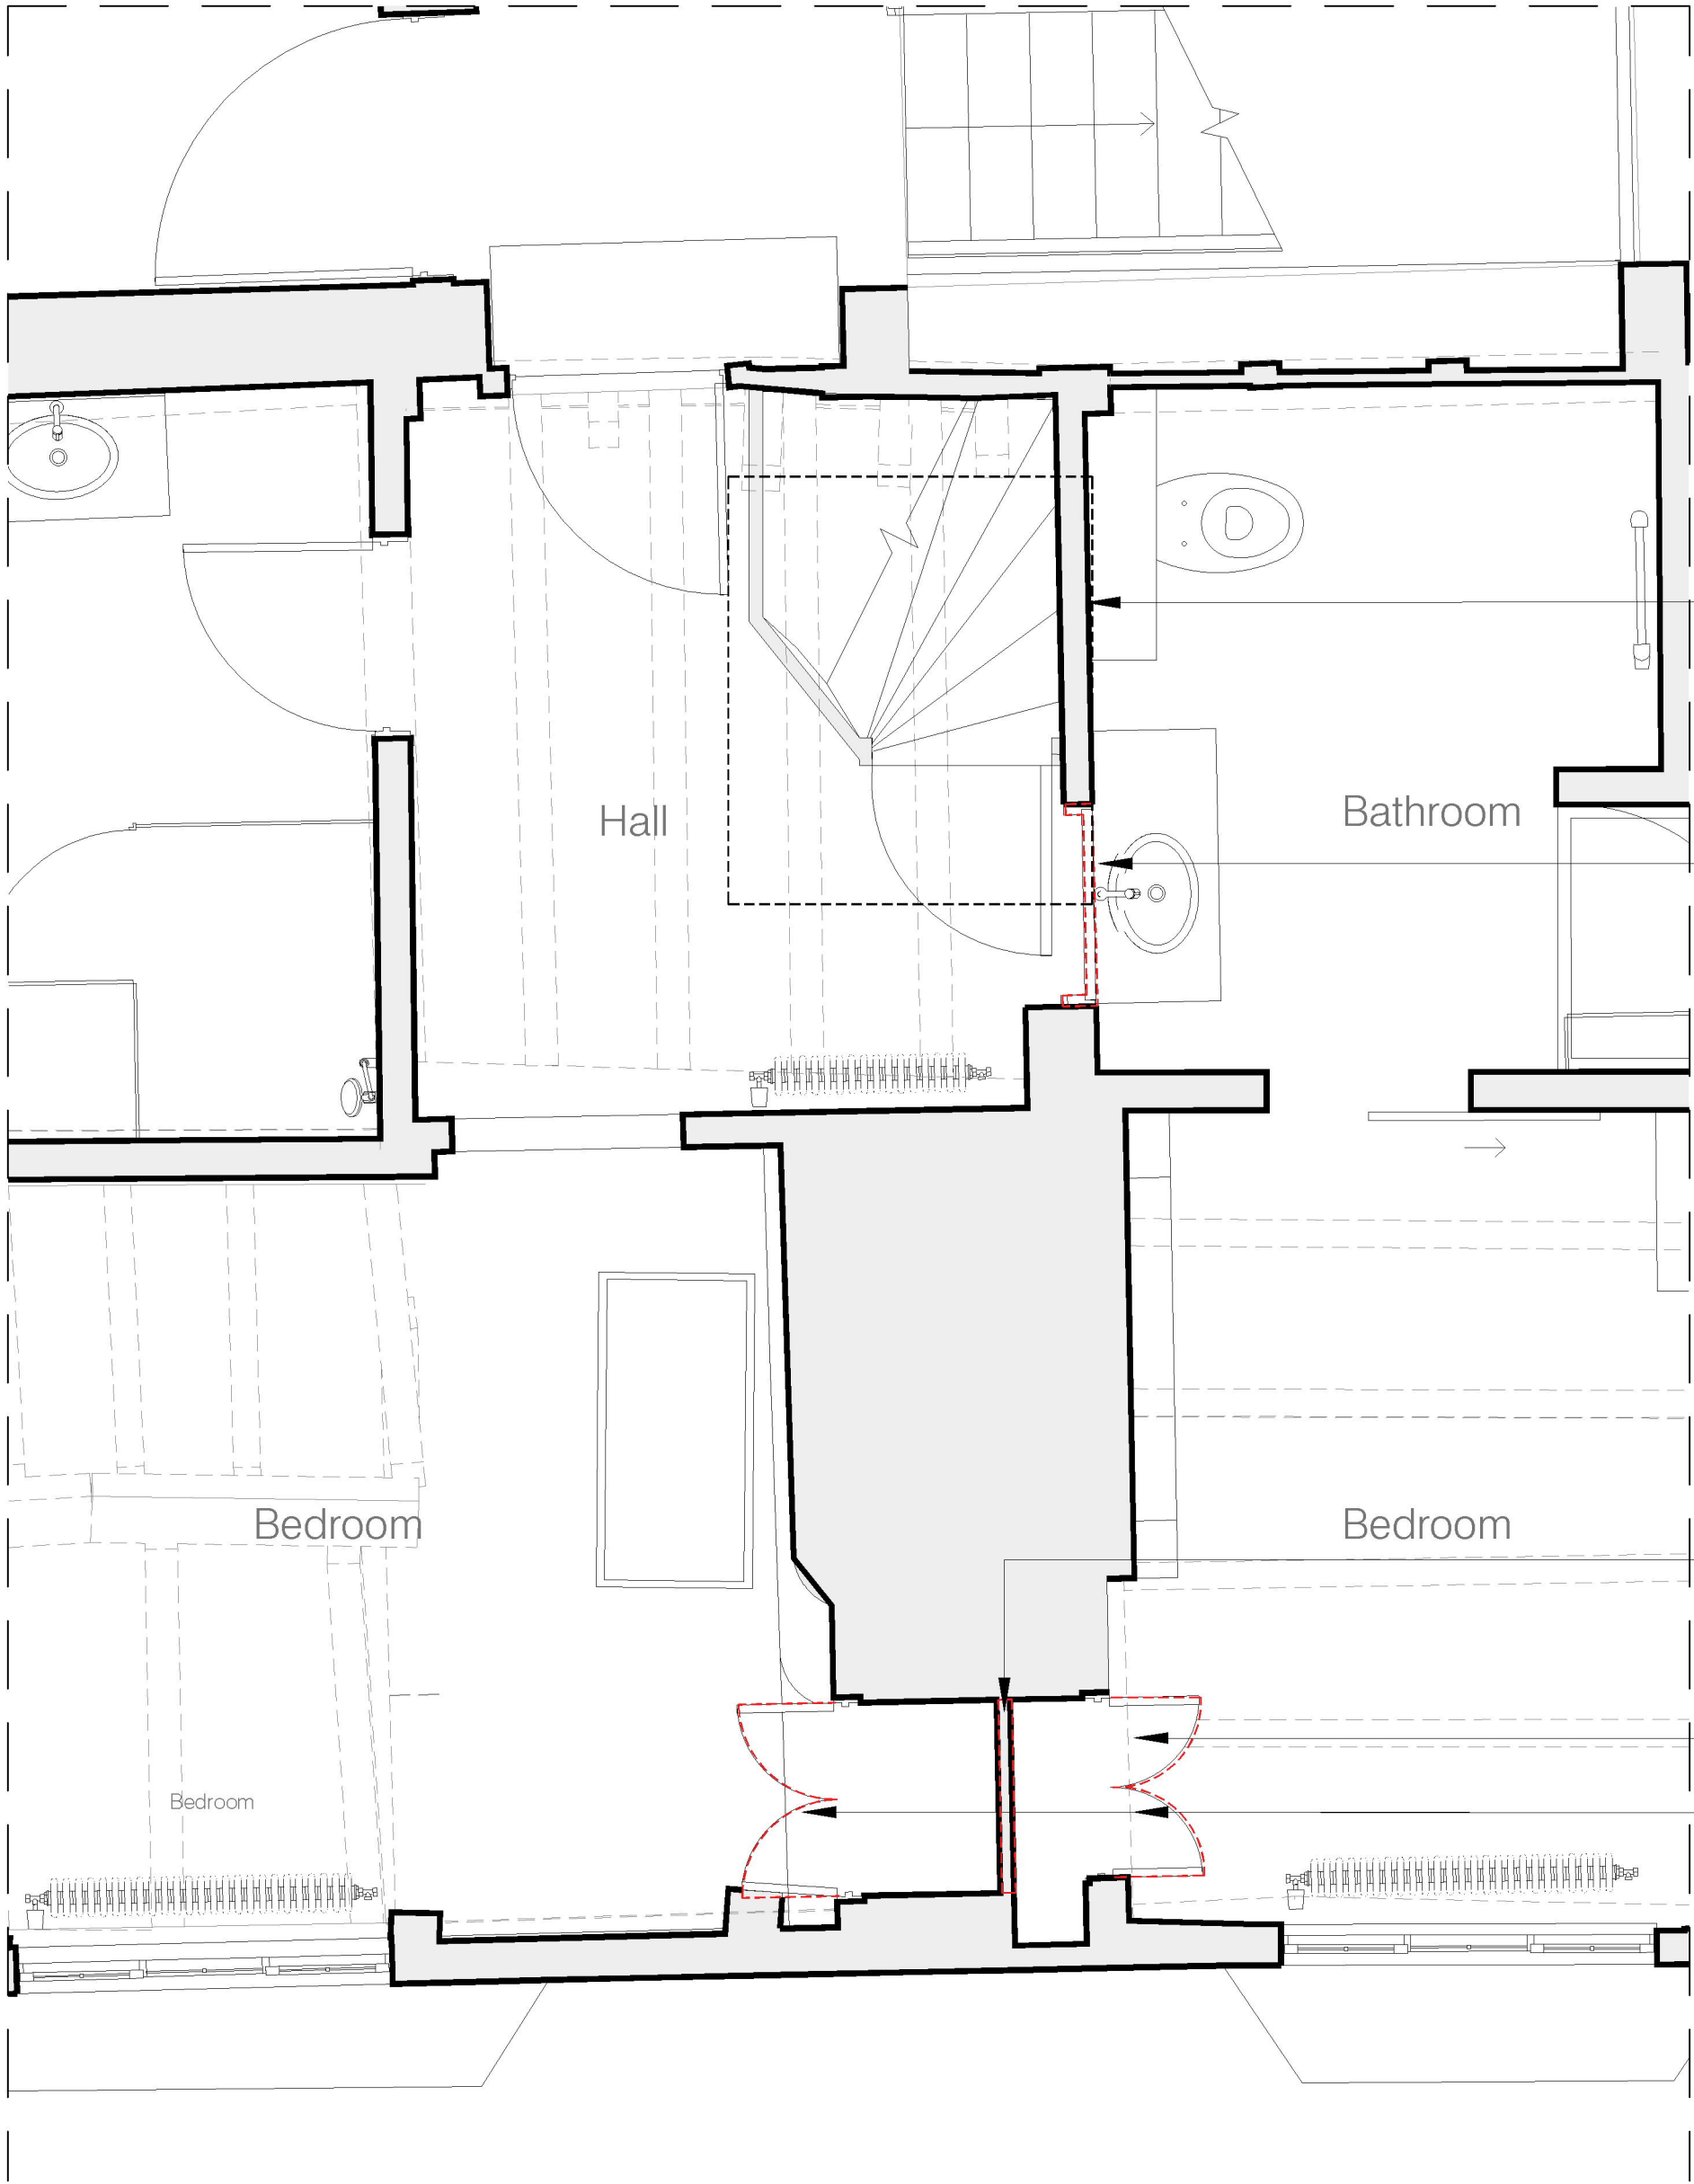

'As Built' / Proposed Scheme First Floor Plan
Scale 1:25@A1
1:50@A3


Refer to drawing 5008

Opening in wall reinstated.
Existing door retained by the
Applicant to be reinstalled and
fixed shut to suit new en-suite
layout.

Existing division reinstated

Existing door replaced

Fitted wardrobes joinery, 2no
18mm MDF back panels painted
off white

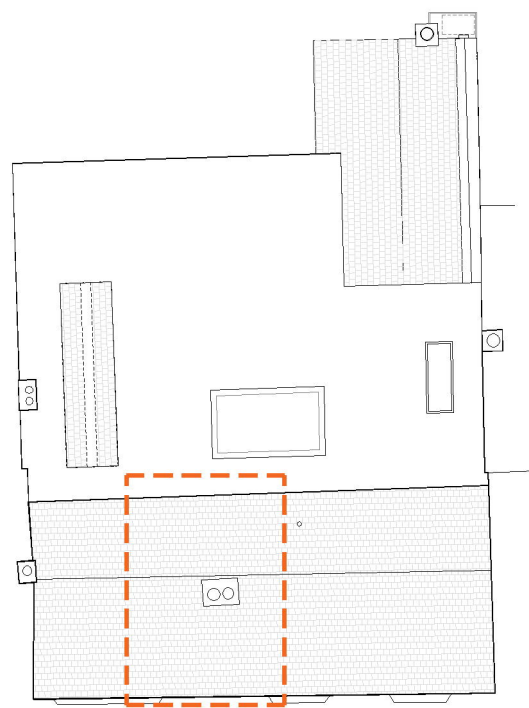

KEY PLAN
Scale 1:200@A1
1:400@A3



Fitted Wardrobe, view from North bedroom



Existing timber door to be
re-instated and fixed shut

KEY:
Highlighted difference between Approved
Scheme and 'As-Built'/Proposed Scheme

NOTE
DRAWINGS TO BE READ IN CONJUNCTION WITH SUBMITTED
DESIGN&ACCESS STATEMENT AND HERITAGE STATEMENT
MATERIALS INSTALLED IN ACCORDANCE WITH THOSE
OUTLINED IN CONDITION #9 OF APPROVAL DM/23/1605

Rev.	Comments:	By:	Date:
-	-	-	-

Do not scale this drawing. All dimensions must be checked on site.
All rights reserved. No reproduction in any material form is permitted
without consent.

LISTED BUILDING CONSENT			
Client: Mr. Simon Dougal			
Project Title: 107 High St, Lindfield, Haywards Heath, West Sussex, RH16 2HR			
Drawing Title: Fitted Wardrobes Joinery & Re-instated Door			
Scale: 1:25@A1 1:50@A3	Date: Apr 25	Drawn: KN	Checked: KW

kyson ⁺ Studio		
28 Scrutton Street London UK EC2A 4RP		
T: +44(0) 20 7247 2462 E: enquiries@kyson.co.uk W: www.kyson.co.uk		
Project No.: 900-25	Drawing No.: 5013	Revision: -

