





Approved Scheme
Ground Floor Plan
Scale 1:25:A1
1:50@A3



'As Built' and Proposed
Ground Floor Plan
Scale 1:25:A1
1:50@A3

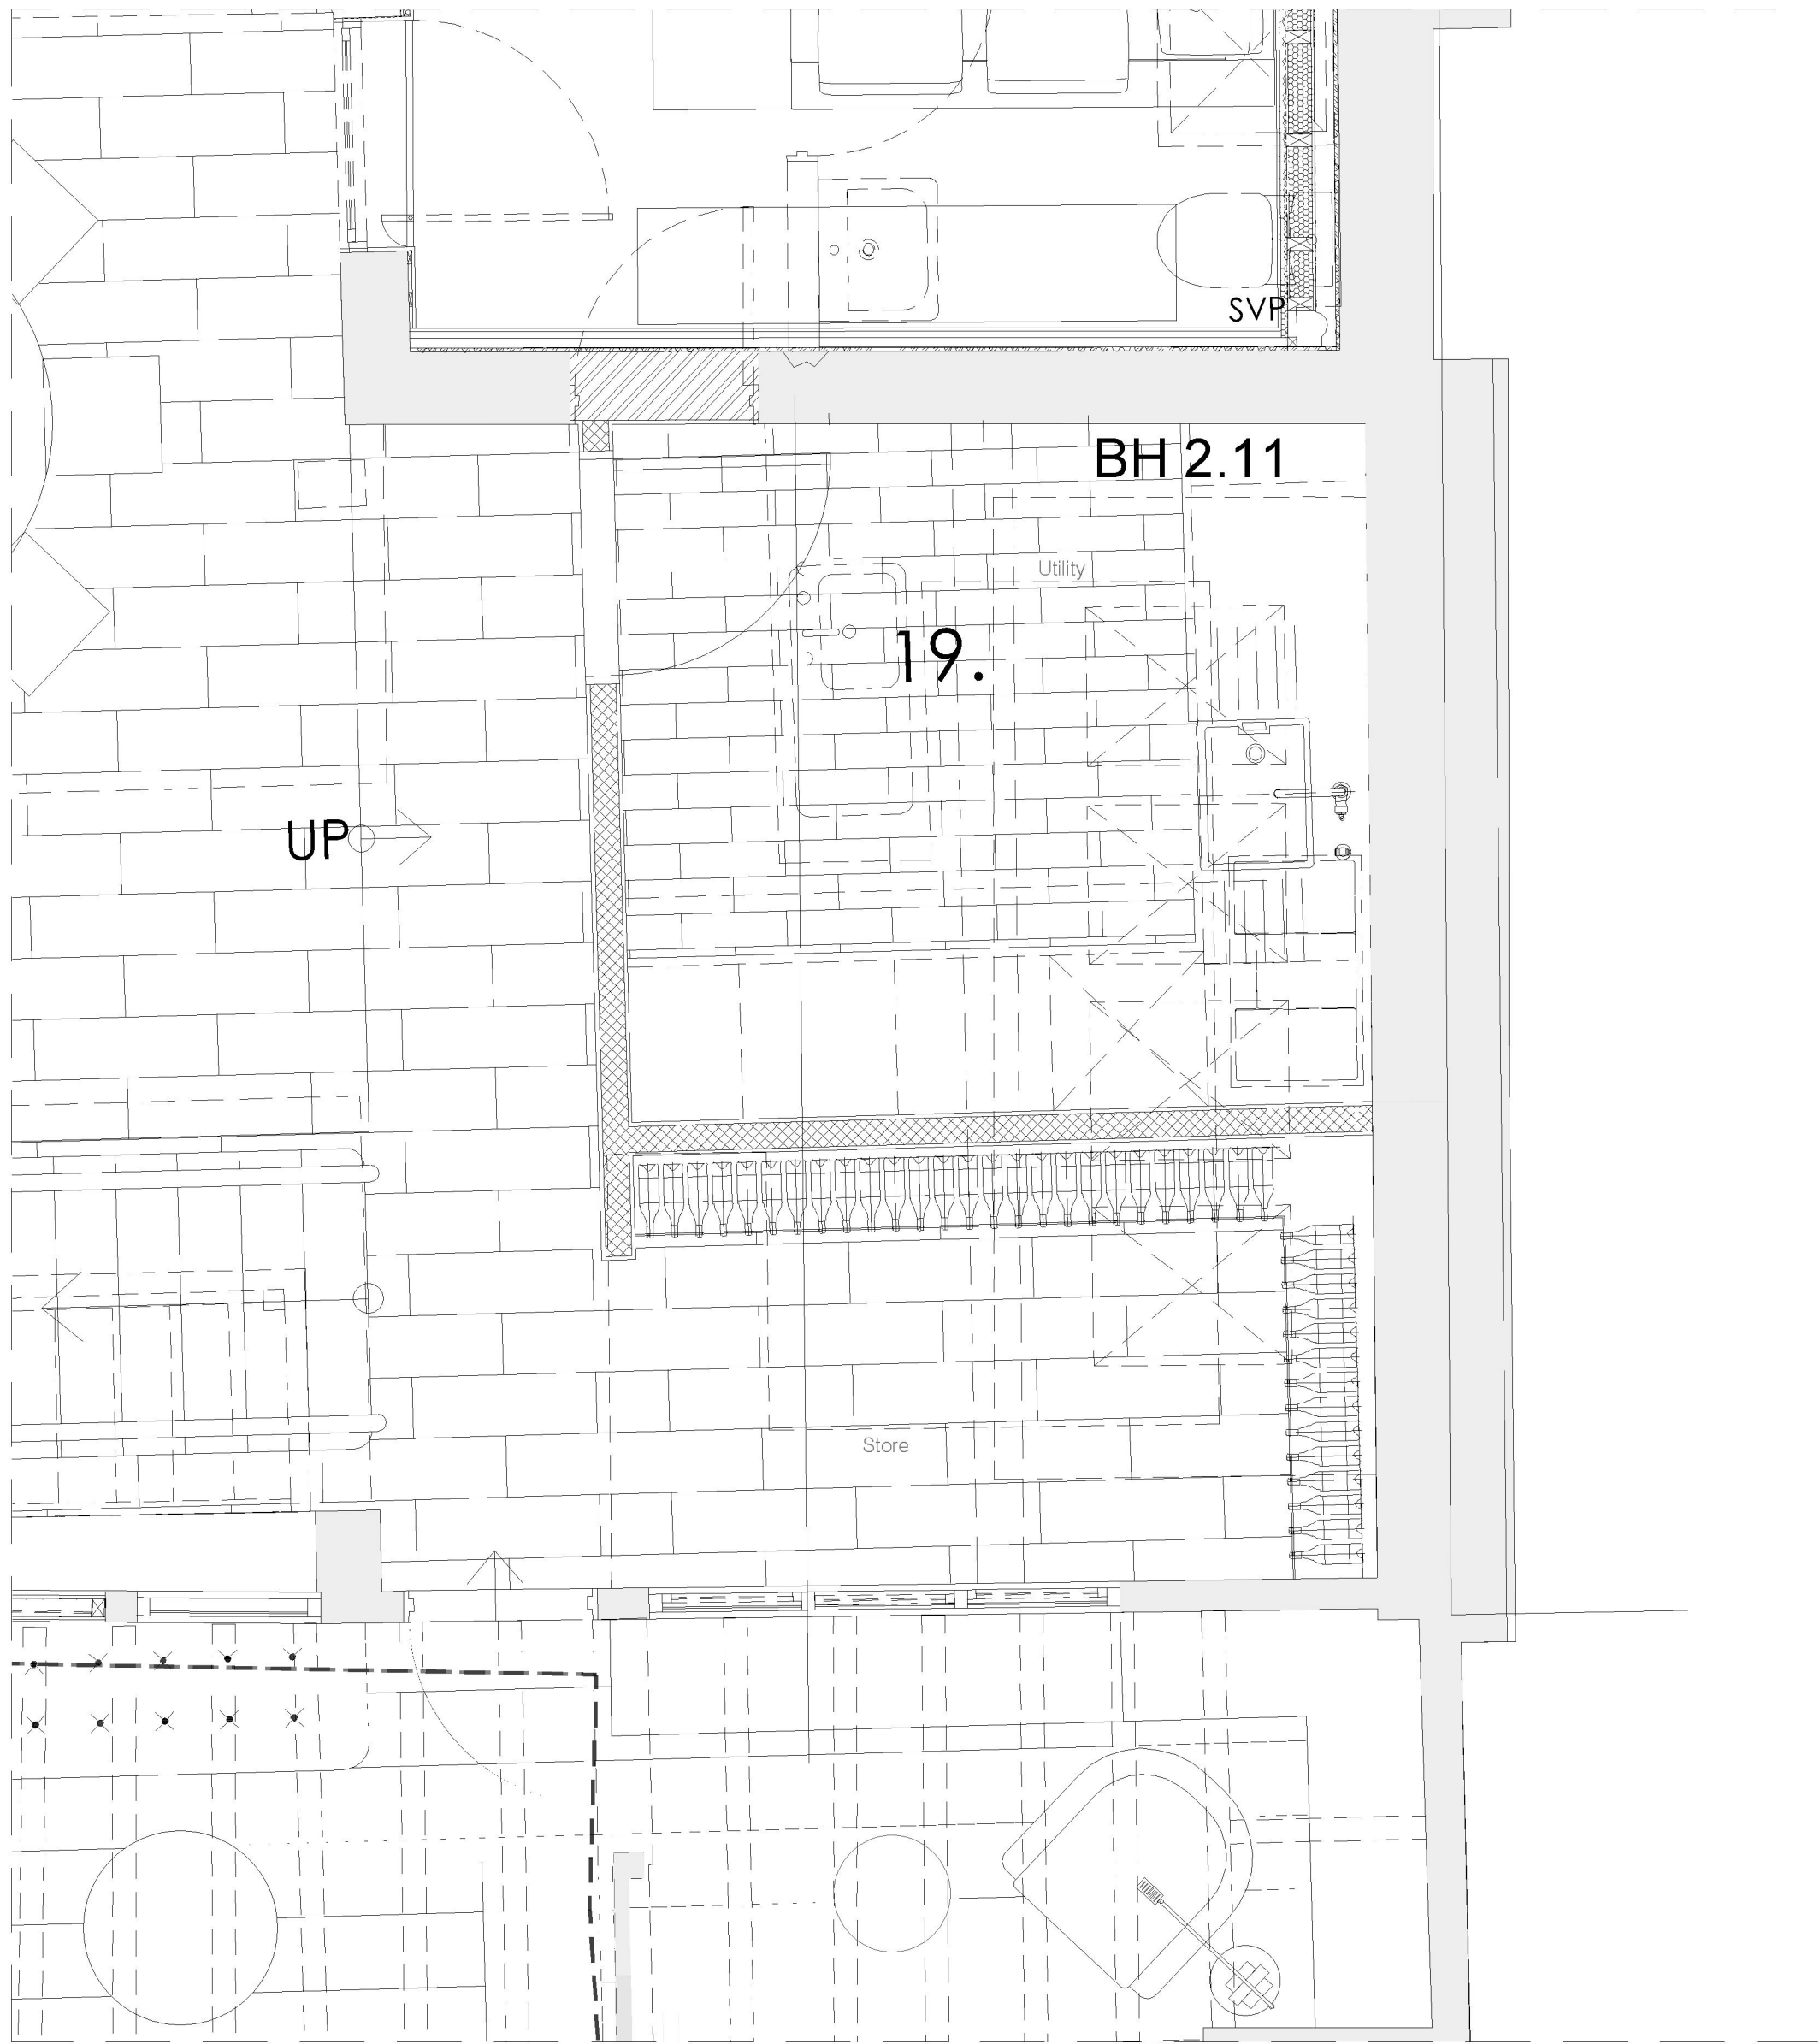

Sliding door to wine cellar/ storage

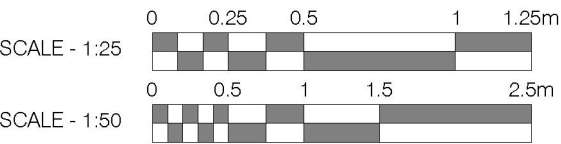

KEY:
Highlighted difference between Approved Scheme and 'As-Built'/Proposed Scheme

Rev.	Comments	By:	Date:
-	-	-	-

Do not scale this drawing. All dimensions must be checked on site.
All rights reserved. No reproduction in any material form is permitted without consent.

**LISTED BUILDING
CONSENT**

Client:
Mr. Simon Dougal

Project Title:
107 High St, Lindfield, Haywards Heath, West Sussex, RH16 2HR

Drawing Title:
Detail Drawings:
Ground floor utility room

Scale:
1:25@A1
1:50@A3

Date:
Apr 25

Drawn:
KN

Checked:
KW

kyson

Studio

28 Scrutton Street
London
UK
EC2A 4RP

T: +44(0) 20 7247 2462
E: enquiries@kyson.co.uk
W: www.kyson.co.uk

Project No.:	Drawing No.:	Revision:
900-25	5015	-