



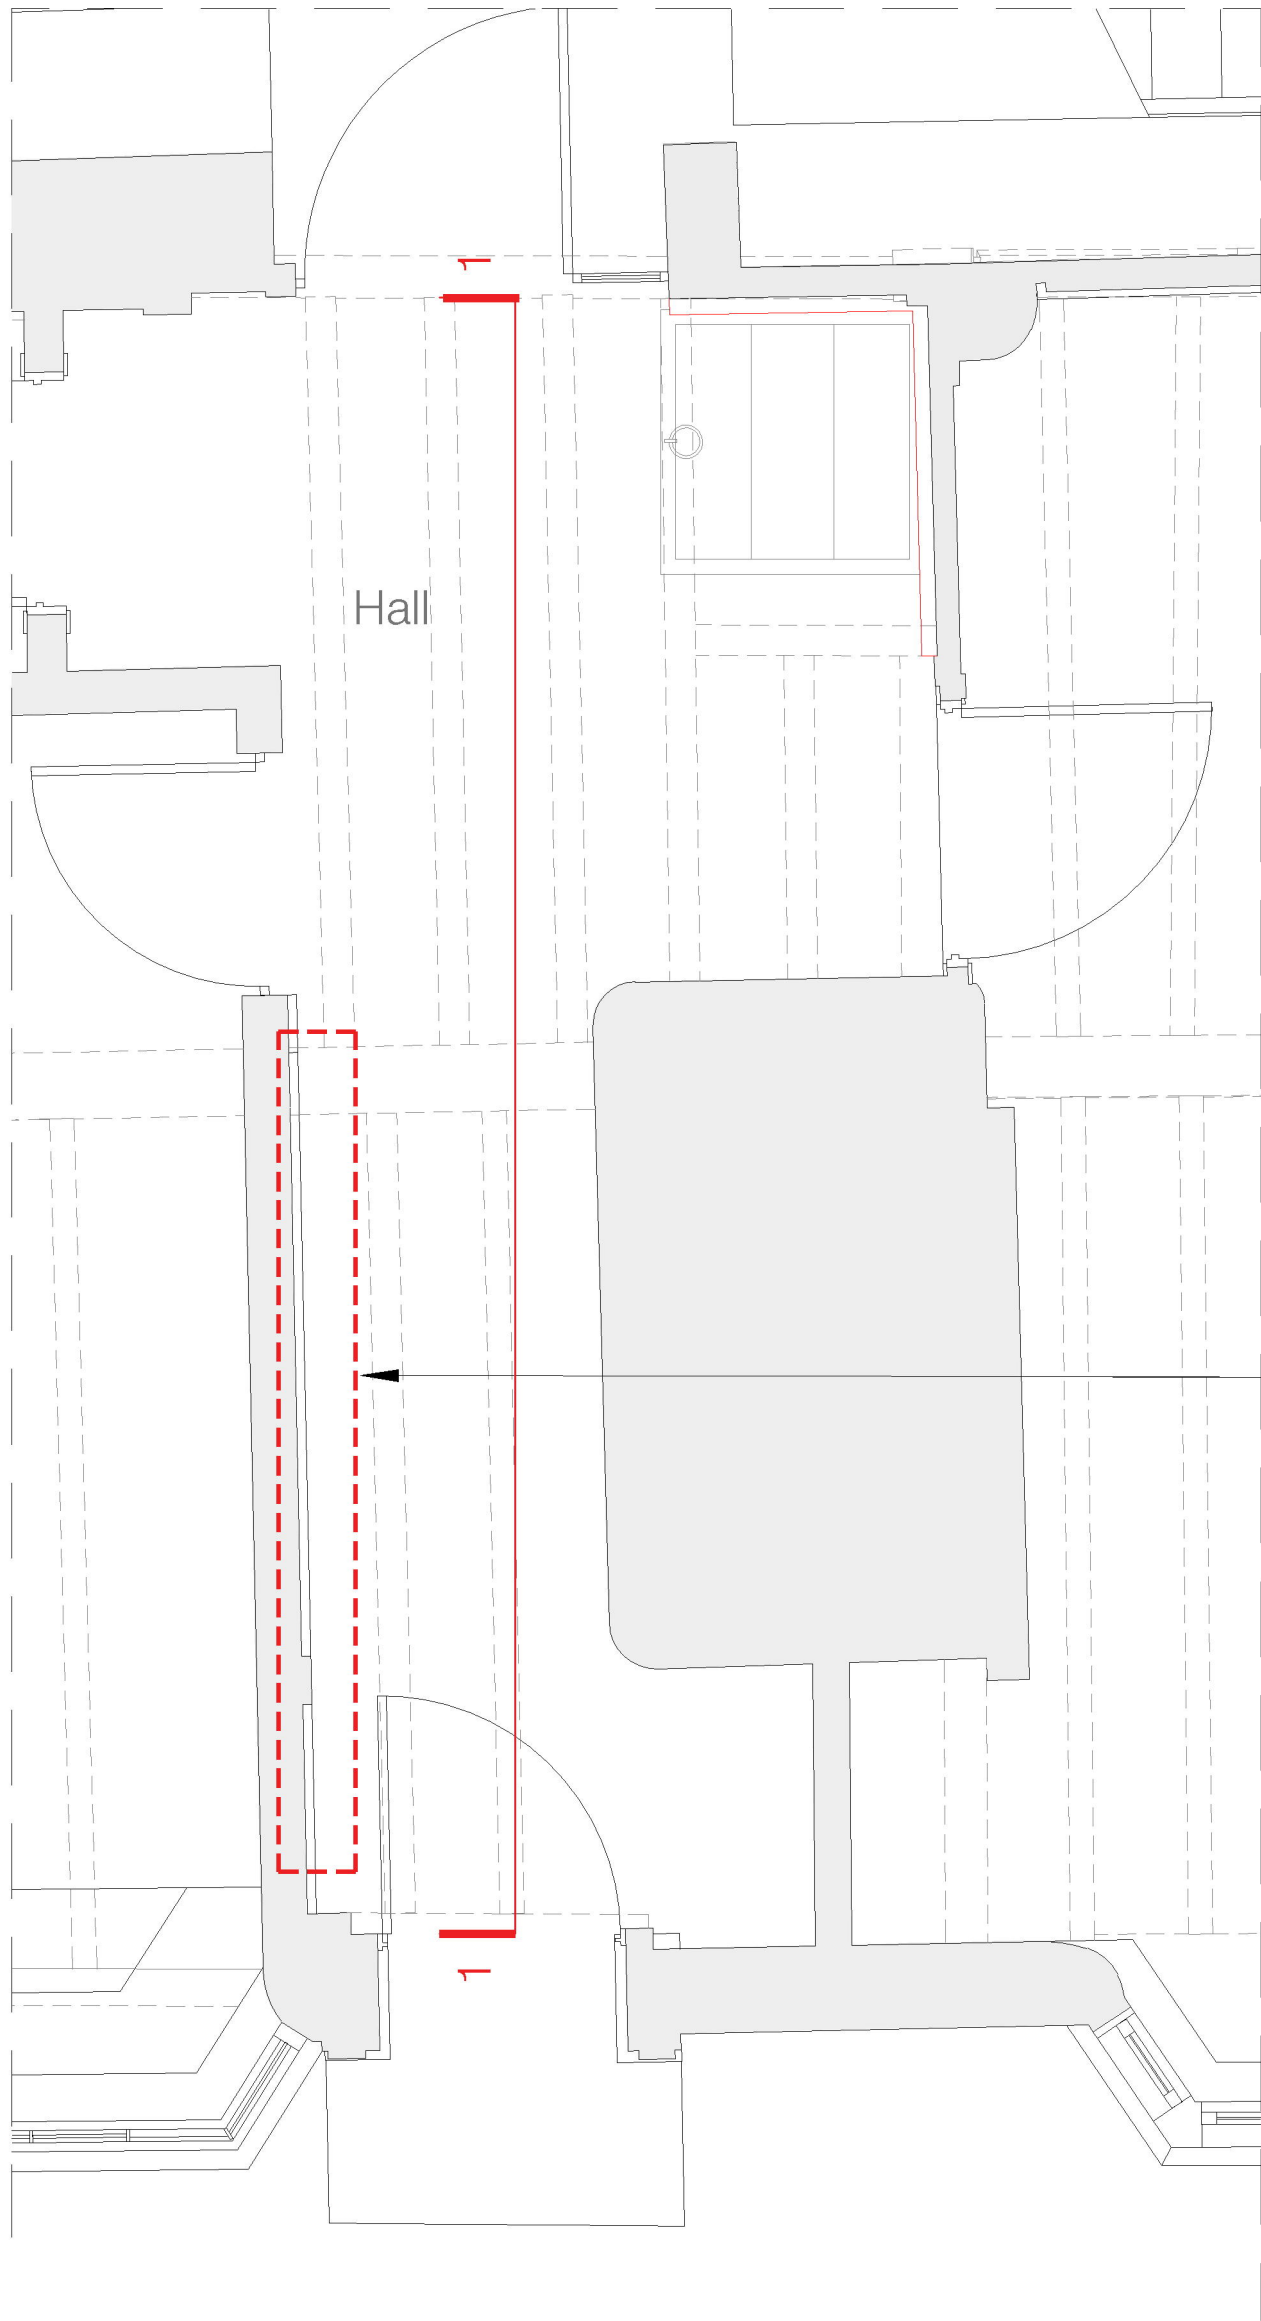


Existing oak timber framing
exposed and restored to
enhance the character of this
area of the original
property

KEY
Ground Floor Plan
Scale 1:25:A1
1:50@A3

 


The entrance passage with exposed timber framing

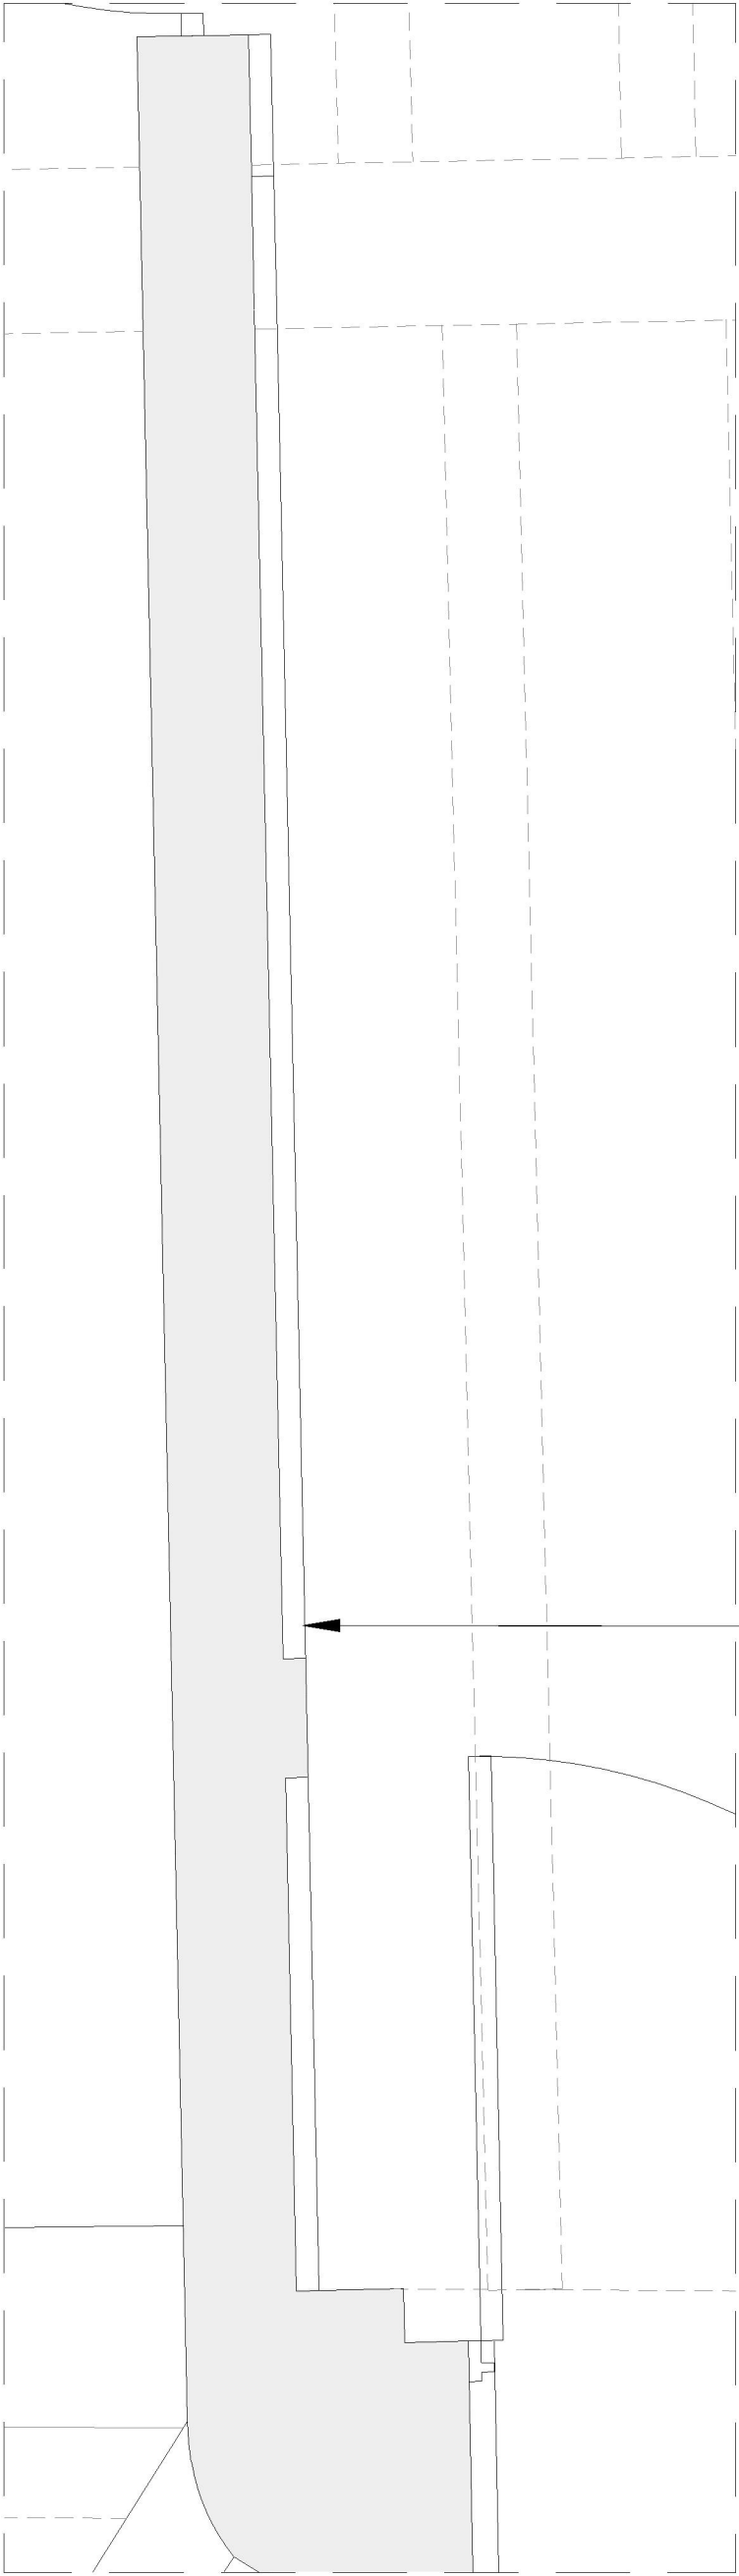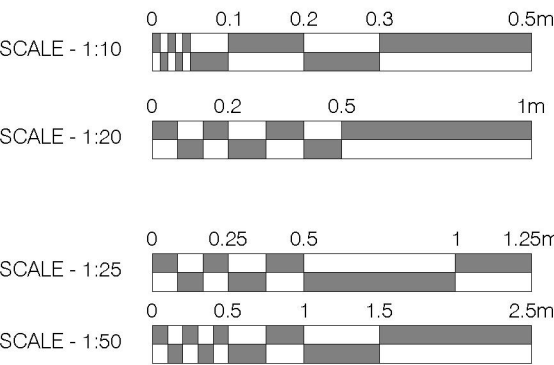


Existing oak timber
framing exposed and
restored by specialist

Plan
Scale 1:10:A1
1:20@A3



Section
Scale 1:10:A1
1:20@A3

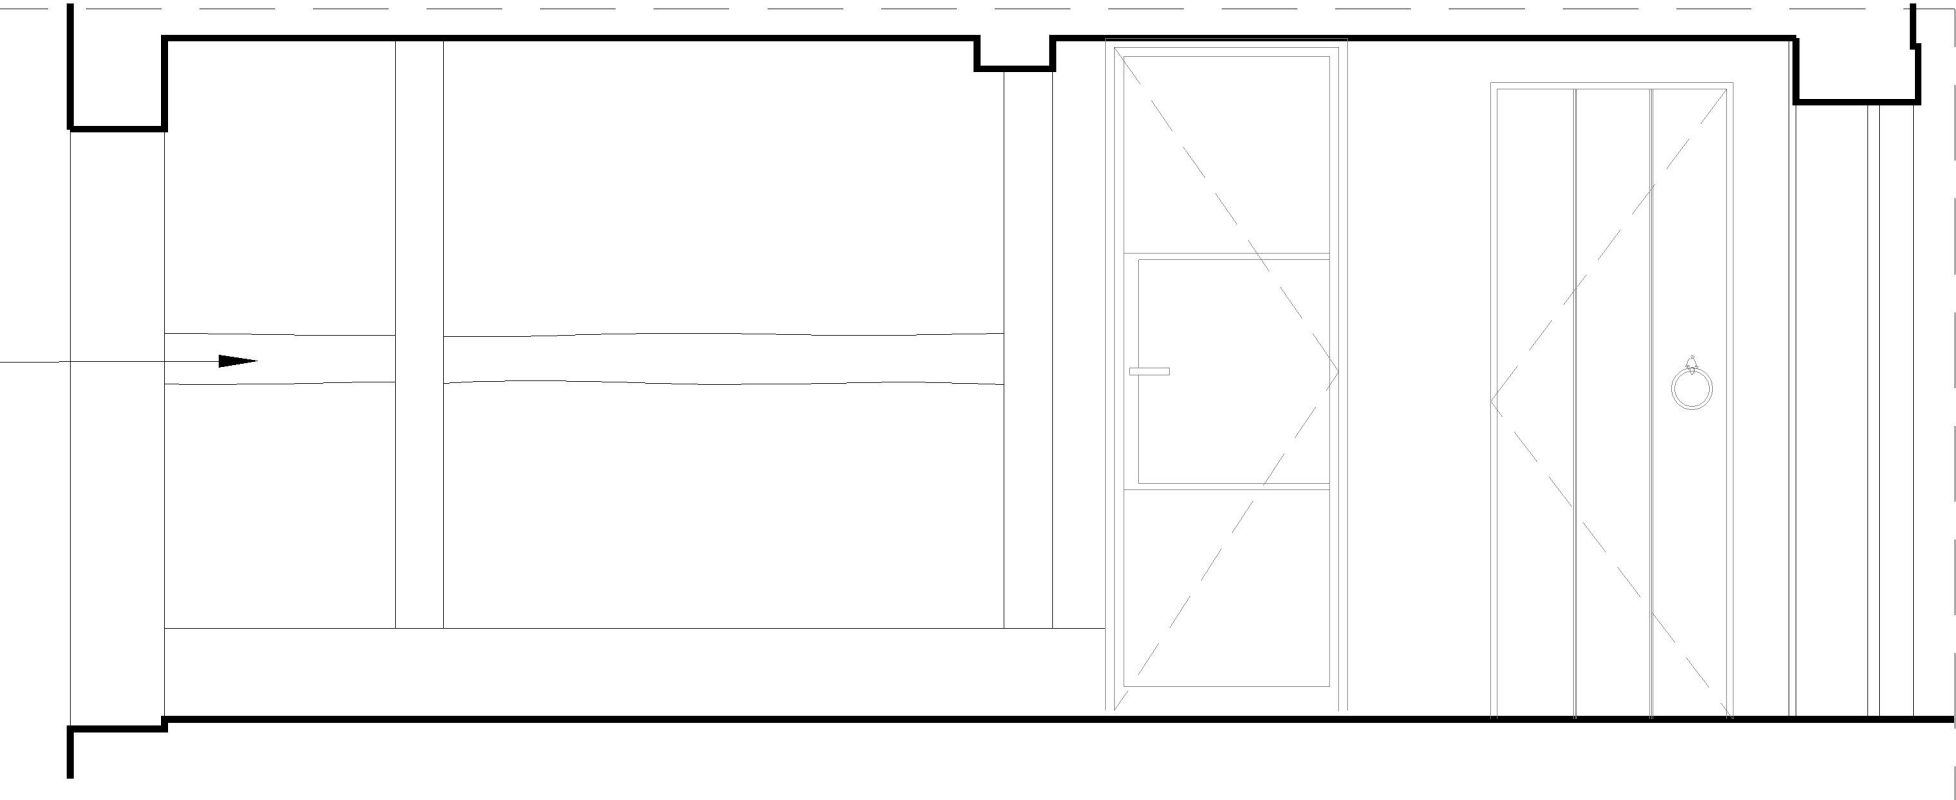

Internal Elevation 1
Scale 1:25:A1
1:50@A3

Existing oak timber framing
exposed and restored

KEY:
Highlighted difference between Approved Scheme and 'As-Built'/Proposed Scheme

Rev: Comments: By: Date:

Do not scale this drawing. All dimensions must be checked on site.
All rights reserved. No reproduction in any material form is permitted
without consent.

LISTED BUILDING
CONSENT

Client:
Mr. Simon Dougall
Project Title:
107 High St, Lindfield, Haywards Heath, West Sussex, RH16 2HR
Drawing Title:
Detail Drawings:
Entrance Passage Timber Framing

Scale: 1:25@A1 1:10@A1 1:20@A3
Date: Apr 25
Drawn: KN
Checked: KW



kyson
Studio
28 Scrutton Street
London
UK
EC2A 4RP
T: +44(0) 20 7247 2462
E: enquiries@kyson.co.uk
W: www.kyson.co.uk

Project No.: 900-25
Drawing No.: 5016
Revision: -