




Approved West Elevation
Scale 1:25@A1
1:50@A3

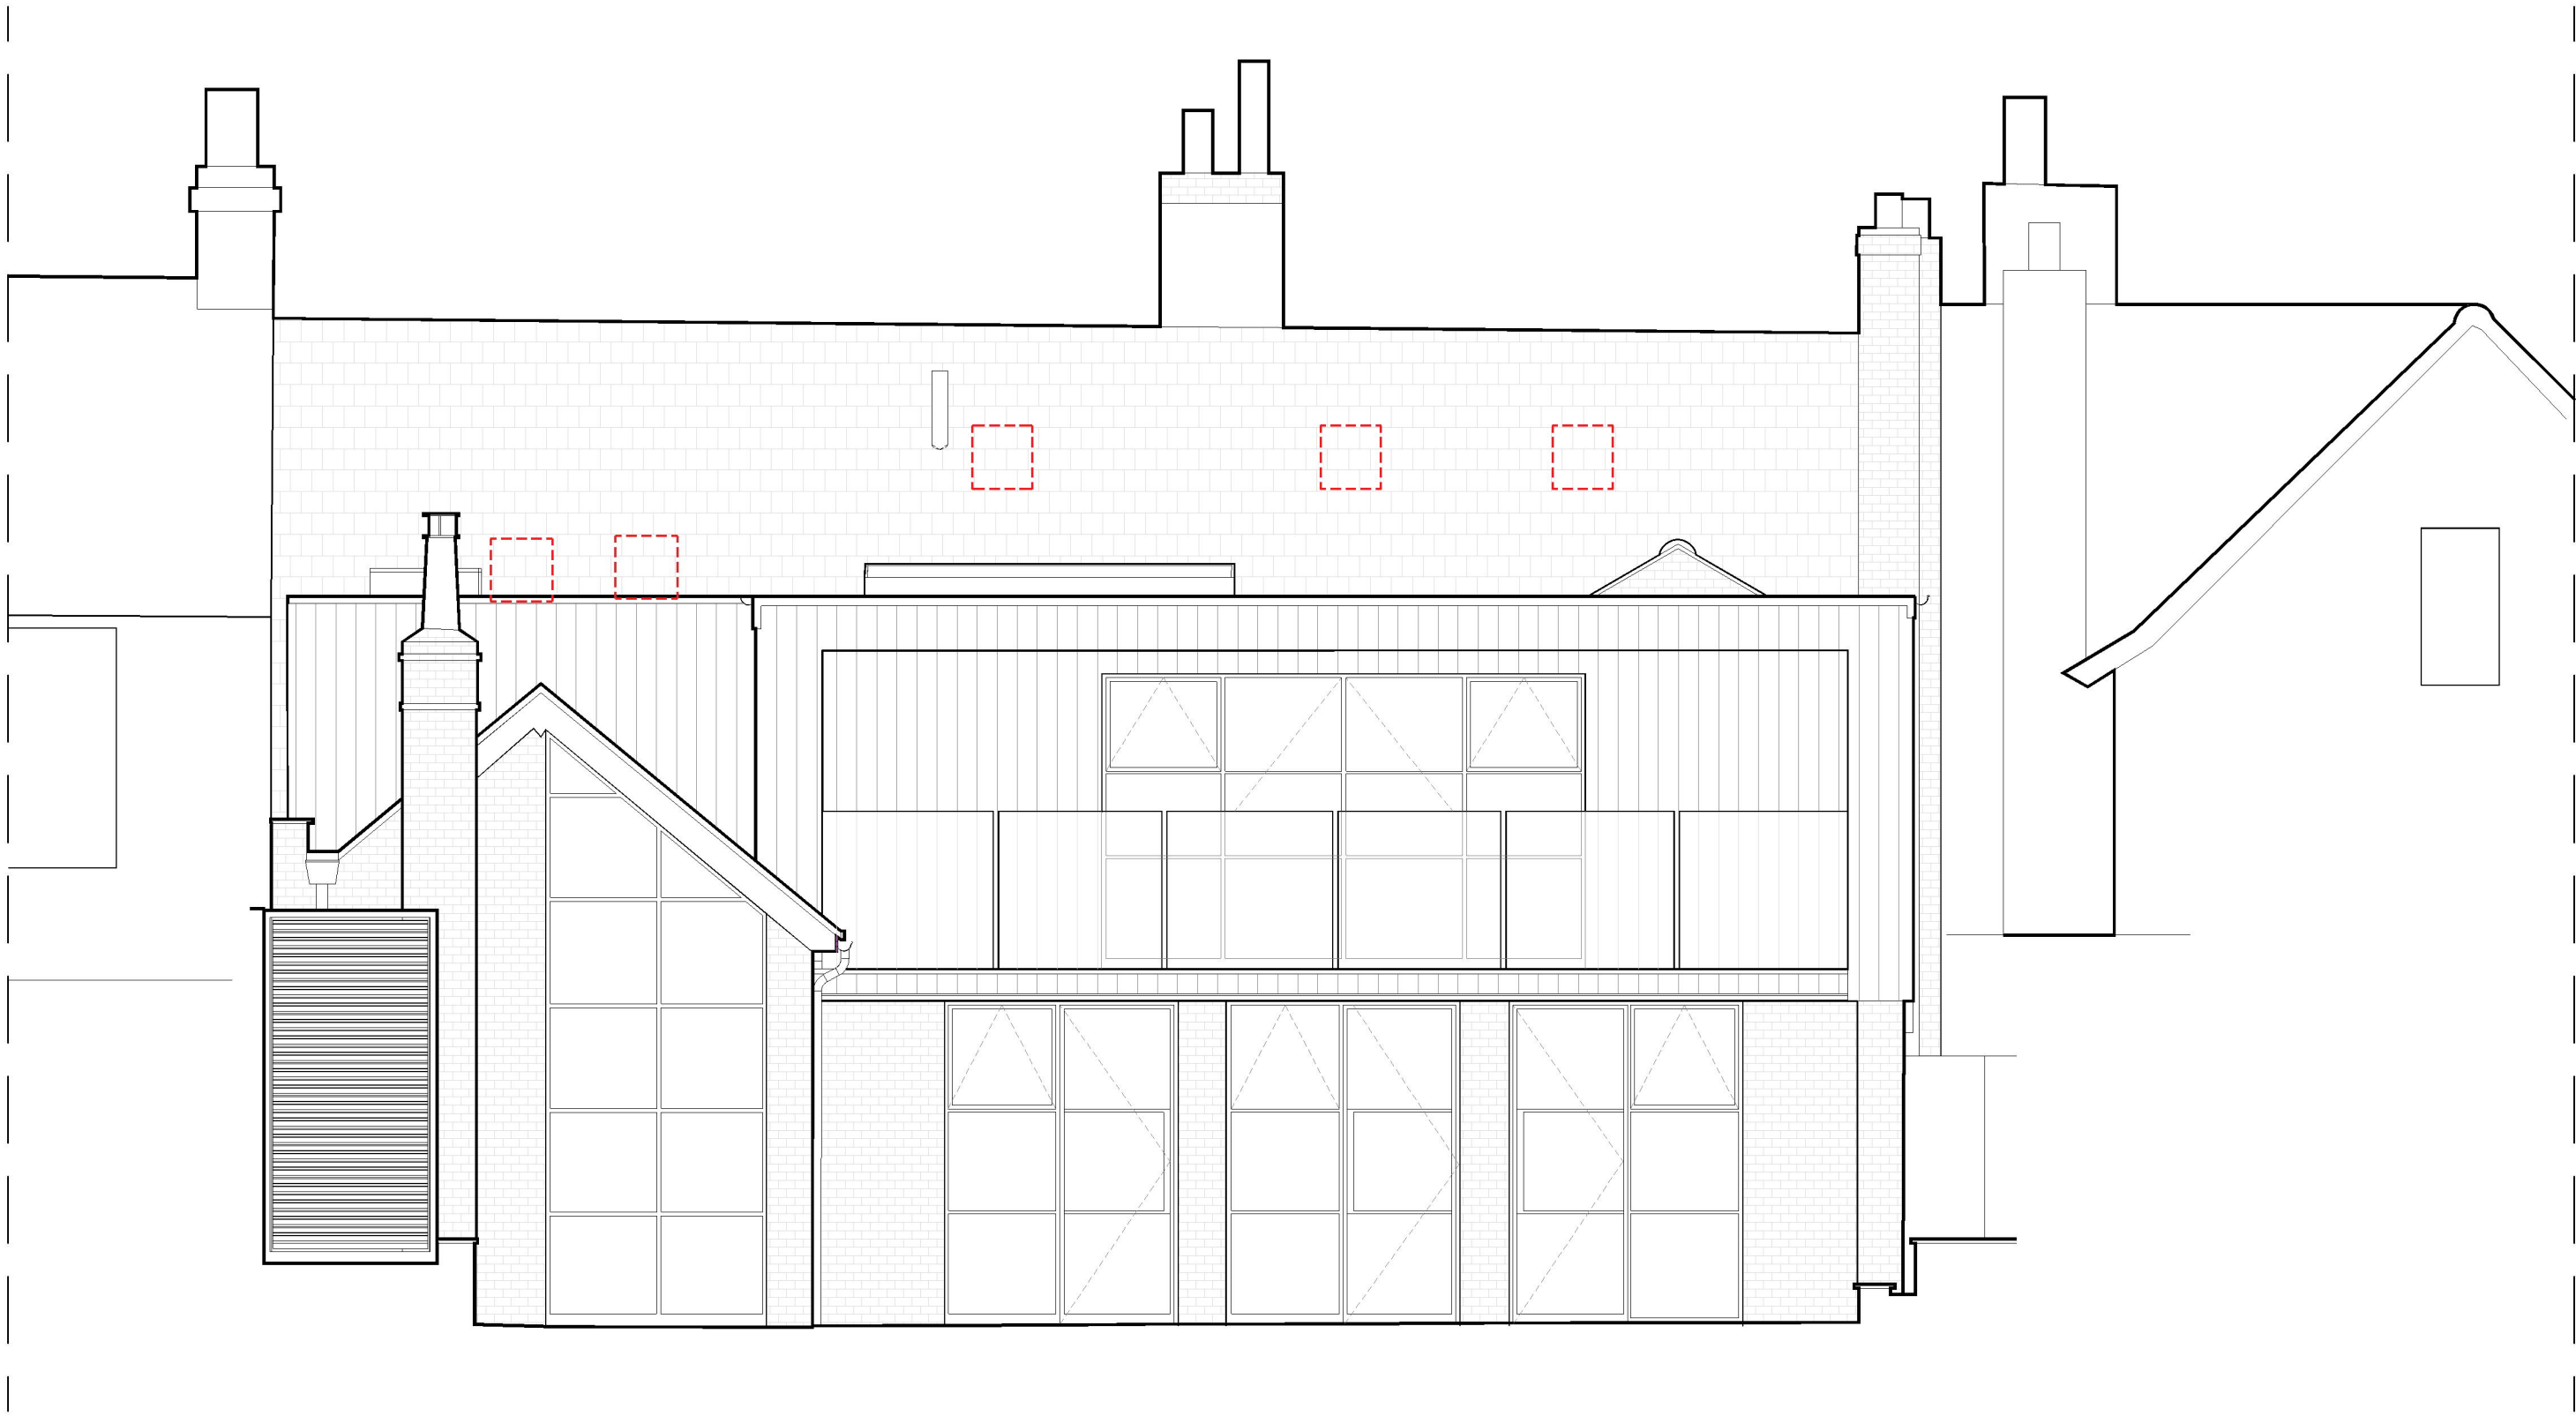

Proposed West Elevation
Scale 1:25@A1
1:50@A3

KEY:
Highlighted difference between Approved Scheme and 'As-Built'/Proposed Scheme

Rev: Comments: By: Date: - - - -				Client: Mr. Simon Dougal		Project Title: 107 High St, Lindfield, Haywards Heath, West Sussex, RH16 2HR		Drawing Title: Detail Drawings: Removal of Rooflights		Scale: 1:25@A1 1:50@A3		Date: Apr 25		Drawn: KN		Checked: KW		Project No.: 900-25		Drawing No.: 5019		Revision: -	
Do not scale this drawing. All dimensions must be checked on site. All rights reserved. No reproduction in any material form is permitted without consent.				LISTED BUILDING CONSENT		kyson[®]		Studio 28 Scrutton Street London UK EC2A 4RP		T: +44(0) 20 7247 2462 E: enquiries@kyson.co.uk W: www.kyson.co.uk													

