




Approved Scheme
First Floor Plan
Scale 1:25:A1
1:50@A3





Approved Scheme
Ground Floor Plan
Scale 1:25:A1
1:50@A3

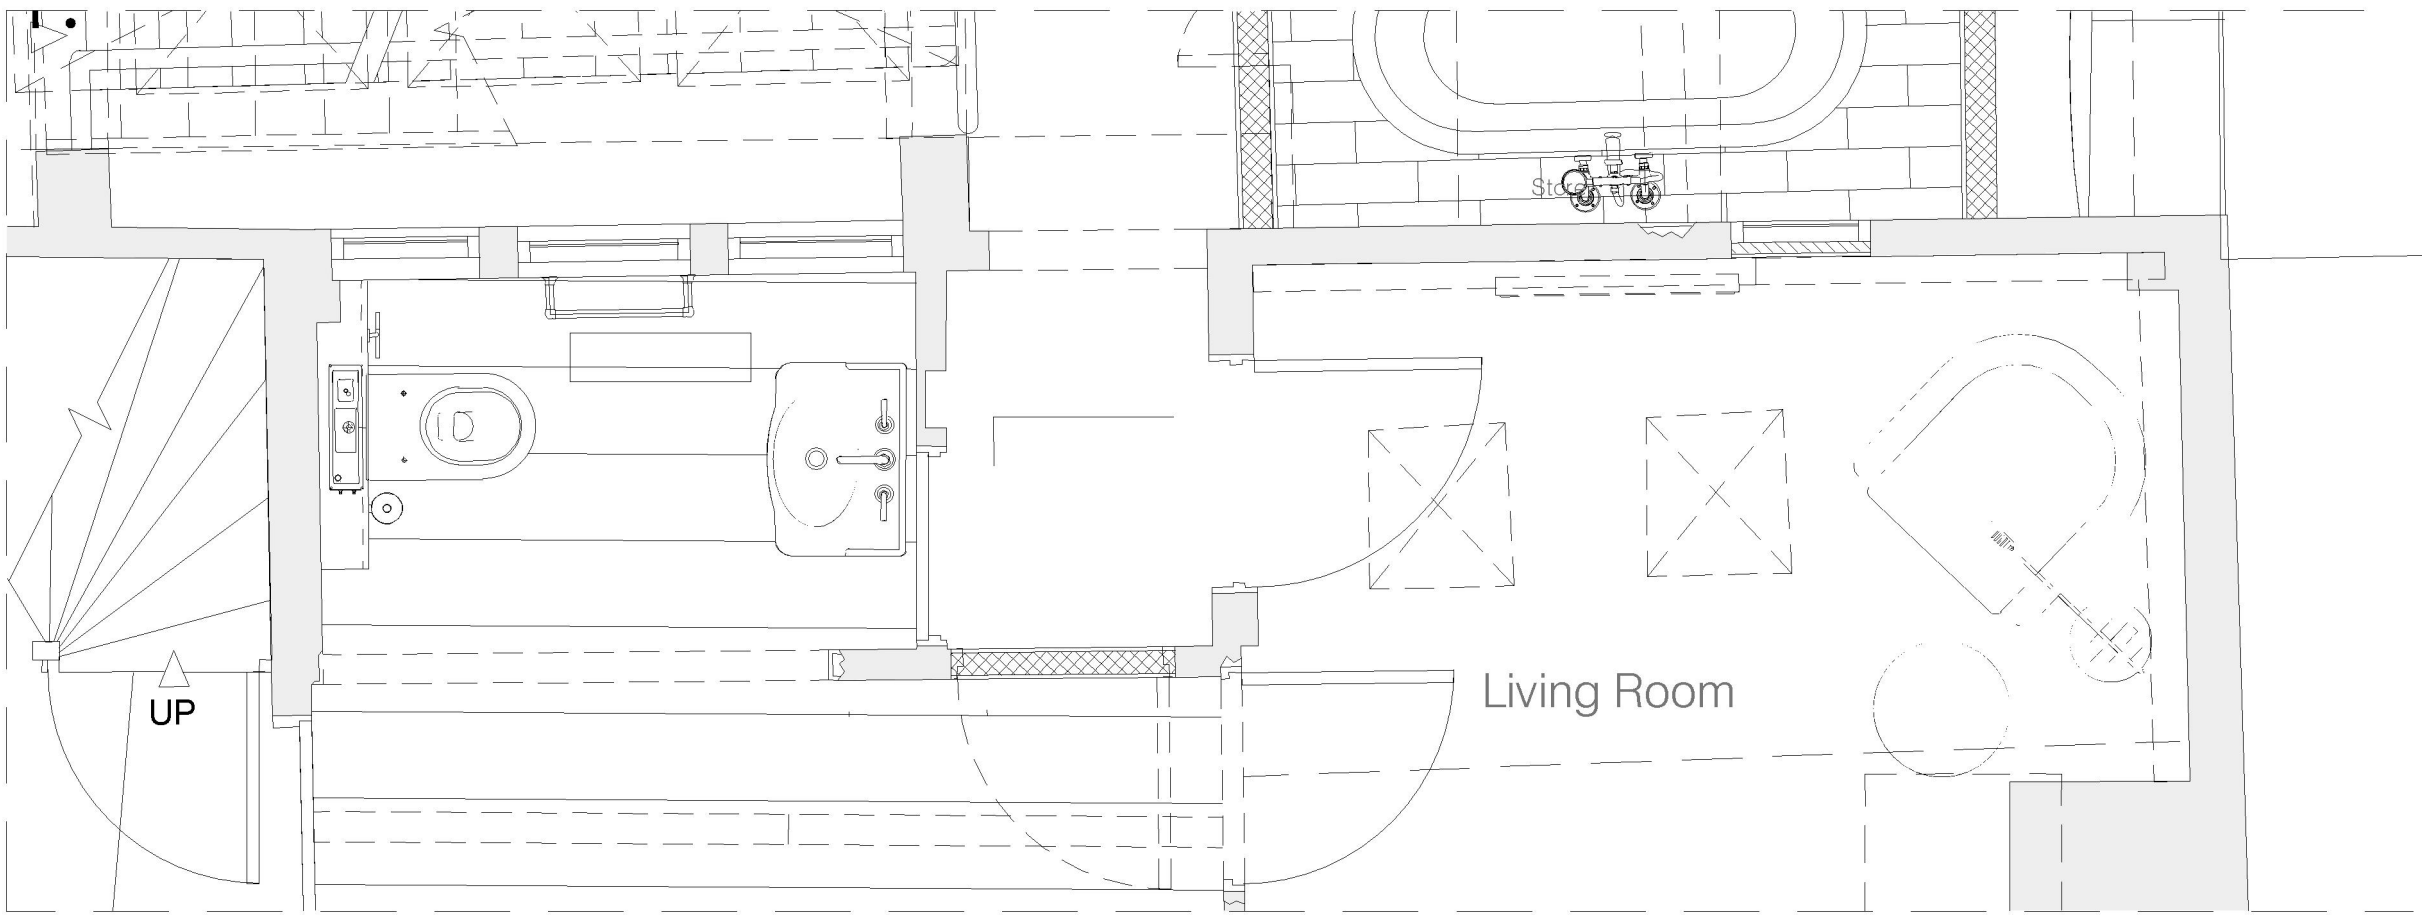

KEY Ground Floor Plan

KEY First Floor Plan

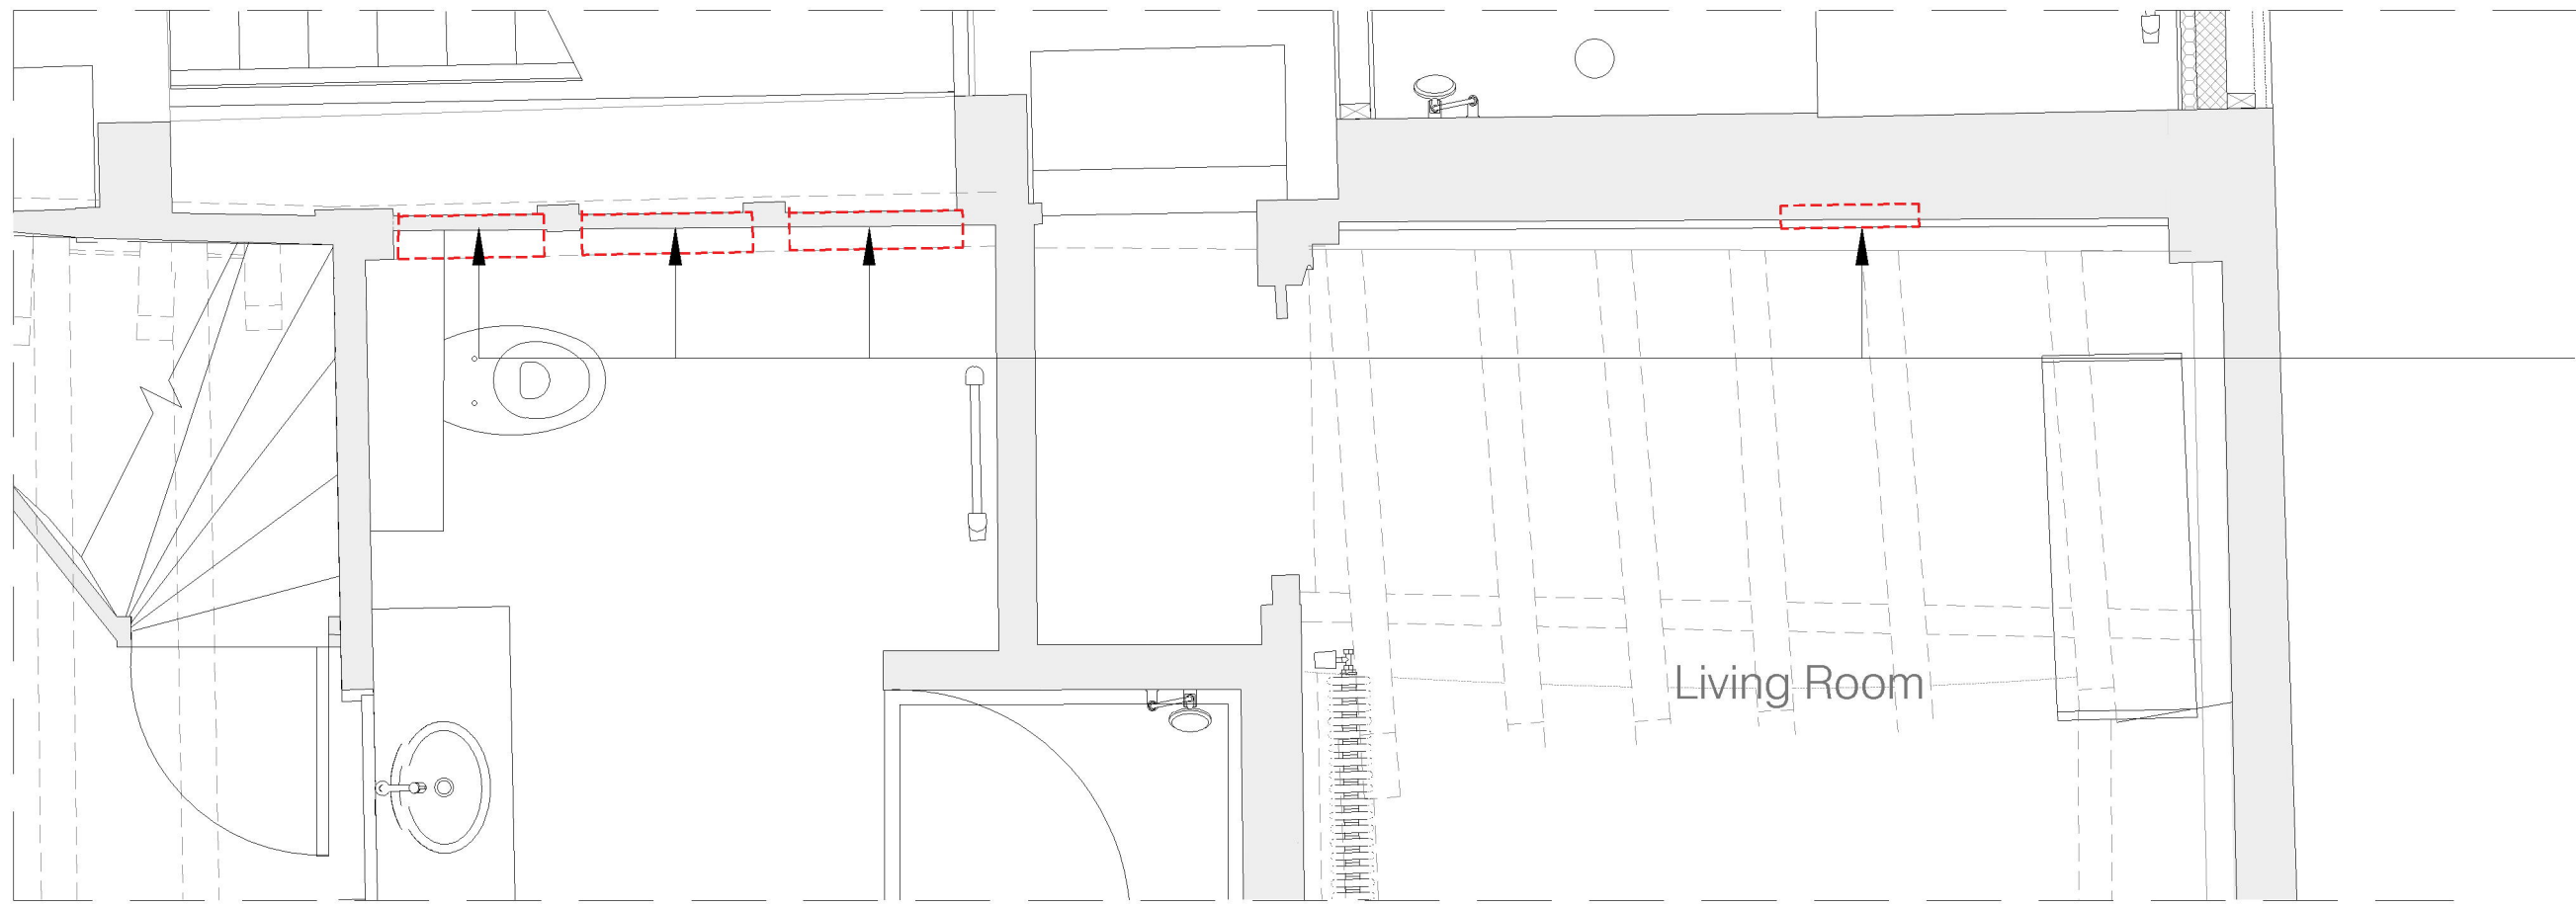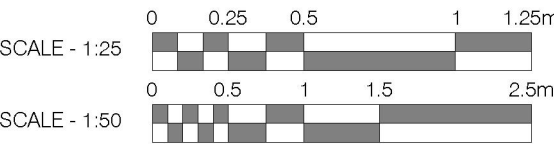

'As Built/ Proposed
First Floor Plan
Scale 1:25:A1
1:50@A3



'As Built/ Proposed
Ground Floor Plan
Scale 1:25:A1
1:50@A3

Existing, not original, casement windows to box framing of 15th century west wall removed. Openings filled in with timber stud framing, wood wool boards and lime plaster.

Existing, not original, casement windows to box framing of 15th century west wall removed. Openings filled in with timber stud framing, wood wool boards and lime plaster.



Before: uPVC casement windows before removal



After: Infilled west wall, view from new extension living room

KEY:

 Highlighted difference between Approved Scheme and 'As-Built'/Proposed Scheme

LISTED BUILDING CONSENT				kyson		
Rev: Comments: By: Date:				Studio		
-				28 Scrutton Street London UK EC2A 4RP		
Client: Mr. Simon Dougal				T: +44(0) 20 7247 2462 E: enquiries@kyson.co.uk W: www.kyson.co.uk		
Project Title: 107 High St, Lindfield, Haywards Heath, West Sussex, RH16 2HR				Project No.: 900-25		
Drawing Title: Detail Drawings: Removal of Internal Casement Windows				Drawing No.: 5020		
Scale: 1:25@A1 1:50@A3				Revision: -		
Date: Apr 25						
Drawn: KN						
Checked: KW						
Do not scale this drawing. All dimensions must be checked on site. All rights reserved. No reproduction in any material form is permitted without consent.						