



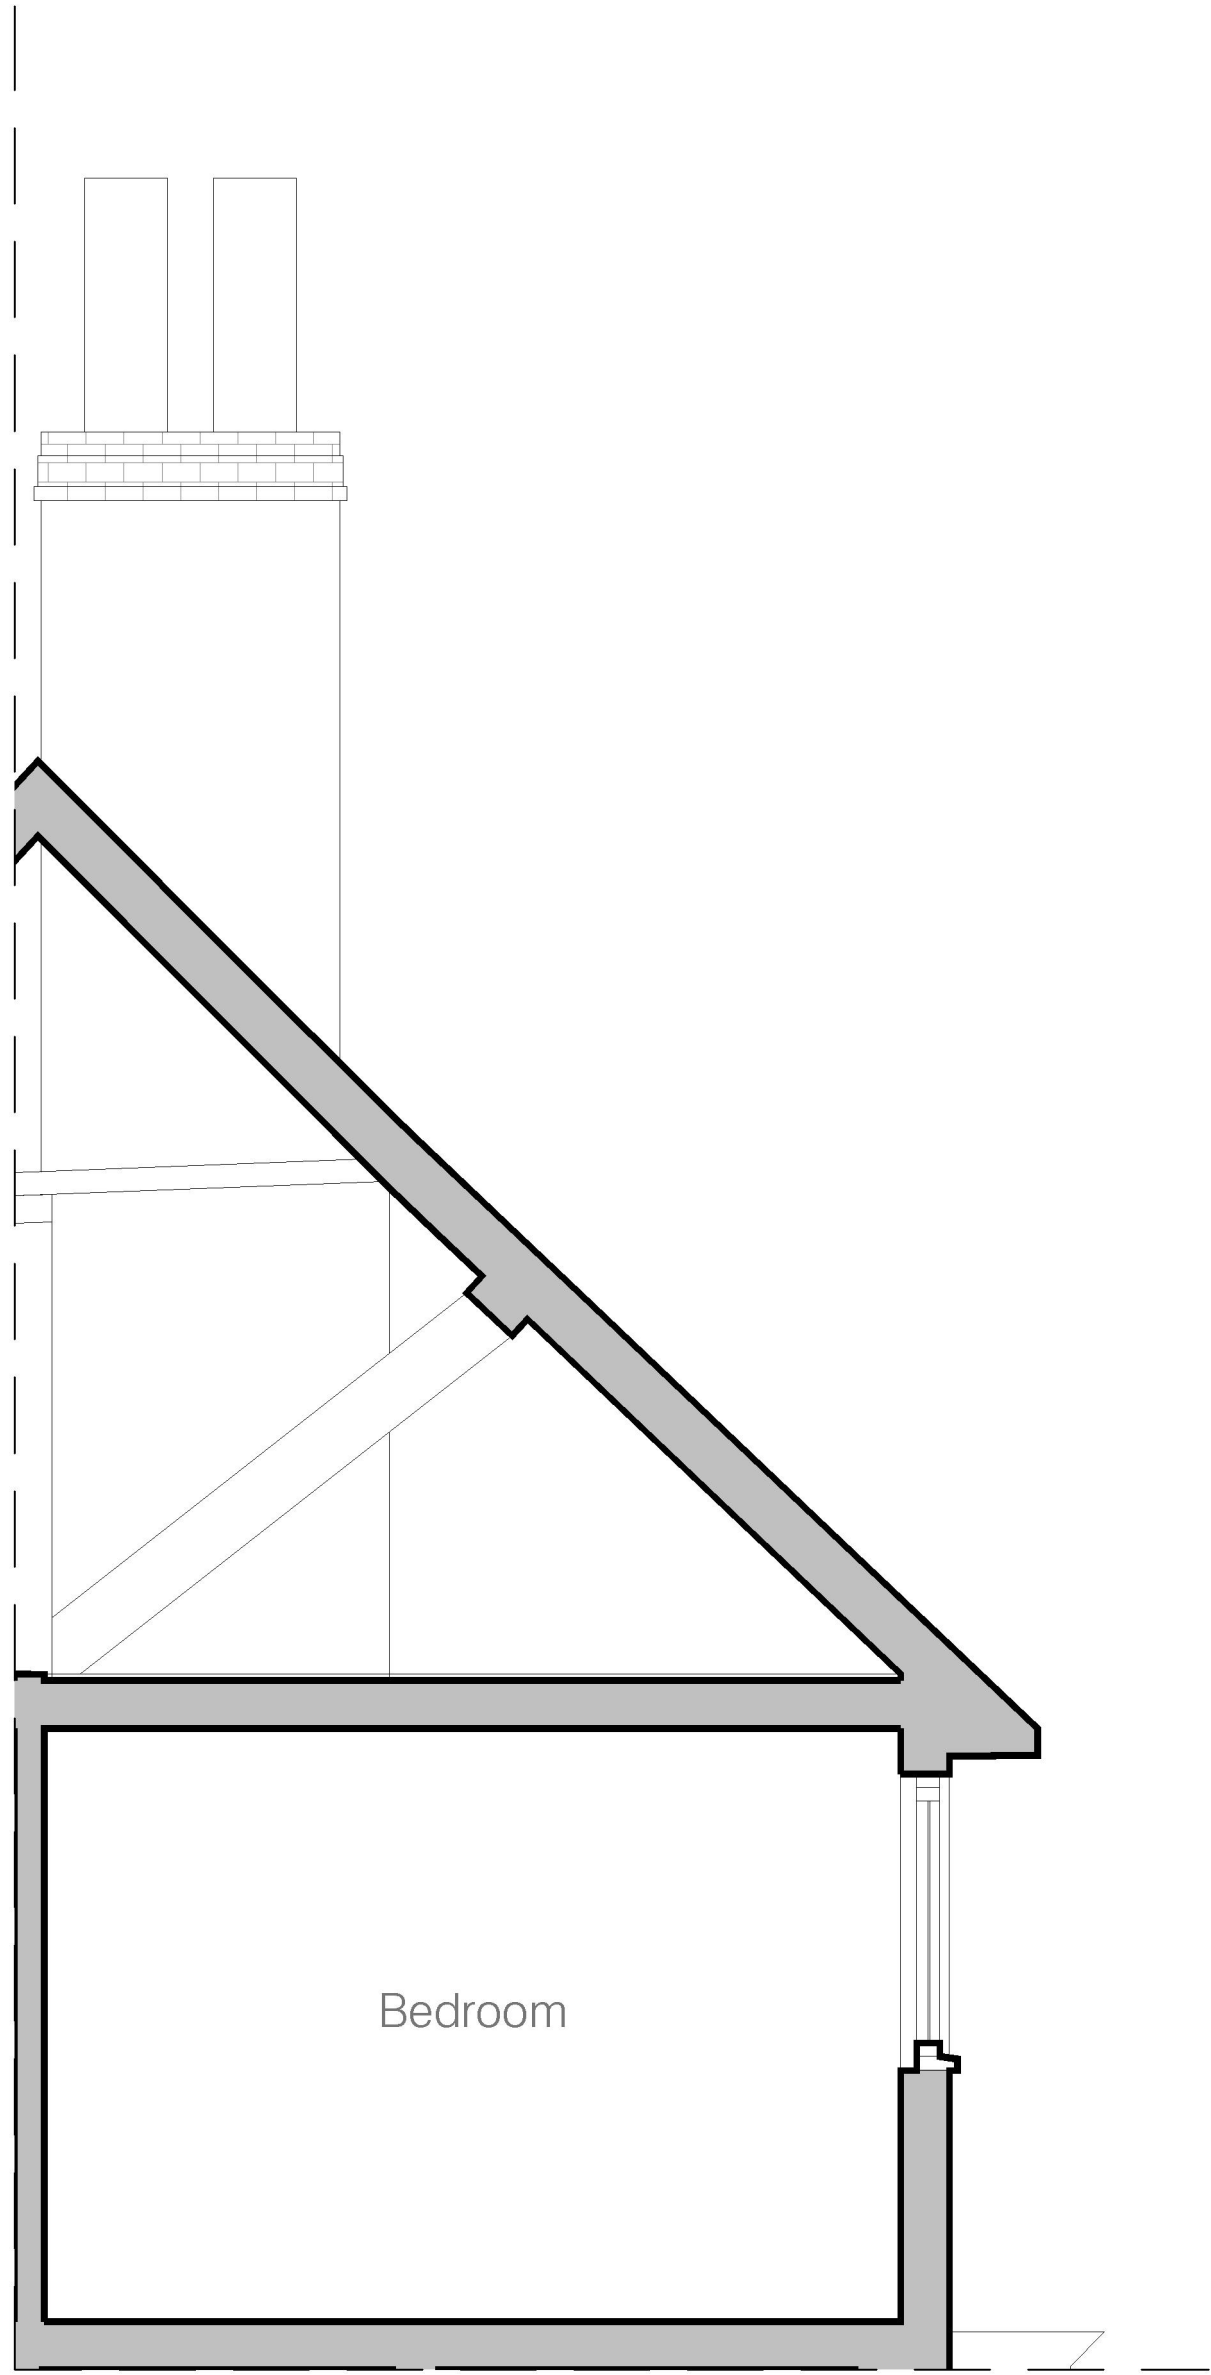


Approved Scheme First Floor SE Bedroom - Section
Scale 1:25@A1
1:50@A3

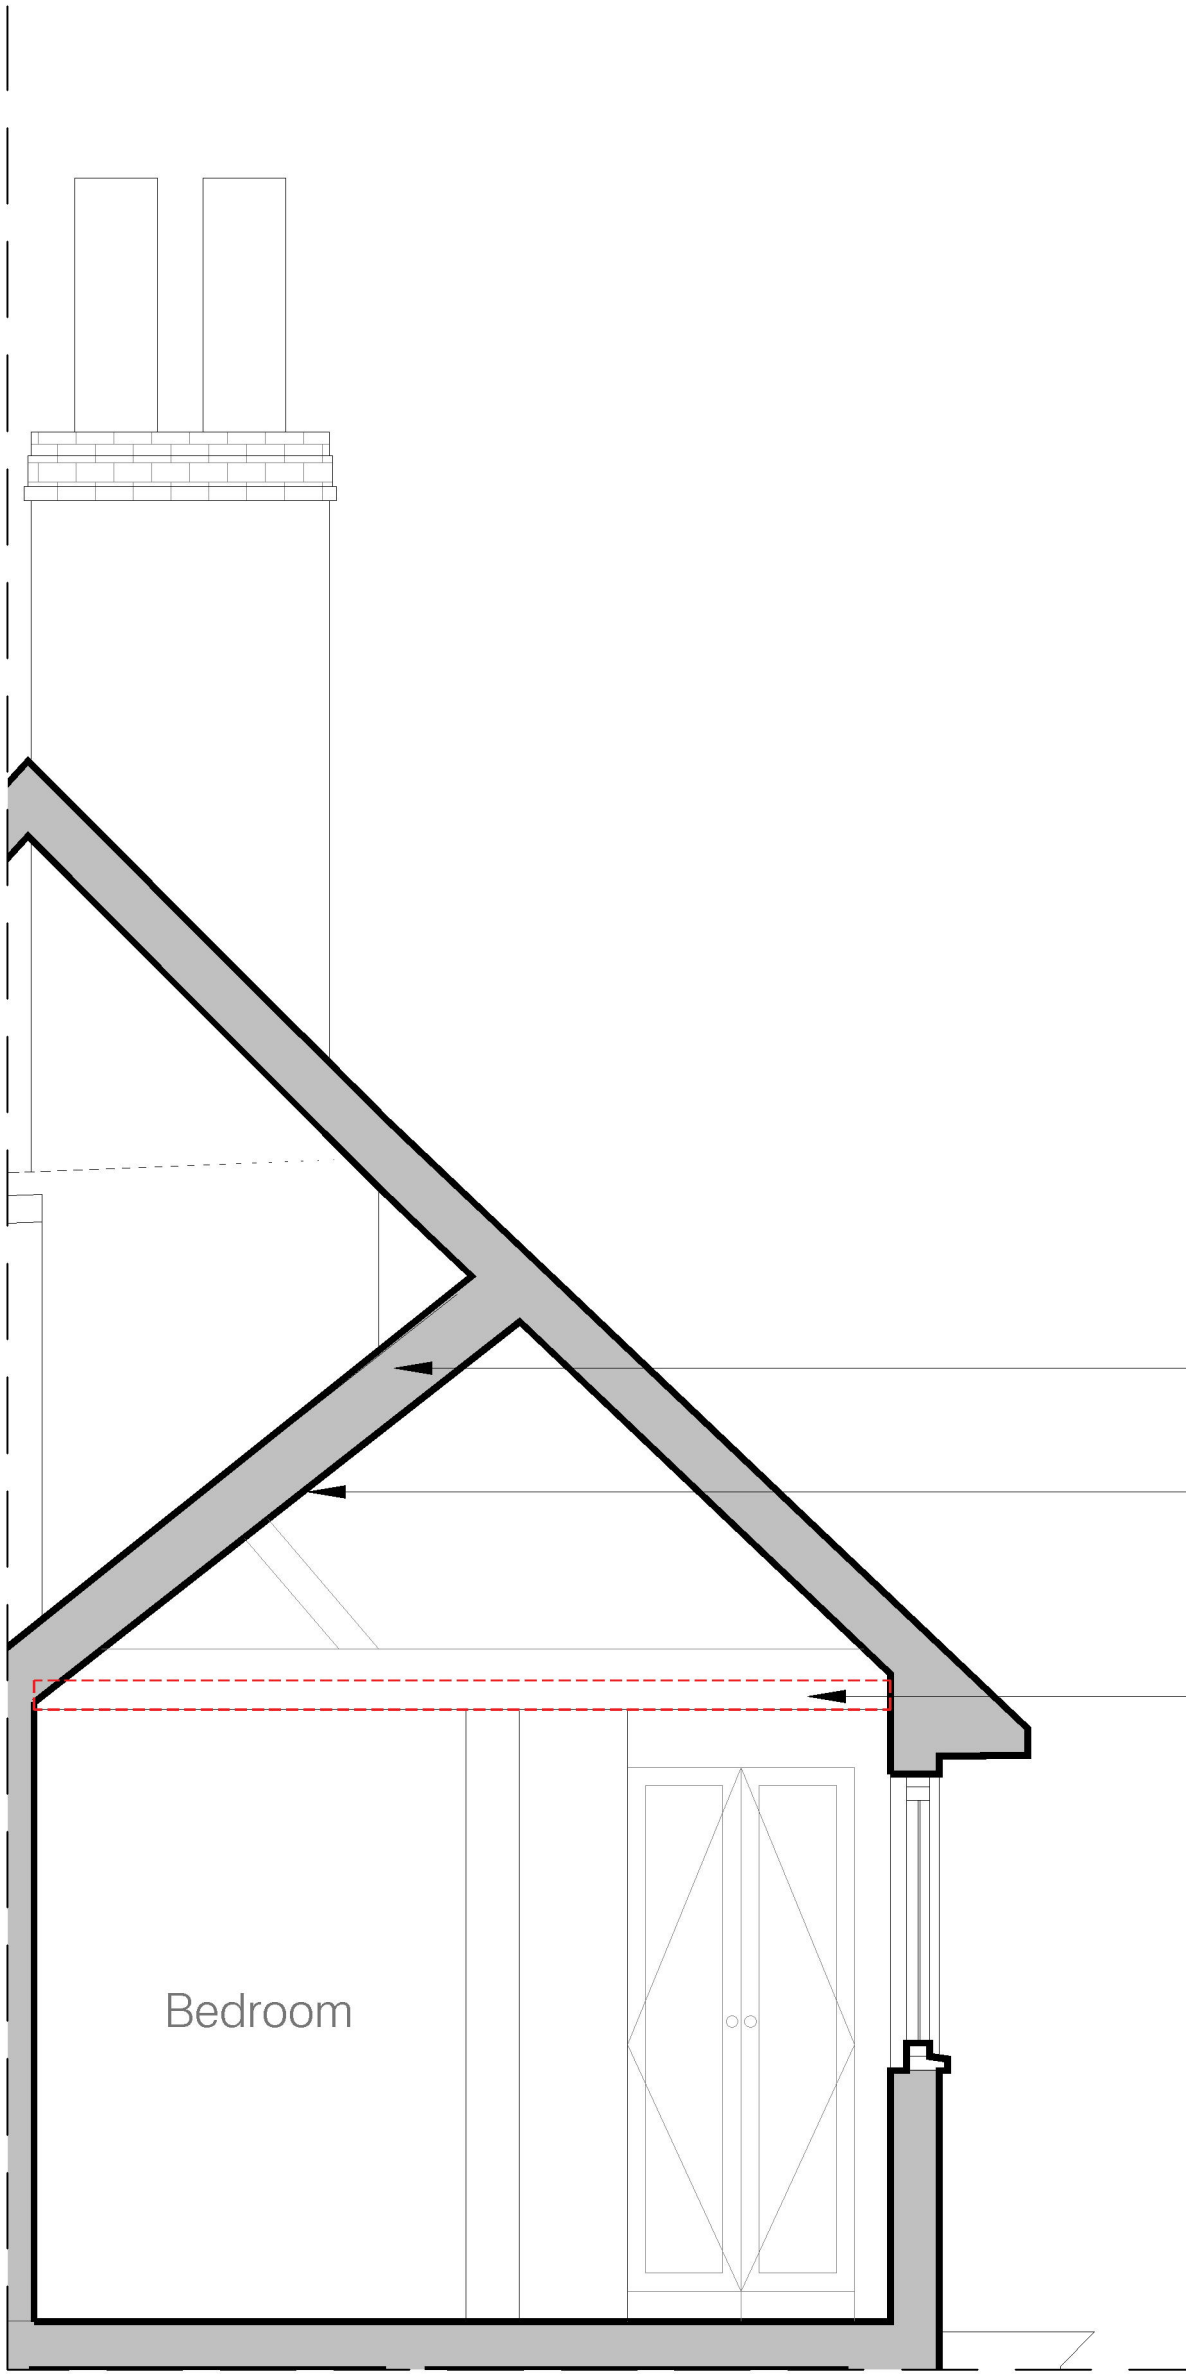

Proposed First Floor SE Bedroom - Section
Scale 1:25@A1
1:50@A3

- Existing timber roof rafter retained and restored by a specialist
- Insertion of vaulted ceiling in reclaimed timber rafters, lath and lime plaster finish
- Existing modern timber ceiling joists and gypsum plasterboard finish removed, timber frame exposed and restored

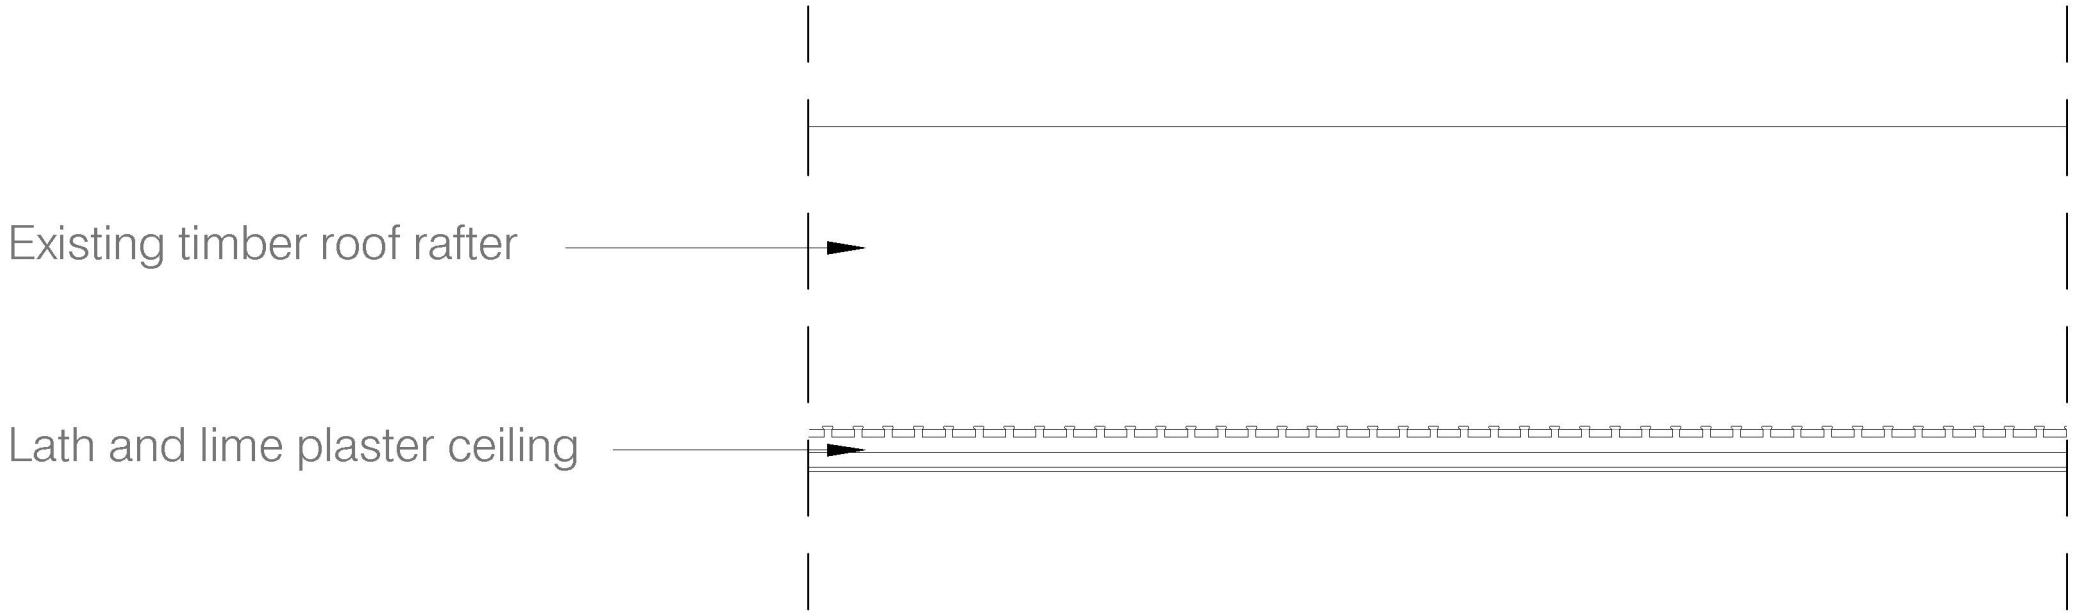


Lath and lime plaster between rafters, section detail
Scale 1:5@A1
1:10@A3



Vaulted ceiling, first floor SE bedroom

KEY:
Highlighted difference between Approved Scheme and 'As-Built'/Proposed Scheme

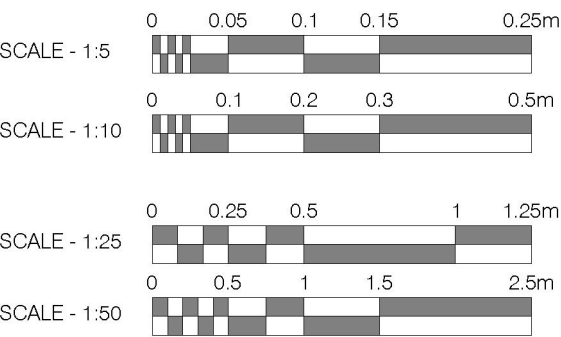

Rev: - Comments: - By: - Date: -				Client: Mr. Simon Dougal Project Title: 107 High St, Lindfield, Haywards Heath, West Sussex, RH16 2HR Drawing Title: Detail Drawings: First Floor SE Bedroom Vaulted Ceiling Scale: 1:25@A1 1:50@A3 1:5@A1 1:10@A3 Date: Apr 25 Drawn: KN Checked: KW				kyson[®] Studio 28 Scrutton Street London UK EC2A 4RP T: +44(0) 20 7247 2462 E: enquiries@kyson.co.uk W: www.kyson.co.uk Project No.: 900-25 Drawing No.: 5022 Revision: -		
--	--	--	--	--	--	--	--	---	--	--