


‘AS BUILT’ / EXISTING DRAWINGS PLANS

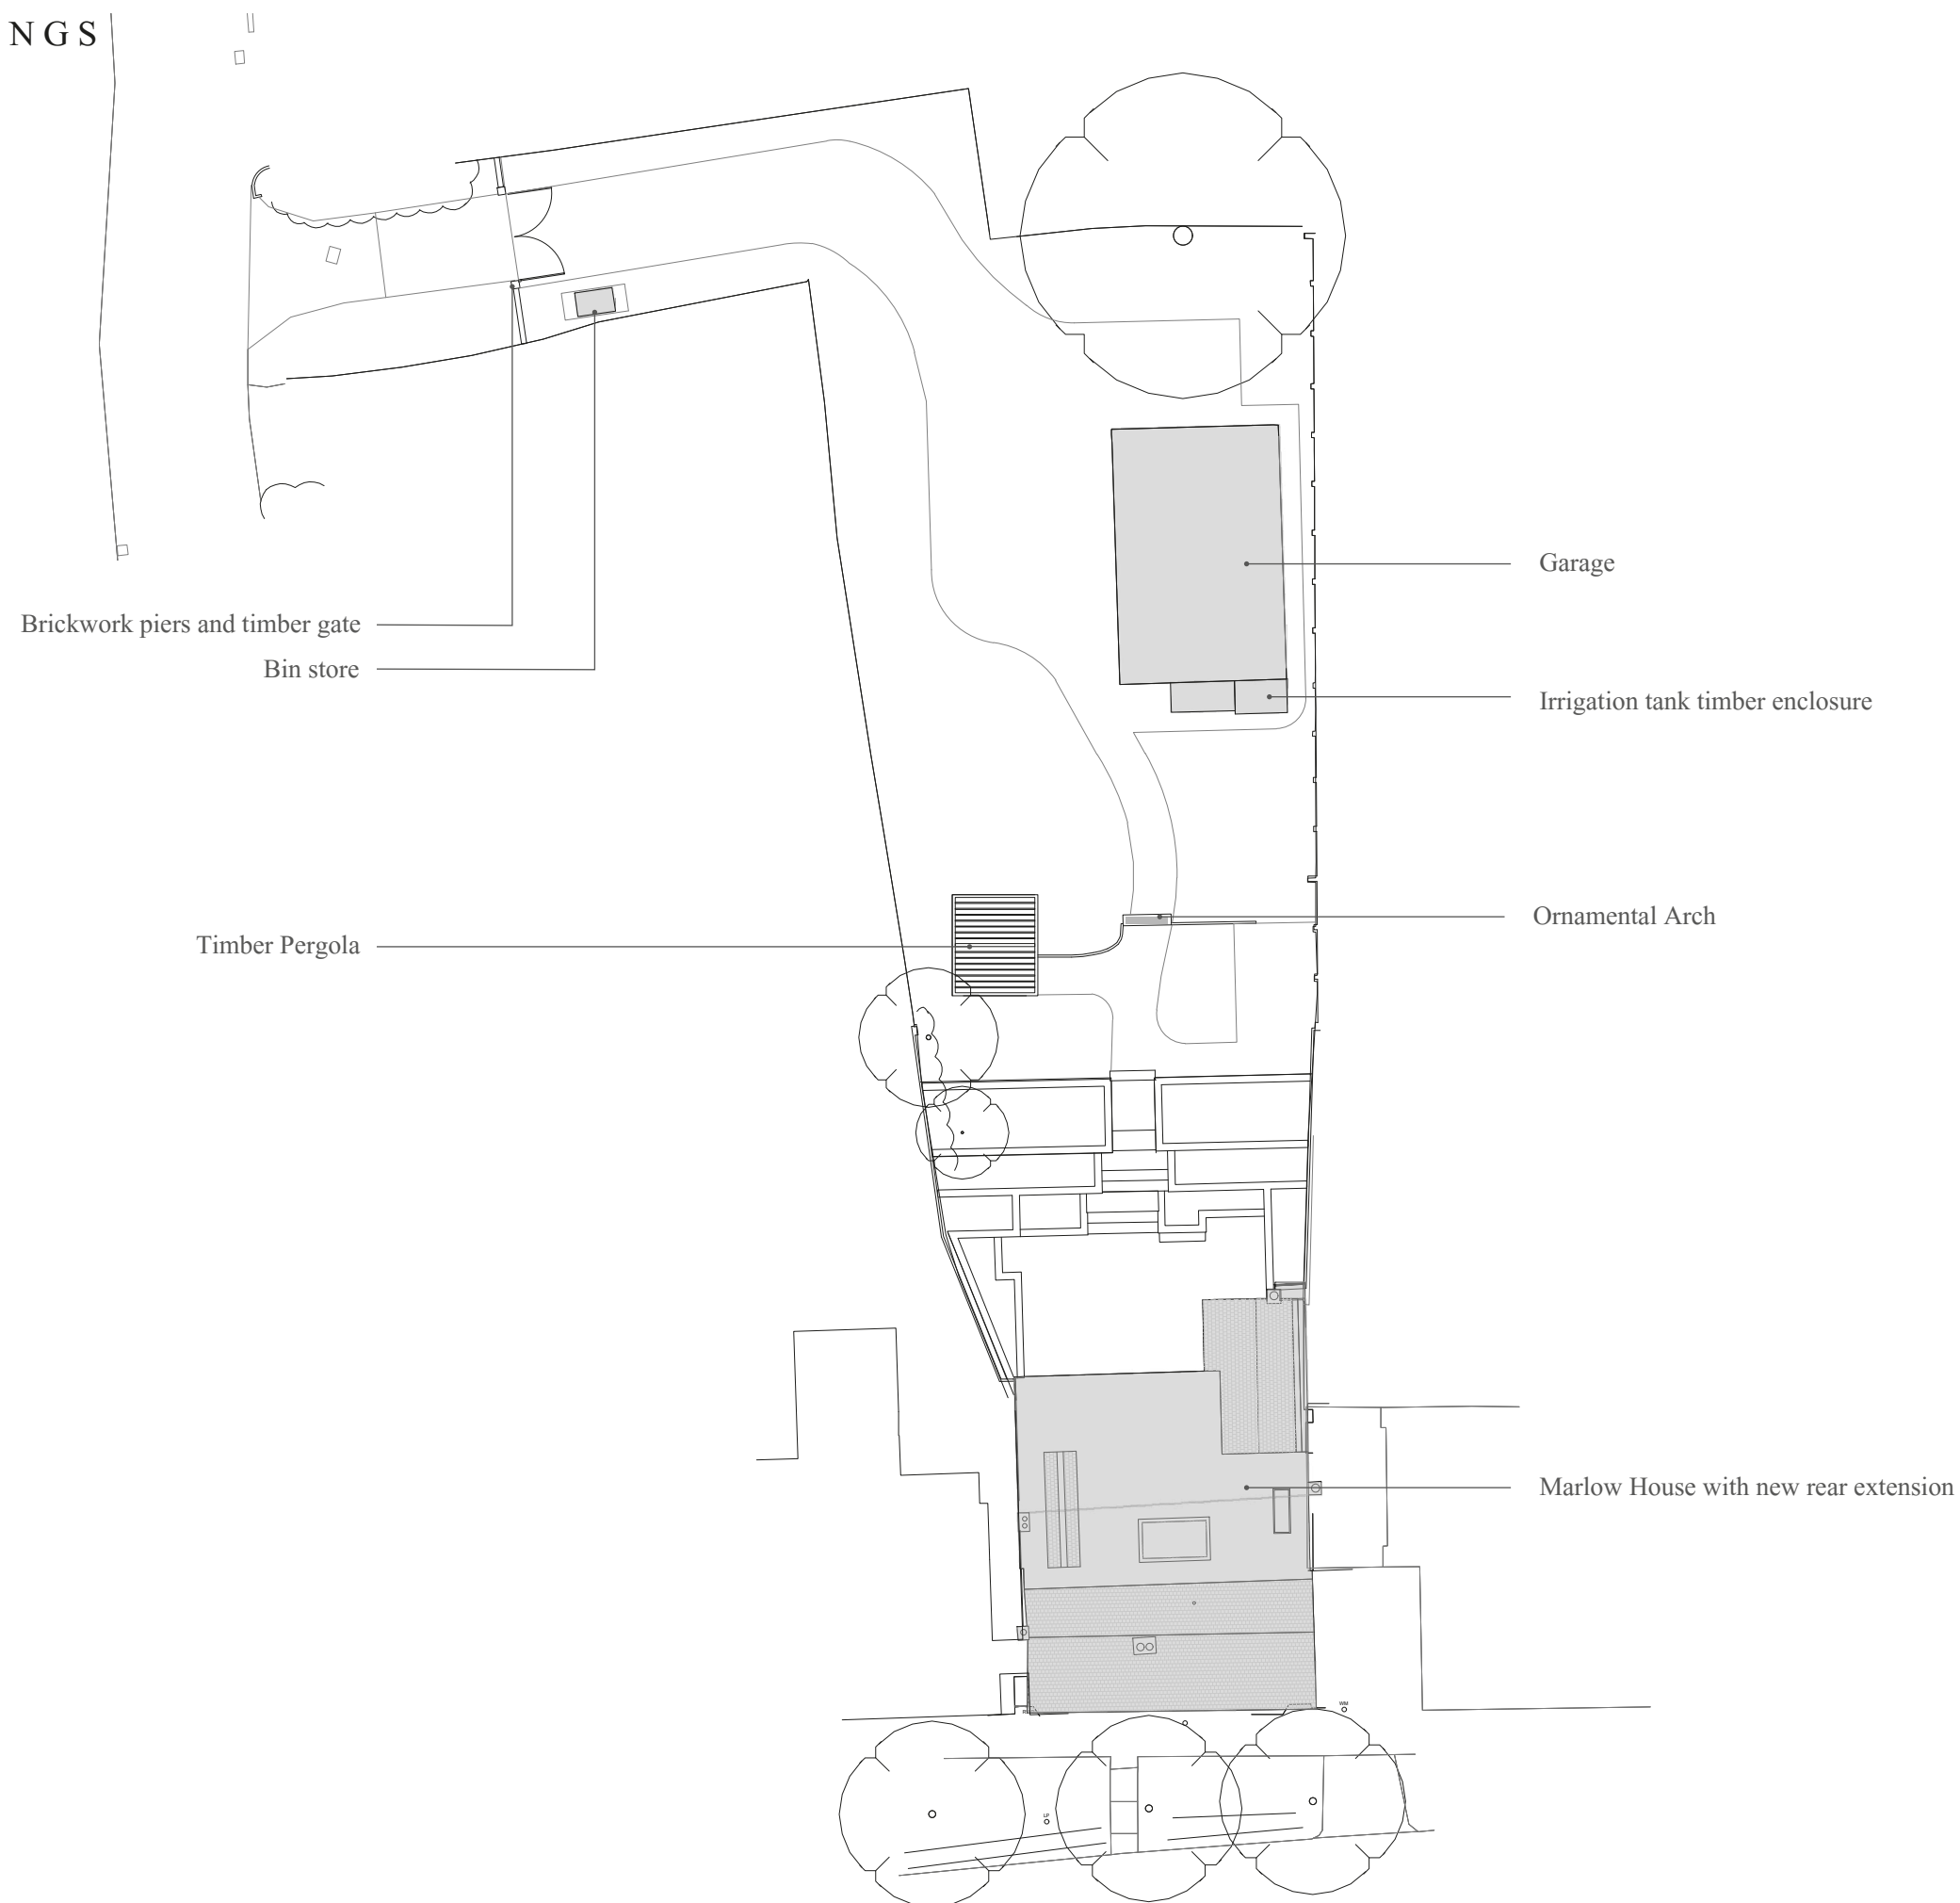

‘AS BUILT’/EXISTING - SITE PLAN. Drawing no. 0700. 1:500@A3

0 1 2 3 4 5 10 15 20m



107 HIGH STREET, LINDFIELD, HAYWARDS HEATH, RH16 2HR

