


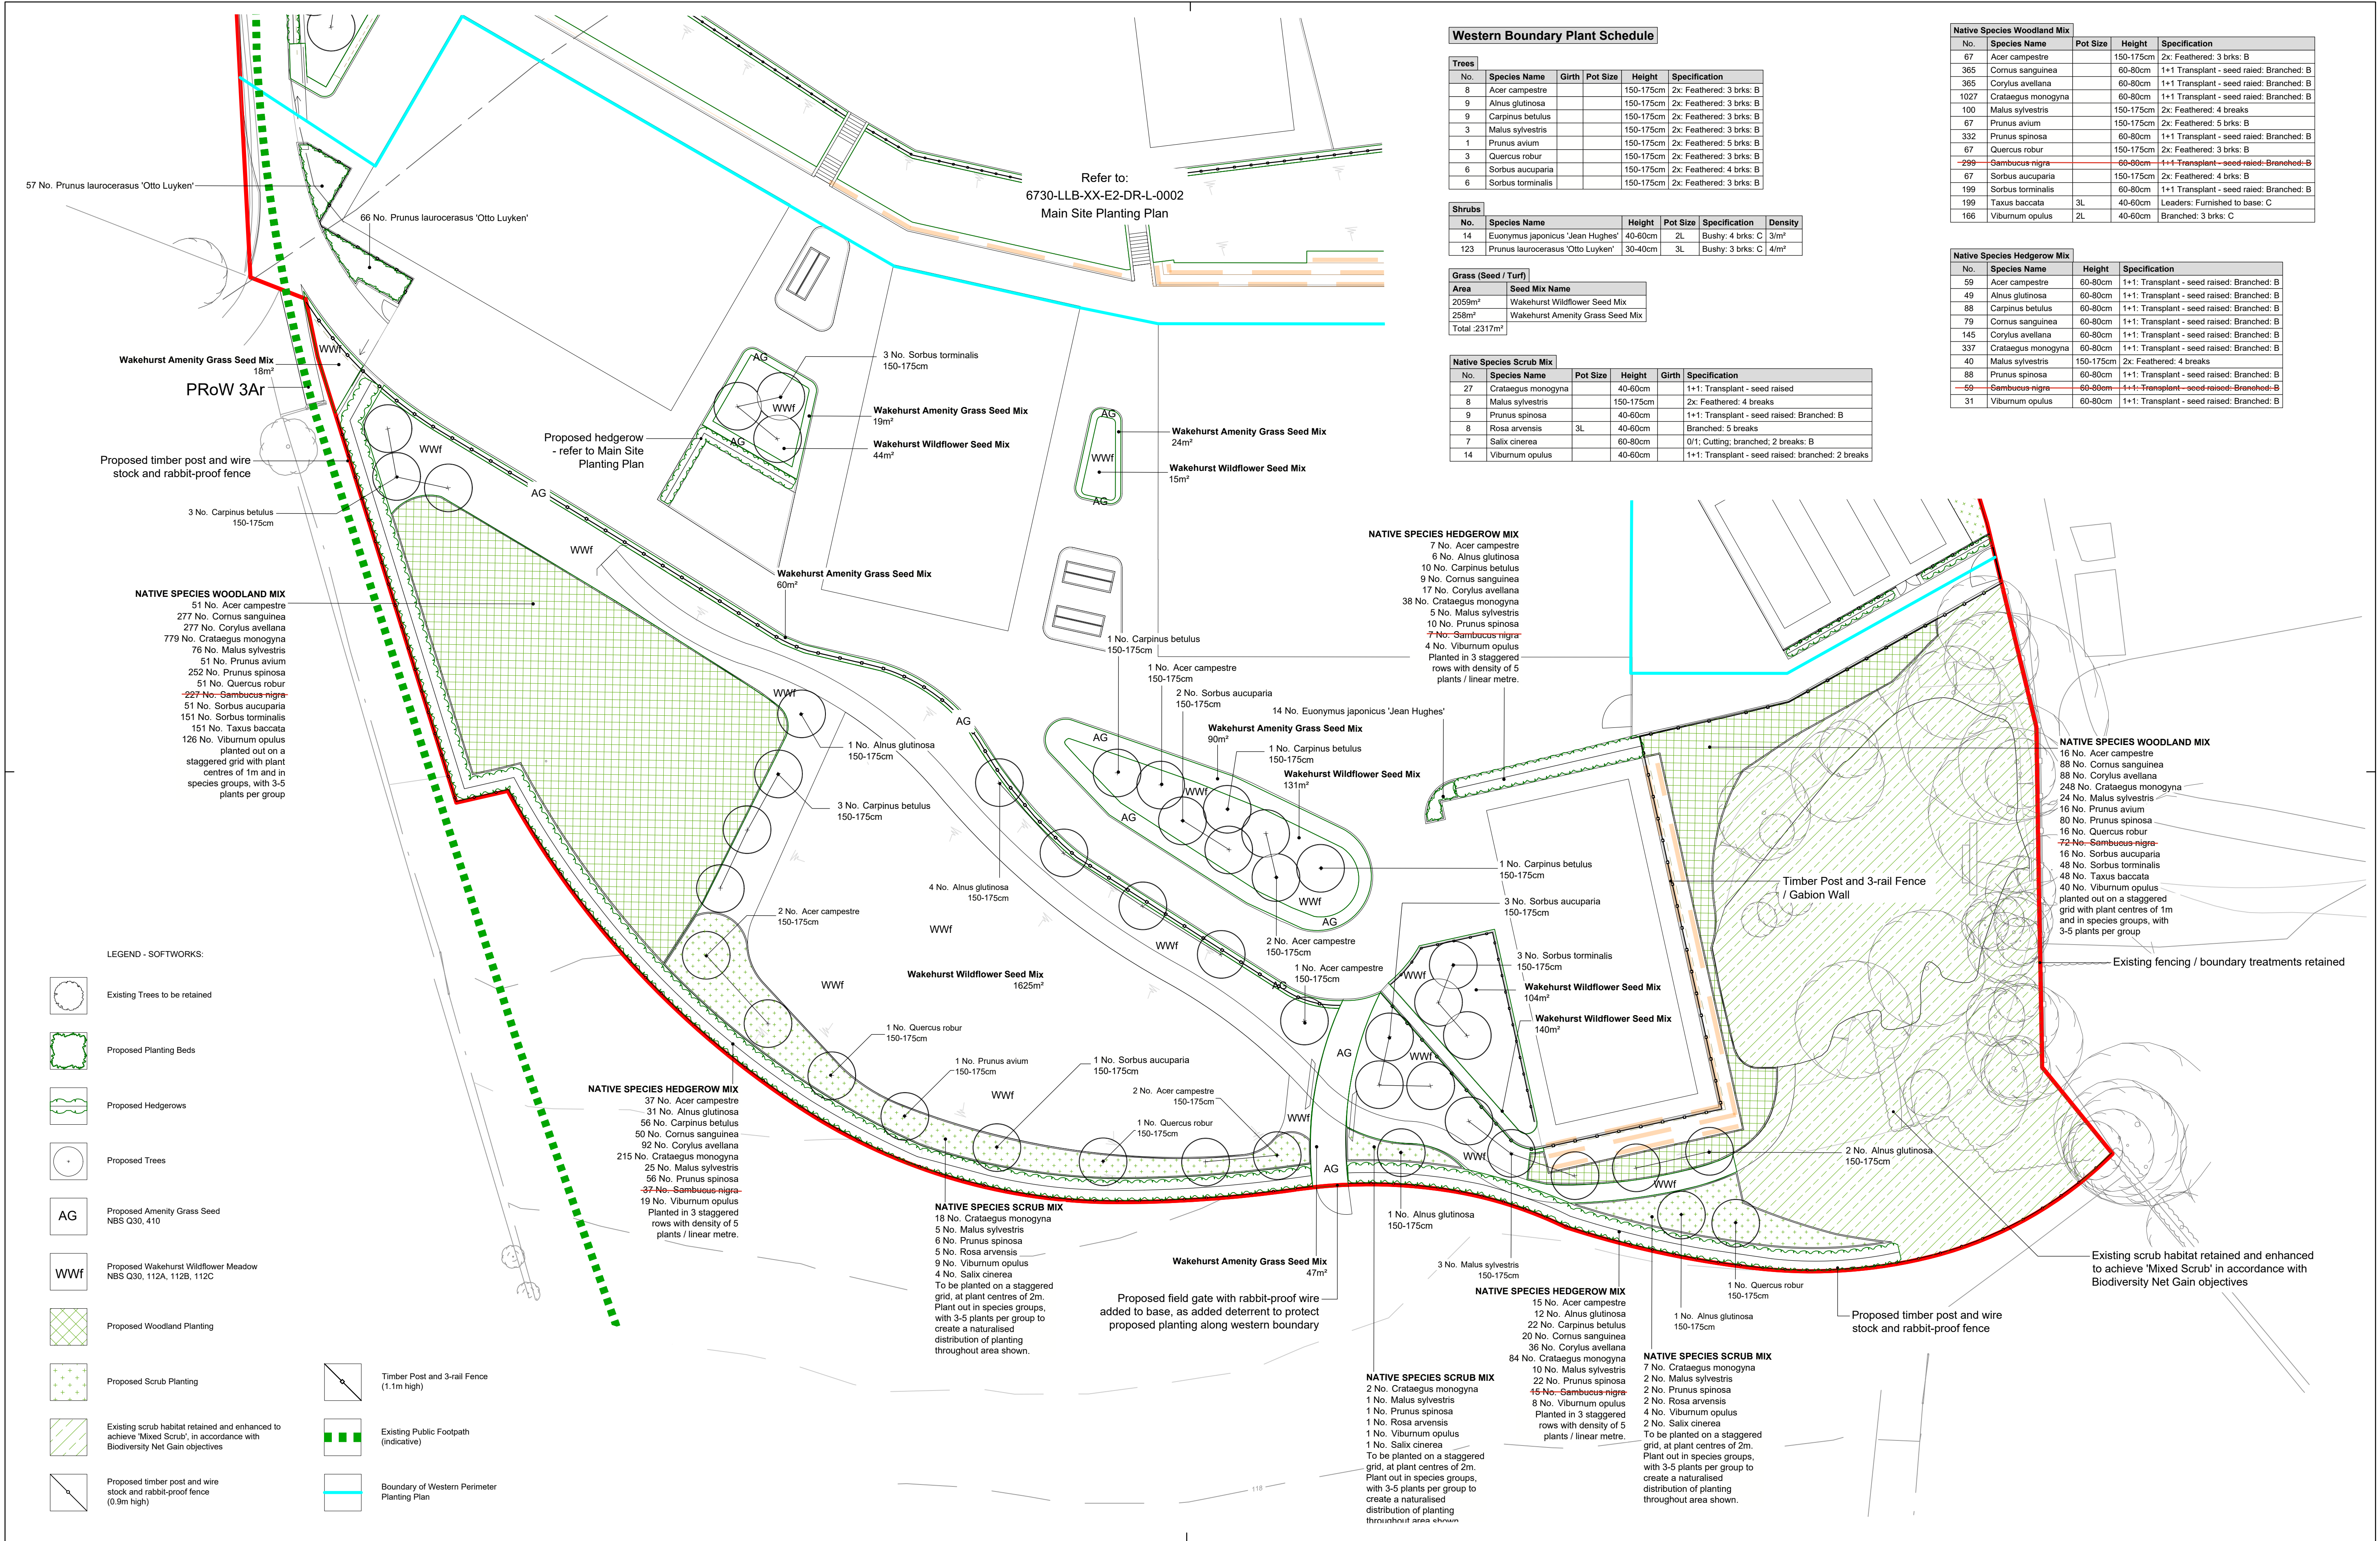

Western Boundary Plant Schedule

Trees					
No.	Species Name	Girth	Pot Size	Height	Specification
8	Acer campestre			150-175cm	2x: Feathered: 3 brks: B
9	Alnus glutinosa			150-175cm	2x: Feathered: 3 brks: B
9	Carpinus betulus			150-175cm	2x: Feathered: 3 brks: B
3	Malus sylvestris			150-175cm	2x: Feathered: 3 brks: B
1	Prunus avium			150-175cm	2x: Feathered: 5 brks: B
3	Quercus robur			150-175cm	2x: Feathered: 3 brks: B
6	Sorbus aucuparia			150-175cm	2x: Feathered: 4 brks: B
6	Sorbus terminalis			150-175cm	2x: Feathered: 3 brks: B

Shrubs					
No.	Species Name	Height	Pot Size	Specification	Density
14	Euonymus japonicus 'Jean Hughes'	40-60cm	2L	Bushy: 4 brks: C	3/m²
123	Prunus laurocerasus 'Otto Luyken'	30-40cm	3L	Bushy: 3 brks: C	4/m²

Grass (Seed / Turf)	
Area	Seed Mix Name
2059m²	Wakehurst Wildflower Seed Mix
258m²	Wakehurst Amenity Grass Seed Mix
Total :2317m²	

Native Species Scrub Mix					
No.	Species Name	Pot Size	Height	Girth	Specification
27	Crataegus monogyna		40-60cm		1+1: Transplant - seed raised
8	Malus sylvestris		150-175cm		2x: Feathered: 4 breaks
9	Prunus spinosa		40-60cm		1+1: Transplant - seed raised: Branched: B
8	Rosa arvensis	3L	40-60cm		Branched: 5 breaks
7	Salix cinerea		60-80cm		0/1: Cutting; branched; 2 breaks: B
14	Viburnum opulus		40-60cm		1+1: Transplant - seed raised: branched: 2 breaks

Native Species Woodland Mix				
No.	Species Name	Pot Size	Height	Specification
67	Acer campestre		150-175cm	2x: Feathered: 3 brks: B
365	Cornus sanguinea		60-80cm	1+1: Transplant - seed raised: Branched: B
365	Corylus avellana		60-80cm	1+1: Transplant - seed raised: Branched: B
1027	Crataegus monogyna		60-80cm	1+1: Transplant - seed raised: Branched: B
100	Malus sylvestris		150-175cm	2x: Feathered: 4 breaks
67	Prunus avium		150-175cm	2x: Feathered: 5 brks: B
332	Prunus spinosa		60-80cm	1+1: Transplant - seed raised: Branched: B
67	Quercus robur		150-175cm	2x: Feathered: 3 brks: B
299	Sambucus nigra		60-80cm	1+1: Transplant - seed raised: Branched: B
67	Sorbus aucuparia		150-175cm	2x: Feathered: 4 brks: B
199	Sorbus terminalis		60-80cm	1+1: Transplant - seed raised: Branched: B
199	Taxus baccata	3L	40-60cm	Leaders: Furnished to base: C
166	Viburnum opulus	2L	40-60cm	Branched: 3 brks: C

Native Species Hedgerow Mix		
No.	Species Name	Height
59	Acer campestre	60-80cm
49	Alnus glutinosa	60-80cm
88	Carpinus betulus	60-80cm
79	Cornus sanguinea	60-80cm
145	Corylus avellana	60-80cm
337	Crataegus monogyna	60-80cm
40	Malus sylvestris	150-175cm
88	Prunus spinosa	60-80cm
59	Sambucus nigra	60-80cm
31	Viburnum opulus	60-80cm

NATIVE SPECIES HEDGEROW MIX

- 7 No. Acer campestre
- 6 No. Alnus glutinosa
- 10 No. Carpinus betulus
- 9 No. Cornus sanguinea
- 17 No. Corylus avellana
- 38 No. Crataegus monogyna
- 5 No. Malus sylvestris
- 10 No. Prunus spinosa
- ~~7 No. Sambucus nigra~~
- 4 No. Viburnum opulus

Planted in 3 staggered rows with density of 5 plants / linear metre.

NATIVE SPECIES WOODLAND MIX

- 16 No. Acer campestre
- 88 No. Cornus sanguinea
- 88 No. Corylus avellana
- 248 No. Crataegus monogyna
- 24 No. Malus sylvestris
- 16 No. Prunus avium
- 80 No. Prunus spinosa
- 16 No. Quercus robur
- ~~72 No. Sambucus nigra~~
- 16 No. Sorbus aucuparia
- 48 No. Sorbus terminalis
- 48 No. Taxus baccata
- 40 No. Viburnum opulus

planted out on a staggered grid with plant centres of 1m and in species groups, with 3-5 plants per group

Existing fencing / boundary treatments retained

Existing scrub habitat retained and enhanced to achieve 'Mixed Scrub' in accordance with Biodiversity Net Gain objectives

NATIVE SPECIES HEDGEROW MIX

- 15 No. Acer campestre
- 12 No. Alnus glutinosa
- 22 No. Carpinus betulus
- 20 No. Cornus sanguinea
- 36 No. Corylus avellana
- 84 No. Crataegus monogyna
- 10 No. Malus sylvestris
- 22 No. Prunus spinosa
- ~~45 No. Sambucus nigra~~
- 8 No. Viburnum opulus

Planted in 3 staggered rows with density of 5 plants / linear metre.

NATIVE SPECIES SCRUB MIX

- 7 No. Crataegus monogyna
- 2 No. Malus sylvestris
- 2 No. Prunus spinosa
- 2 No. Rosa arvensis
- 4 No. Viburnum opulus
- 2 No. Salix cinerea

To be planted on a staggered grid, at plant centres of 2m. Plant out in species groups, with 3-5 plants per group to create a naturalised distribution of planting throughout area shown.

NATIVE SPECIES SCRUB MIX

- 2 No. Crataegus monogyna
- 1 No. Malus sylvestris
- 1 No. Prunus spinosa
- 1 No. Rosa arvensis
- 1 No. Viburnum opulus
- 1 No. Salix cinerea

To be planted on a staggered grid, at plant centres of 2m. Plant out in species groups, with 3-5 plants per group to create a naturalised distribution of planting throughout area shown.

rev. rev. date auth. rev. note

rev. rev. date auth. rev. note
P01 13/08/24 PW 1st issue.
P02 11/12/24 PW Updated to latest Arch and Eng layouts. Planting updated to BNG discussions with SWT.
P03 31/01/25 PW Minor amendments to tree positions to coordinate with engineering strategy and existing utilities.
P04 30/04/25 PW G14 position updated.
P05 01/05/25 PW Note added to hedgerow planting by Waste Recycling area.

This drawing and design are the copyright of Lloyd Bore Ltd. Do not scale from this drawing. This drawing has been produced for the purposes of a planning application and is not intended for construction purposes. The landscape design information is subject to checking and written approval by the project engineer, particularly in respect of above and below ground services, structures and foundations.

client. **Hugh Broughton Architects Ltd**
project. **Lansdown Conservation and Research Nursery**
Wakehurst Place
Haywards Heath
drawing no. **6730-LLB-XX-E2-DR-L-0004**
drawing title. **Planting Plan WB**
Western Boundary
rev. **P05**
scale. **S4**
sheet. **A1**
drawn. **PW**
checked. **PW**
REV 2

rev. date **01/05/2025**
scale. **1:250**
sheet. **A1**
drawn. **PW**
checked. **PW**

lloyd bore landscape ecology arboriculture
33 ST. GEORGE'S PLACE, CANTERBURY, KENT CT1 1UT
www.lloydbore.co.uk 01227464340
mall@lloydbore.co.uk

1:250
0 2.5 5 7.5 10 12.5 m