


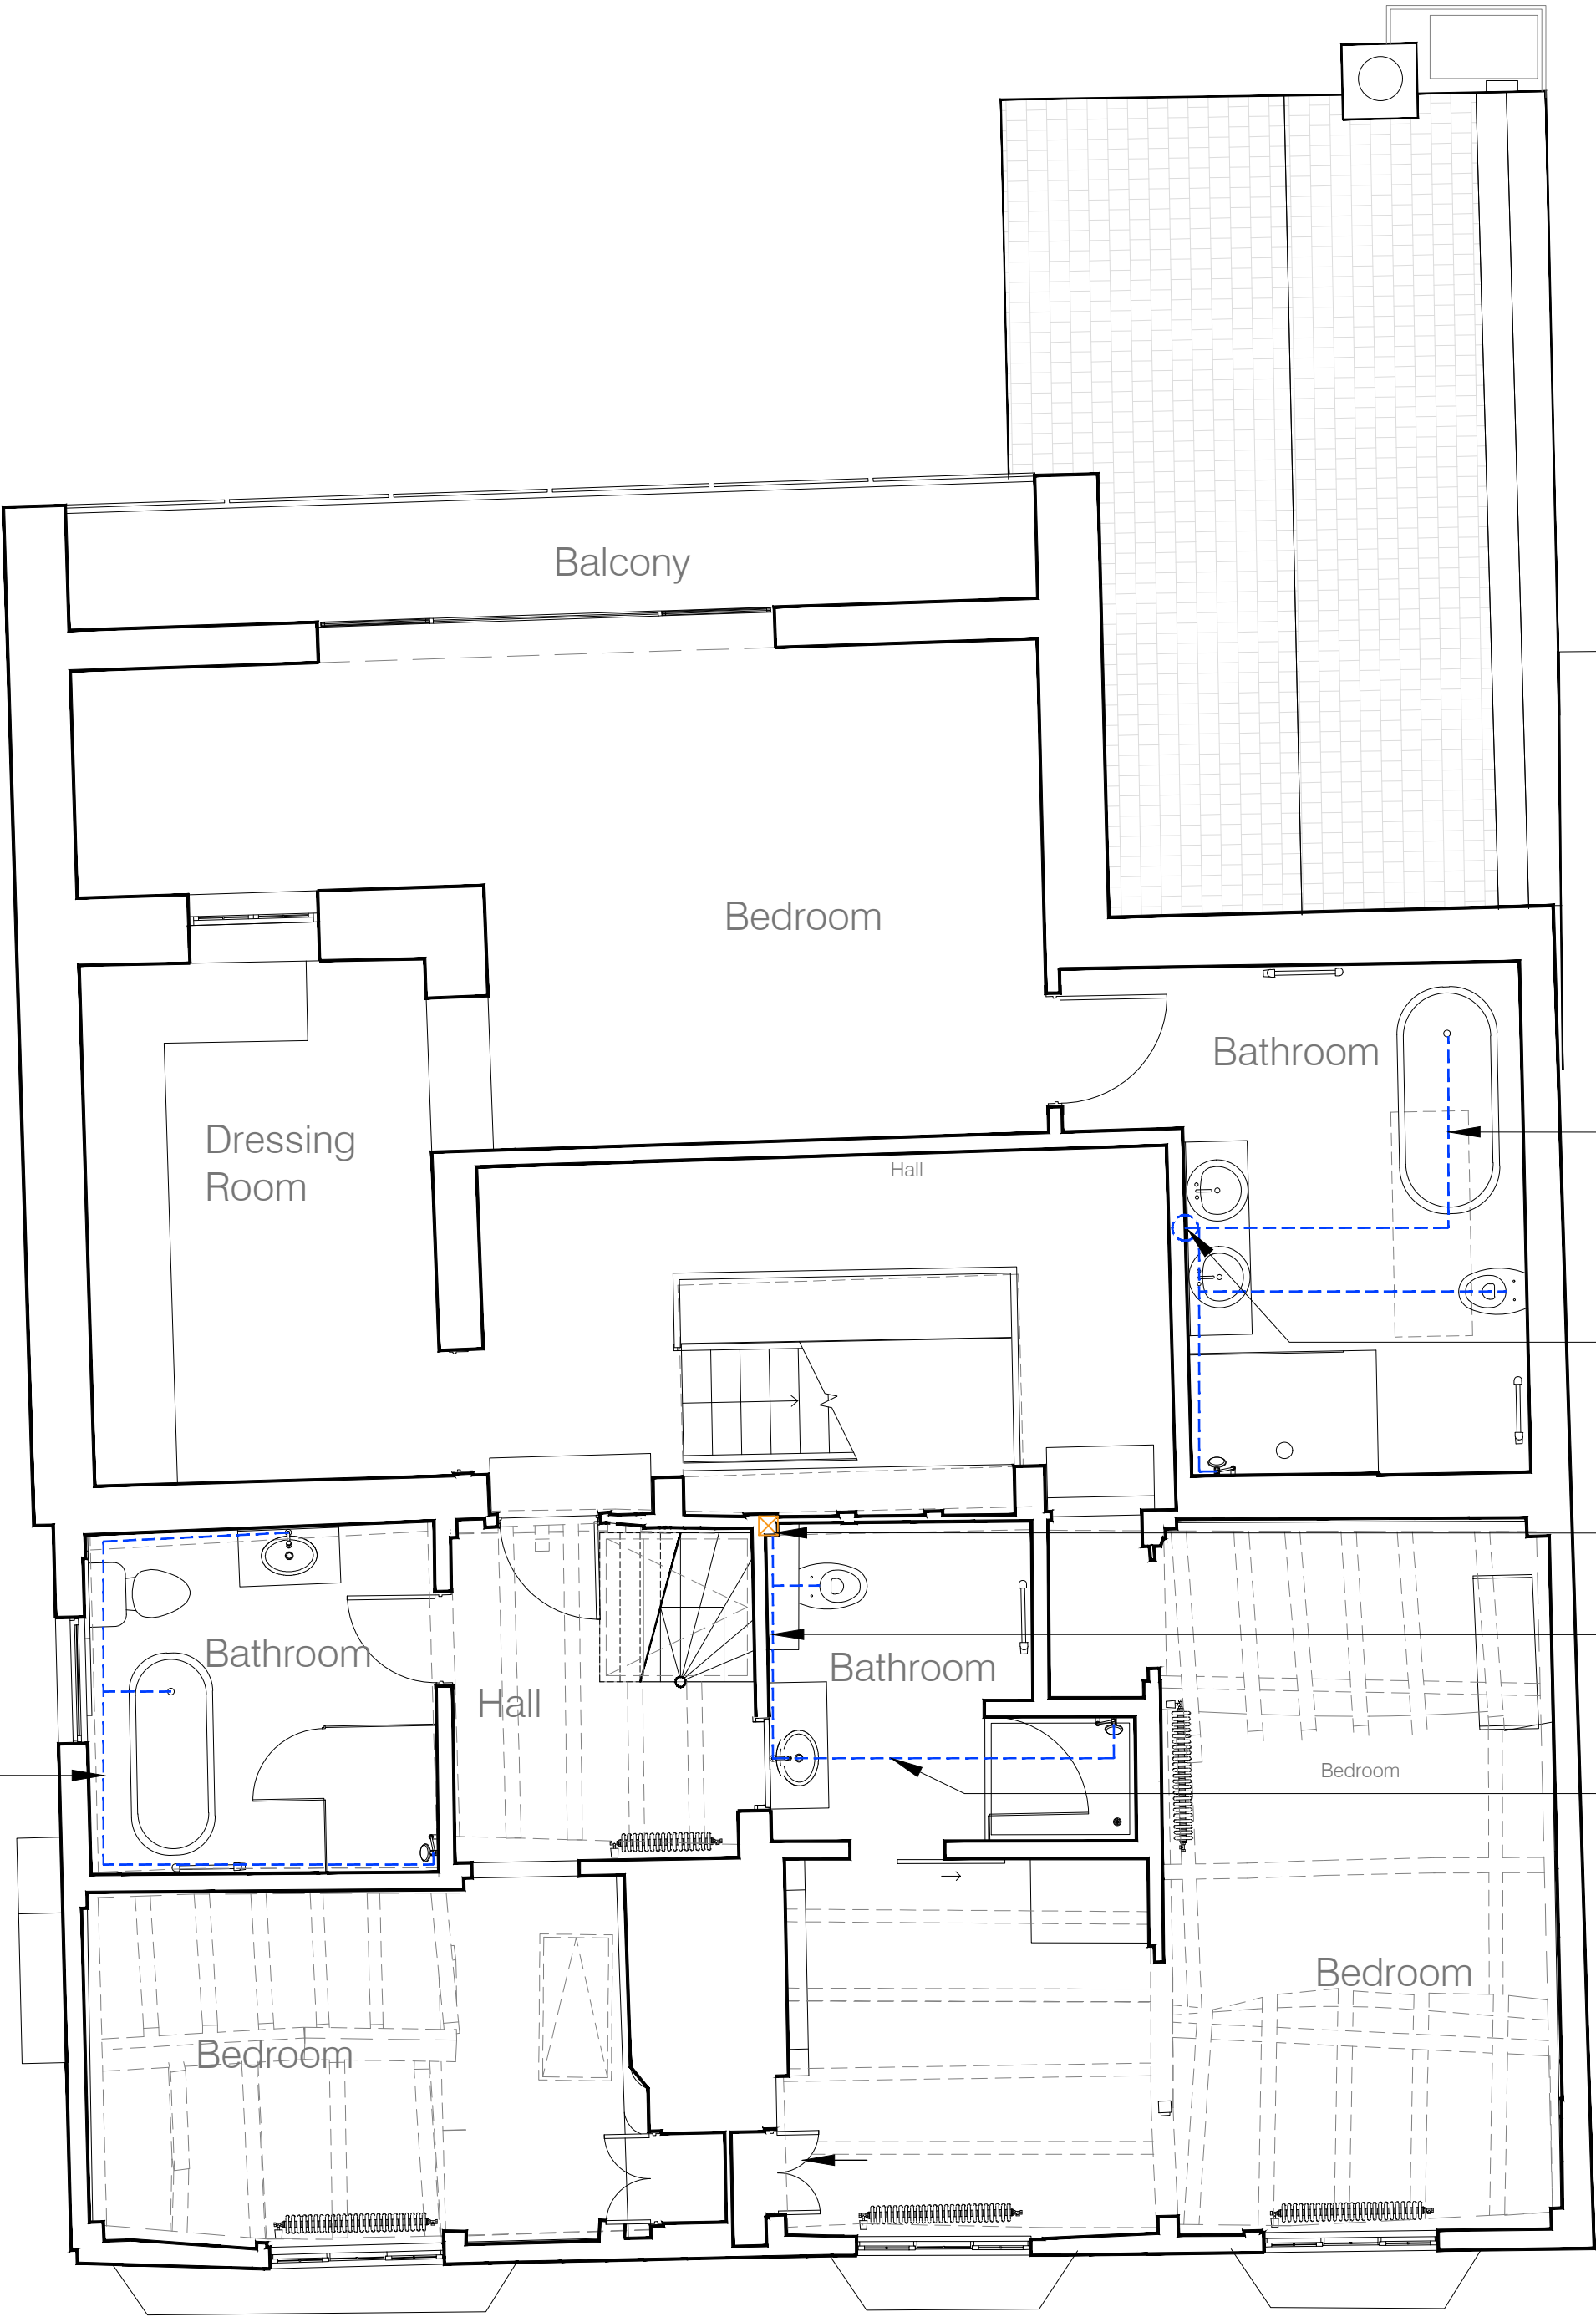

Water services rise from WC below, clipped to joists

Water services distributed from new wall via new floor structure

Water services drop in new walls to new bathroom & utility below

Service riser from cellar to loft


Water pipes clipped to joists

Joists notched to allow for pipe runs

FIRST FLOOR PLAN
Scale 1:50@A1
1:100@A3

NOTE
DRAWINGS TO BE READ IN CONJUNCTION WITH SUBMITTED
DESIGN&ACCESS STATEMENT AND HERITAGE STATEMENT

SERVICES INFORMATION OBTAINED FROM THE CONTRACTOR
WHO INSTALLED IT.

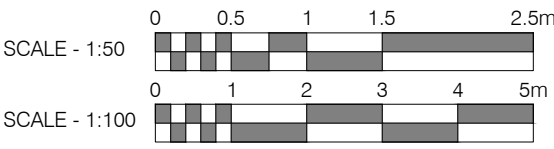

Rev.	Comments	By:	Date:
-	-	-	-

Do not scale this drawing All dimensions must be checked on site
All rights reserved. No reproduction in any material form is permitted
without consent.

LISTED BUILDING CONSENT			
Client: Mr. Simon Dougall			
Project Title: 107 High St, Lindfield, Haywards Heath, West Sussex, RH16 2HR			
Drawing Title: 'As-Built' Services: First Floor			
Scale: 1:50@A1 1:100@A3	Date: Sep 25	Drawn: KN	Checked: KW

kyson [®] Studio		
28 Scrutton Street London UK EC2A 4RP		
T: +44(0) 20 7247 2462 E: enquiries@kyson.co.uk W: www.kyson.co.uk		
Project No.: 900-25	Drawing No.: 2401	Revision: -