



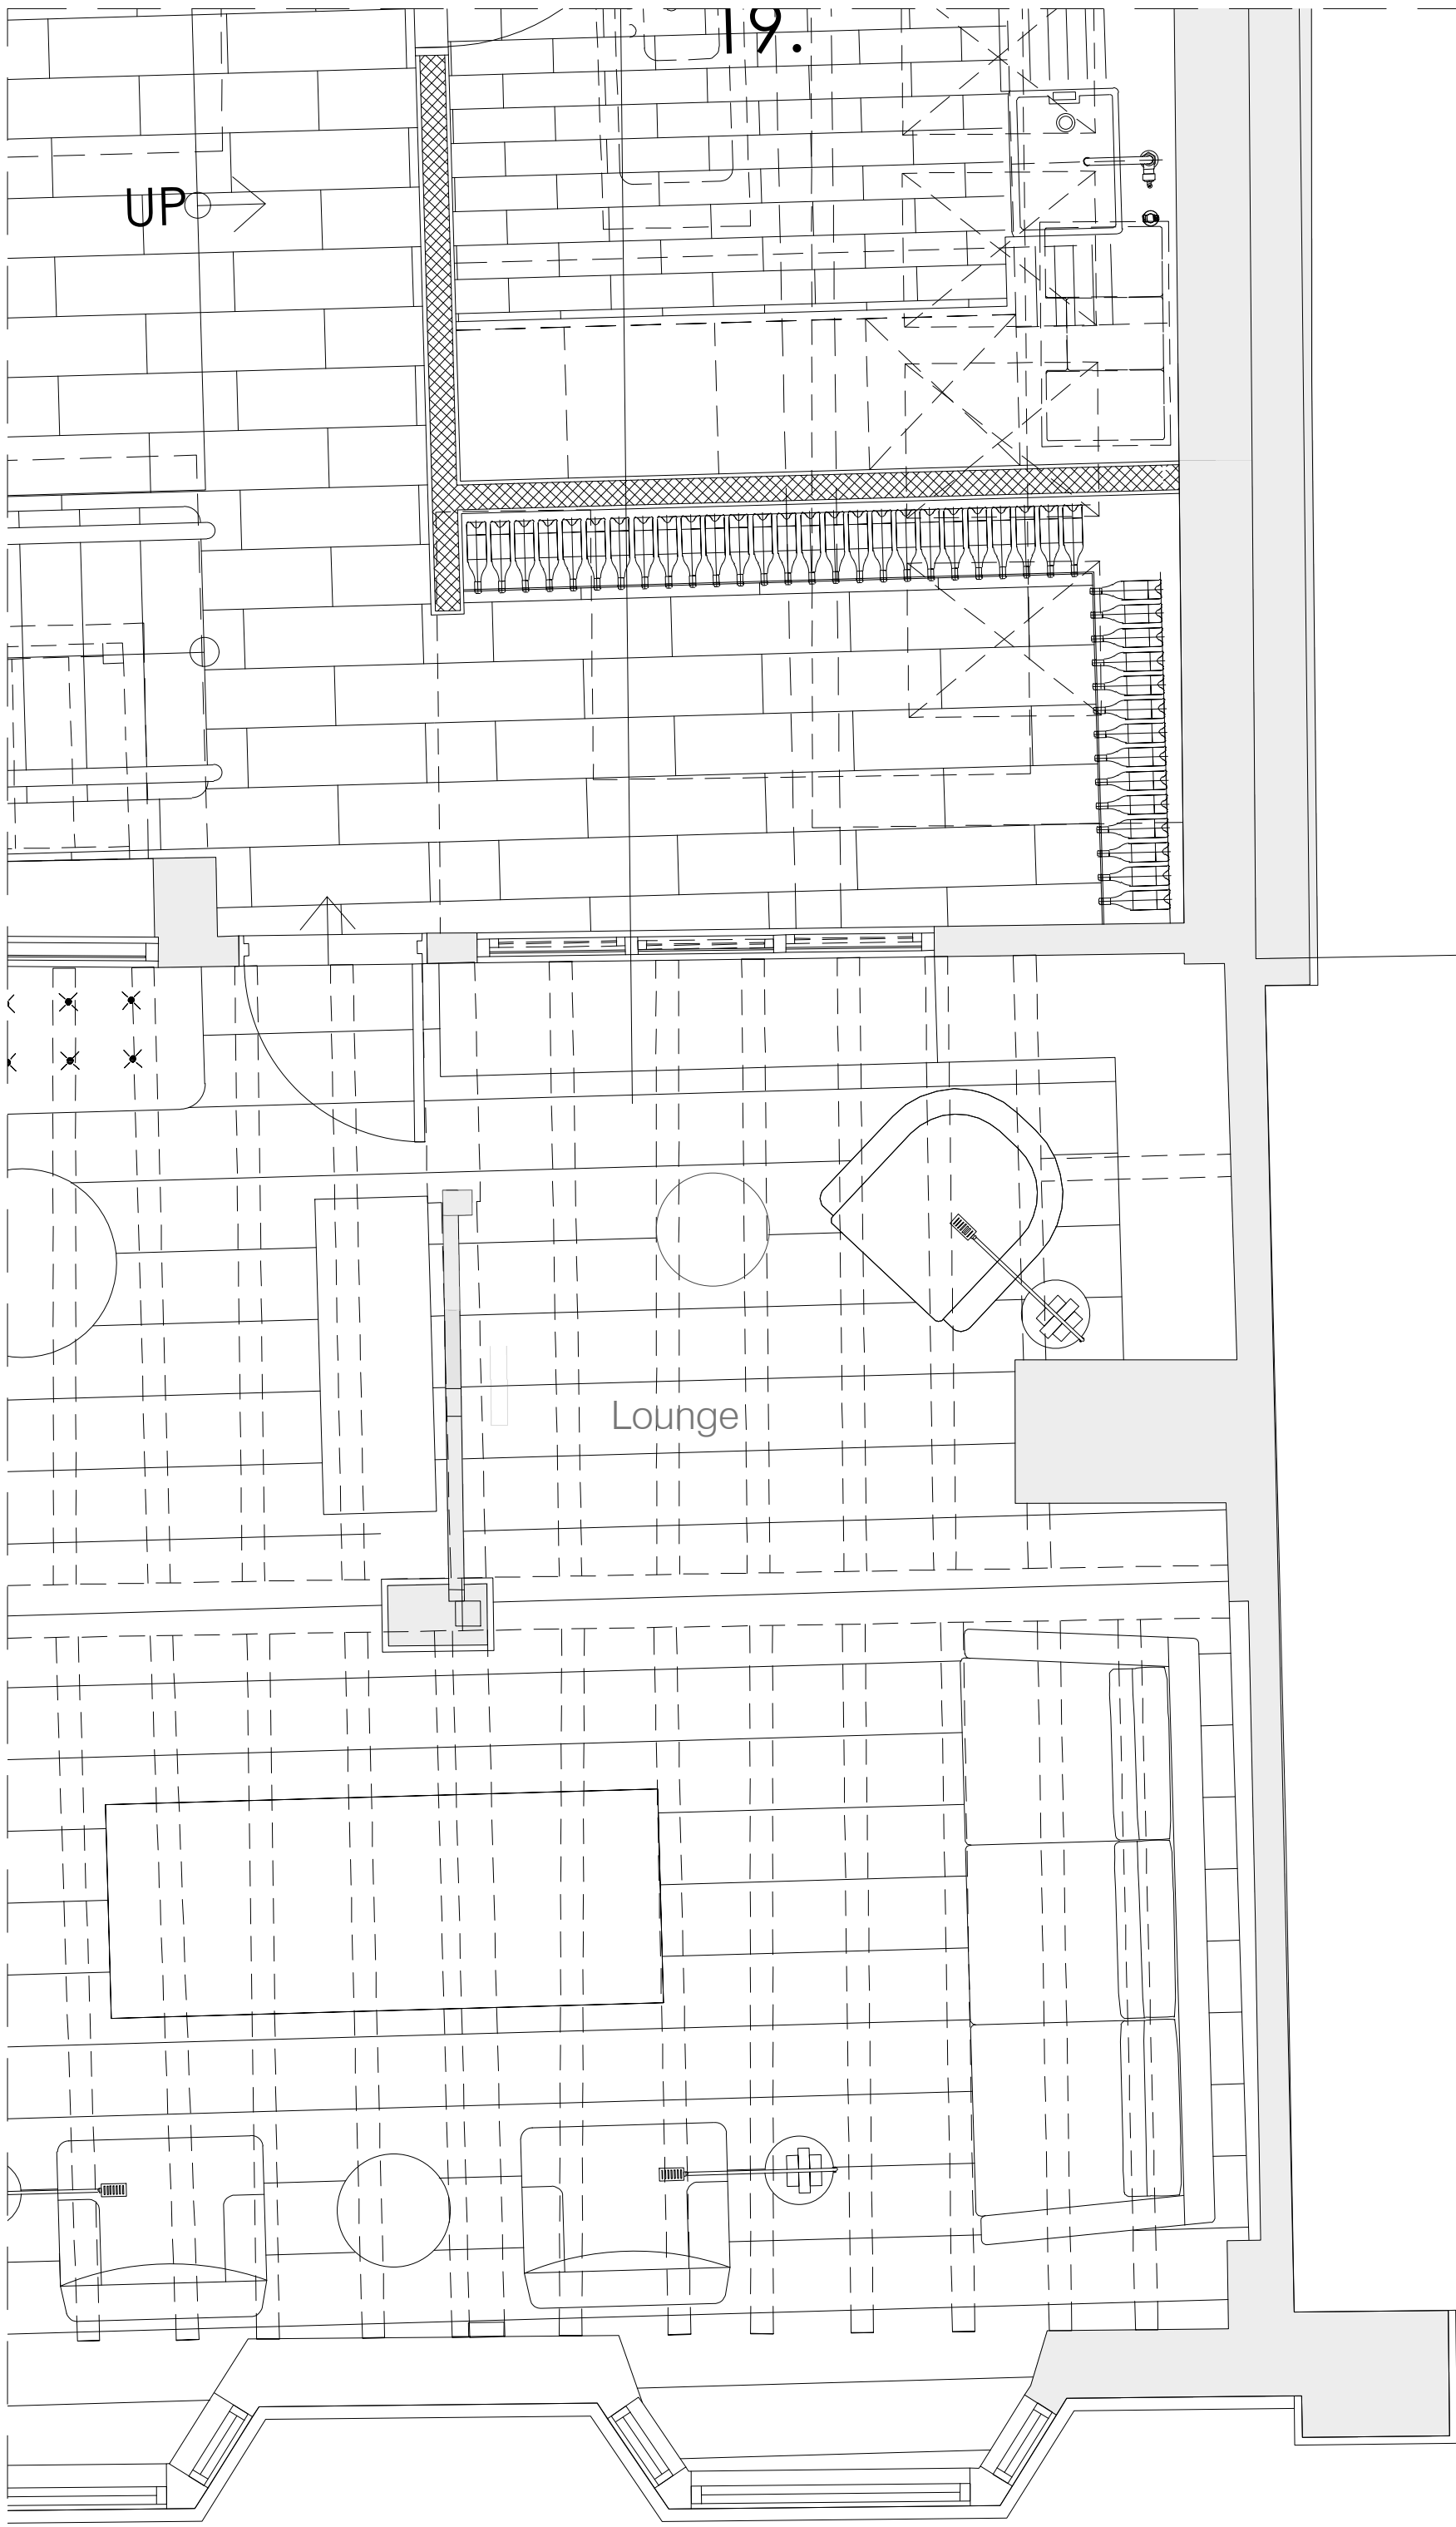

Approved Scheme
Ground Floor Plan
Scale 1:25:A1
1:50@A3

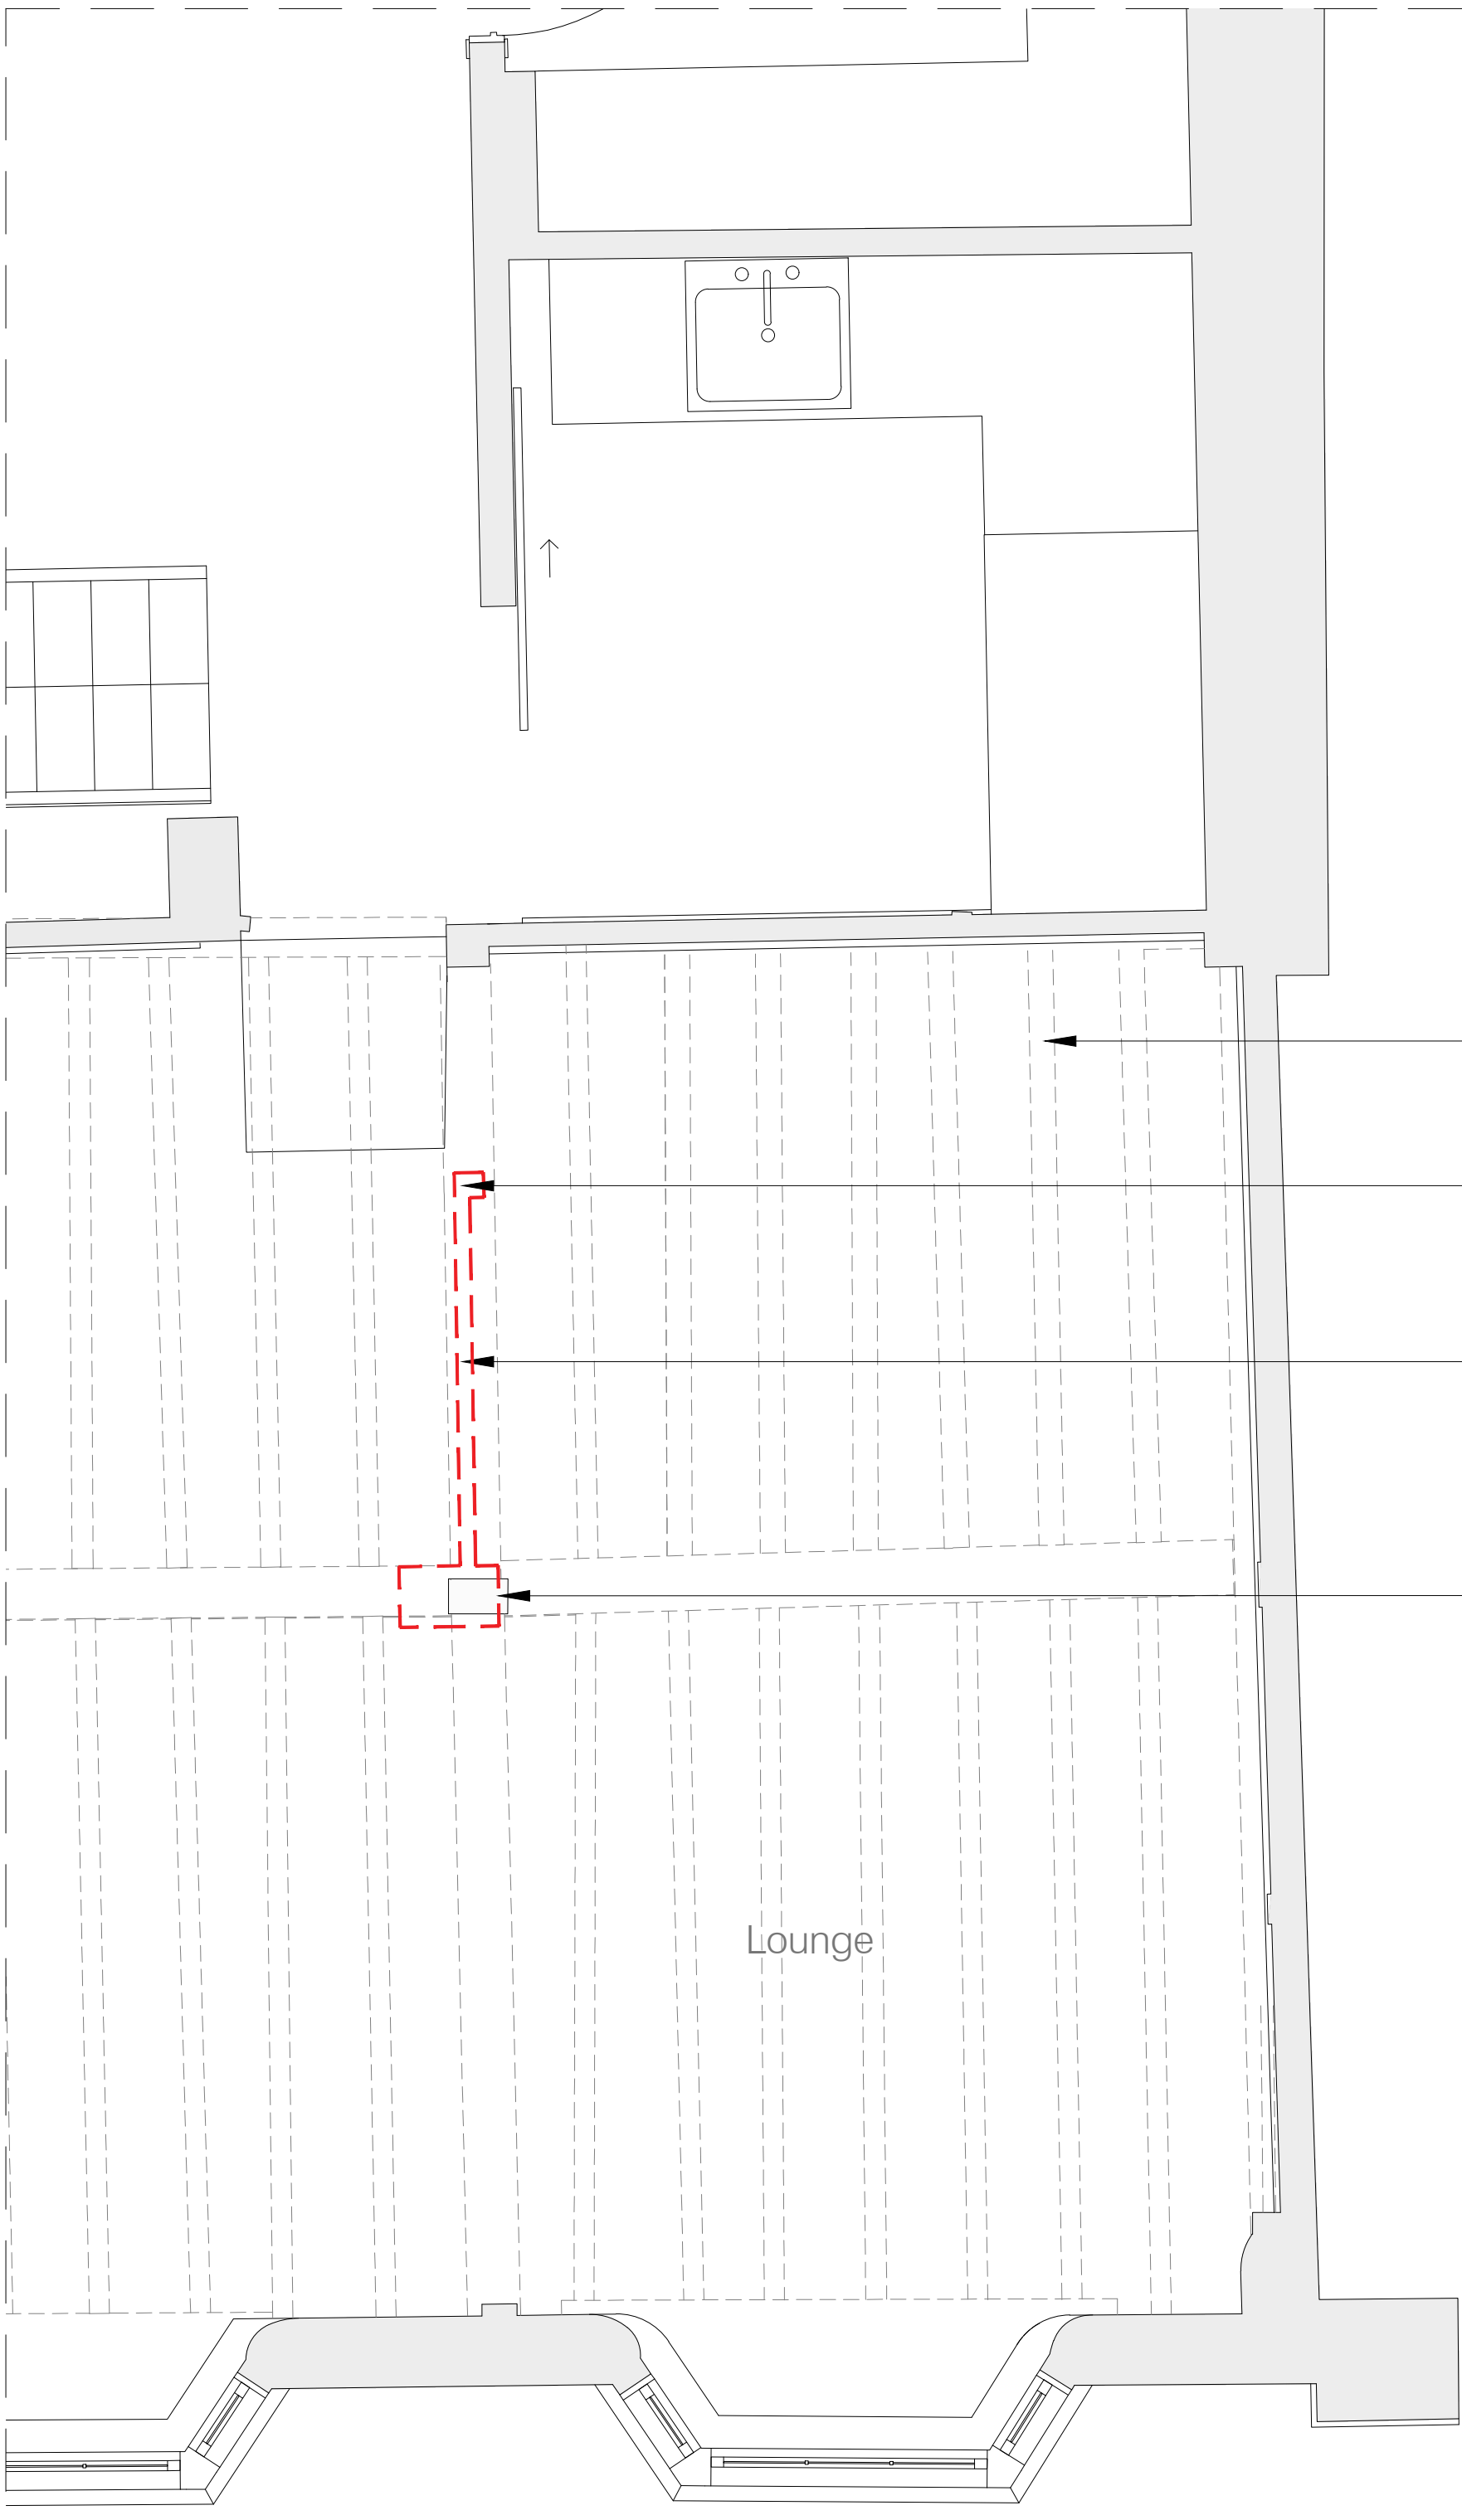

'As Built' and Proposed
Ground Floor Plan
Scale 1:25:A1
1:50@A3

- Dashed lines to indicate beams overhead
- Timber post forming jamb of door opening and horizontal timber member removed following removal of modern infill panelling, as noted below
- Modern infill panelling removed. Construction consisted of gypsum plasterboard and skim coat finish with faux timber batten planted on surface, stained to match original timber frame elsewhere
- Steel posts removed and replaced with oak gun stock post as per approved scheme and implemented on site



Partition wall in the lounge before removal

KEY:
Highlighted difference between Approved Scheme and 'As-Built'/Proposed Scheme

Rev.	Comments.	By:	Date:
-	-	-	-

Do not scale this drawing All dimensions must be checked on site.
All rights reserved. No reproduction in any material form is permitted without consent.

LISTED BUILDING CONSENT

Client:
Mr. Simon Dougall

Project Title:
107 High St, Lindfield, Haywards Heath, West Sussex, RH16 2HR

Drawing Title:
Detail Drawings:
Removal of Partition Wall in Lounge

Scale: 1:25@A1
1:50@A3

Date: Apr 25

Drawn: KN

Checked: KW

kyson

Studio
28 Scrutton Street
London
UK
EC2A 4RP

T: +44(0) 20 7247 2462
E: enquiries@kyson.co.uk
W: www.kyson.co.uk

Project No.: 900-25
Drawing No.: 5026
Revision: -

