




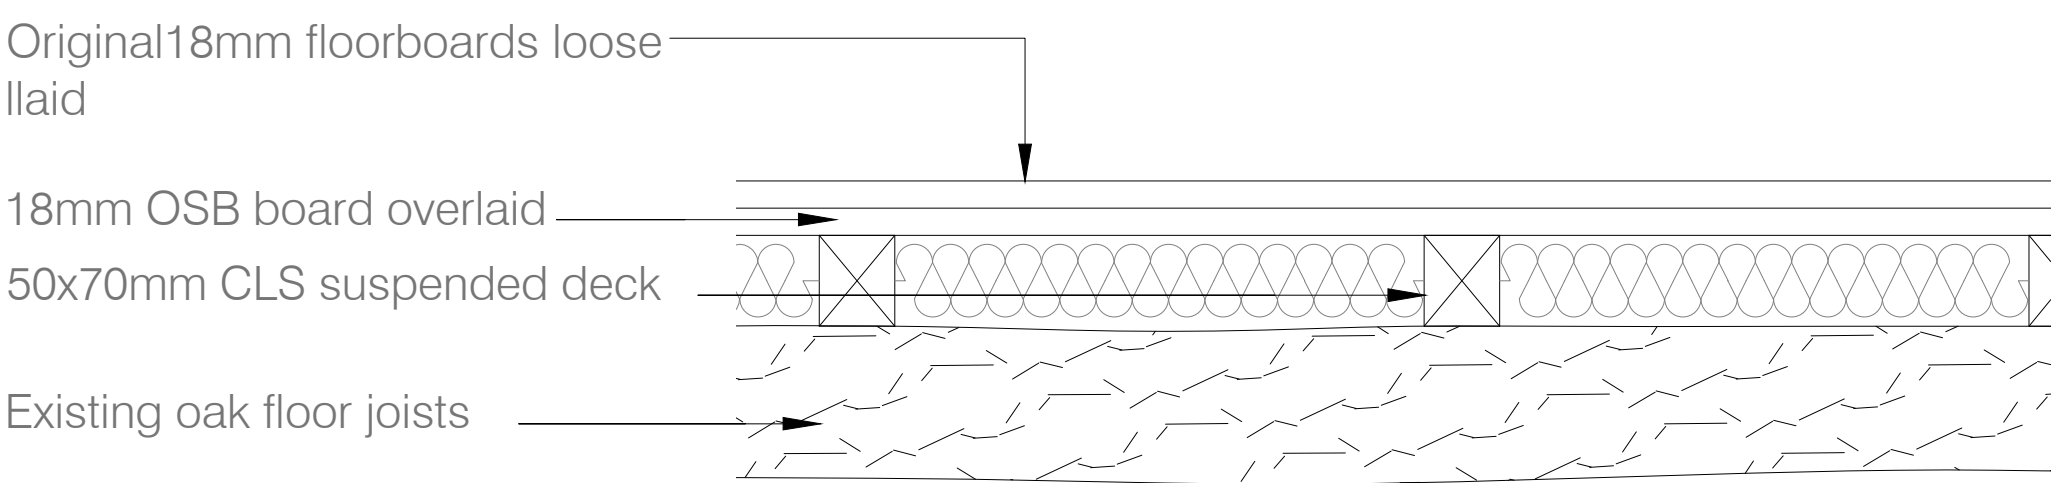


Detail 1
Existing Attic Floor Build-Up
Scale 1:5@A1
1:10@A3

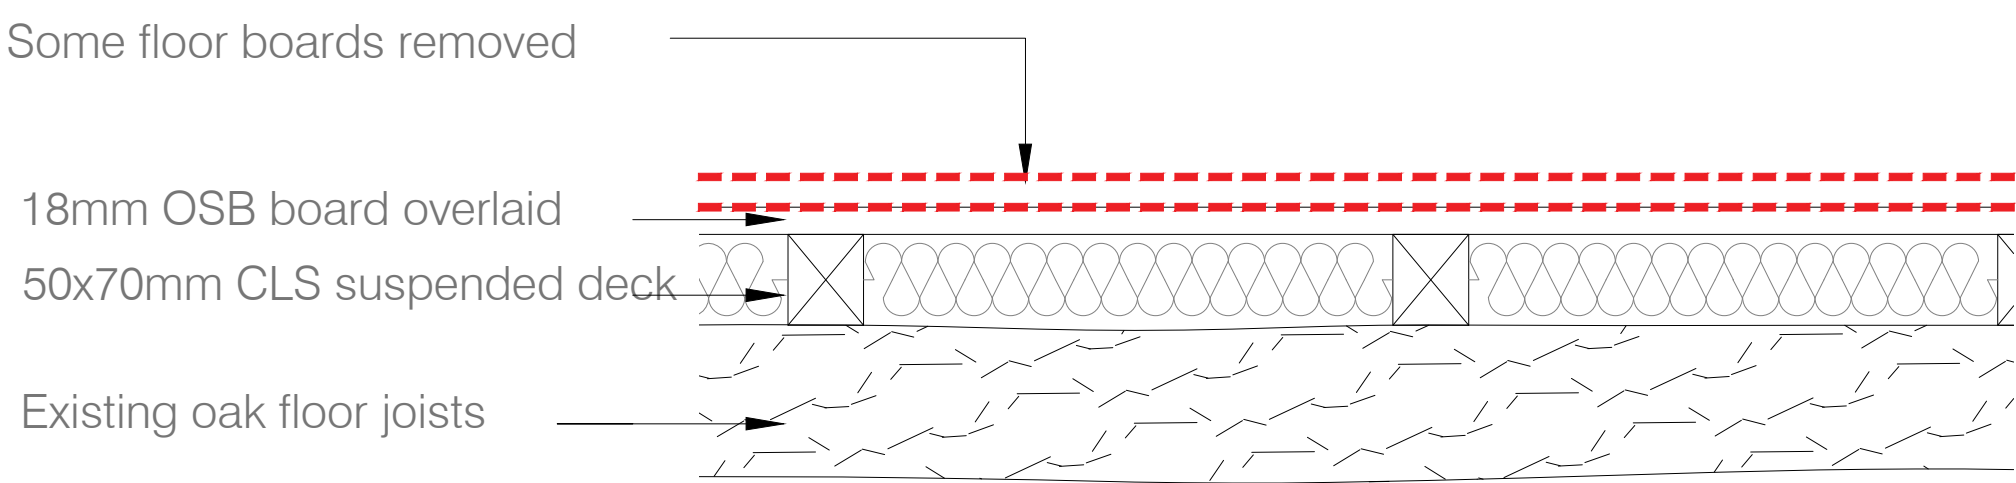

Detail 2
'As Built' Attic Floor Build-Up
Scale 1:5@A1
1:10@A3

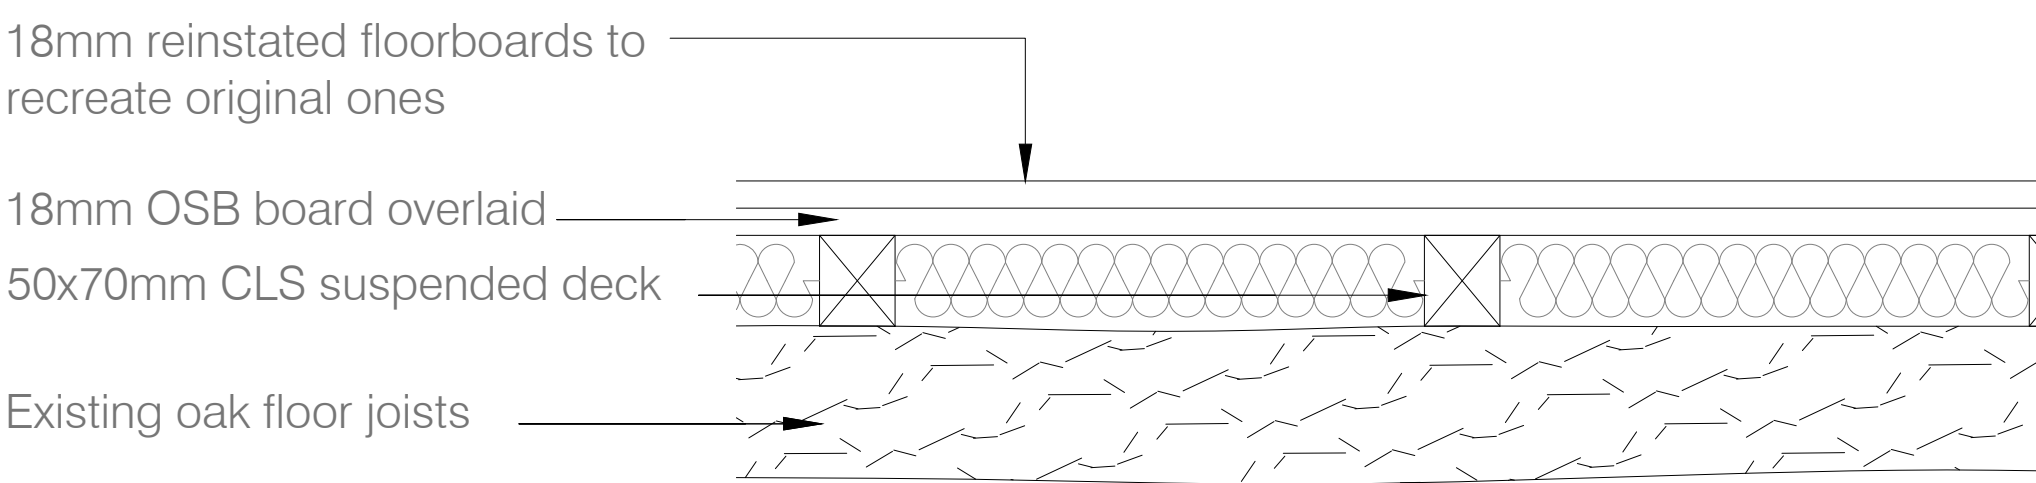


Detail 3
Proposed Attic Floor Build-Up
Scale 1:5@A1
1:10@A3

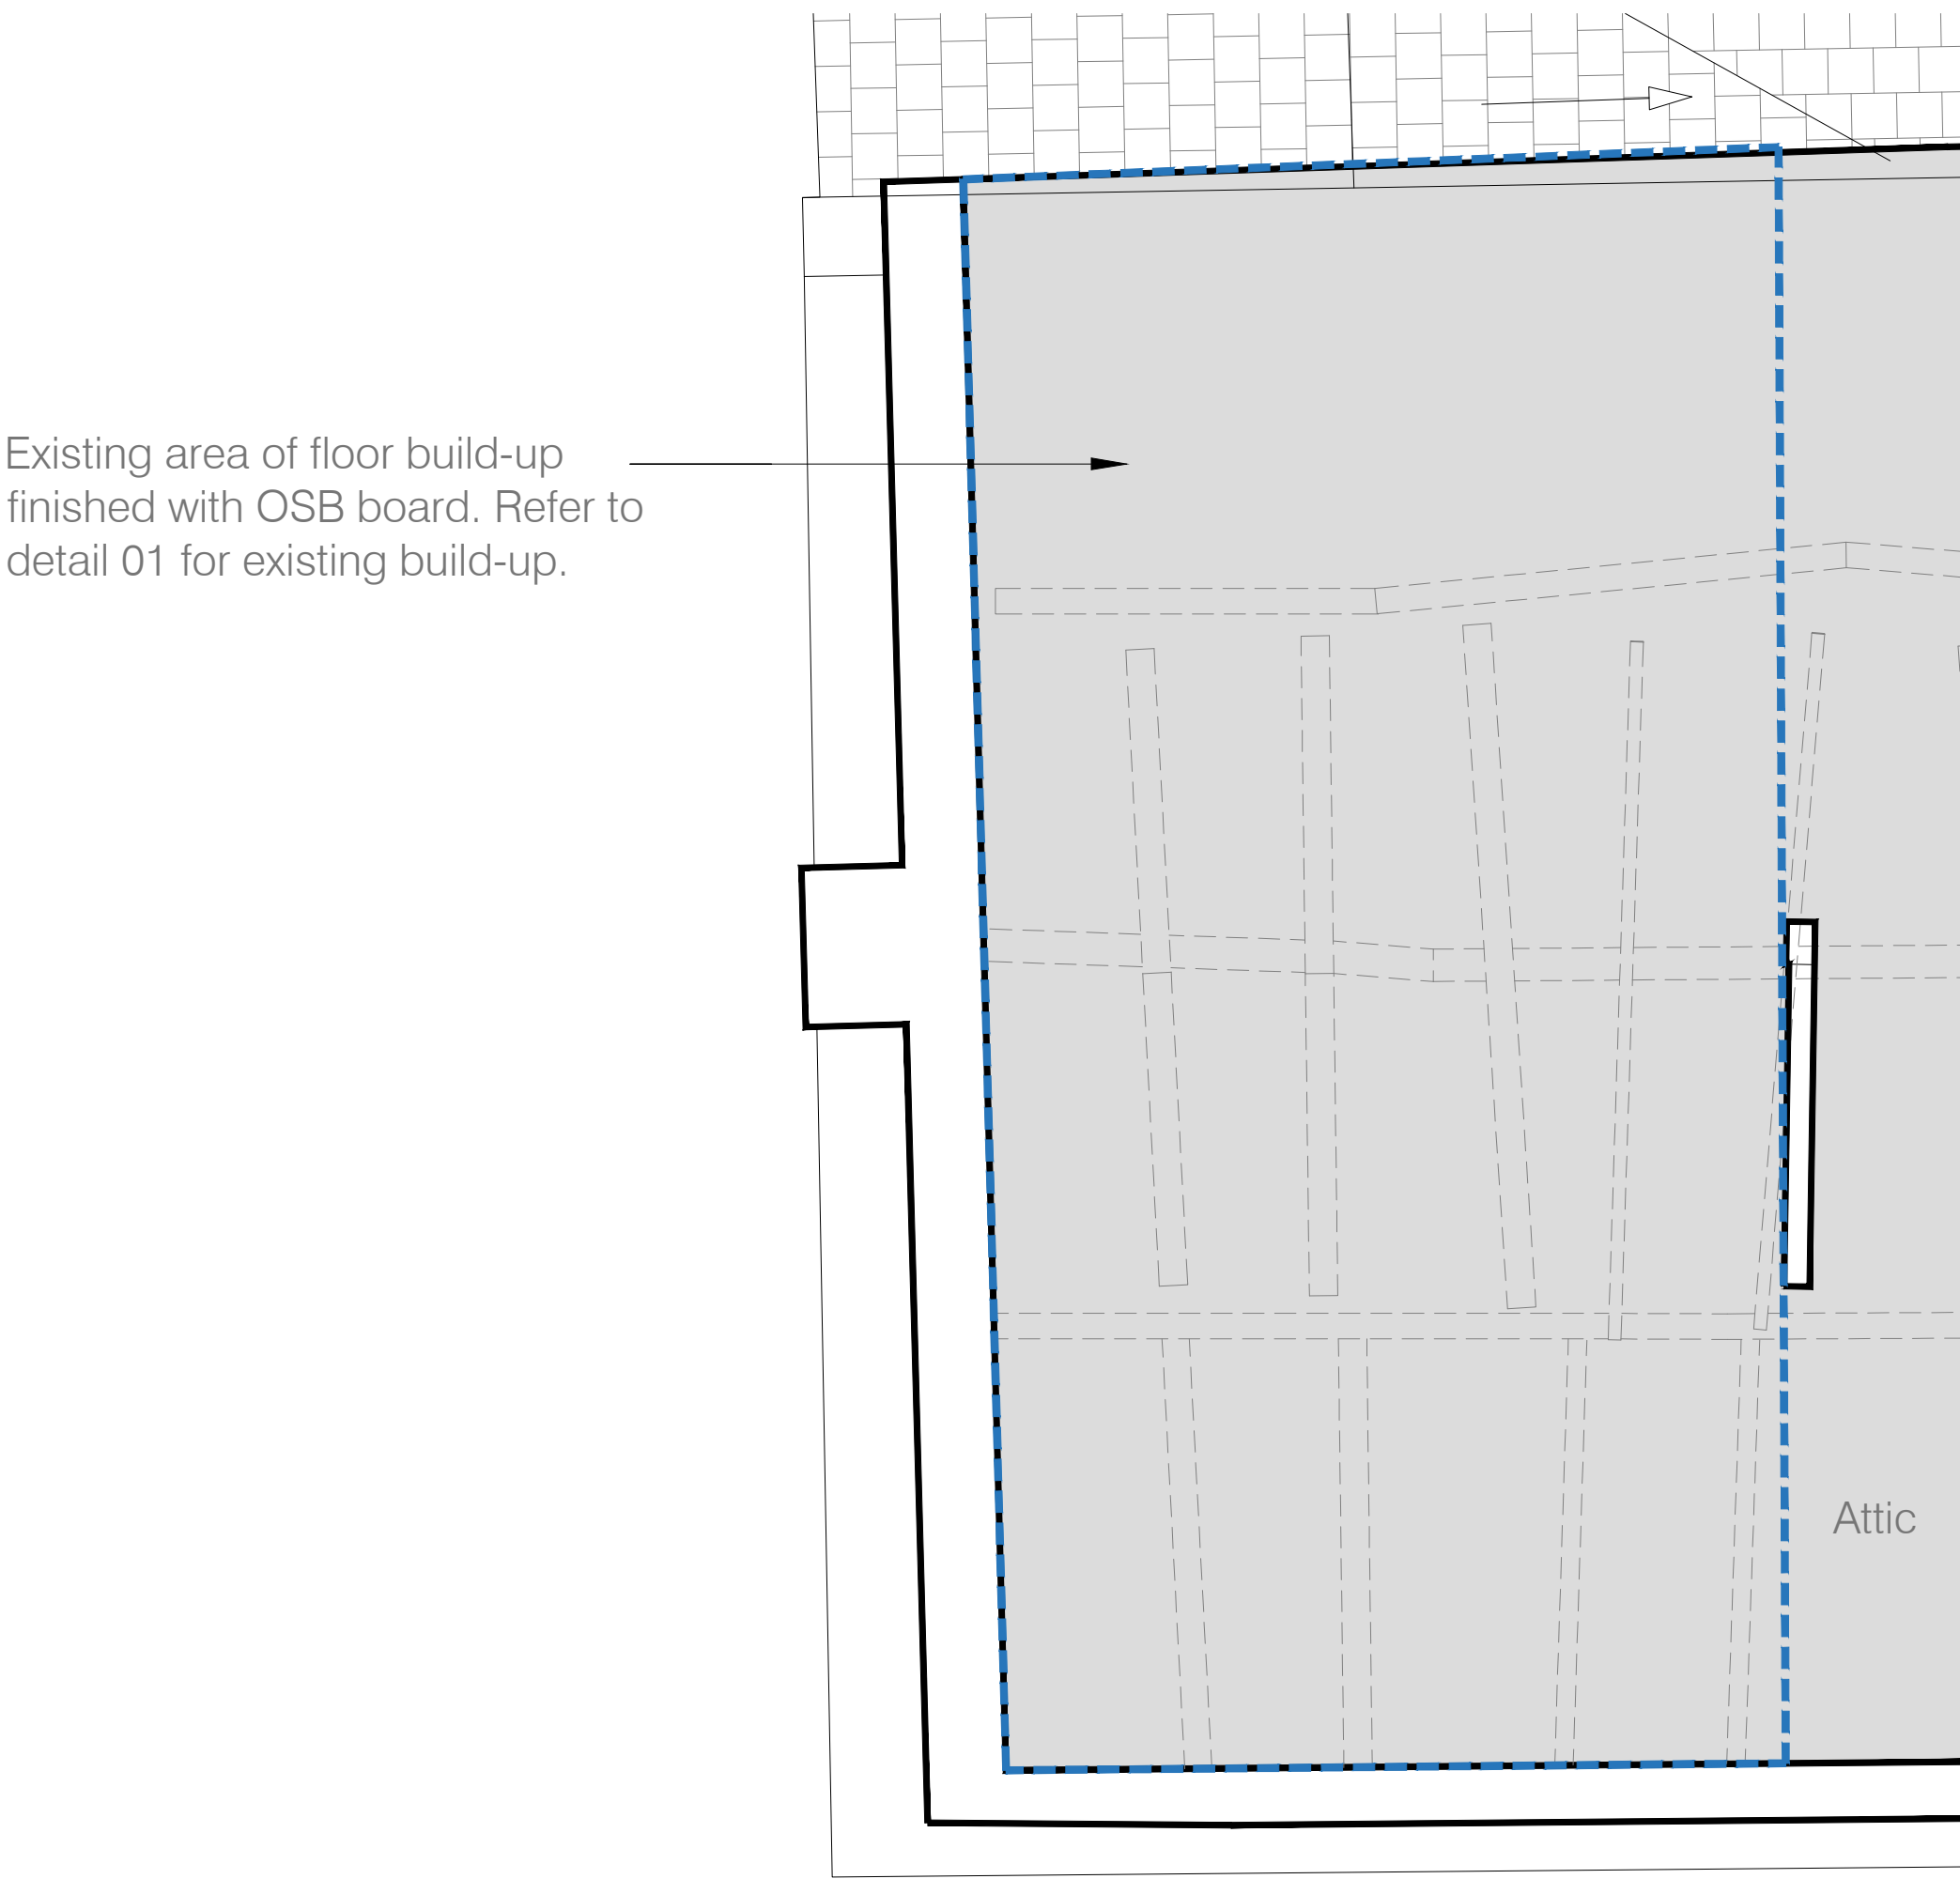

Existing area of floor build-up finished with OSB board. Refer to detail 01 for existing build-up.


Key Plan
Existing Attic Plan
Scale 1:25@A1
1:50@A3

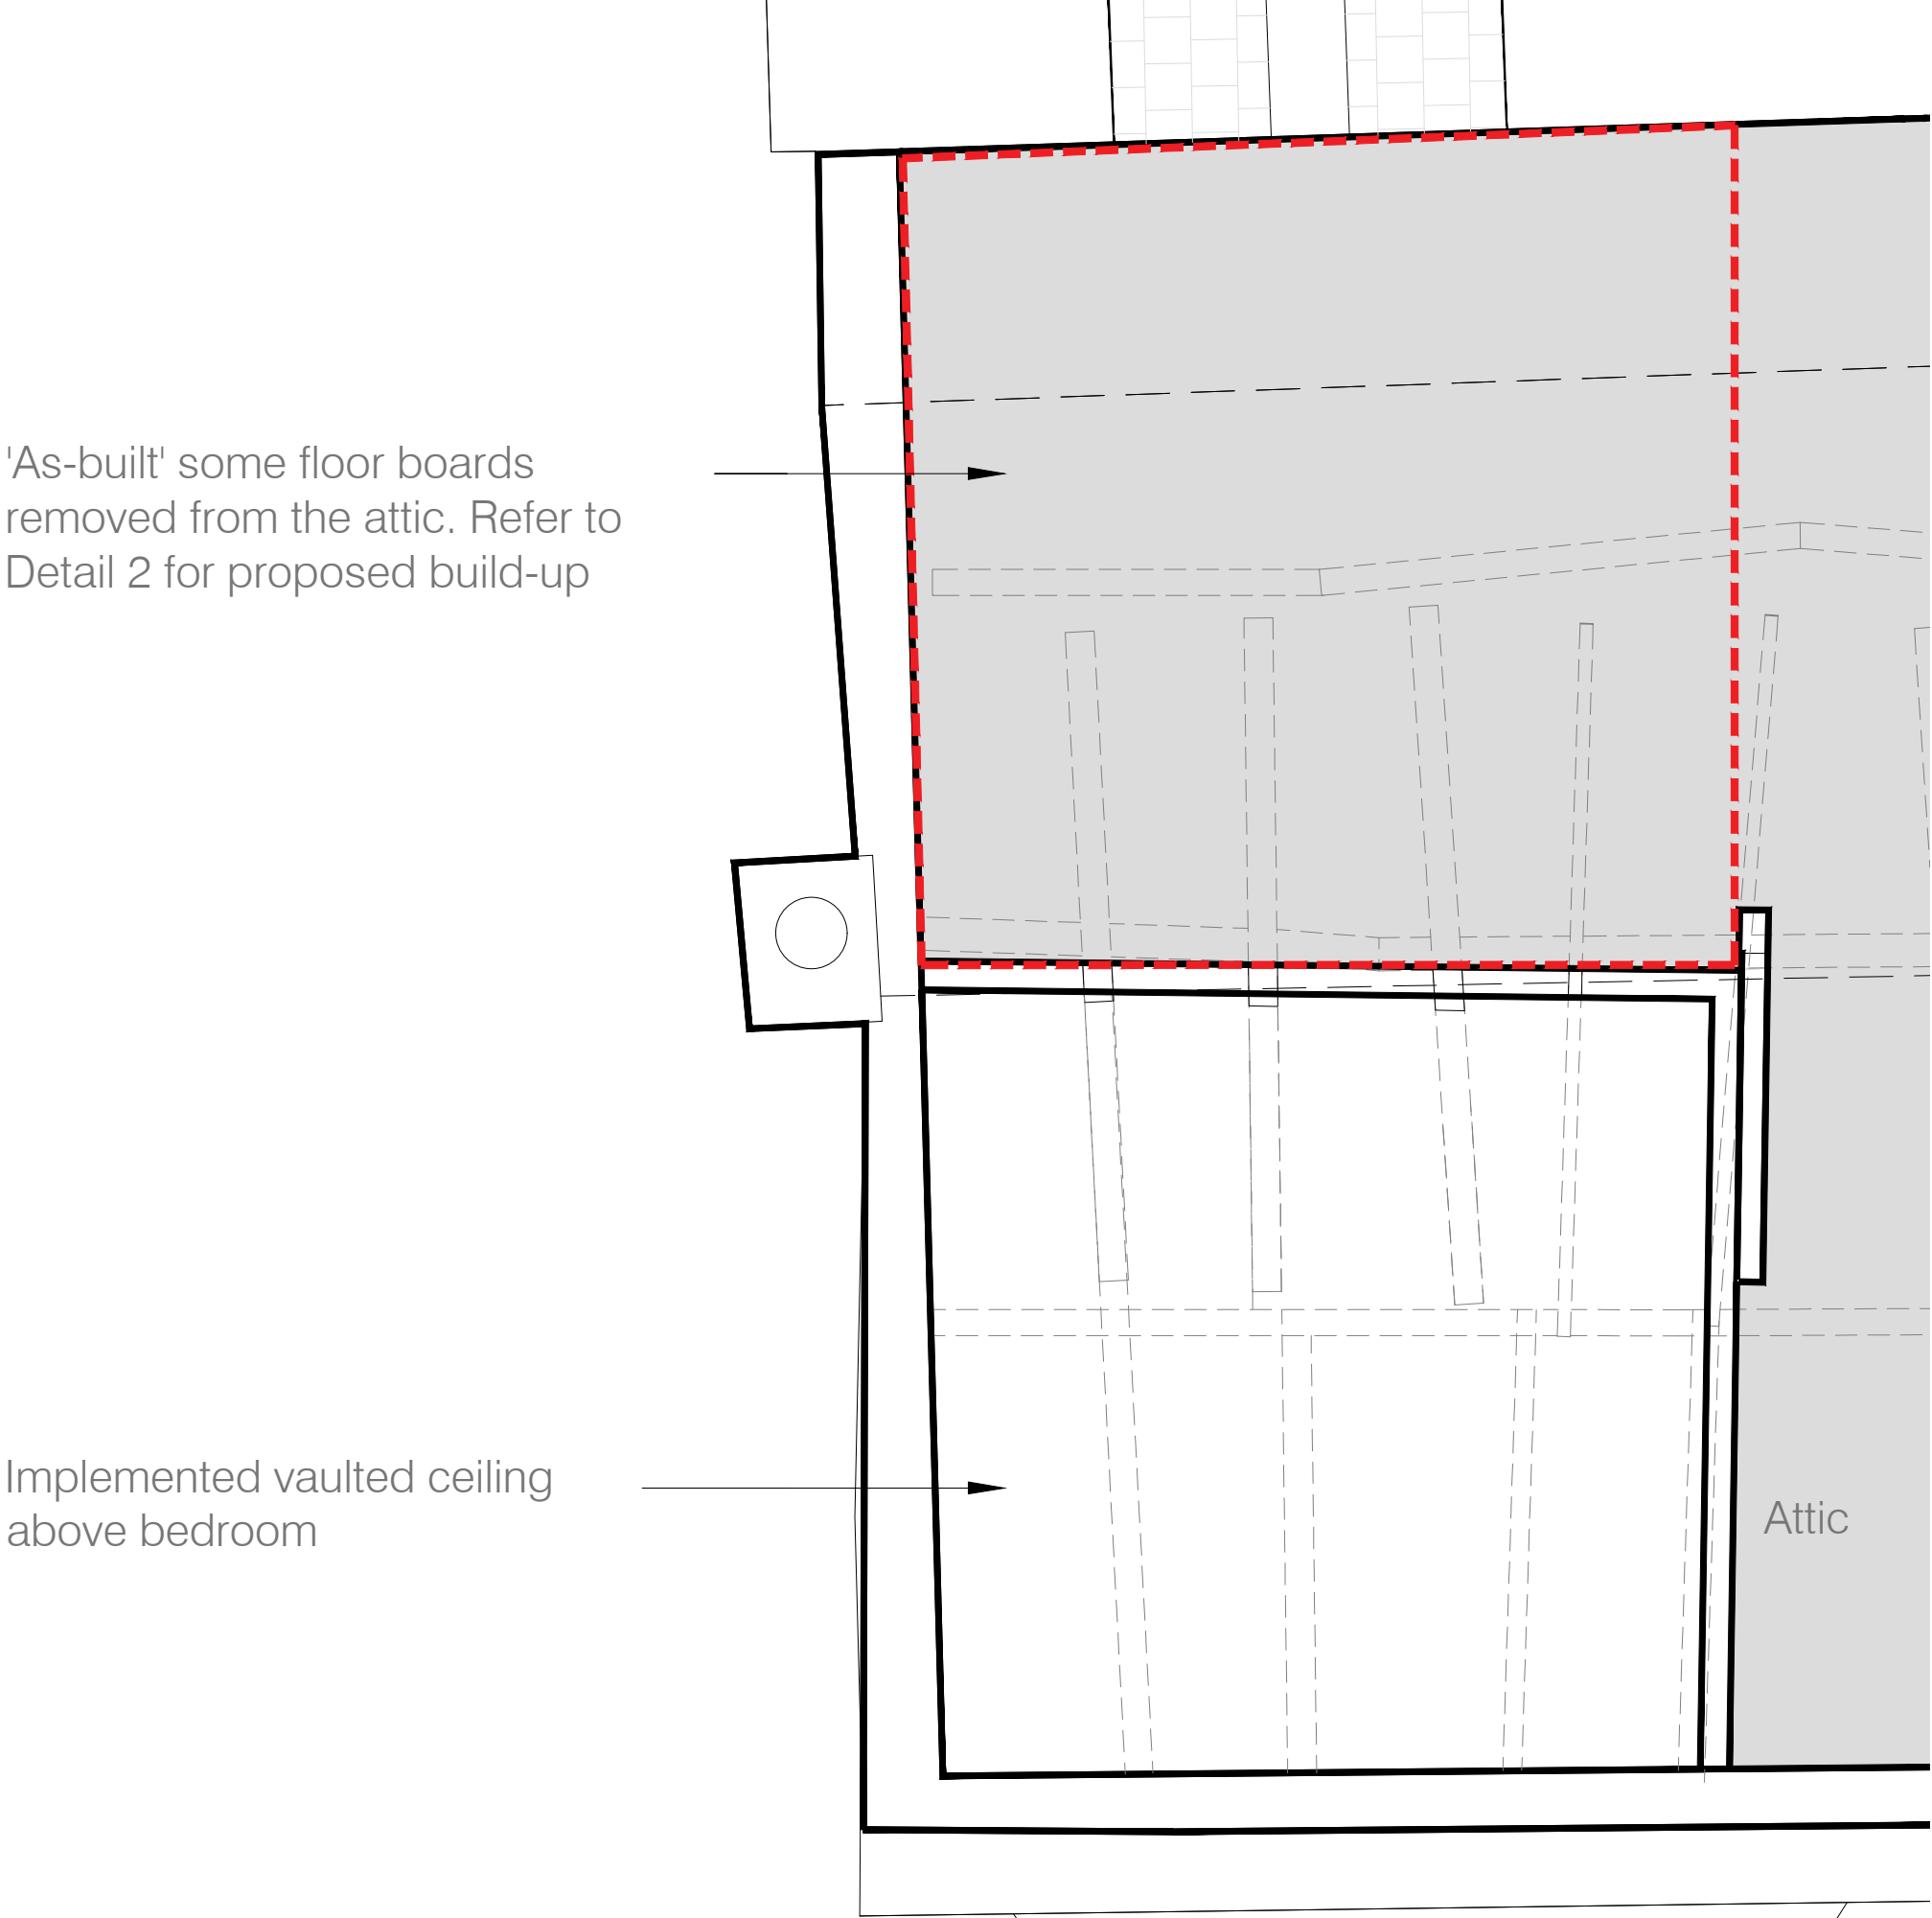

'As-built' some floor boards removed from the attic. Refer to Detail 2 for proposed build-up

Implemented vaulted ceiling above bedroom


Key Plan
'As-Built' Attic Plan
Scale 1:25@A1
1:50@A3

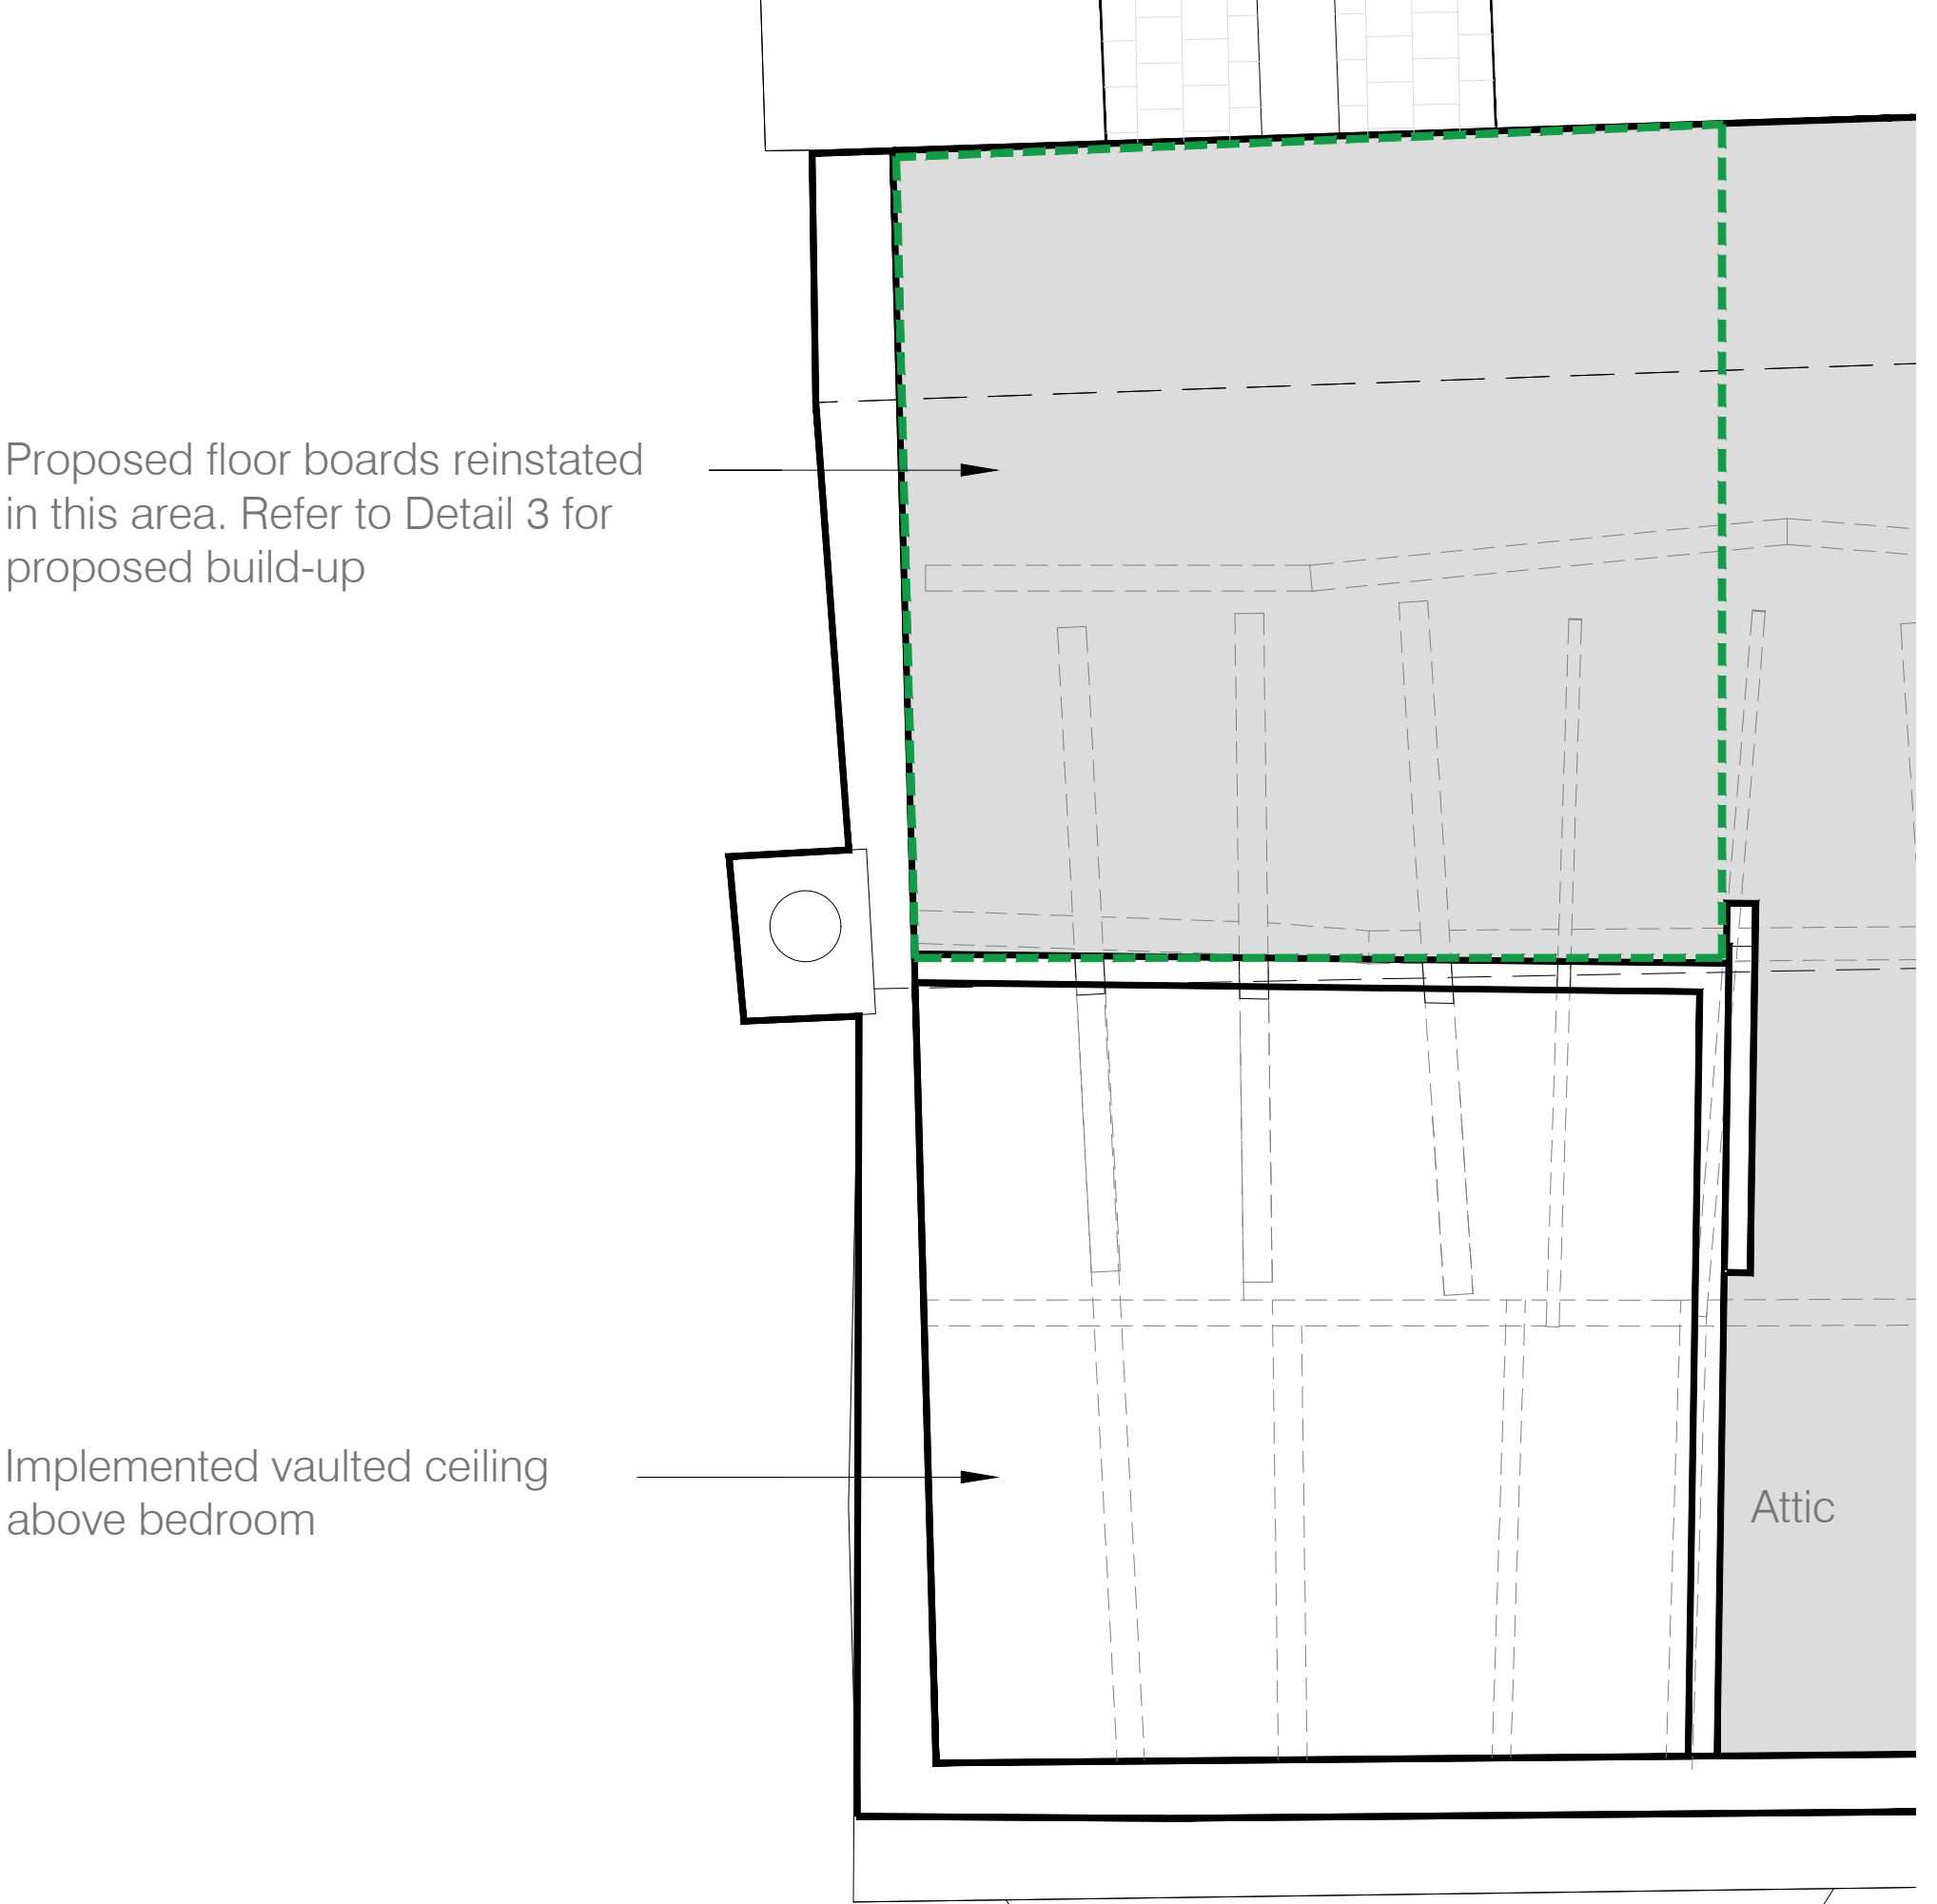

Proposed floor boards reinstated in this area. Refer to Detail 3 for proposed build-up


Implemented vaulted ceiling above bedroom

Key Plan
Proposed Attic Plan
Scale 1:25@A1
1:50@A3

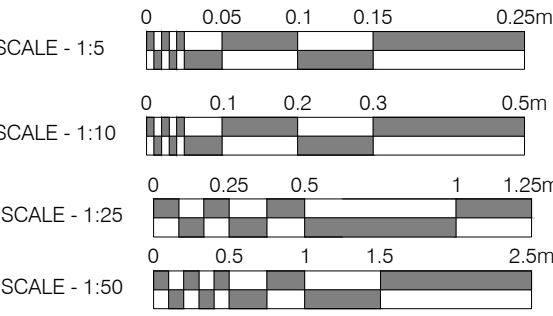

NOTE
DRAWINGS TO BE READ IN CONJUNCTION WITH SUBMITTED
DESIGN&ACCESS STATEMENT AND HERITAGE STATEMENT.

INFORMATION ON THE EXISTING AND PROPOSED MATERIALS
AND BUILD-UPS WERE OBTAINED FROM THE CONTRACTOR.

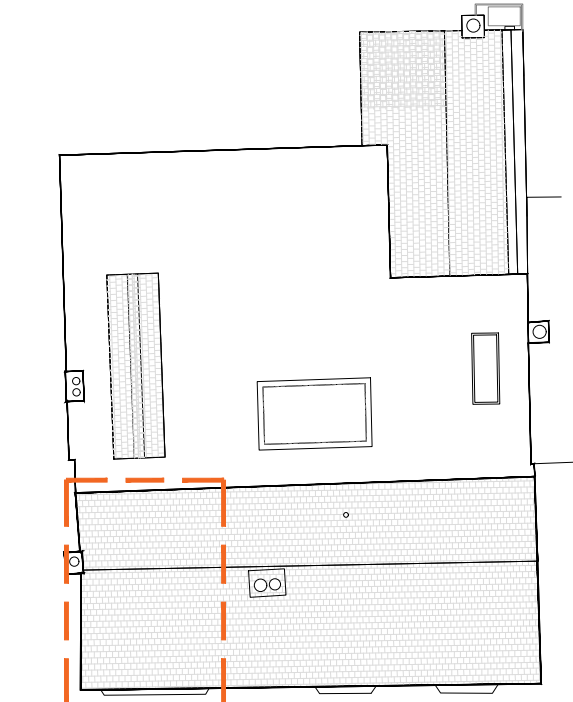

Key Plan 1:200@A1, 1:400@A3

Rev.	Comments	By:	Date:
-	-	-	-

Do not scale this drawing All dimensions must be checked on site
All rights reserved. No reproduction in any material form is permitted without consent.

LISTED BUILDING CONSENT			
Client: Mr. Simon Dougall			
Project Title: 107 High St, Lindfield, Haywards Heath, West Sussex, RH16 2HR			
Drawing Title: Detail Drawings: Attic Floor Boards			
Scale:	Date:	Drawn:	Checked:
1:25@A1 1:5@A1 1:50@A3 1:10@A3	Sep 25	KN	KW

kyson		
Studio		
28 Scrutton Street London UK EC2A 4RP		
T: +44(0) 20 7247 2462 E: enquiries@kyson.co.uk W: www.kyson.co.uk		
Project No.:	Drawing No.:	Revision:
900-25	5029	-