



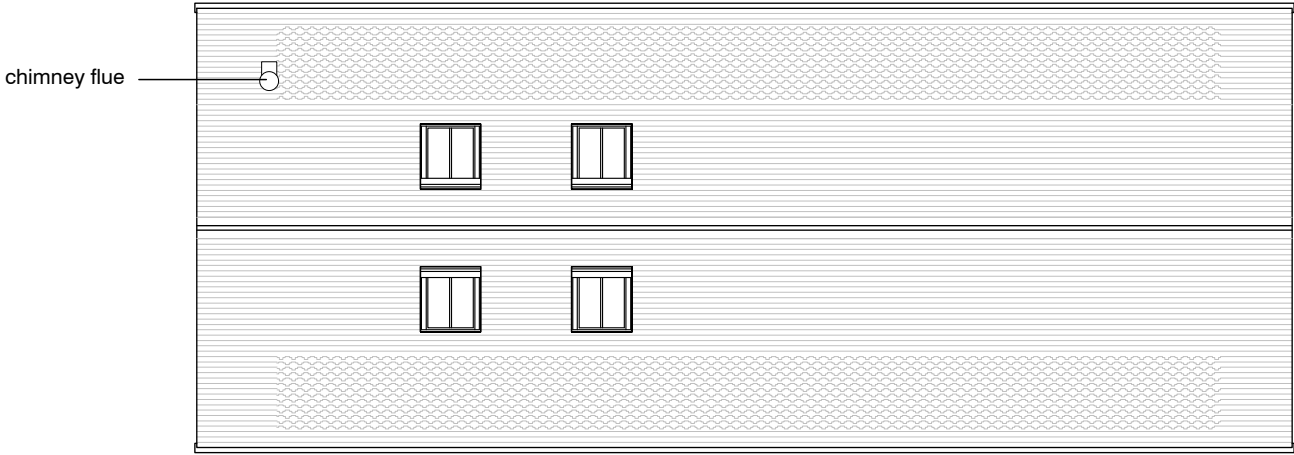

Roof

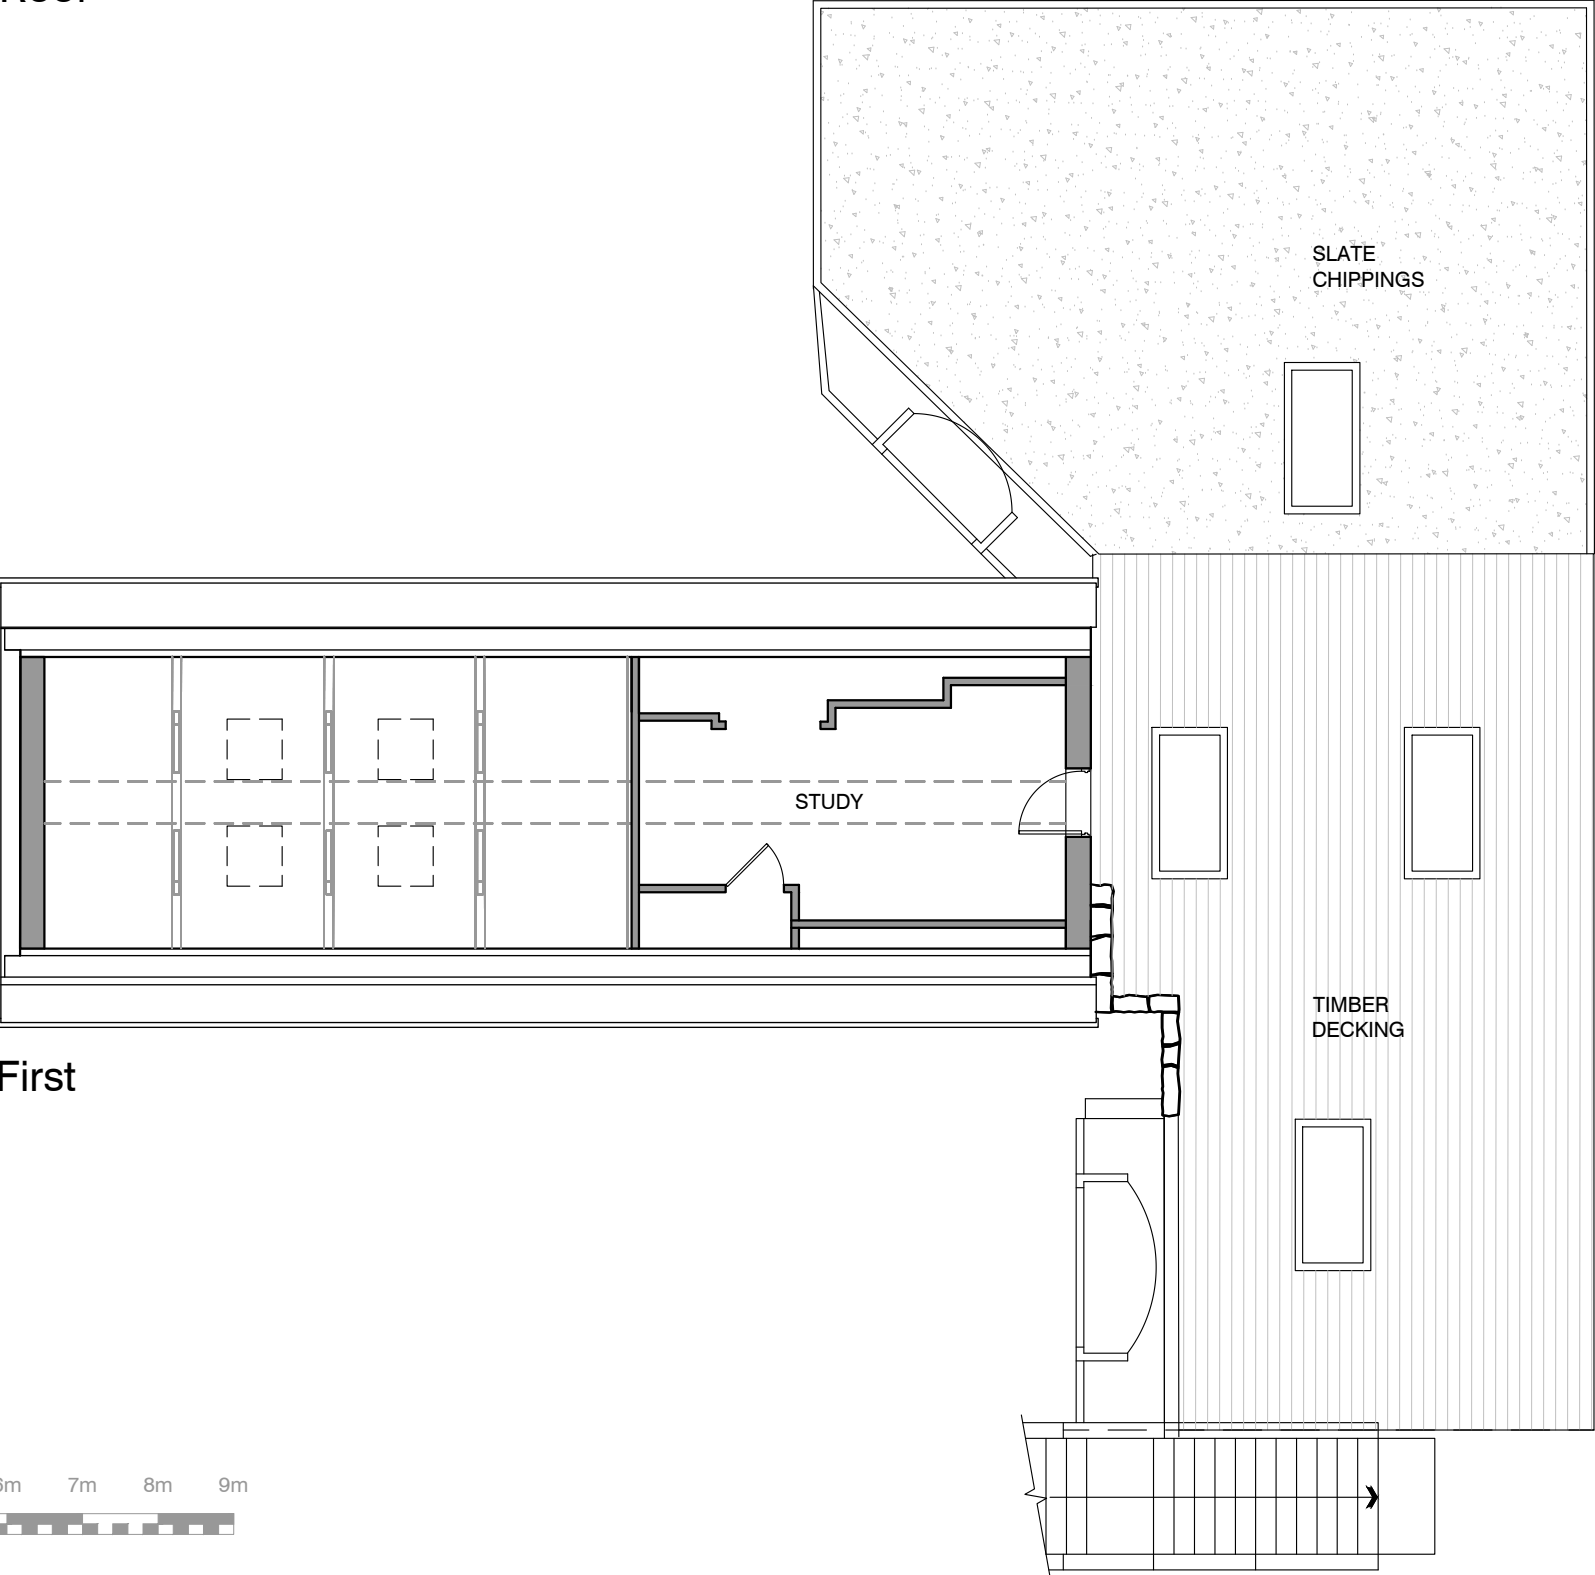

First

Date	Revision
L	
K	
J	
I	
H	
G	
F	
E	
D	
C	
B	
A	

Client	MR & MRS COOPER		
Project	BROADHURST STABLES BROADHURST MANOR ROAD HORSTED KEYNES		
Title	FIRST FLOOR AND ROOF PLAN AS BUILT		
Date	Scales	Dwg. No.	Rev.
09/25	1:100 @ A3	805/04	