


Notes

This drawing is subject to copyright.
Do not scale from this drawing.


Based on drawing by Patrick Parsons
Drawing number NOR-PPC-S1-XX-DR-C-3021-3024

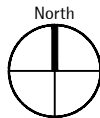

LEGEND

- Red Line
- Existing tree
- Existing shrubs
- Existing PRow track
- New PRow alignment - 3m wide where possible
- Path Construction Type 1
- Path Construction Type 2
- Path Construction Type 3
- Area within 15m of ancient woodland (proposed no dig area)
- Post & Rail Fencing

Section 1

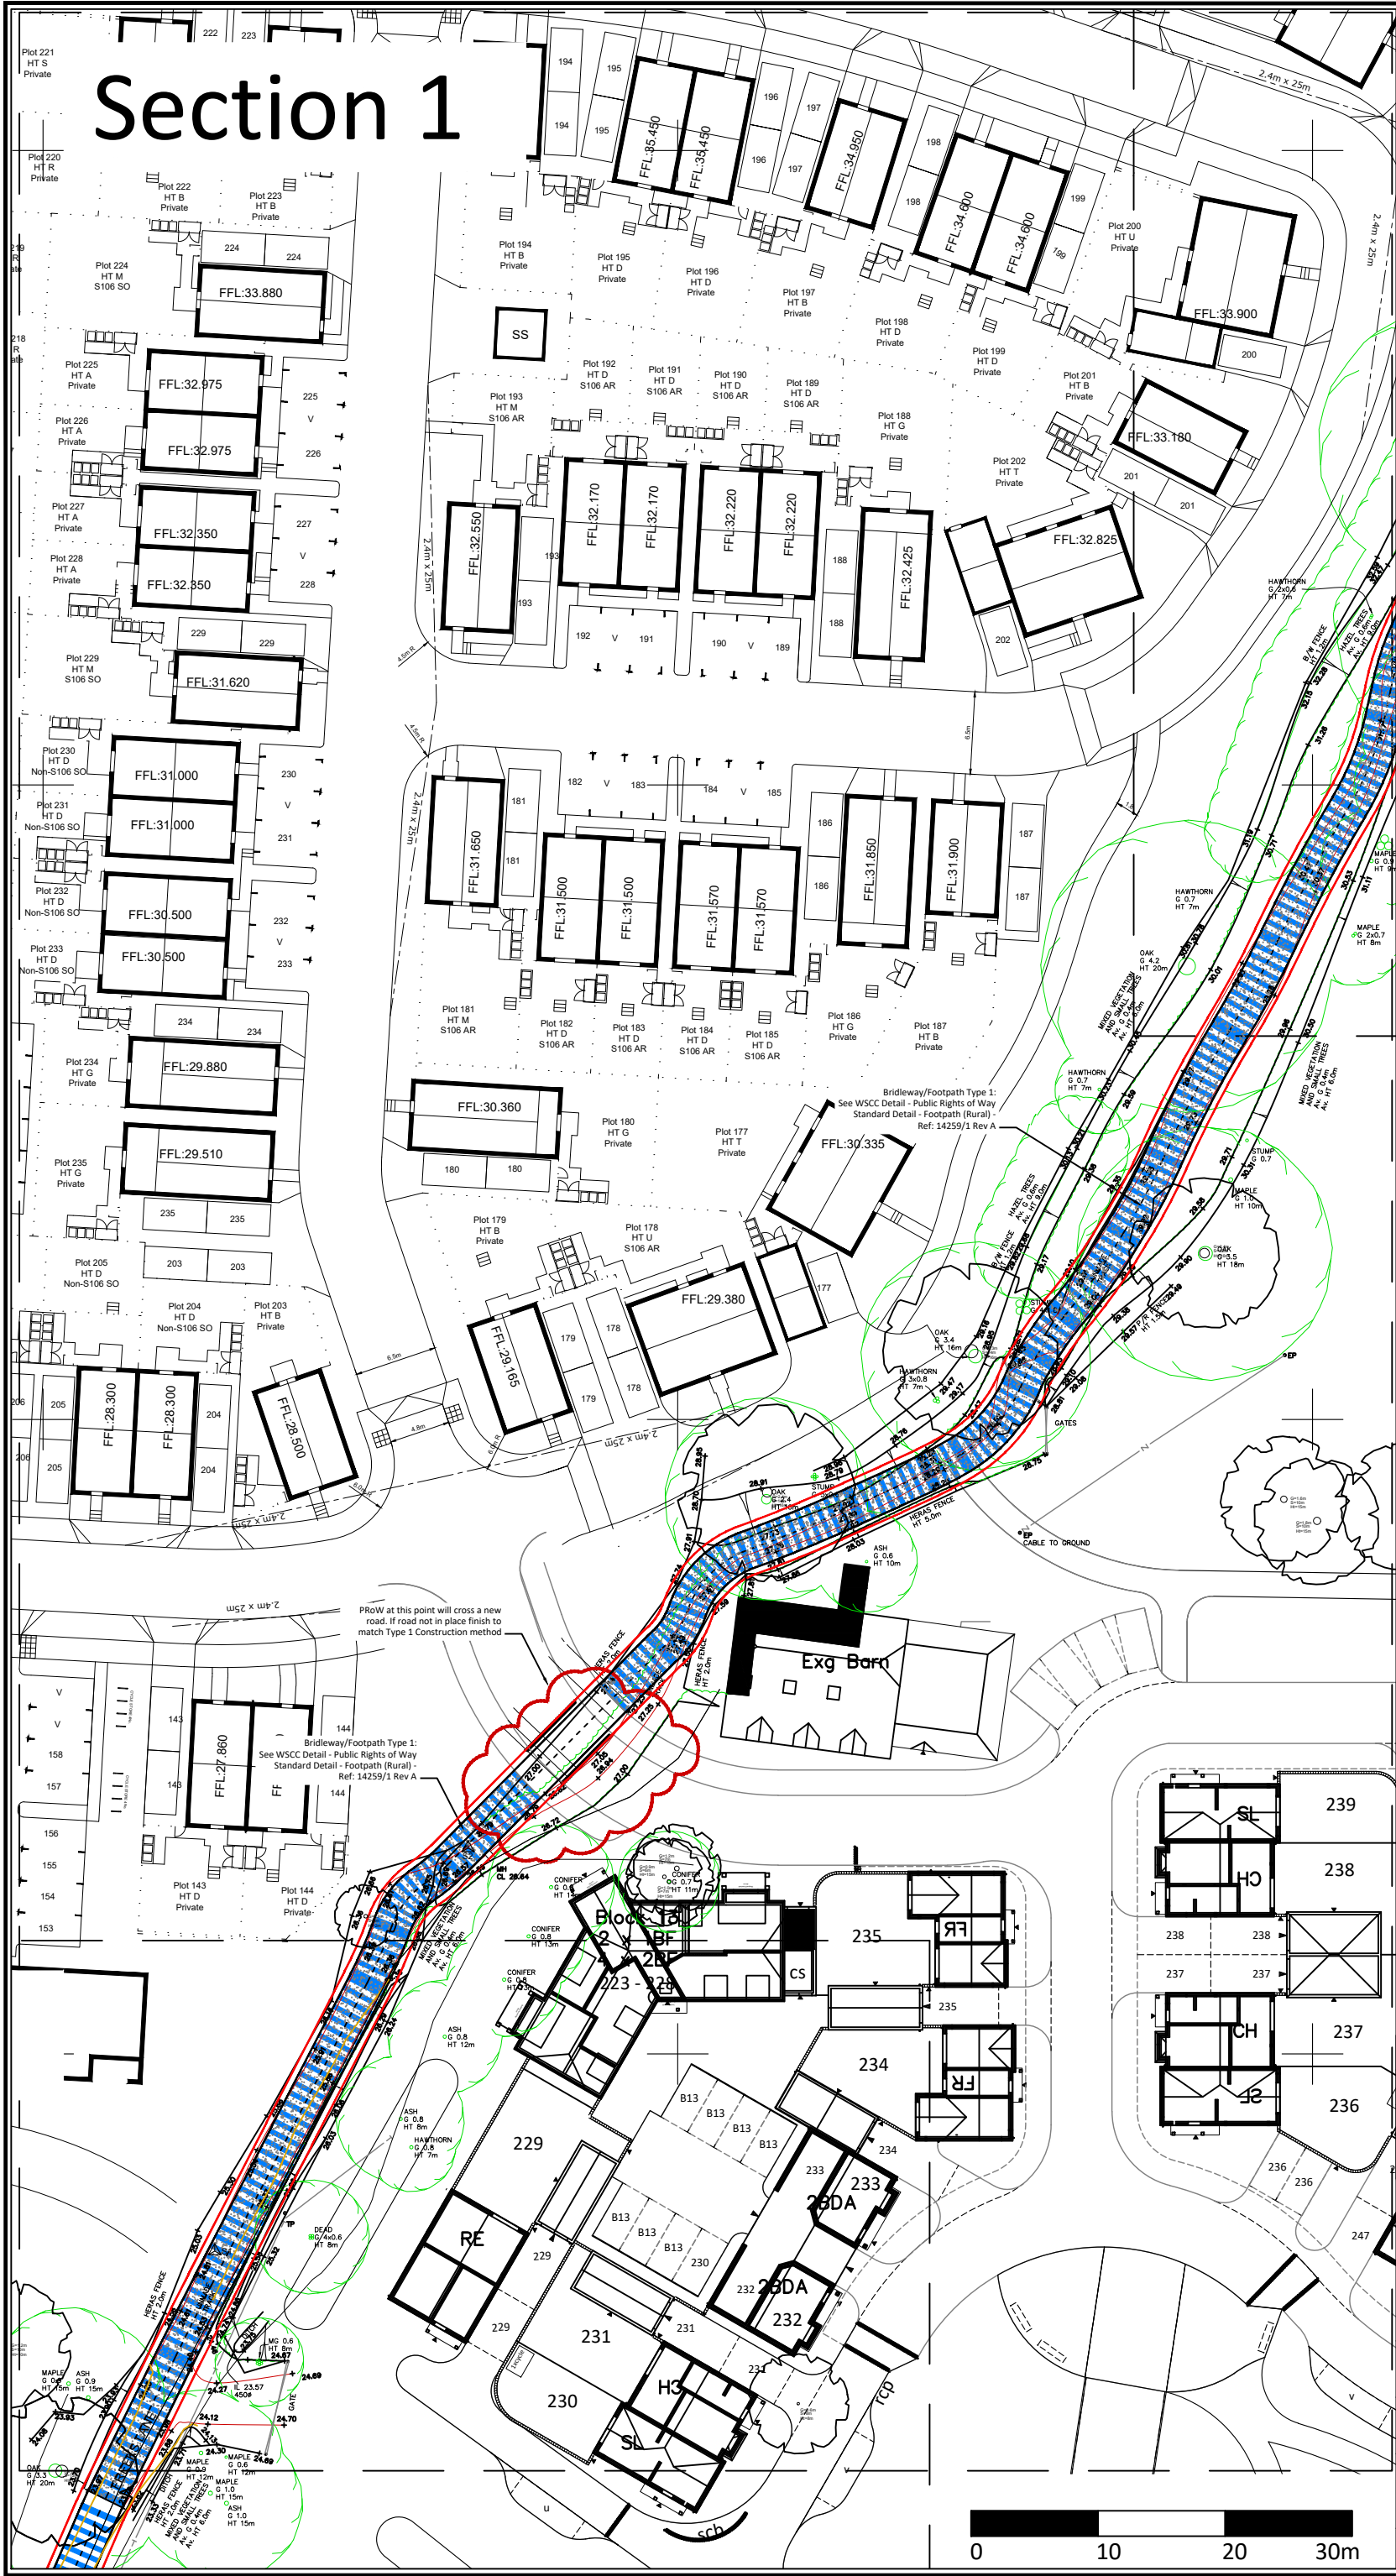

P02	Red Line Update	06/12/24	JH	JH
P01	Planning Issue	28/06/24	JH	JH
P00.02	Footpath width change and passing points added	21/05/24	JH	JH
Rev	Description	Date	Drawn	Checked

Drawing Status
PLANNING ISSUE

Allen Pyke LONDON • BATH • CAMBRIDGE
T 020 8549 3434 T 01225 431 283 T 01223 358 055
www.allenpyke.co.uk
A registered practice of the Landscape Institute

Client: Bellway South London Scale: 1:500@A3

Project: Northern Arc Burgess Hill Project No: 3034

Drawing Title: Green Link Path Date: 14/03/2024
By/Chk: CS/JH

Drawing Number: 3034-APA-ZZ-XX-SK-L-0015 Revision: P02