




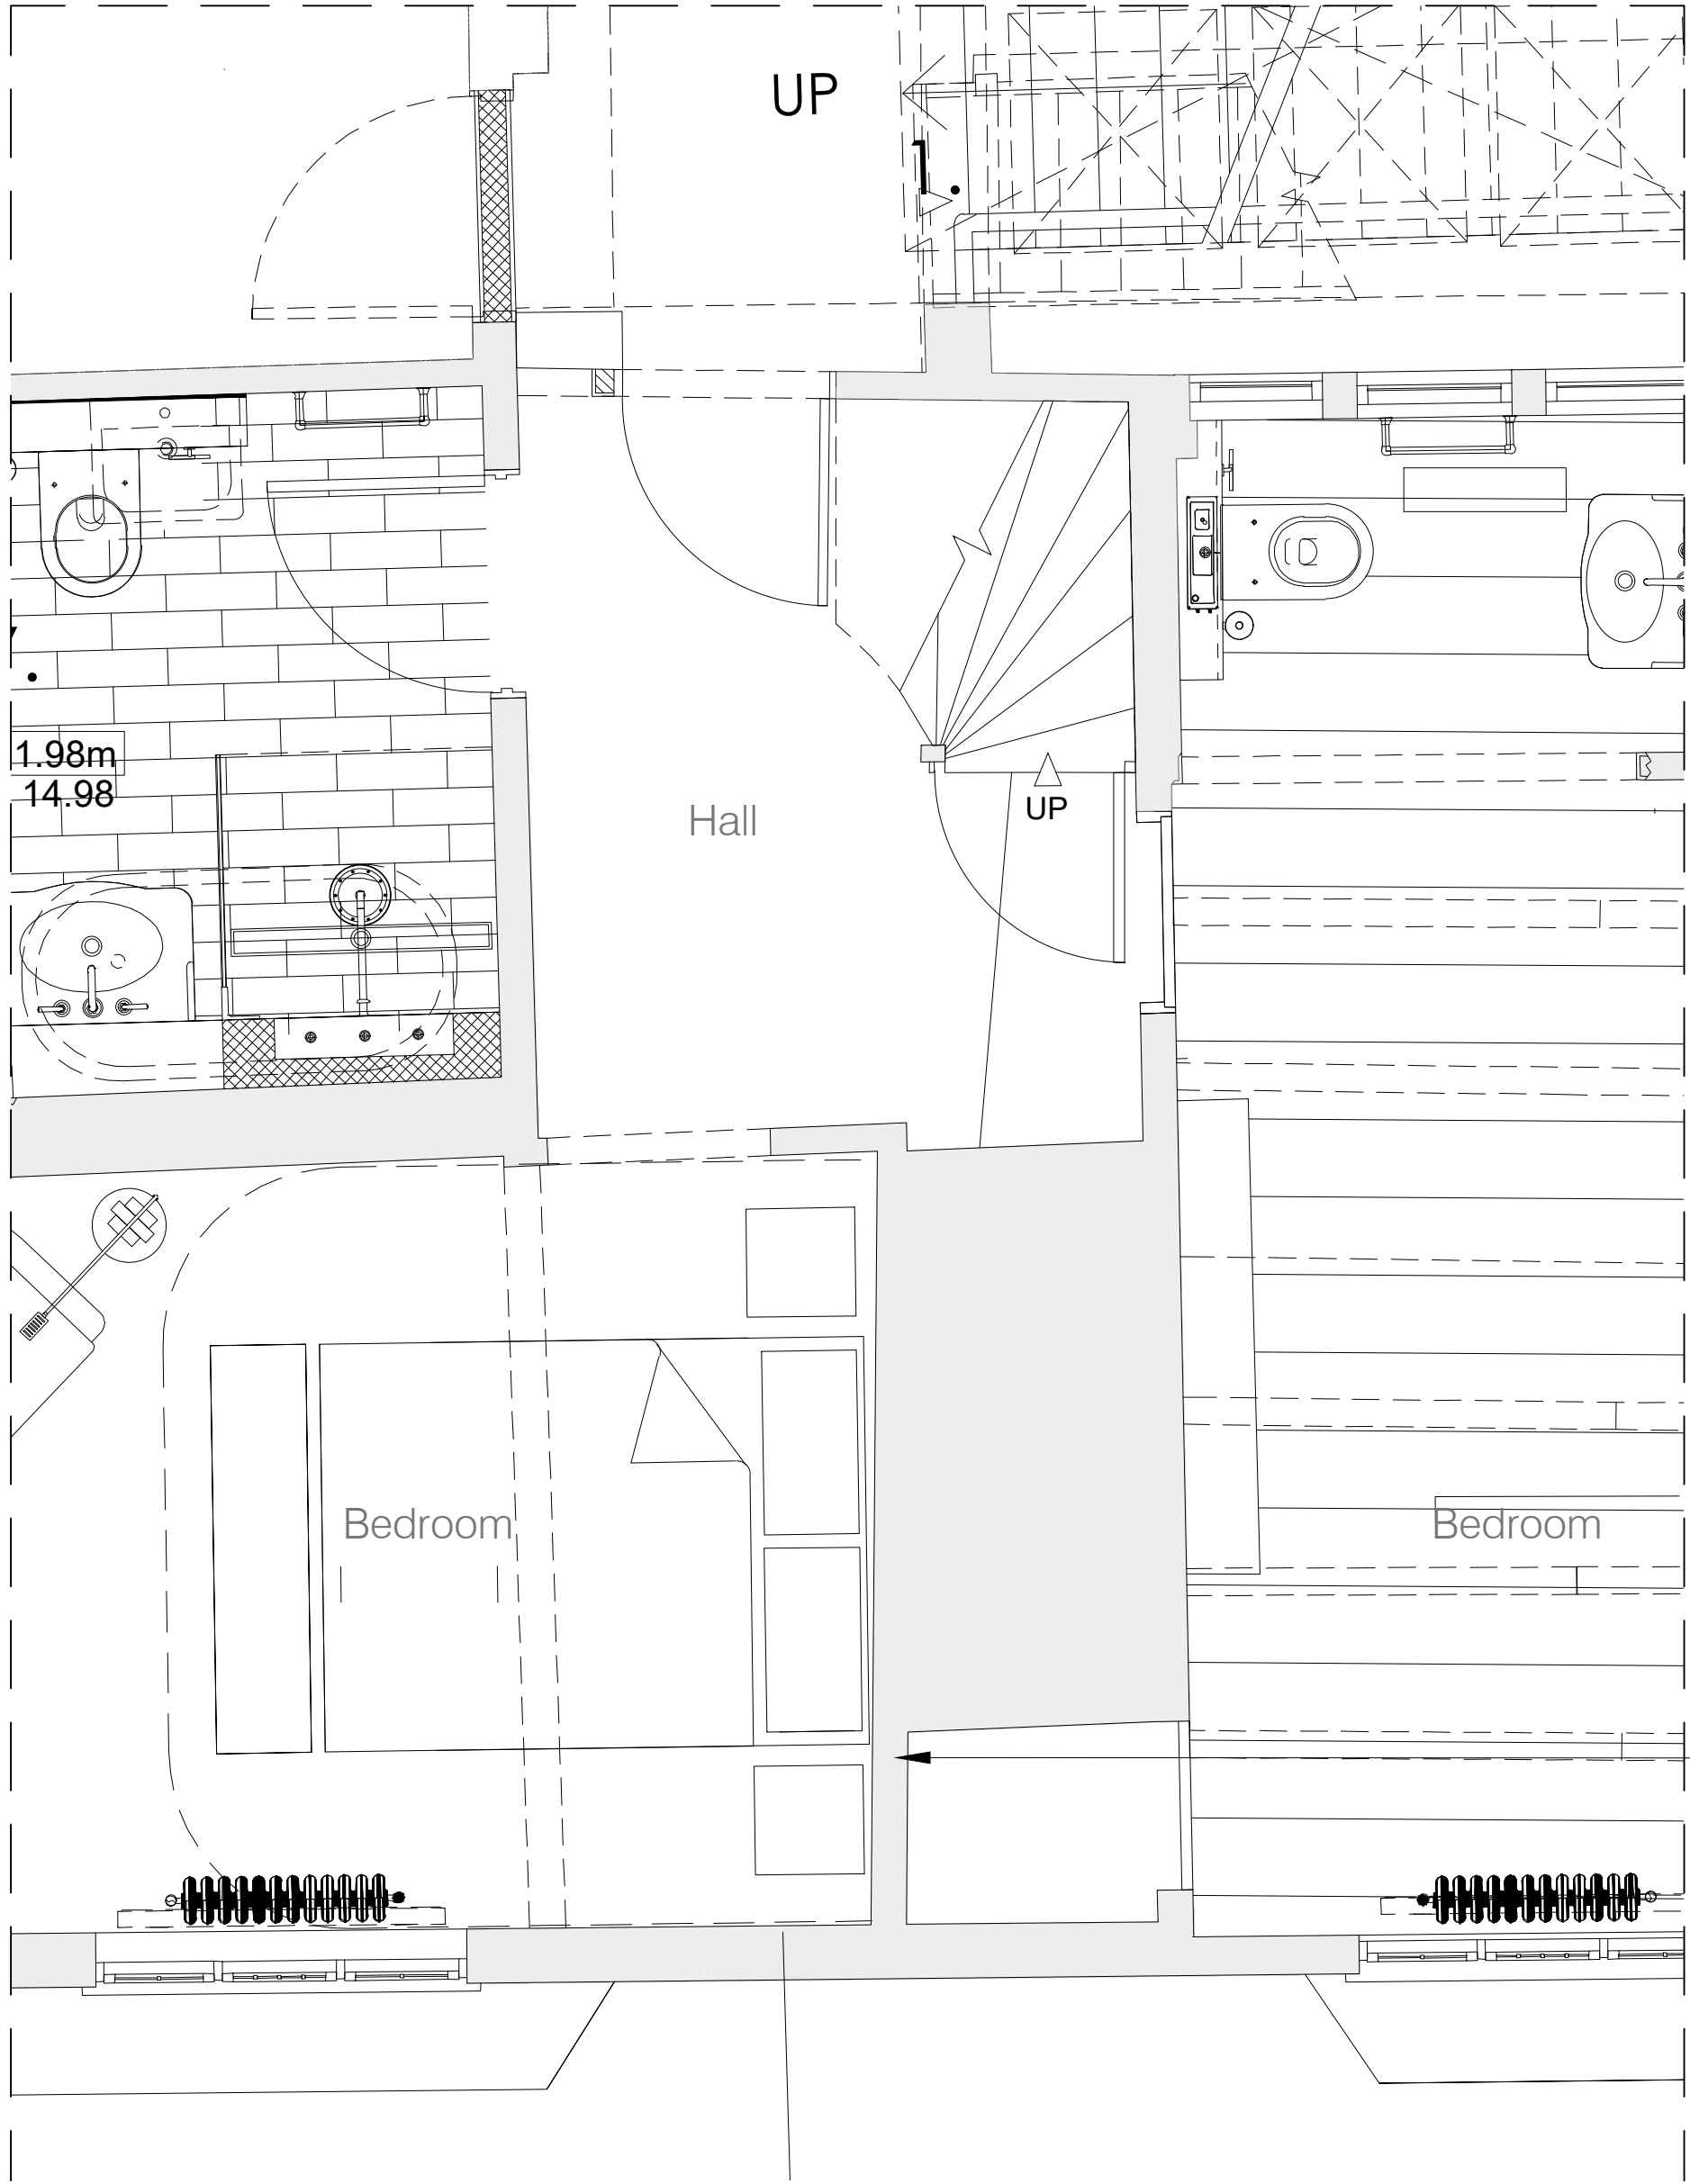

Approved Scheme First Floor Plan
Scale 1:25@A1
1:50@A3

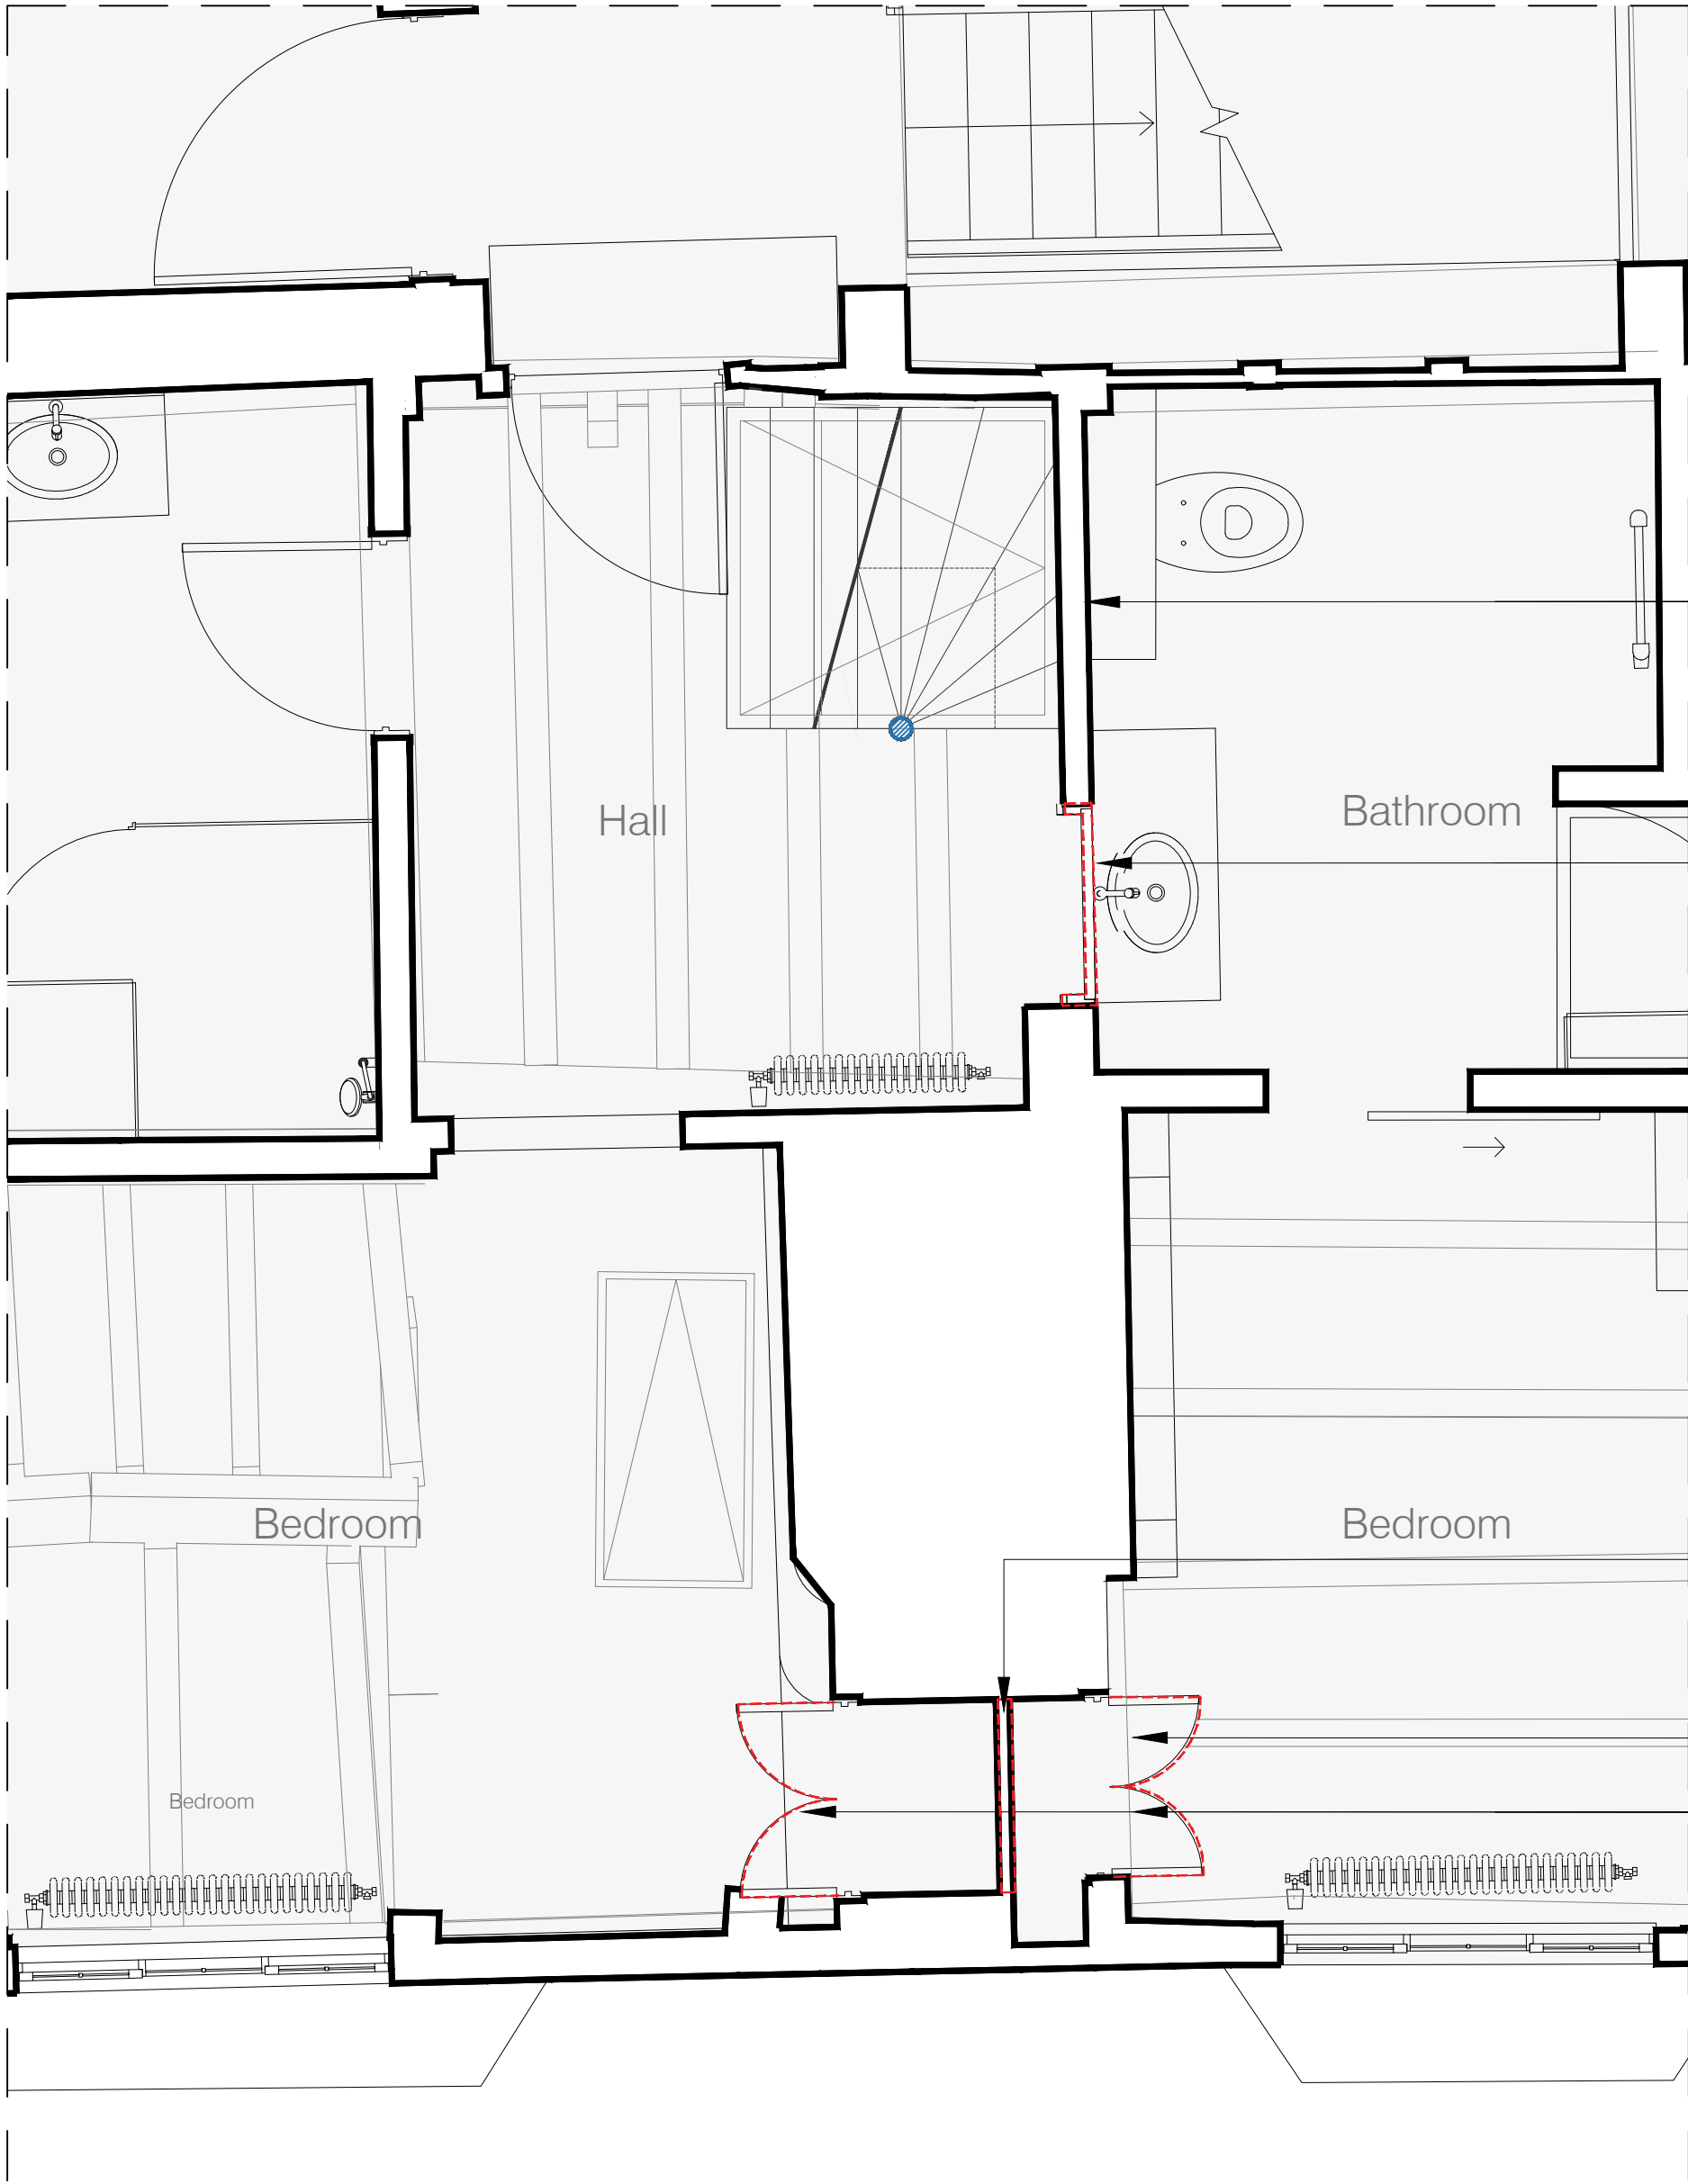

'As Built' / Proposed Scheme First Floor Plan
Scale 1:25@A1
1:50@A3

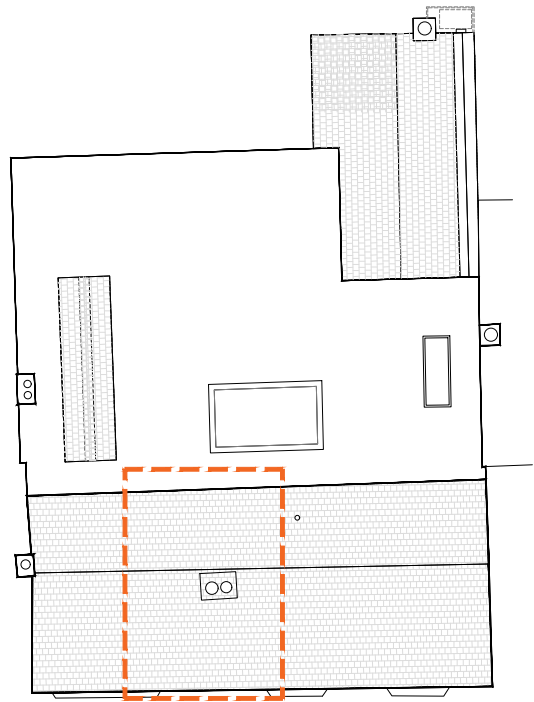

KEY PLAN
Scale 1:200@A1
1:400@A3



Fitted Wardrobe, view from North bedroom



Existing timber door to be re-instated and fixed shut

KEY:
Highlighted difference between Approved Scheme and 'As-Built'/Proposed Scheme

NOTE
DRAWINGS TO BE READ IN CONJUNCTION WITH SUBMITTED DESIGN&ACCESS STATEMENT AND HERITAGE STATEMENT MATERIALS INSTALLED IN ACCORDANCE WITH THOSE OUTLINED IN CONDITION #9 OF APPROVAL DM/23/1605

LISTED BUILDING
CONSENT

kyson^{studio}

Rev. Comments. By. Date.

Client:
Mr. Simon Dougall

28 Scrutton Street
London
UK
EC2A 4RP
T: +44(0) 20 7247 2462
E: enquiries@kyson.co.uk
W: www.kyson.co.uk

Project Title:
107 High St, Lindfield, Haywards Heath, West Sussex, RH16 2HR
Drawing Title:
Fitted Wardrobes Joinery & Re-instated Door

Scale: 1:25@A1 1:50@A3
Date: Apr 25
Drawn: KN
Checked: KW

Project No.: 900-25
Drawing No.: 5013
Revision: A

Do not scale this drawing. All dimensions must be checked on site. All rights reserved. No reproduction in any material form is permitted without consent.

