


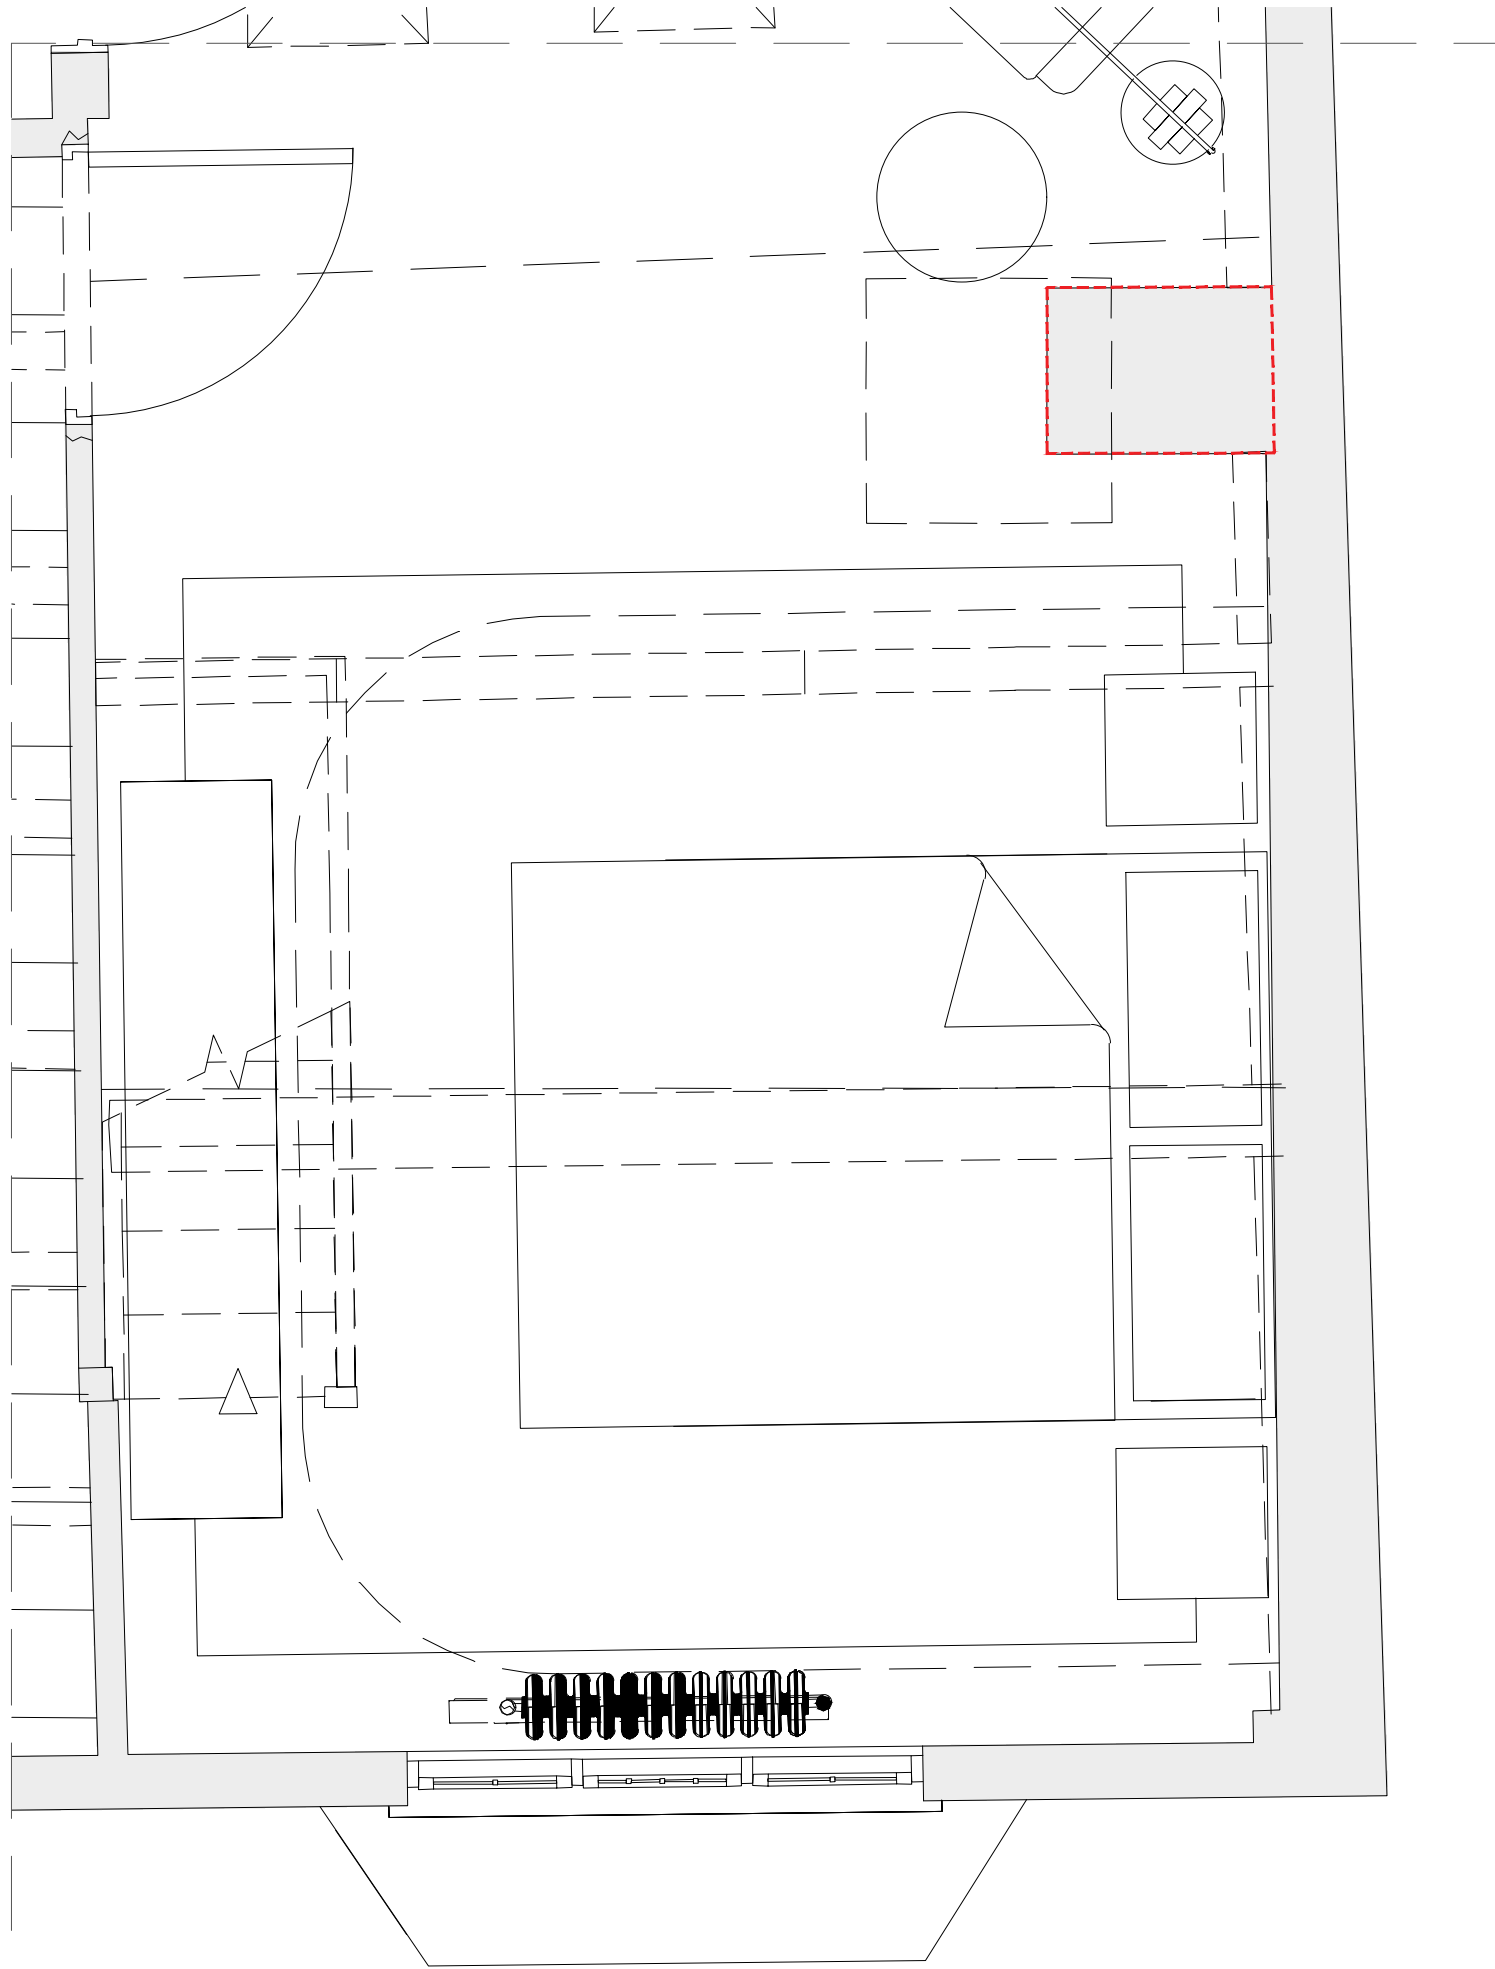


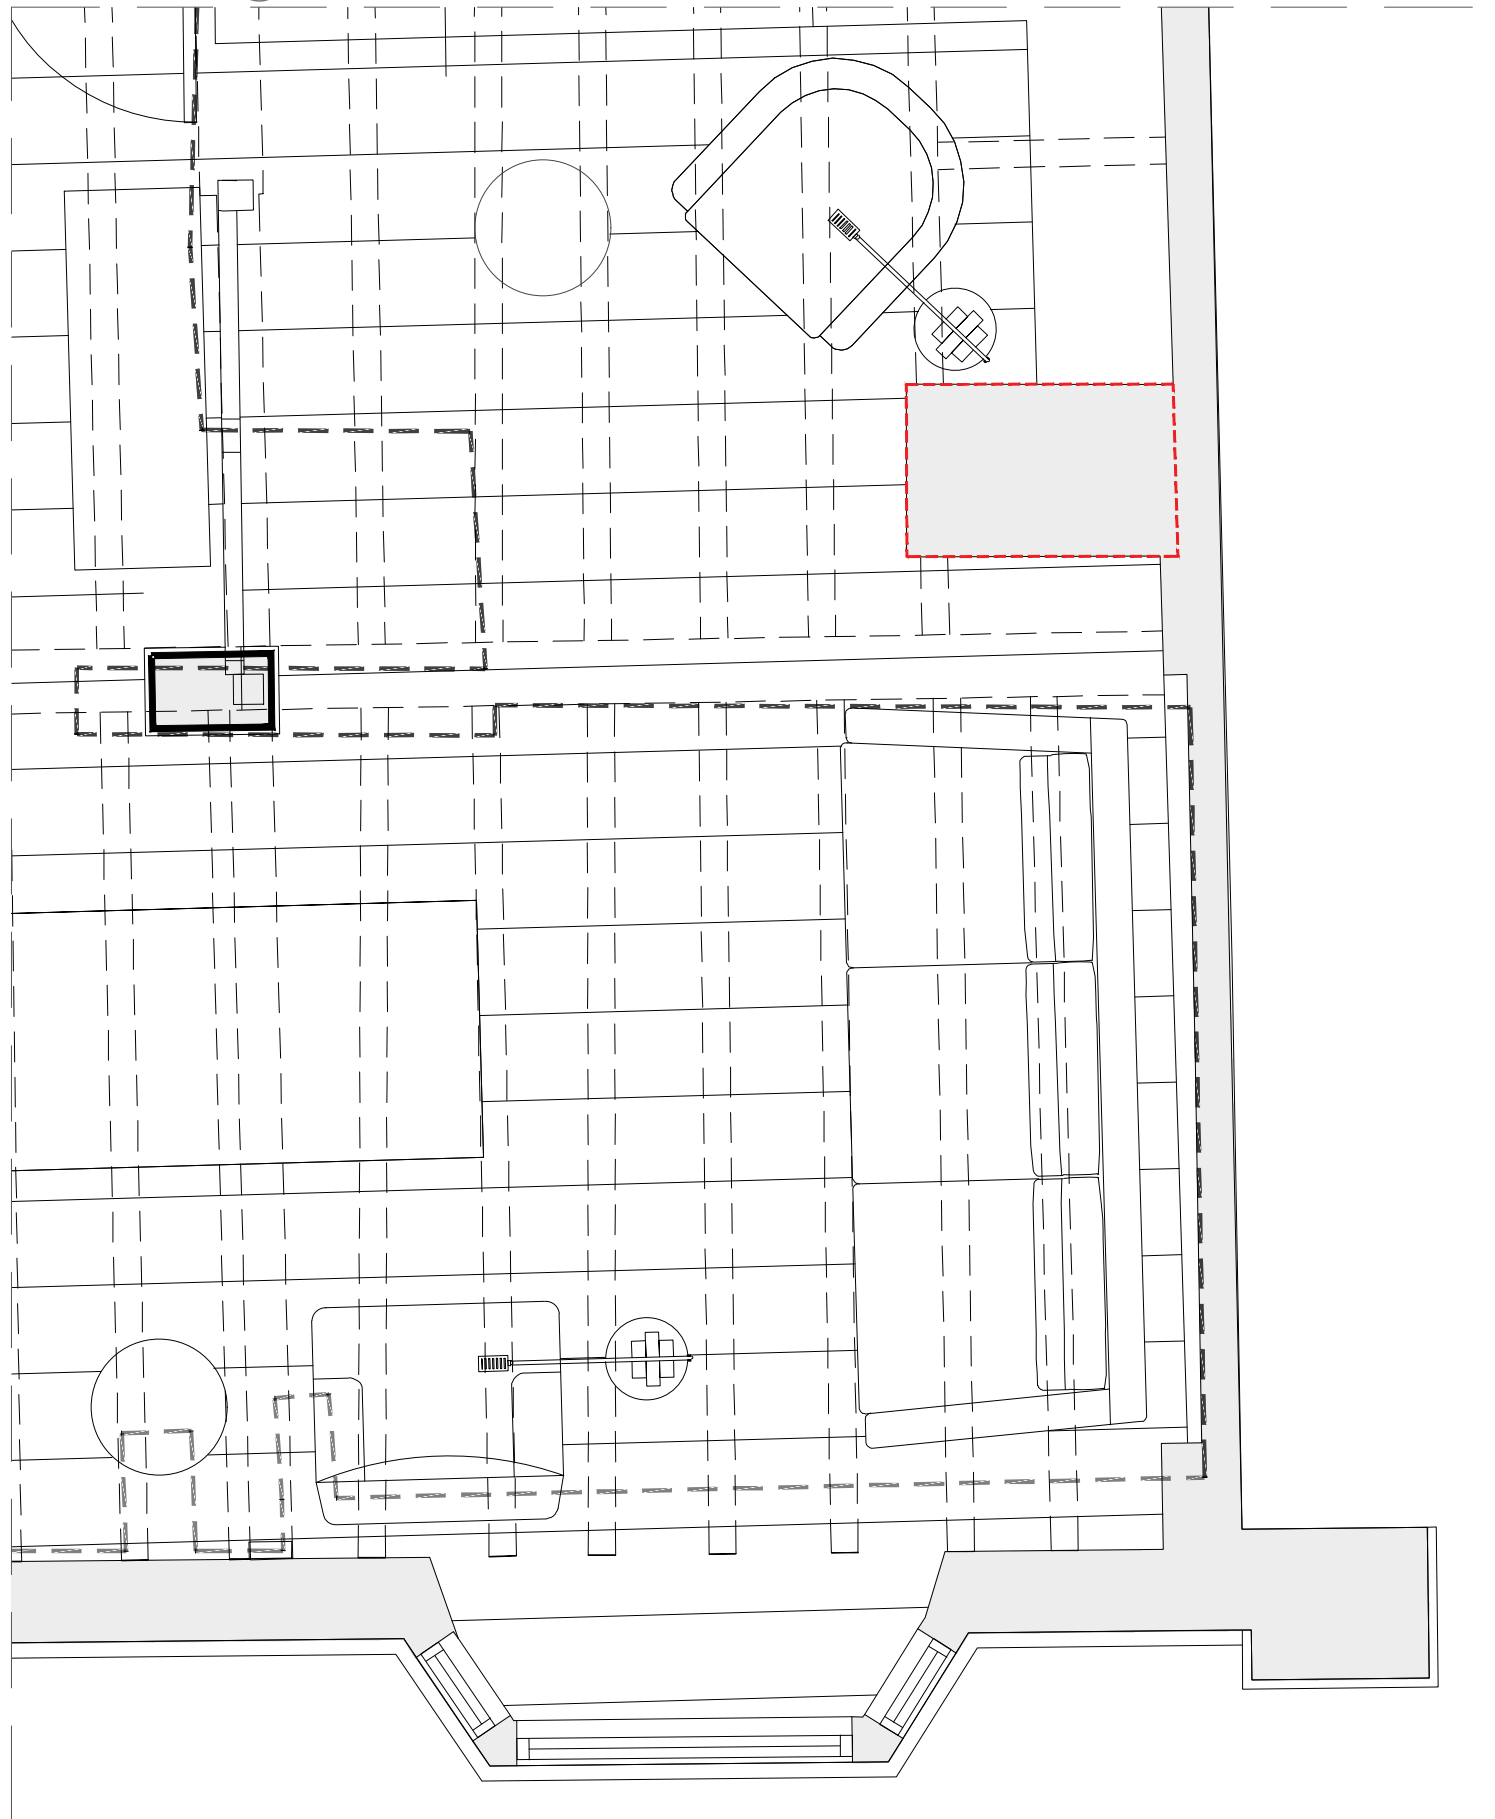


Approved Scheme First Floor Plan
Scale 1:25@A1
1:50@A3

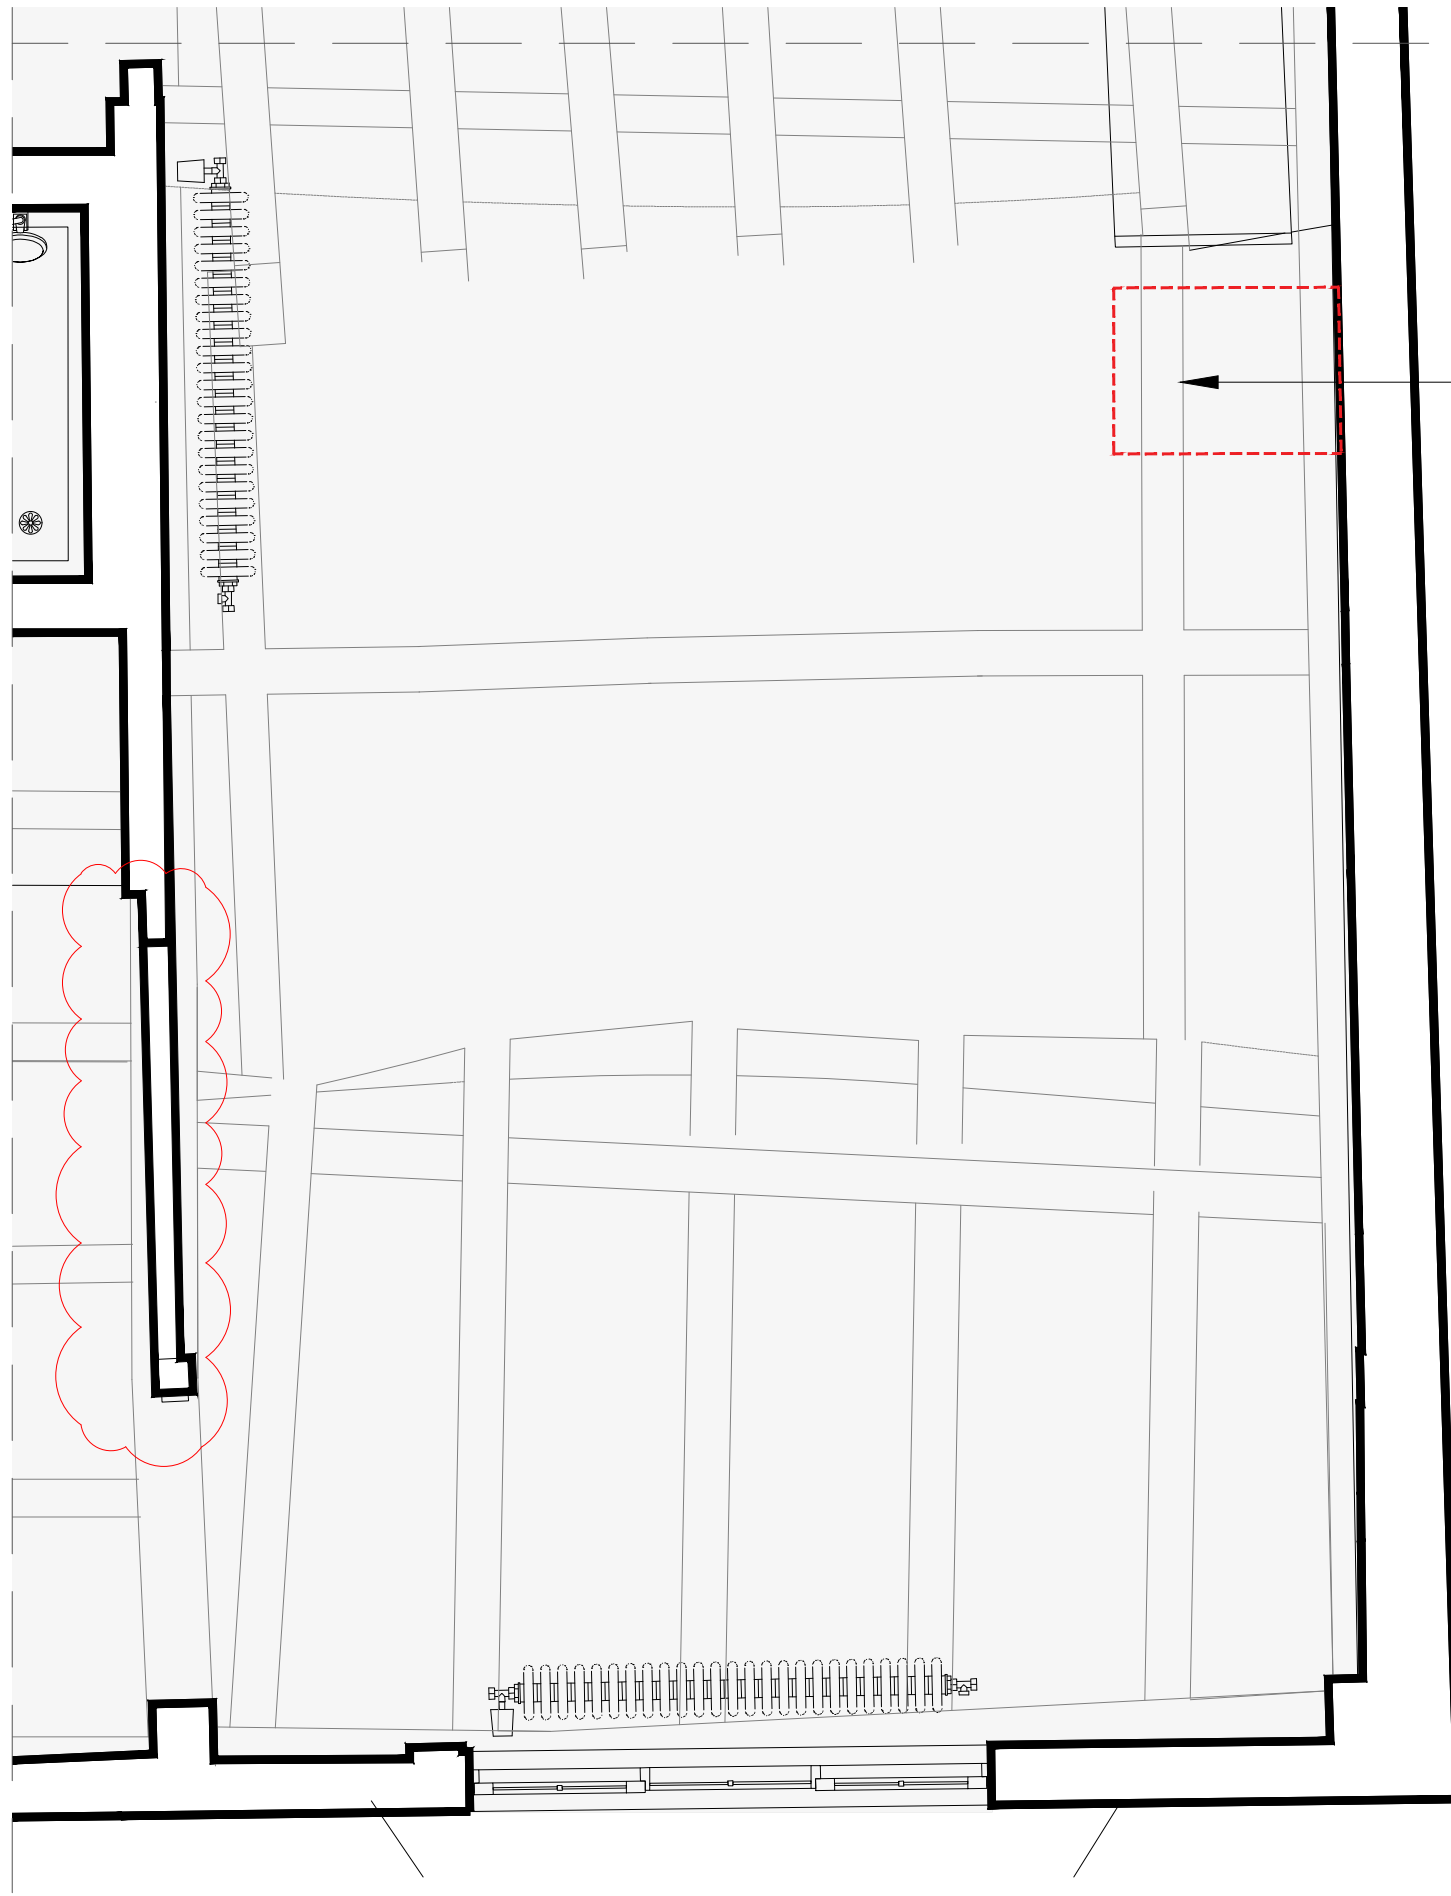

Approved Scheme Ground Floor Plan
Scale 1:25@A1
1:50@A3

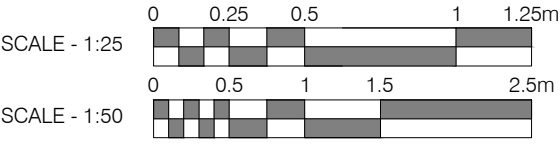

'As Built' / Proposed First Floor Plan
Scale 1:25@A1
1:50@A3

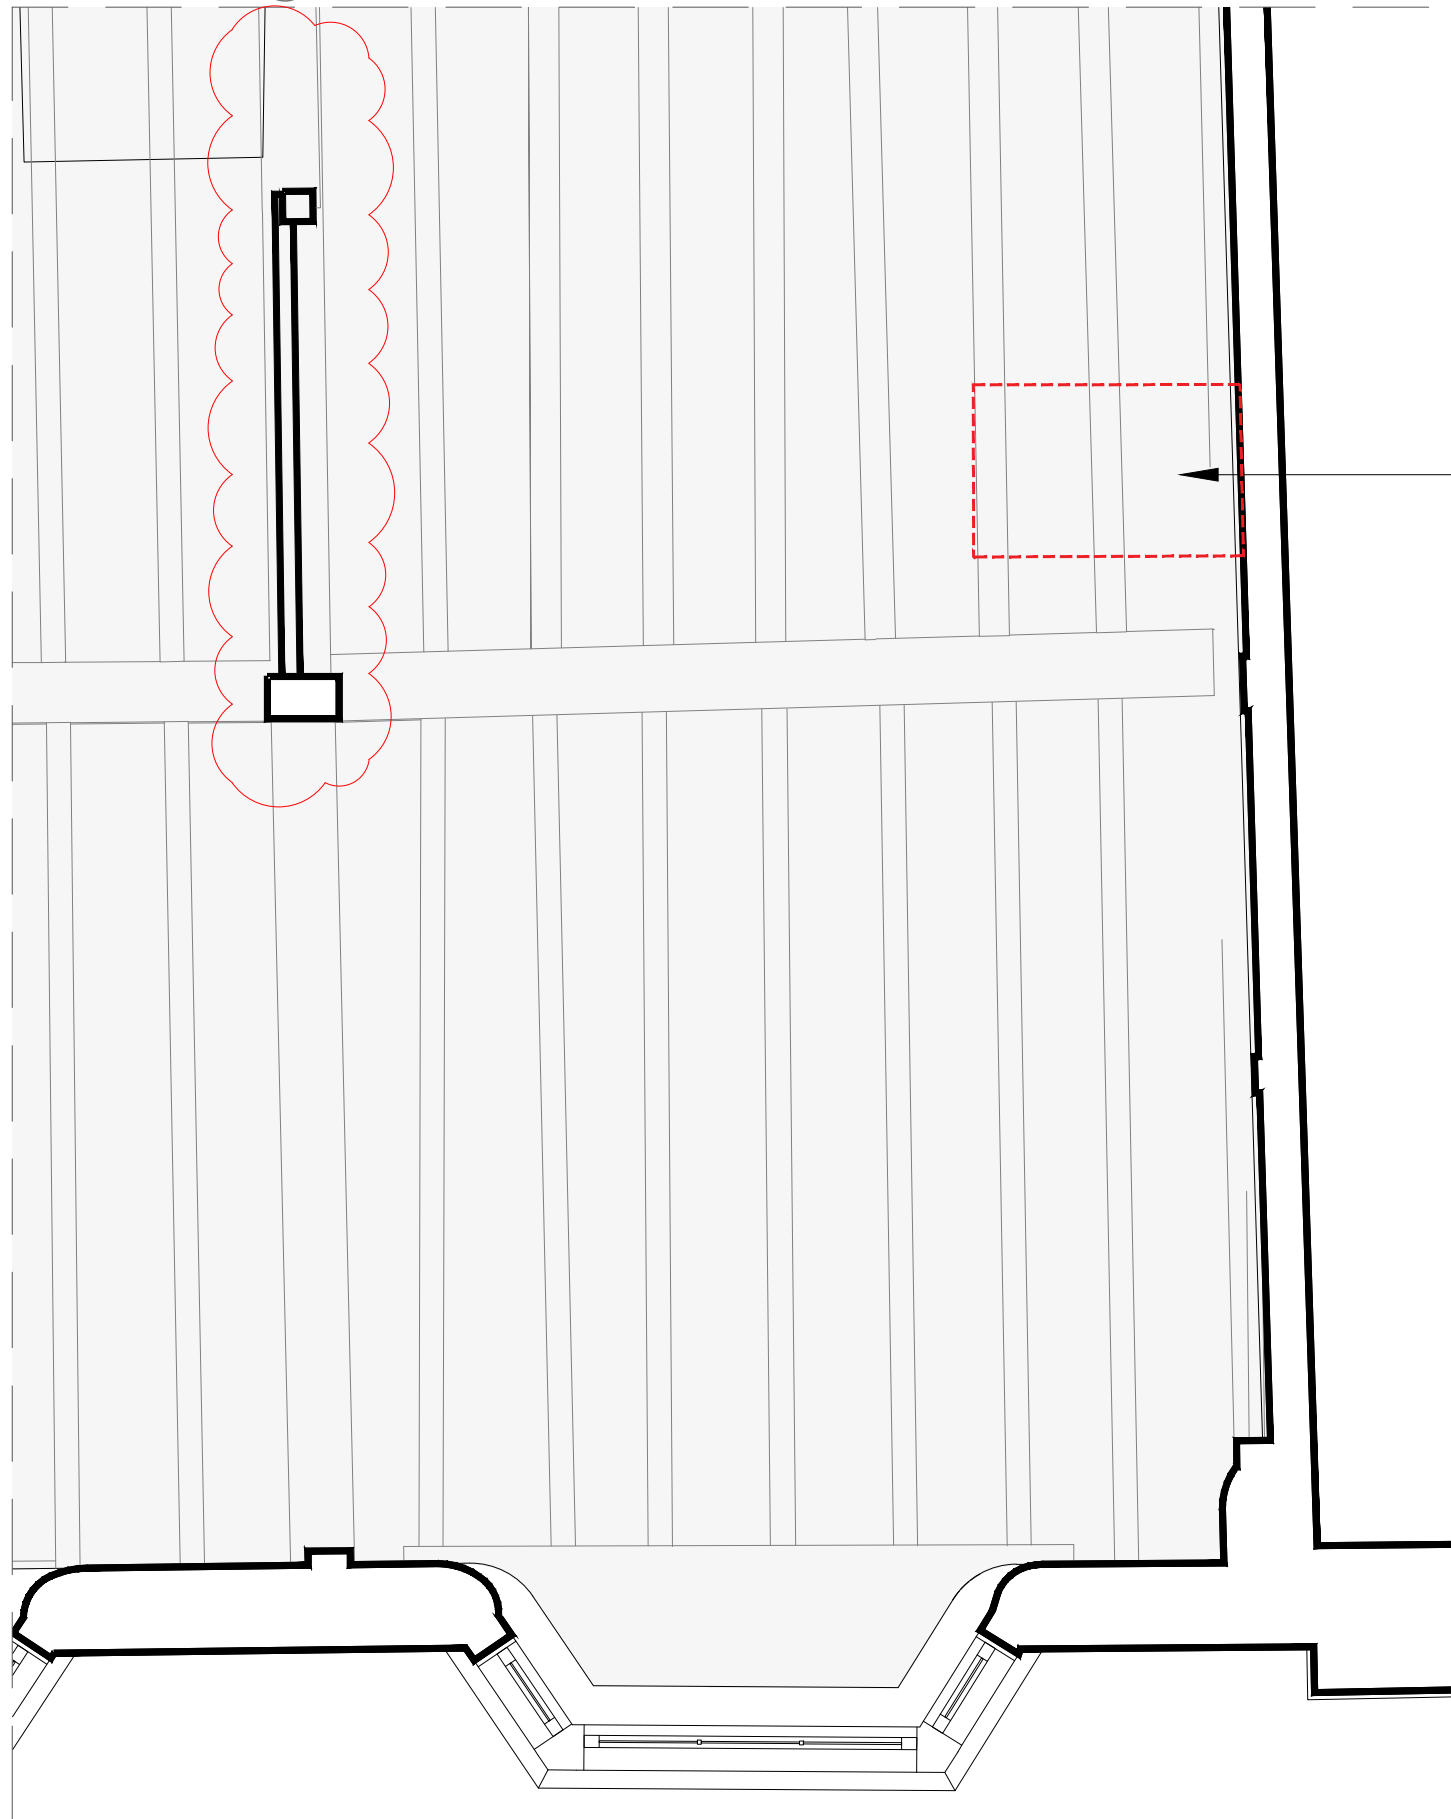

'As Built' / Proposed Ground Floor Plan
Scale 1:25@A1
1:50@A3

19th century chimney stack removed, timber floor and lathe and plaster ceiling made good

19th century chimney stack removed, timber floor and lathe and plaster ceiling made good

KEY:
Highlighted difference between Approved Scheme and 'As-Built'/Proposed Scheme

Rev: A
Comments: Amendments as clouded.
By: KN
Date: Nov 25

Do not scale this drawing All dimensions must be checked on site
All rights reserved. No reproduction in any material form is permitted without consent.

LISTED BUILDING
CONSENT


Client:
Mr. Simon Dougall

Project Title:
107 High St, Lindfield, Haywards Heath, West Sussex, RH16 2HR

Drawing Title:
Detail Drawings:
Removal of chimney - Sheet 1 of 2

Scale: 1:25@A1
1:50@A3
Date: Apr 25
Drawn: KN
Checked: KW

NOTE
DRAWINGS TO BE READ IN CONJUNCTION WITH SUBMITTED
DESIGN&ACCESS STATEMENT AND HERITAGE STATEMENT
MATERIALS INSTALLED IN ACCORDANCE WITH THOSE
OUTLINED IN CONDITION #9 OF APPROVAL DM/23/1605

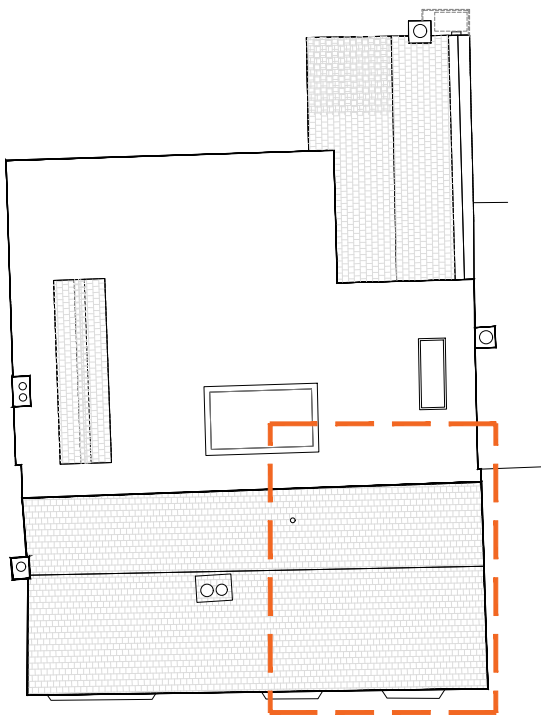

Key Plan 1:200@A1, 1:400@A3

kyson

Studio
28 Scrutton Street
London
UK
EC2A 4RP
T: +44(0) 20 7247 2462
E: enquiries@kyson.co.uk
W: www.kyson.co.uk

Project No.: 900-25
Drawing No.: 5005
Revision: A