





Approved Scheme
Ground Floor Plan
Scale 1:25:A1
1:50@A3



'As Built' and Proposed
Ground Floor Plan
Scale 1:25:A1
1:50@A3

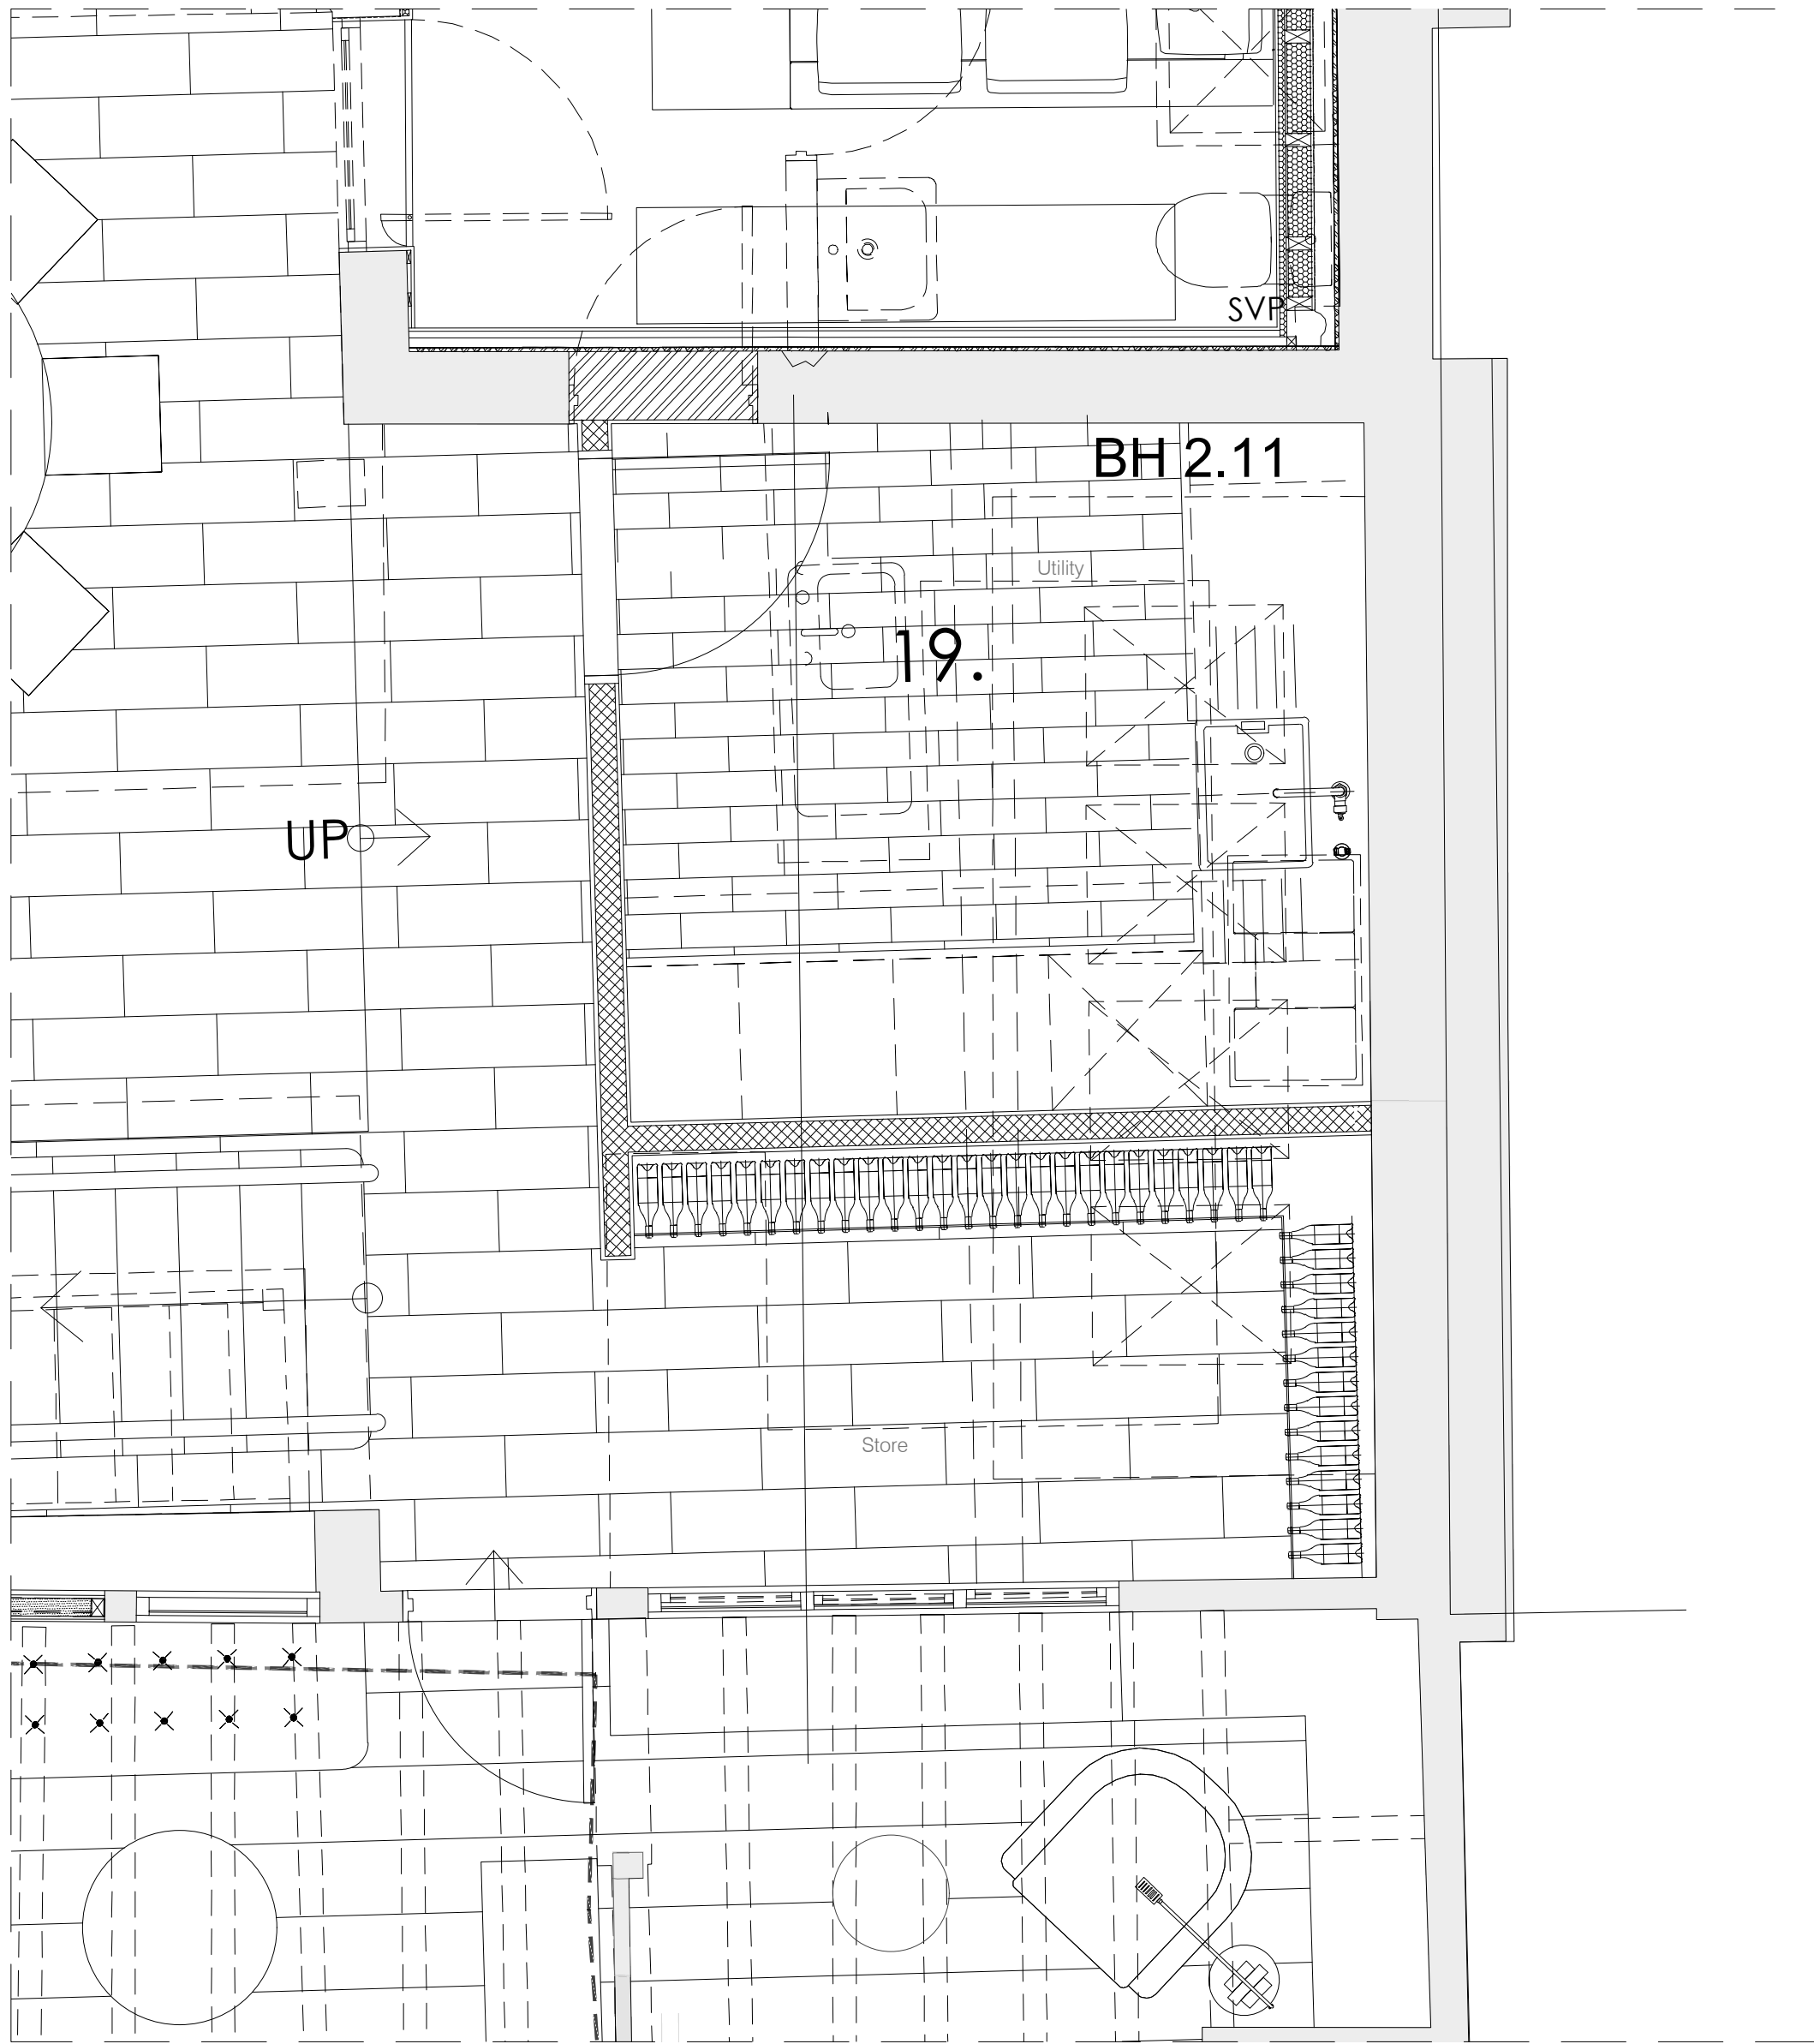

Sliding door to wine cellar/ storage

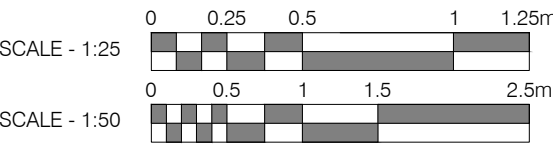

KEY:
Highlighted difference between Approved Scheme and 'As-Built'/Proposed Scheme

Rev: Comments: By: Date:

- - - -

**LISTED BUILDING
CONSENT**

Client:
Mr. Simon Dougall

Project Title:
107 High St, Lindfield, Haywards Heath, West Sussex, RH16 2HR

Drawing Title:
Detail Drawings:
Ground floor utility room

Scale: Date: Drawn: Checked:
1:25@A1 Apr 25 KN KW
1:50@A3



Studio
28 Scrutton Street
London
UK
EC2A 4RP

T: +44(0) 20 7247 2462
E: enquiries@kyson.co.uk
W: www.kyson.co.uk

kyson

Project No.: Drawing No.: Revision:
900-25 5015 -