



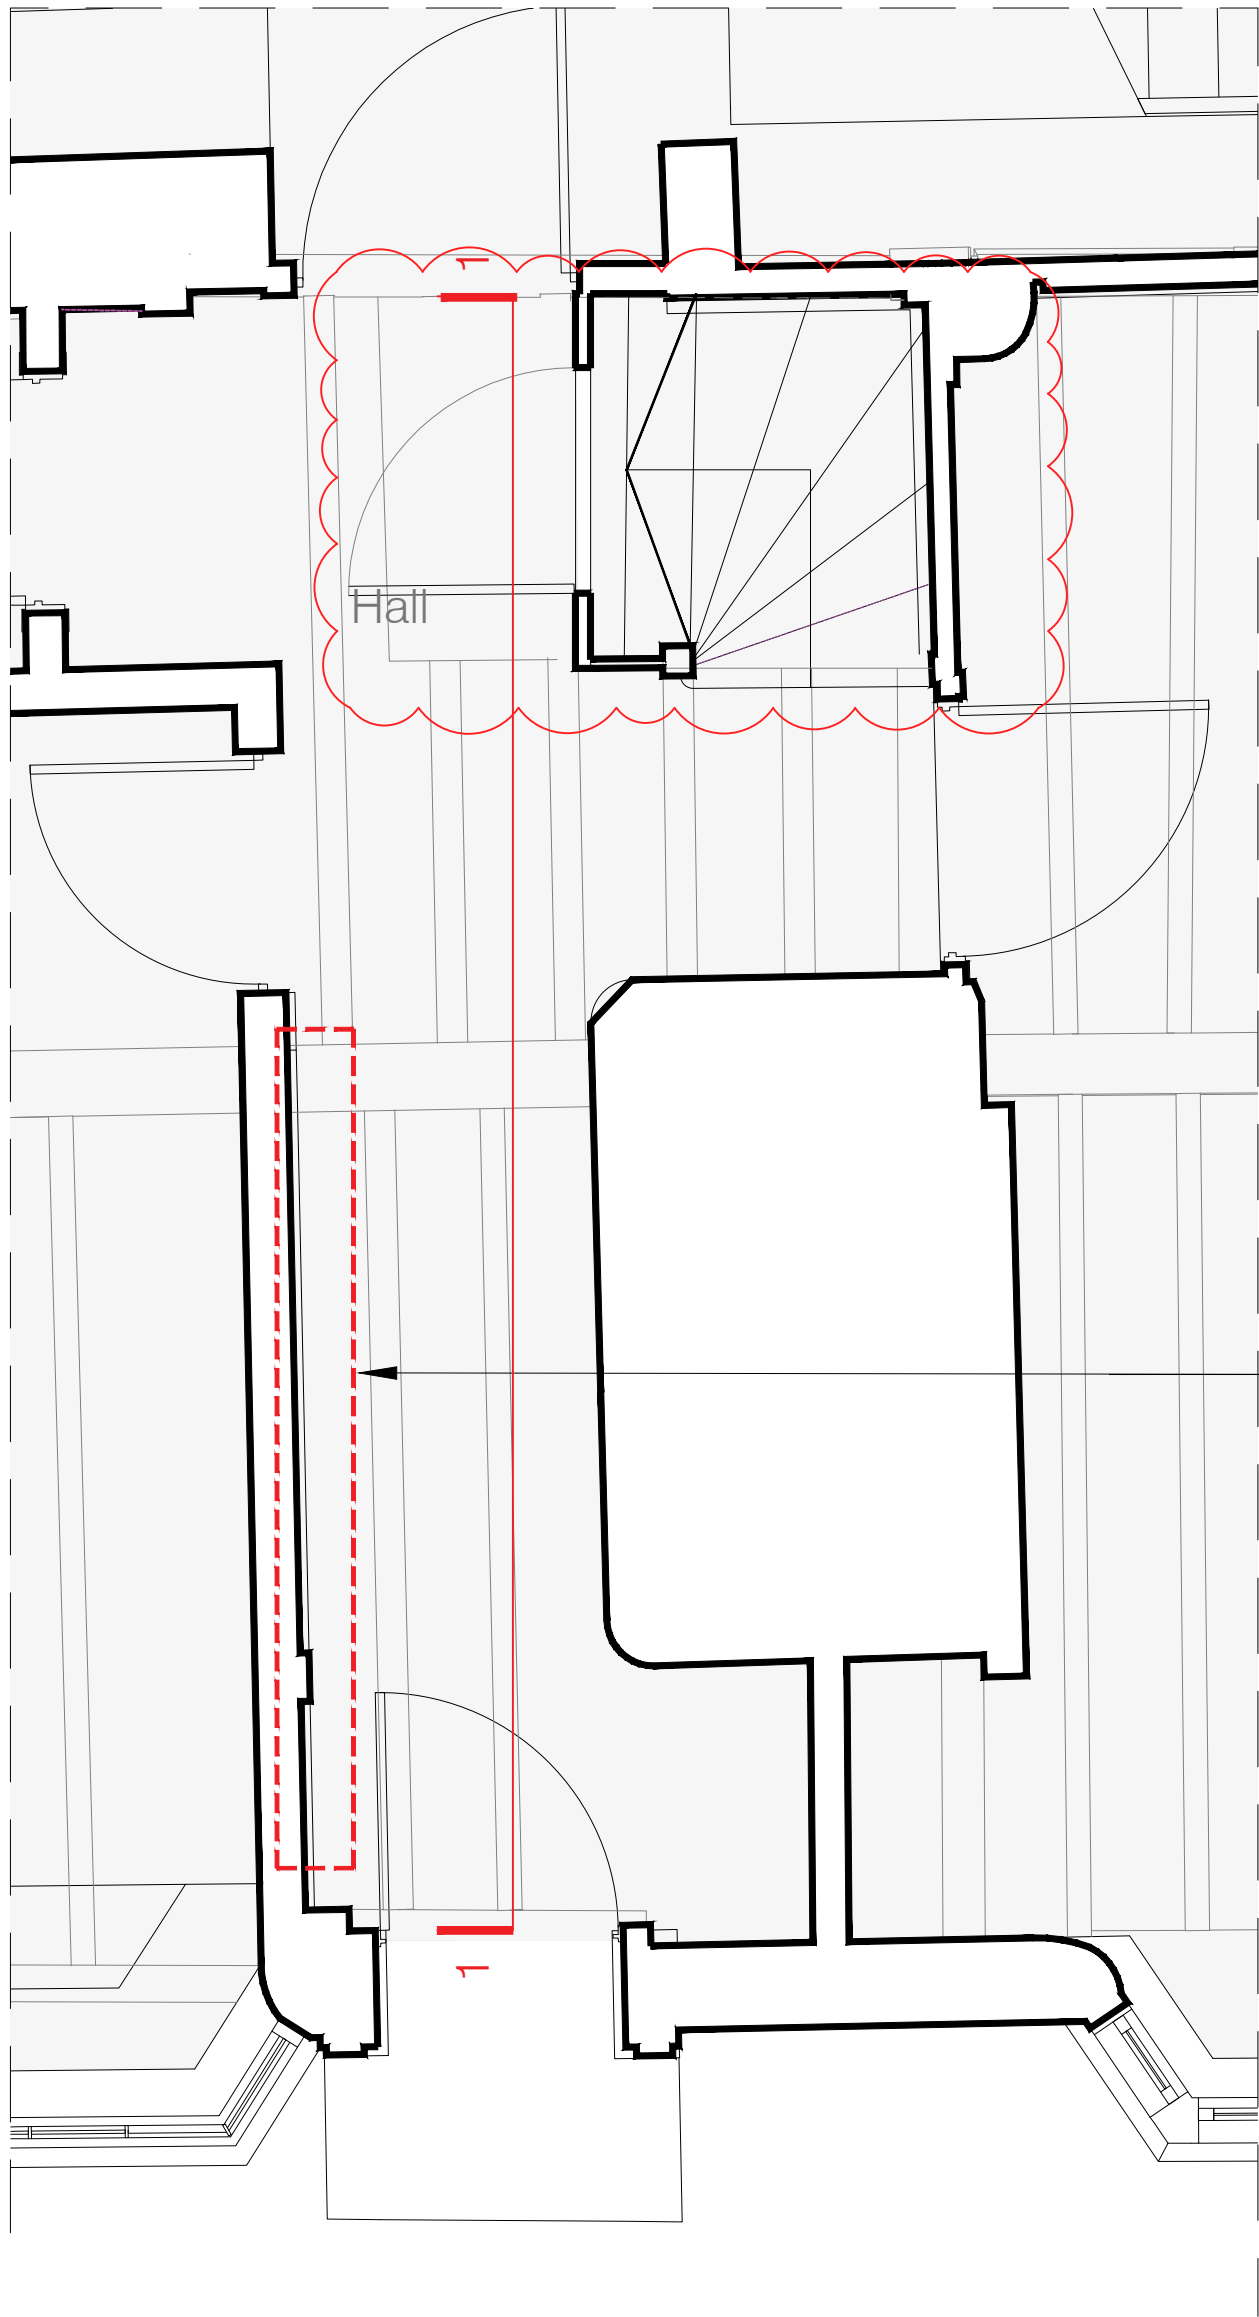


Existing oak timber framing
exposed and restored to
enhance the character of this
area of the original
property


KEY
Ground Floor Plan
Scale 1:25:A1
1:50@A3



The entrance passage with exposed timber framing

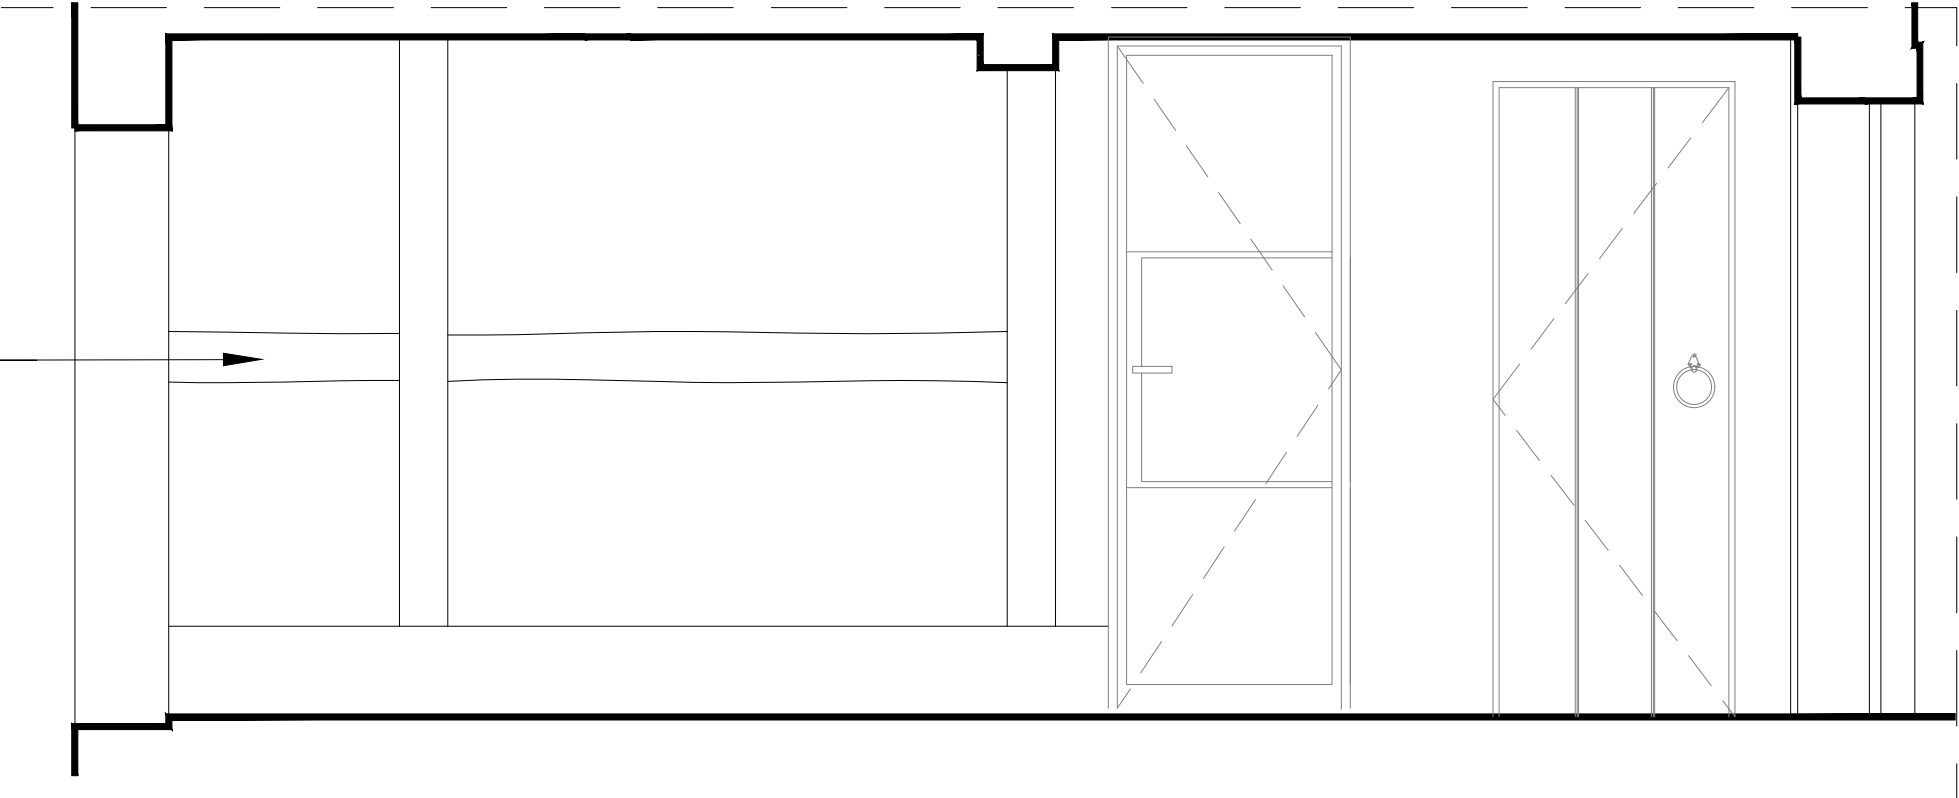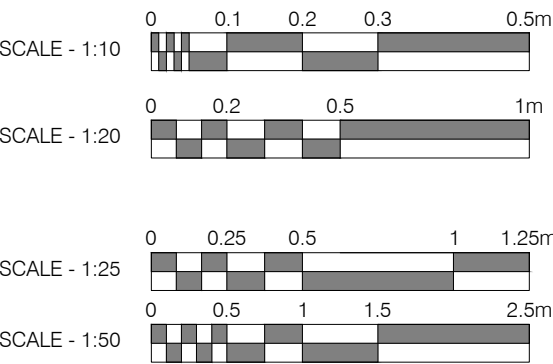


Internal Elevation 1
Scale 1:25:A1
1:50@A3

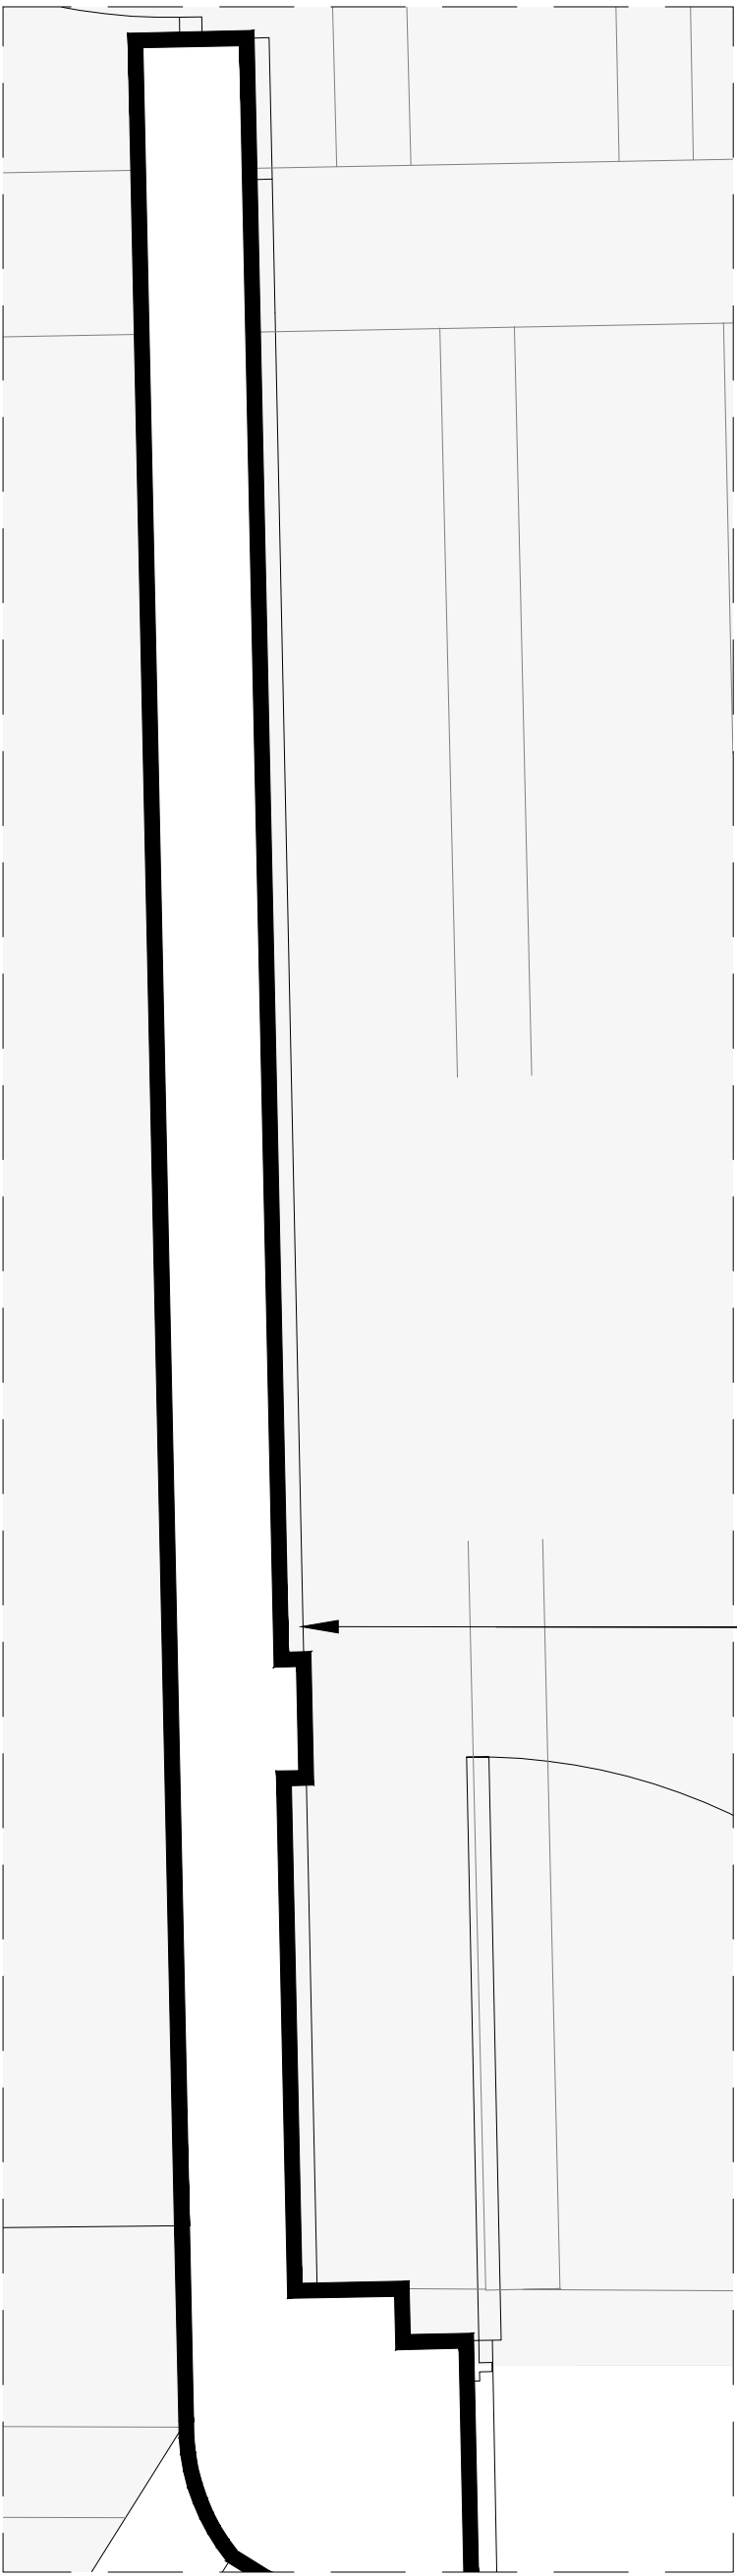

Existing oak timber
framing exposed and
restored by specialist

 Plan
Scale 1:10:A1
1:20@A3



Section
Scale 1:10:A1
1:20@A3

KEY:
Highlighted difference between Approved Scheme and 'As-Built'/Proposed Scheme

Rev.	Comments	By:	Date:
A	Amendments as clouded.	KN	Nov 25

Do not scale this drawing All dimensions must be checked on site
All rights reserved. No reproduction in any material form is permitted
without consent.

**LISTED BUILDING
CONSENT**

Client:
Mr. Simon Dougall

Project Title:
107 High St, Lindfield, Haywards Heath, West Sussex, RH16 2HR

Drawing Title:
Detail Drawings:
Entrance Passage Timber Framing

Scale:	Date:	Drawn:	Checked:
1:25@A1	1:10@A1	KN	KW
1:50@A3	1:20@A3		



Studio

28 Scrutton Street
London
UK
EC2A 4RP

T: +44(0) 20 7247 2462
E: enquiries@kyson.co.uk
W: www.kyson.co.uk

kyson

Project No.:	Drawing No.:	Revision:
900-25	5016	A