




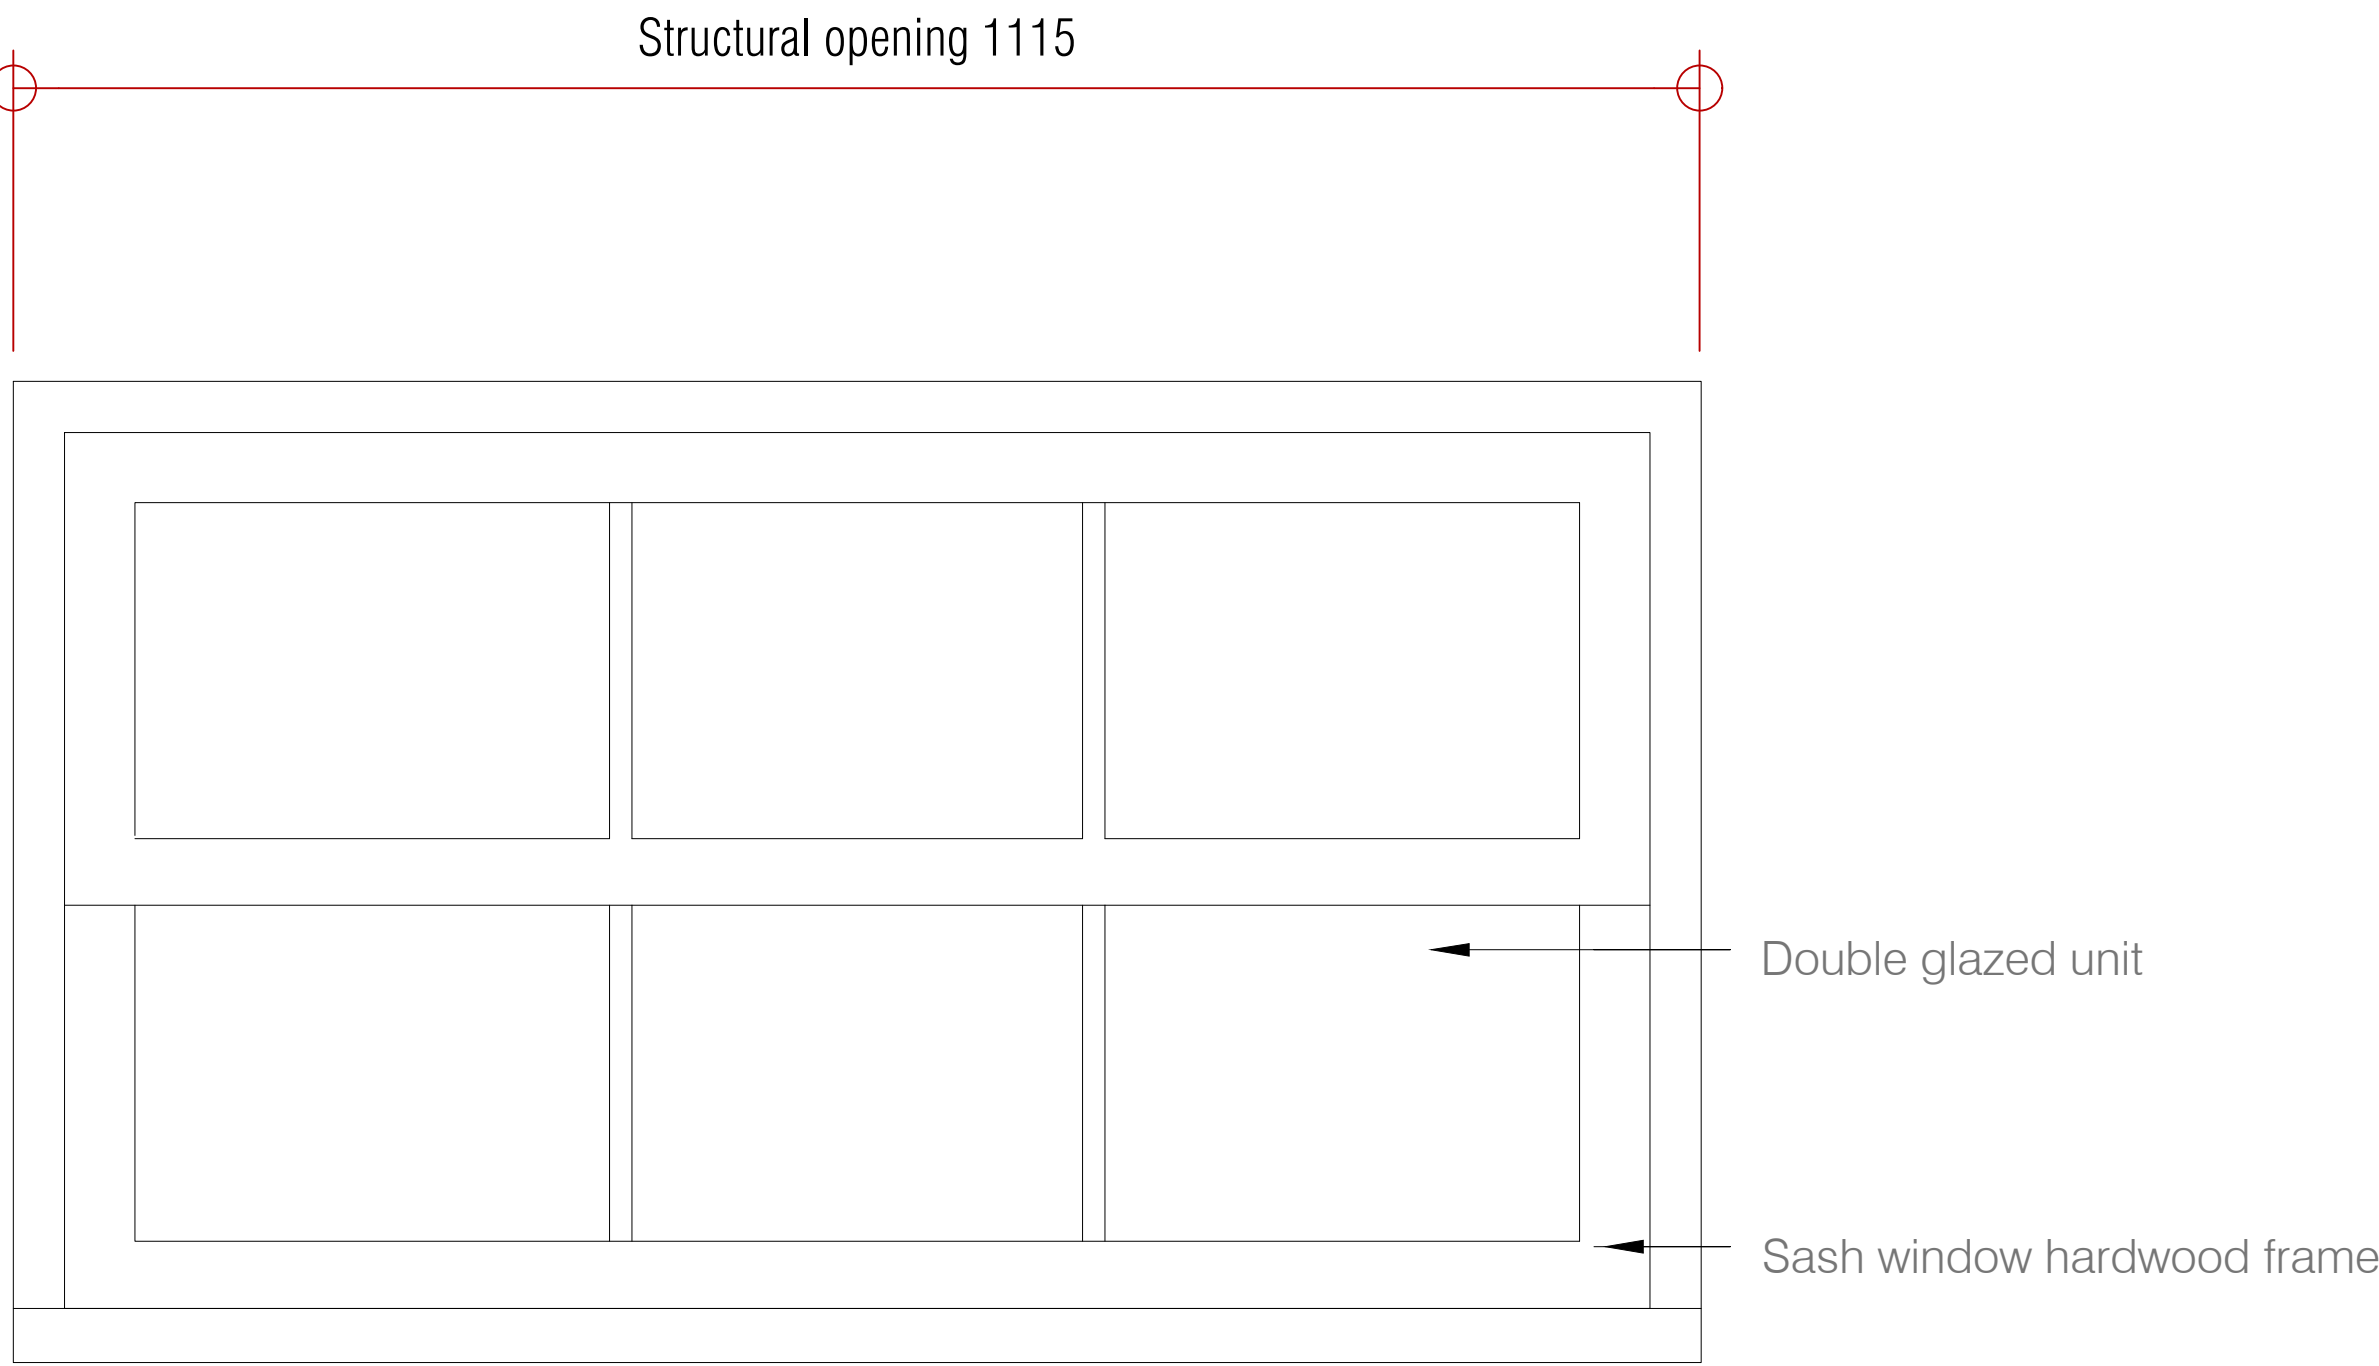

Elevation

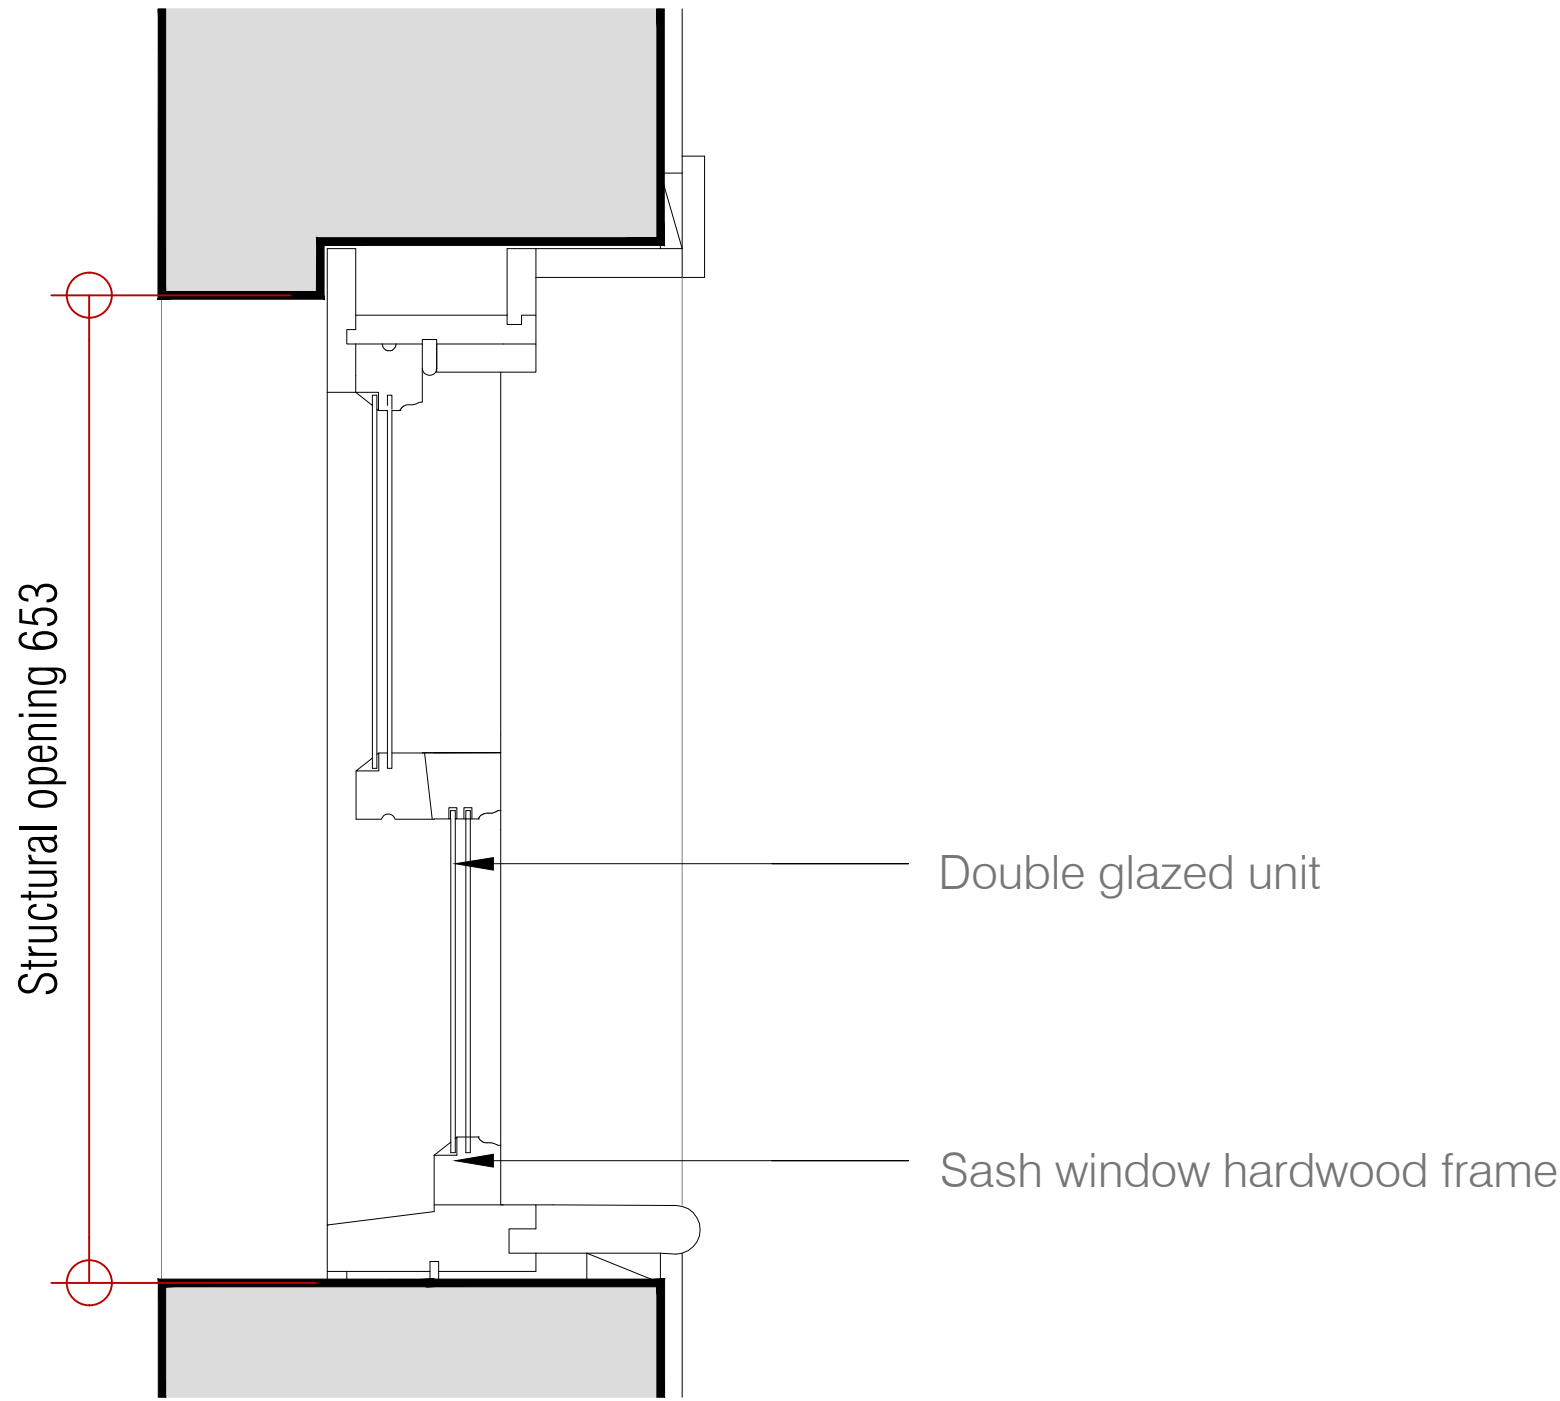


Section

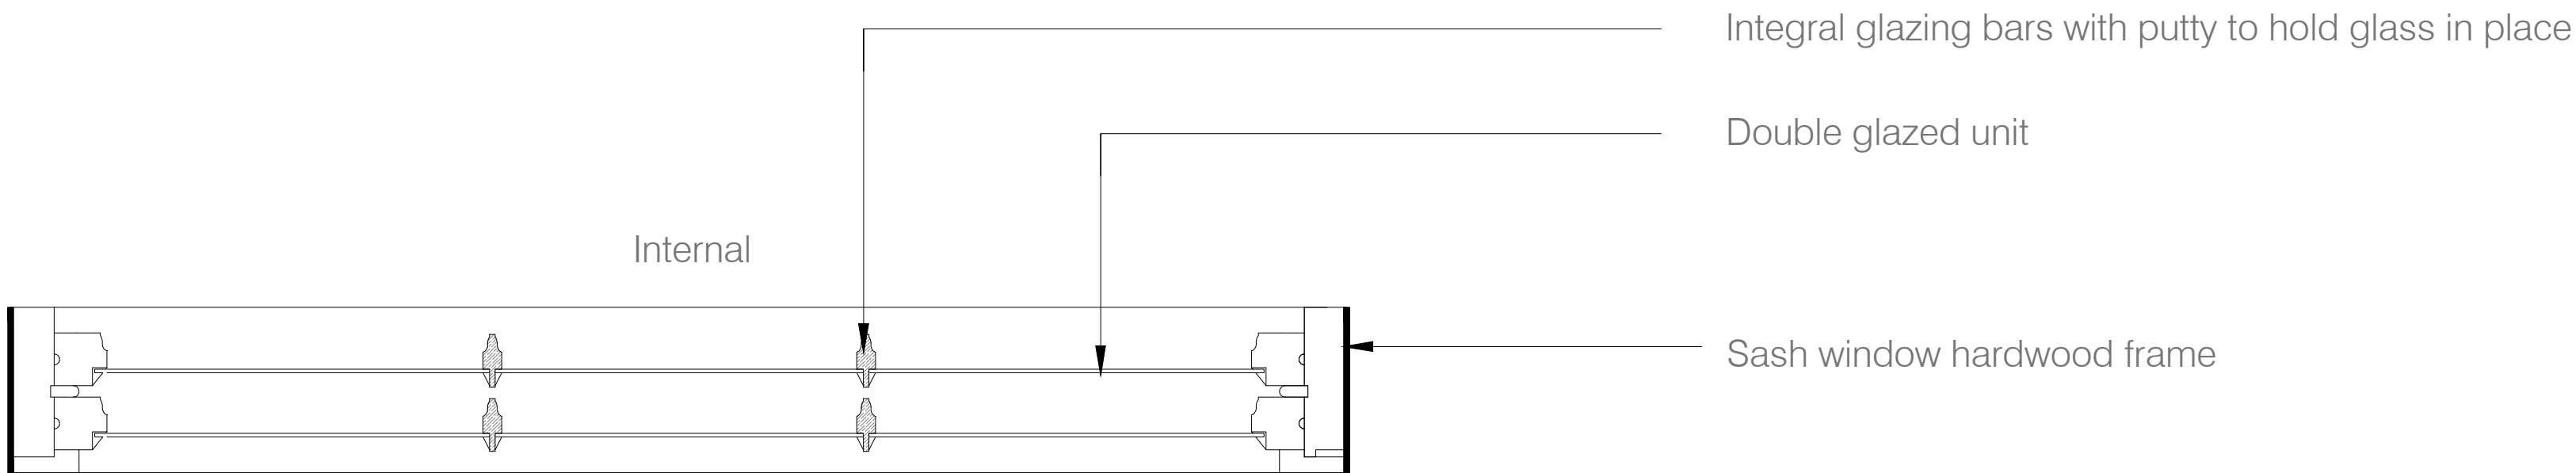

Plan

Replacement window details
Scale 1:5@A1
1:10@A3

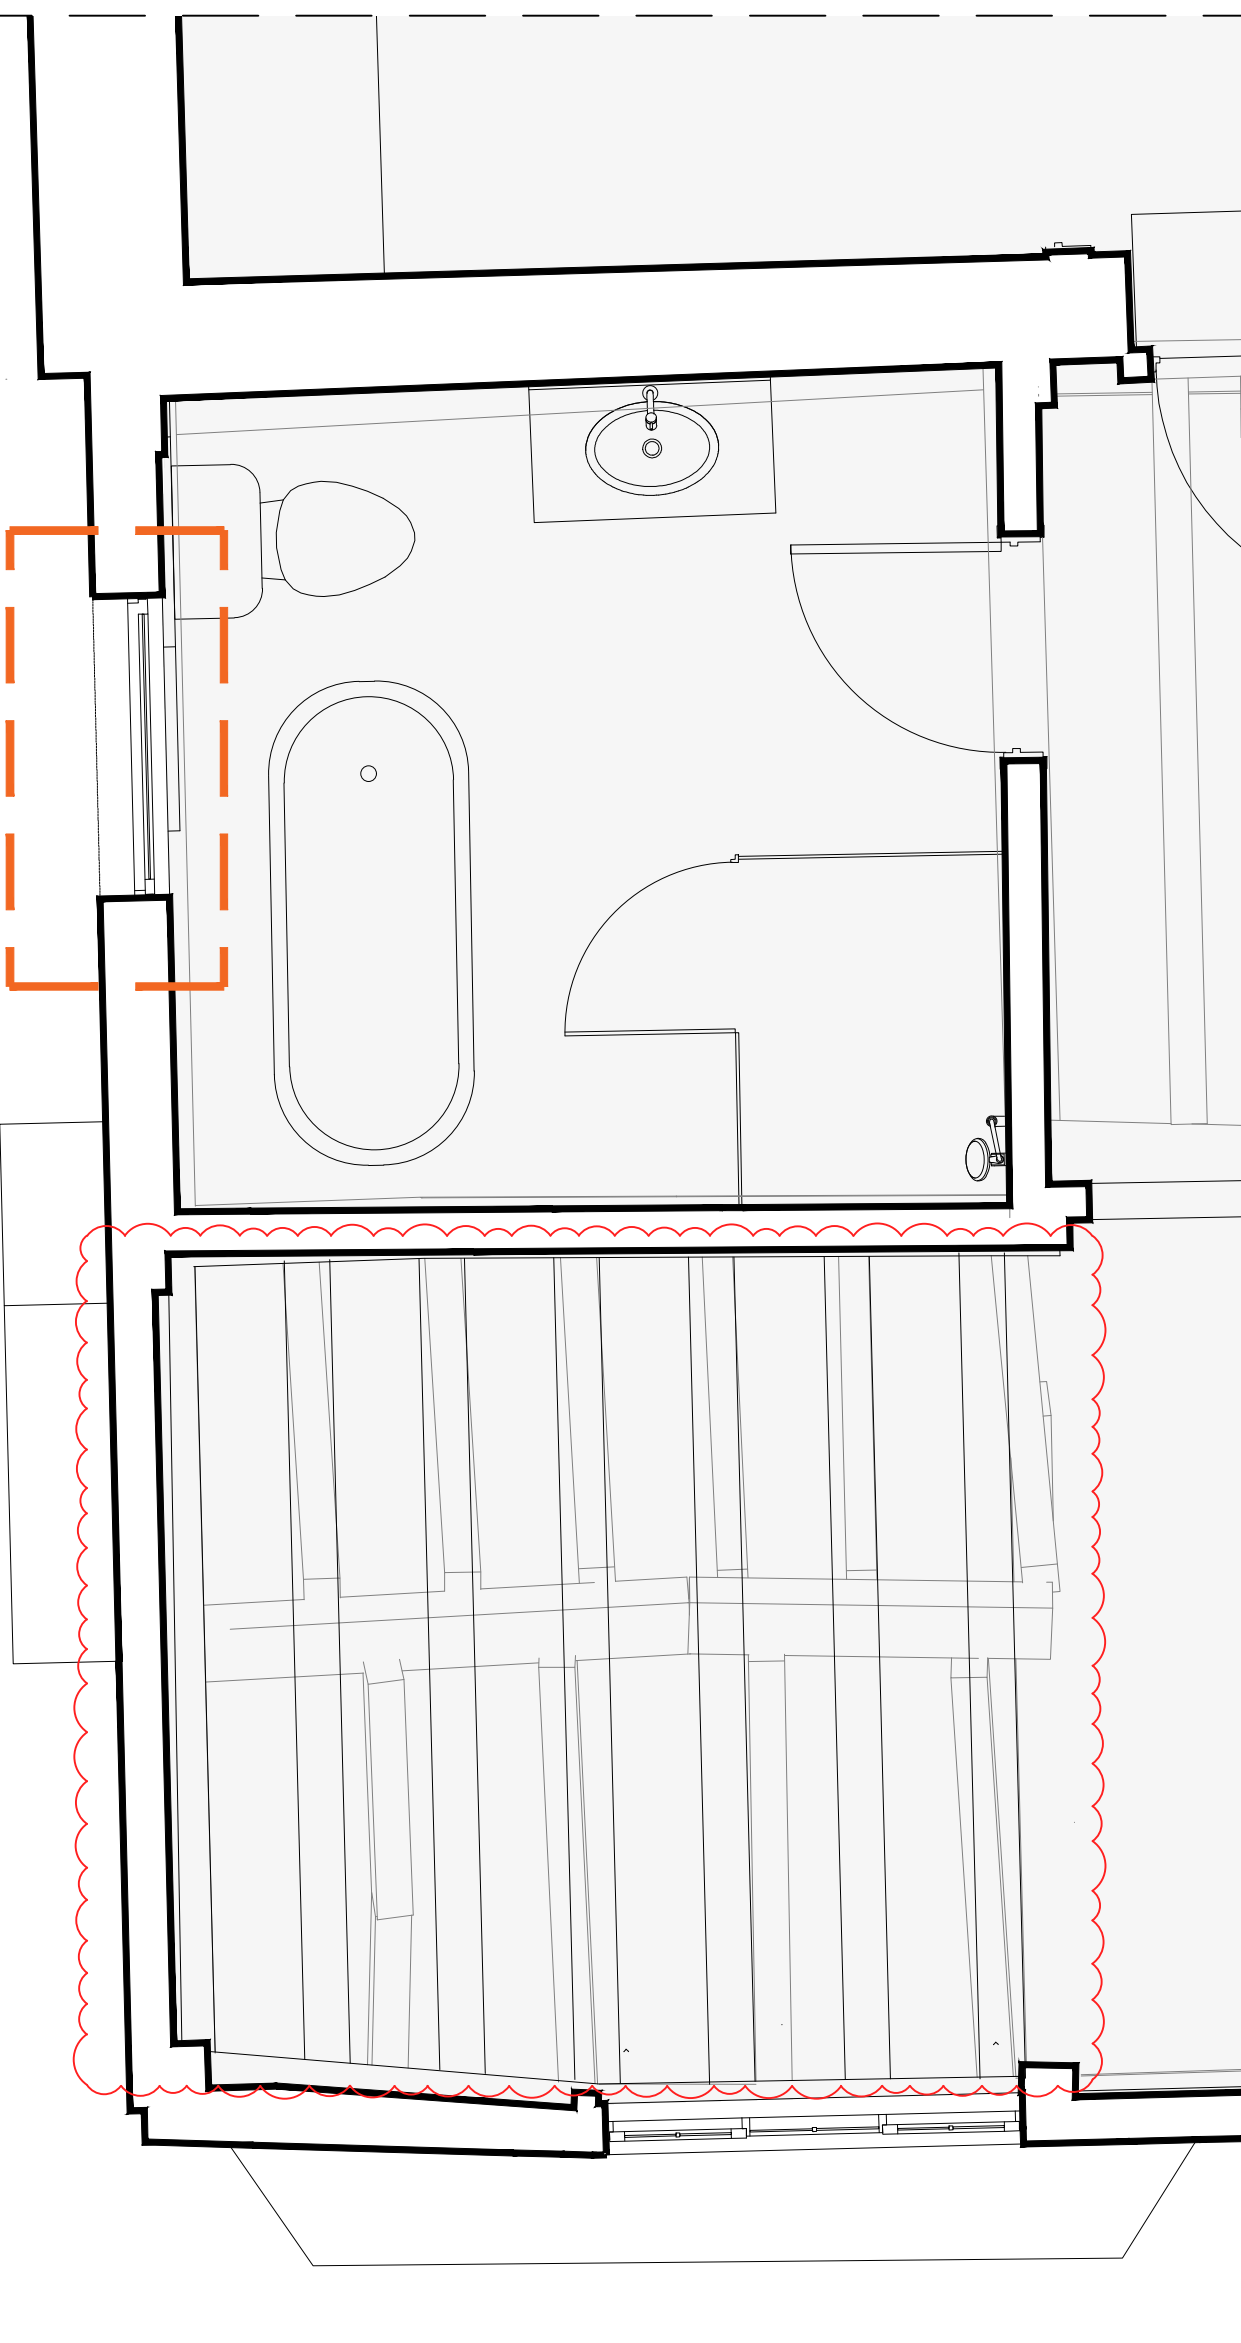

KEY:
Highlighted difference between Approved Scheme and 'As-Built'/Proposed Scheme

Rev:				Client:			
A	Comments: Amendments as clouded.	By: KN	Date: Nov 25	Mr. Simon Dougall			
Project Title:				Drawing Title:			
107 High St, Lindfield, Haywards Heath, West Sussex, RH16 2HR				Replacement casement window - first floor south east elevation			
Scale:				Date:			
1:25@A1 1:5@A1 1:50@A3 1:10@A3				Apr 25			
Drawn:				Checked:			
KN				KW			
Project No.:				Drawing No.:			
900-25				5023			
Revision:				A			

