




Approved West Elevation
Scale 1:25@A1
1:50@A3



As Built / Proposed West Elevation
Scale 1:25@A1
1:50@A3



KEY
Approved First Floor Plan
Scale 1:25@A1
1:50@A3

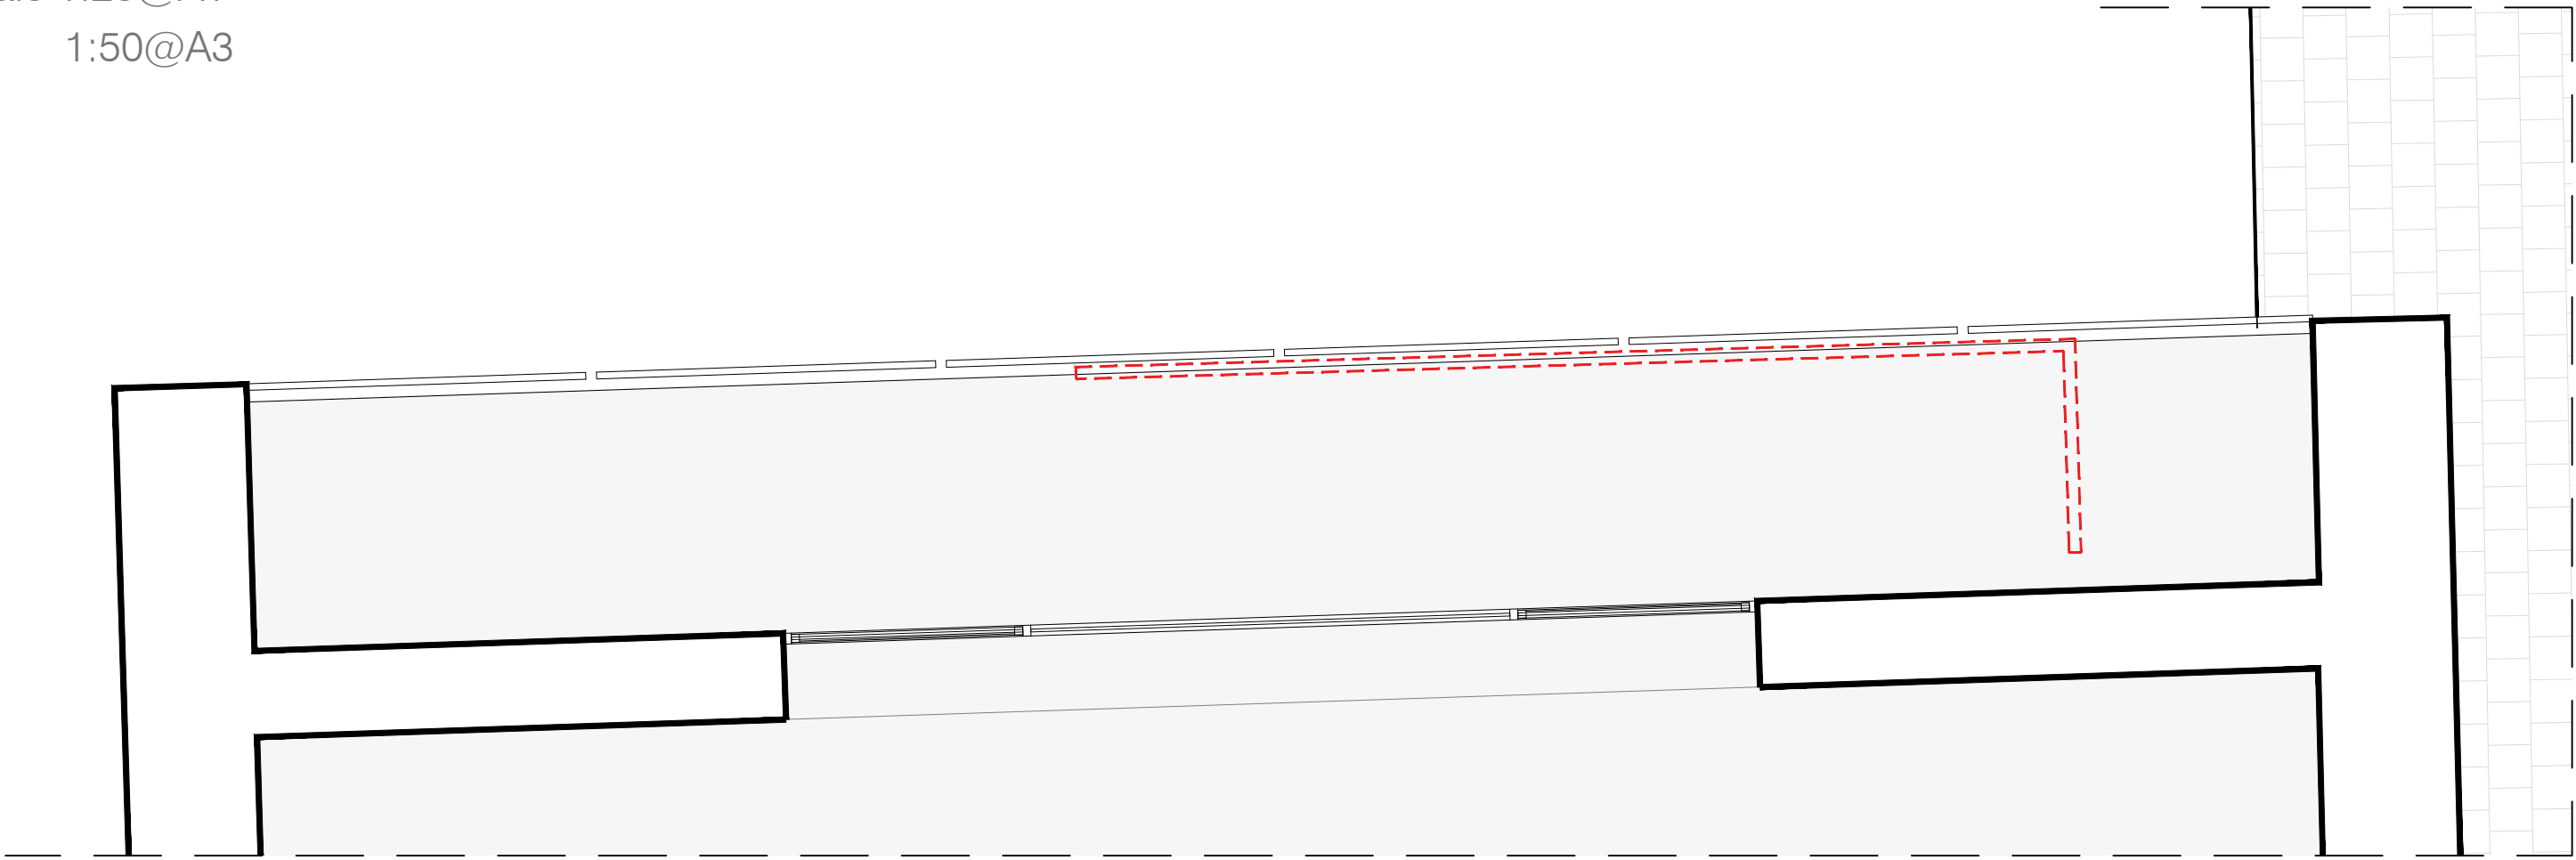

KEY
As Built / Proposed First Floor Plan
Scale 1:25@A1
1:50@A3

KEY:
Highlighted difference between Approved Scheme and 'As-Built'/Proposed Scheme

Rev.				Client:				Project Title:				Drawing Title:				Project No.:			
A				Mr. Simon Dougall				107 High St, Lindfield, Haywards Heath, West Sussex, RH16 2HR				Balustrade to terrace - Sheet 1 of 2				900-25			
Comments:				By:				Date:				Scale:				Drawing No.:			
Amendments as clouded.				KN				Apr 25				1:25@A1 1:10@A1 1:20@A3				5024			
												Checked:				Revision:			
												KW				A			

Do not scale this drawing. All dimensions must be checked on site. All rights reserved. No reproduction in any material form is permitted without consent.

1:25@A1 1:10@A1 1:20@A3

Apr 25

KN

KW

kyson

28 Scrutton Street
London
UK
EC2A 4RP

T: +44(0) 20 7247 2462
E: enquiries@kyson.co.uk
W: www.kyson.co.uk