



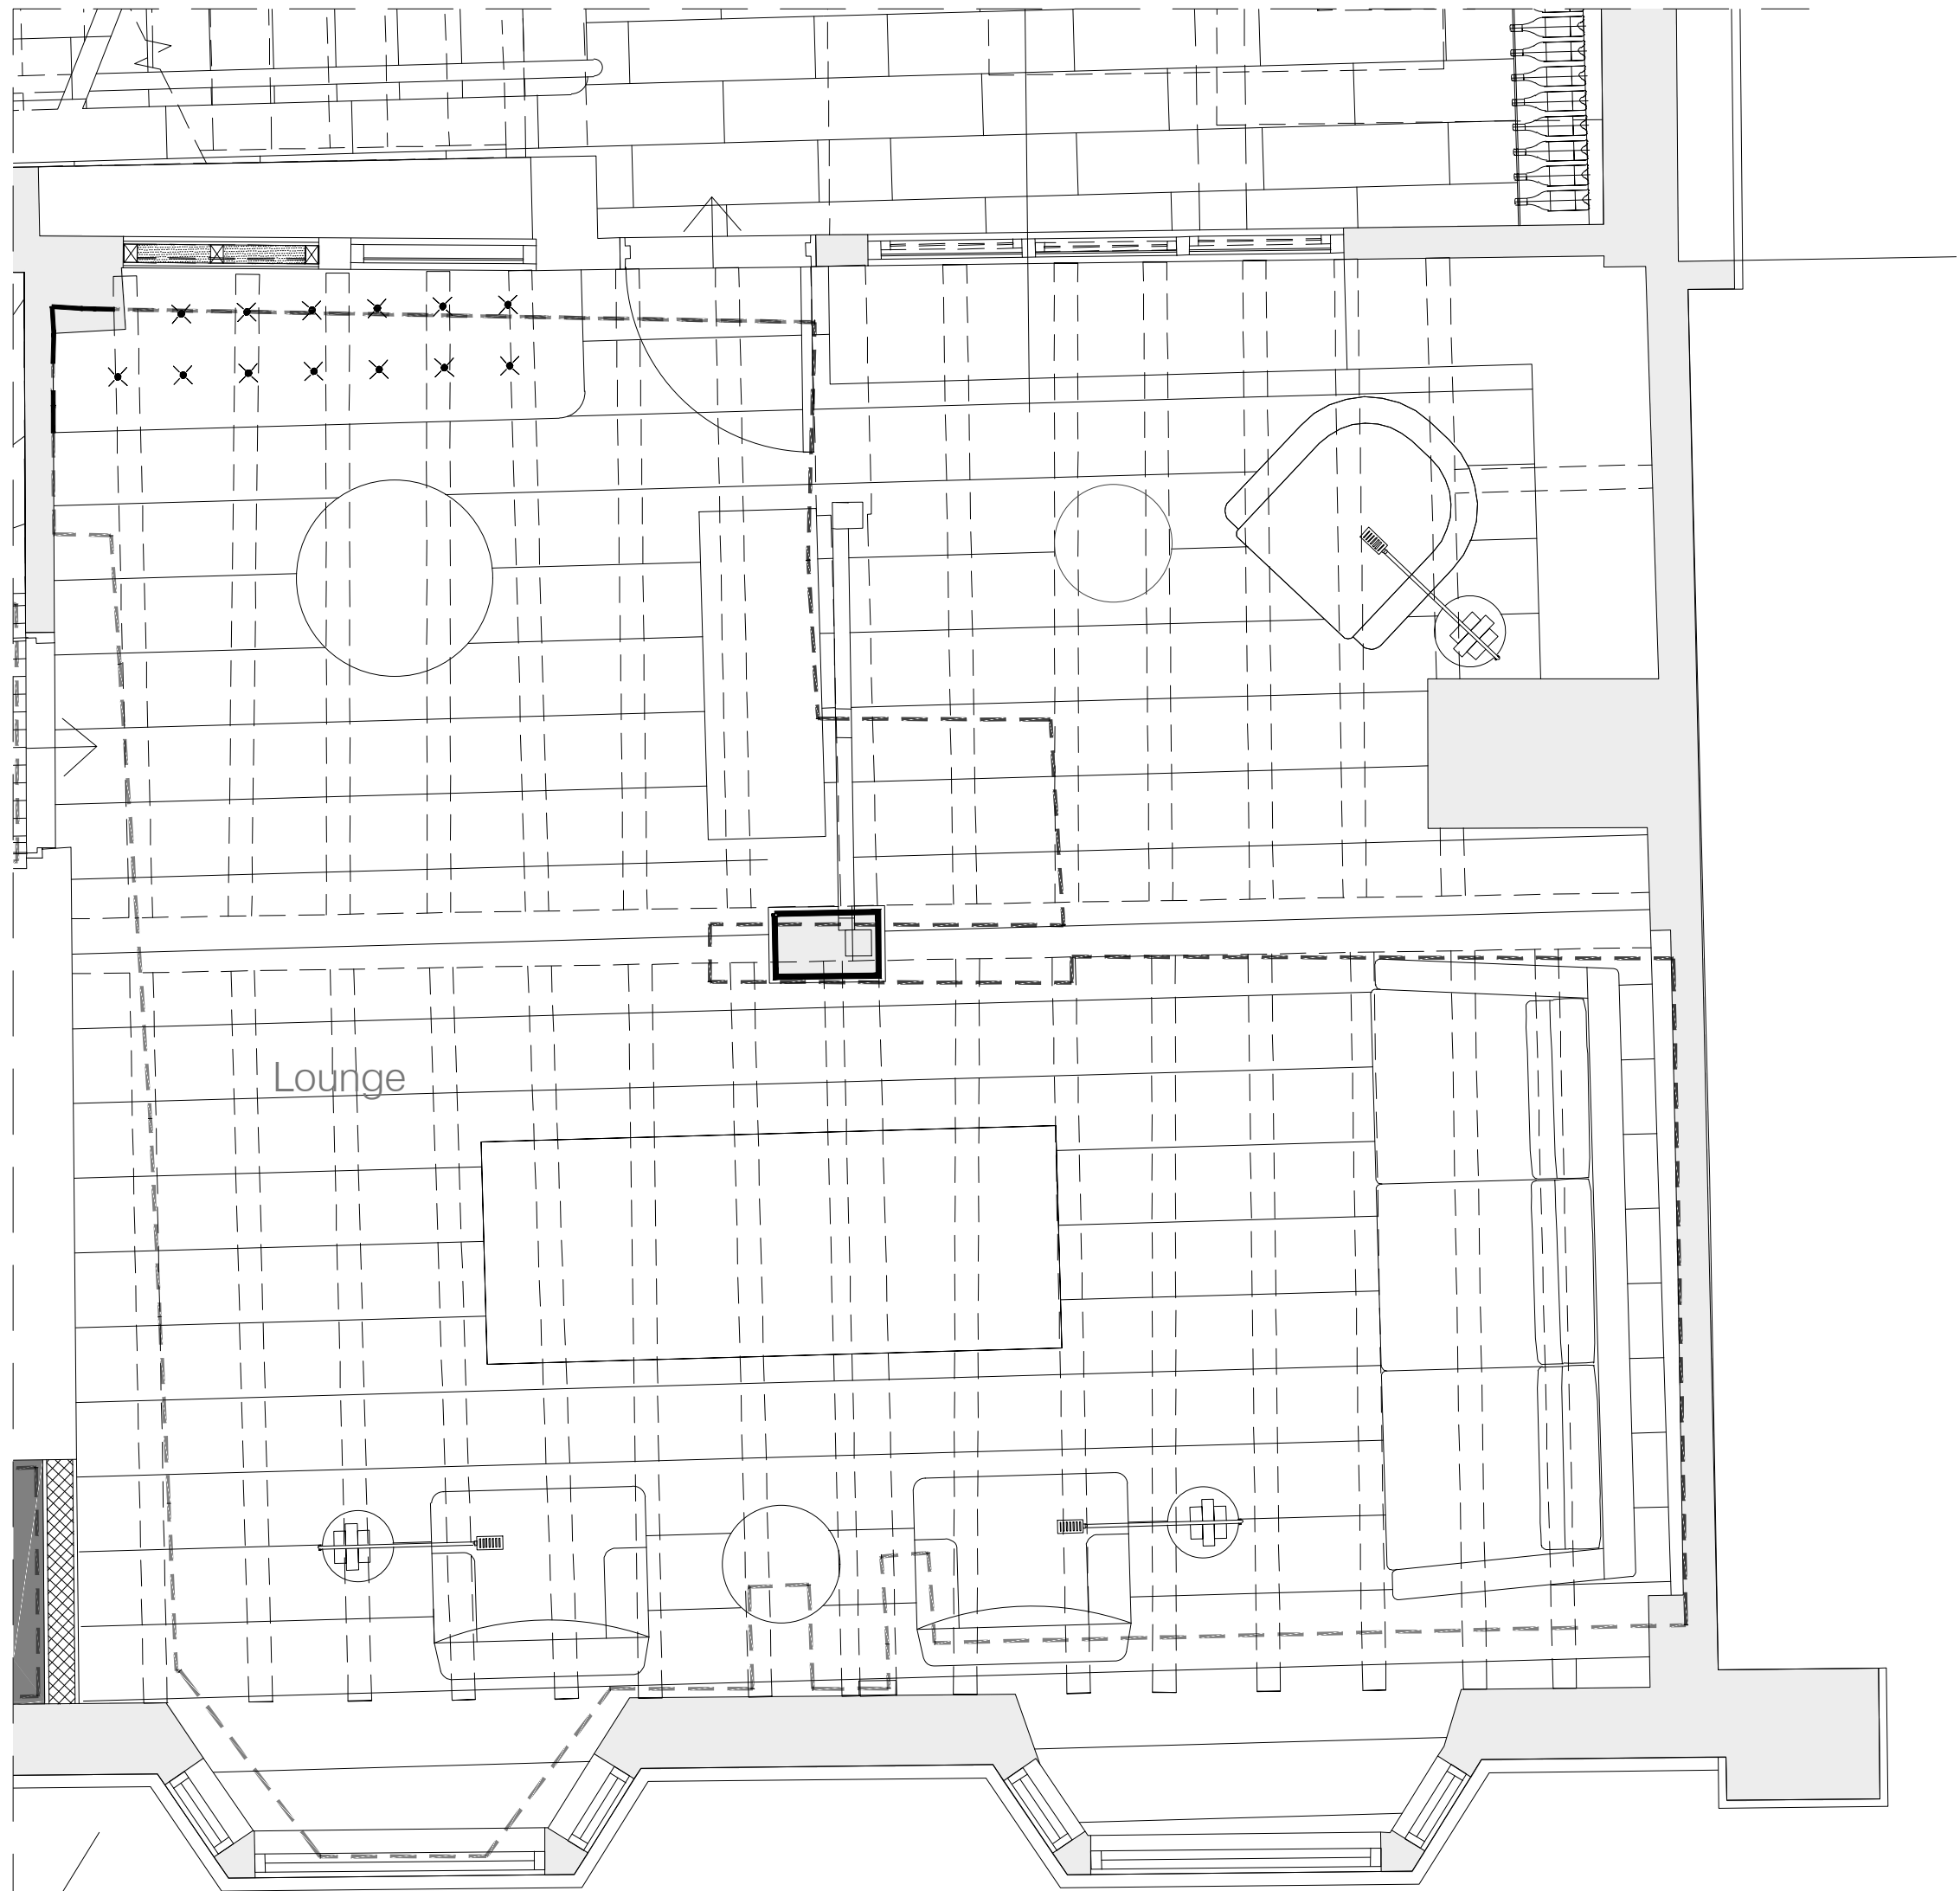

Approved Scheme
Ground Floor Plan
Scale 1:25@A1 , 1:50@A3

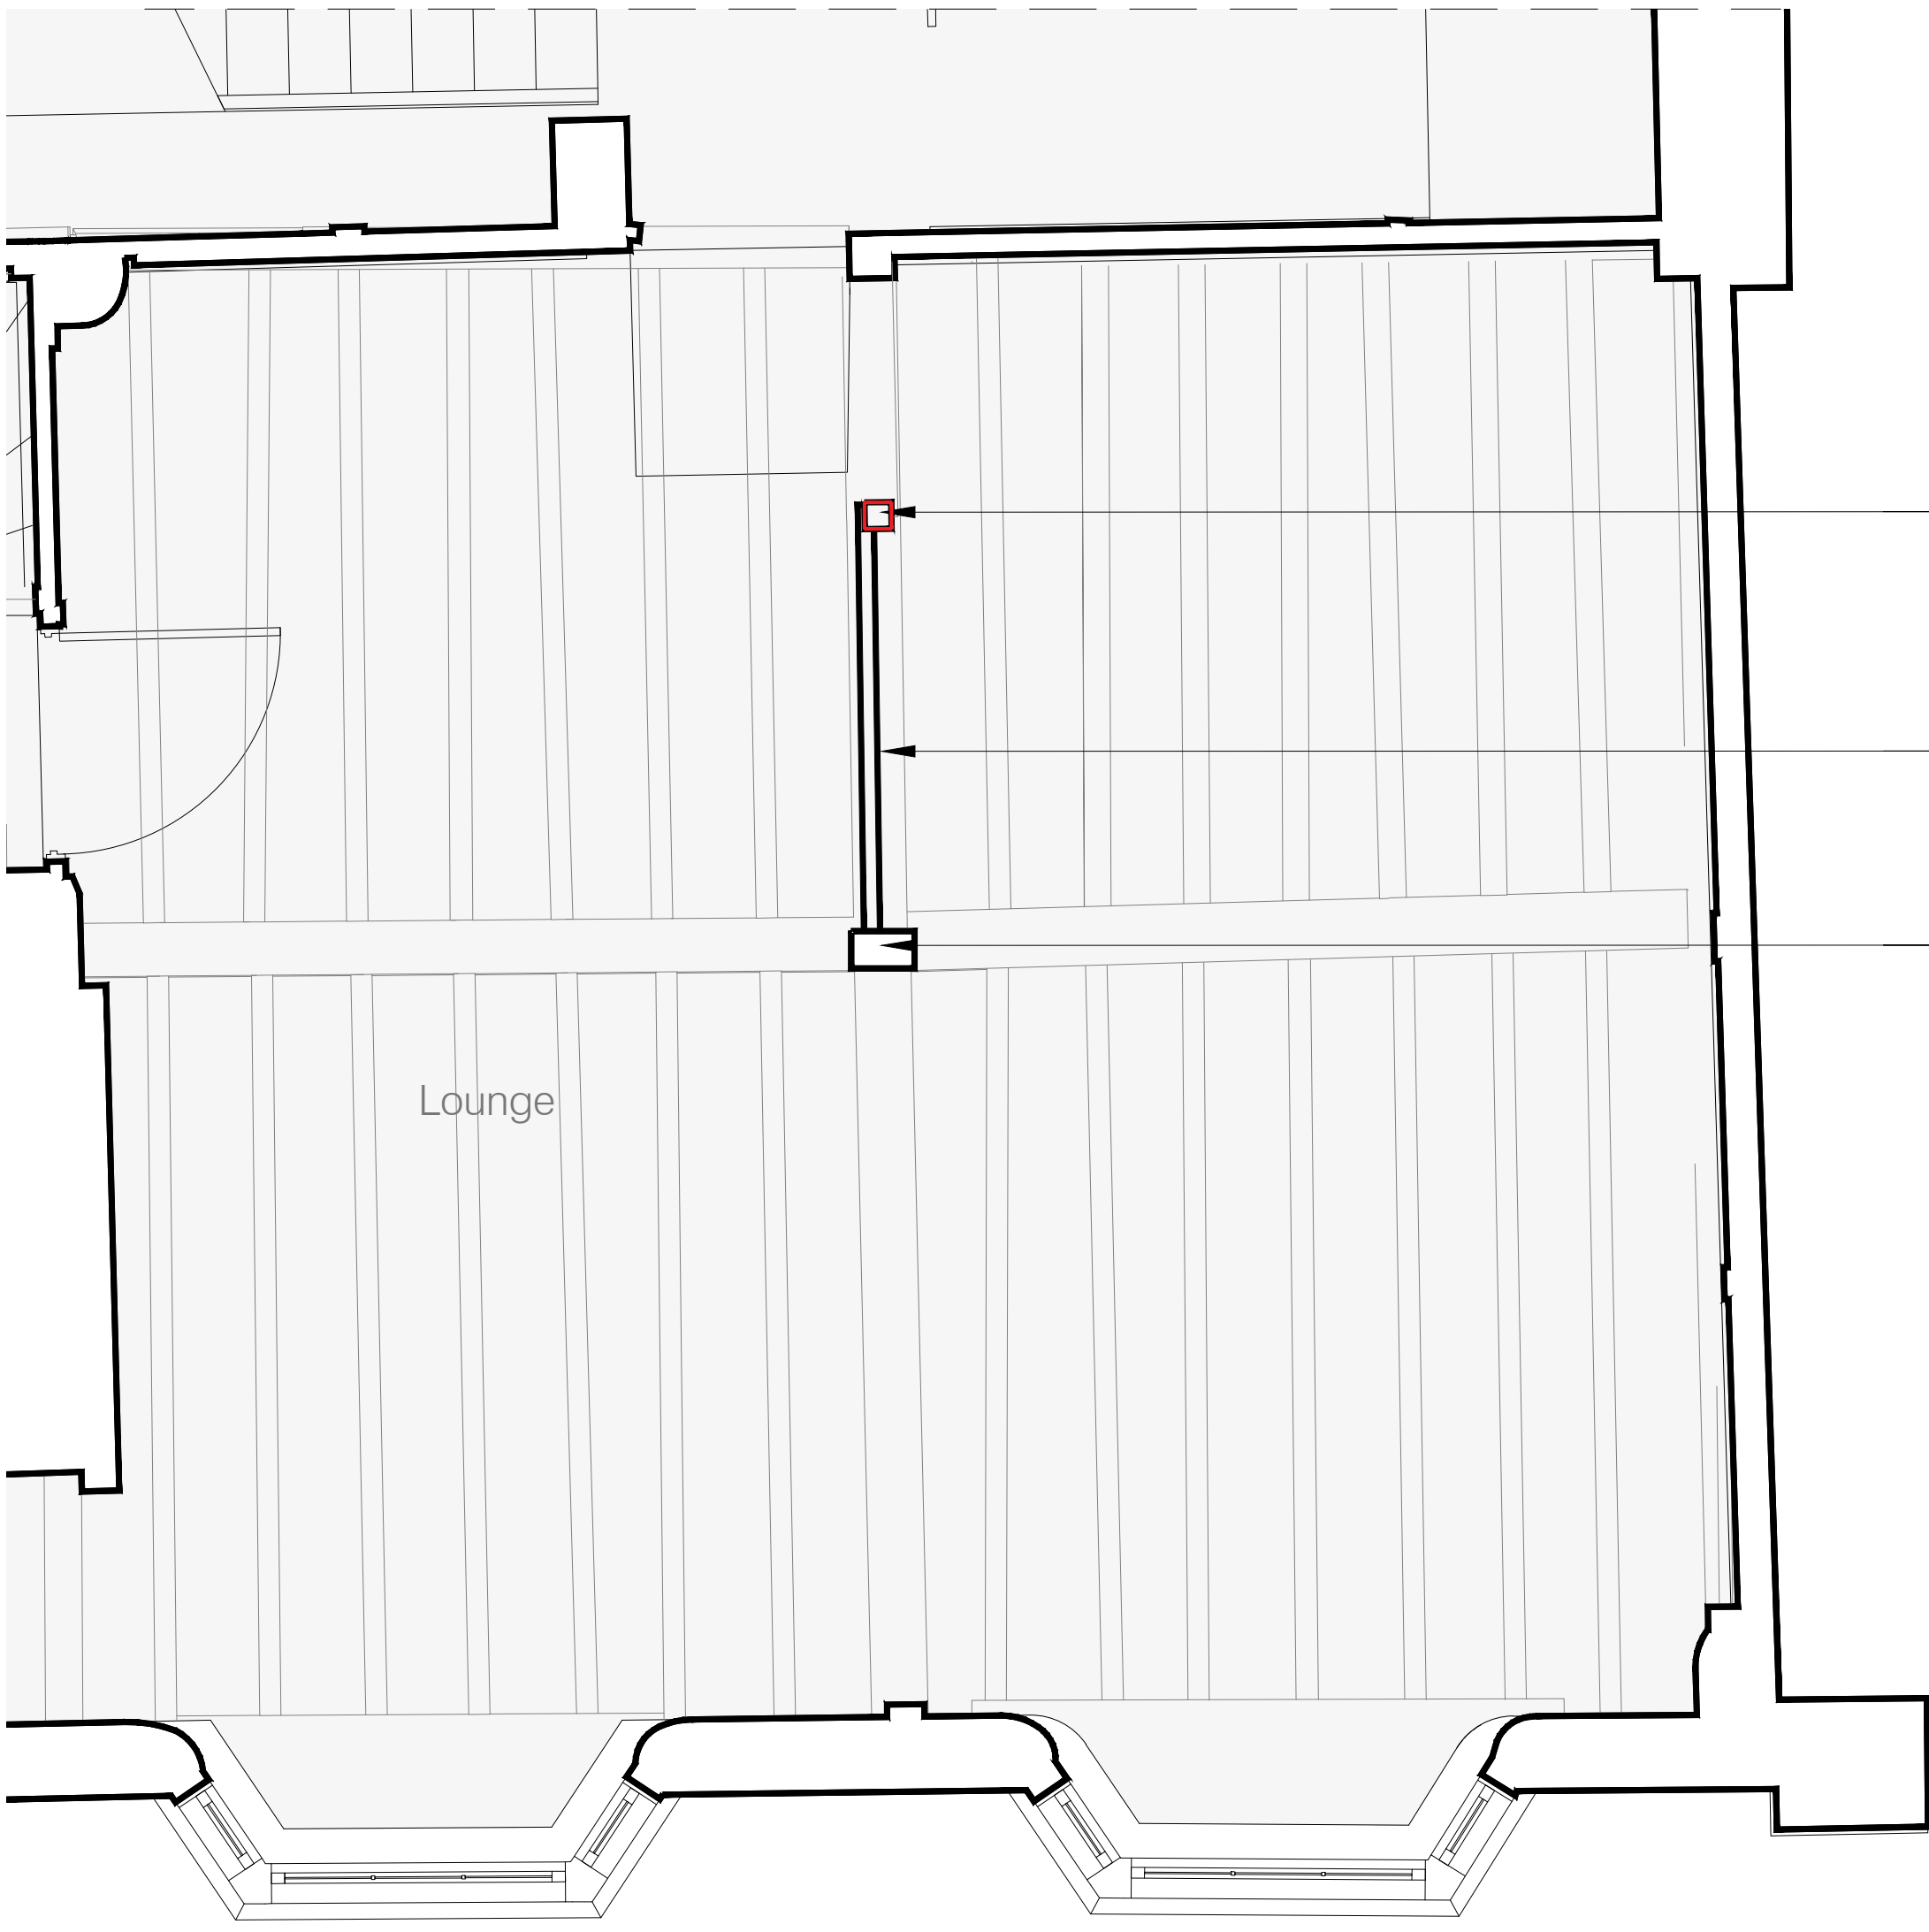

Proposed Scheme
Ground Floor Plan
Scale 1:25@A1 , 1:50@A3

Previously removed door jamb to be reinstated to make legible an original stud partition which was heavily altered in the 20th century.

Historic horizontal timber frame member to be reinstated, secured to the post for stability

Existing timber gunstock post




Internal lounge wall prior to changes.

Plaster panel infills removed

Historic door jamb to be reinstated
Steel post previously replaced with timber gunstock post

Historic horizontal timber frame member to be reinstated, secured to the post for stability


Non-original decorative wall fillet element previously removed

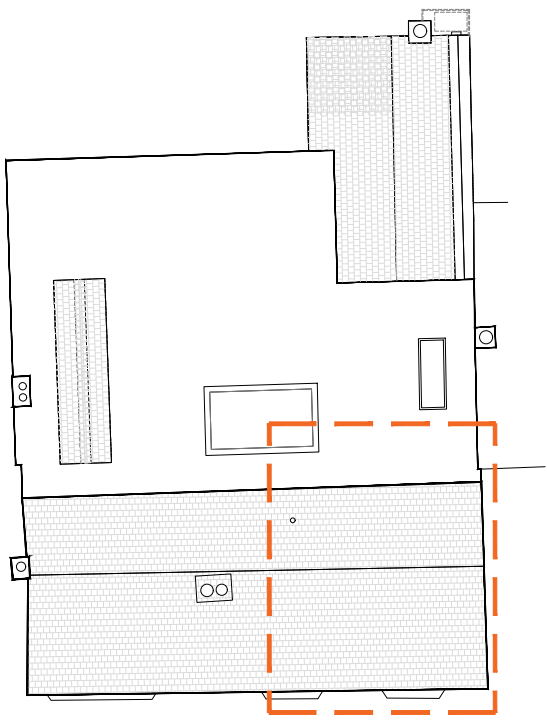

Key Plan 1:200@A1, 1:400@A3

NOTE
DRAWINGS TO BE READ IN CONJUNCTION WITH SUBMITTED DESIGN&ACCESS STATEMENT AND HERITAGE STATEMENT MATERIALS INSTALLED IN ACCORDANCE WITH THOSE OUTLINED IN CONDITION #9 OF APPROVAL DM/23/1605

KEY:
Highlighted difference between Approved Scheme and 'As-Built'/Proposed Scheme

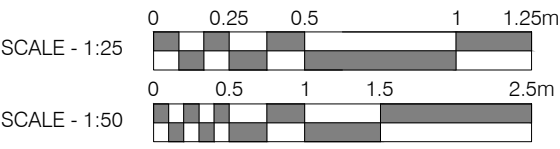

Rev:	Comments:	By:	Date:
A	Amendments as clouded.	KN	Nov 25

Do not scale this drawing All dimensions must be checked on site
All rights reserved. No reproduction in any material form is permitted without consent.

LISTED BUILDING CONSENT			
Client: Mr. Simon Dougall			
Project Title: 107 High St, Lindfield, Haywards Heath, West Sussex, RH16 2HR			
Drawing Title: Detail Drawings: Ground Floor North Lounge Reinstated Door Jamb			
Scale: 1:25@A1 1:50@A3	Date: Aug 25	Drawn: KN	Checked: KW

kyson ⁺ Studio		
28 Scrutton Street London UK EC2A 4RP		
T: +44(0) 20 7247 2462 E: enquiries@kyson.co.uk W: www.kyson.co.uk		
Project No.: 900-25	Drawing No.: 5026	Revision: A