




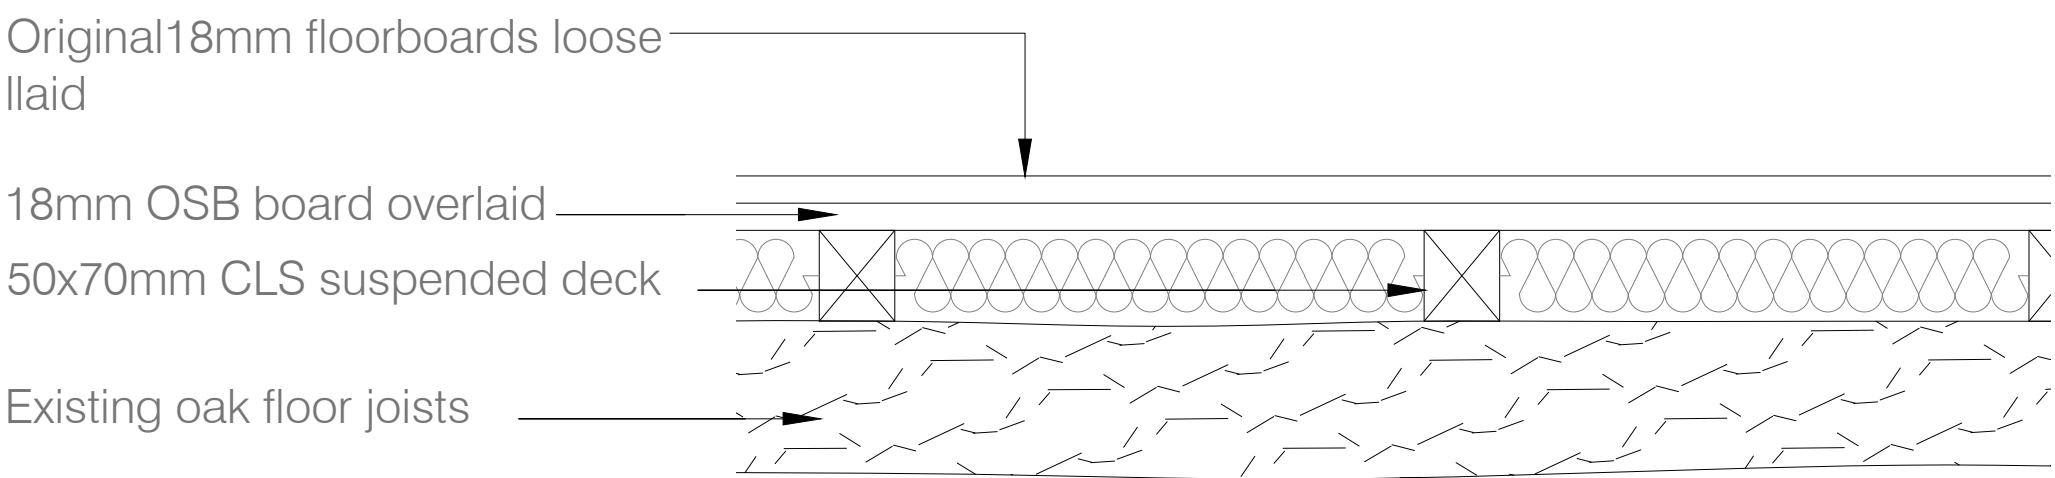


Detail 1
Existing Attic Floor Build-Up
Scale 1:5@A1
1:10@A3

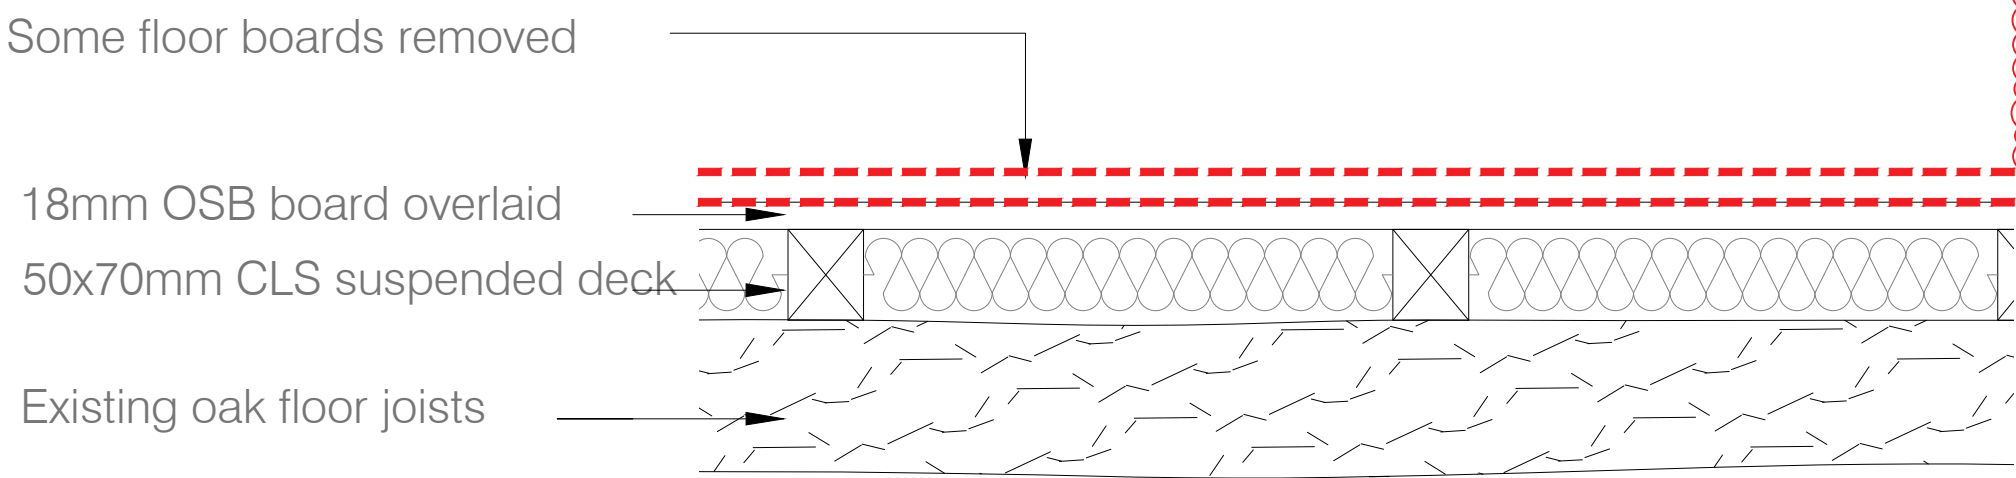


Detail 2
'As Built' Attic Floor Build-Up
Scale 1:5@A1
1:10@A3

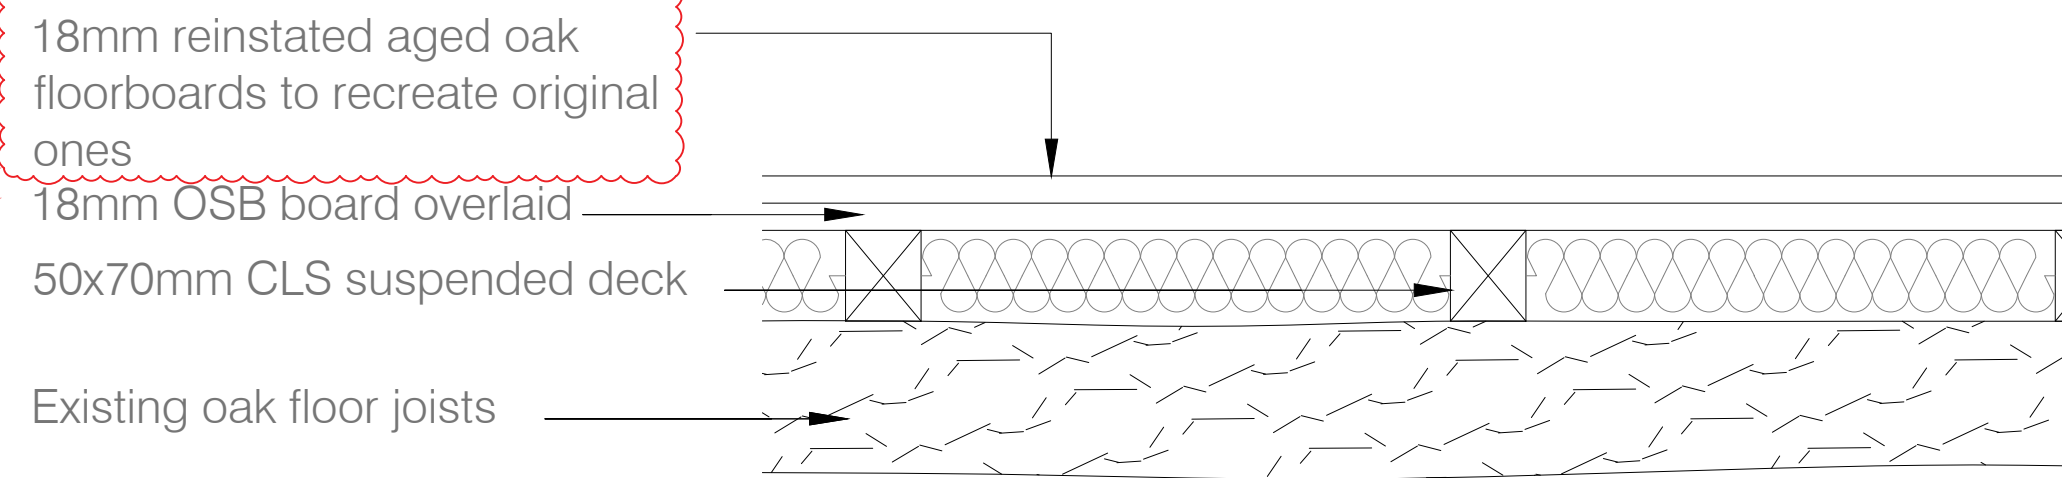


Detail 3
Proposed Attic Floor Build-Up
Scale 1:5@A1
1:10@A3

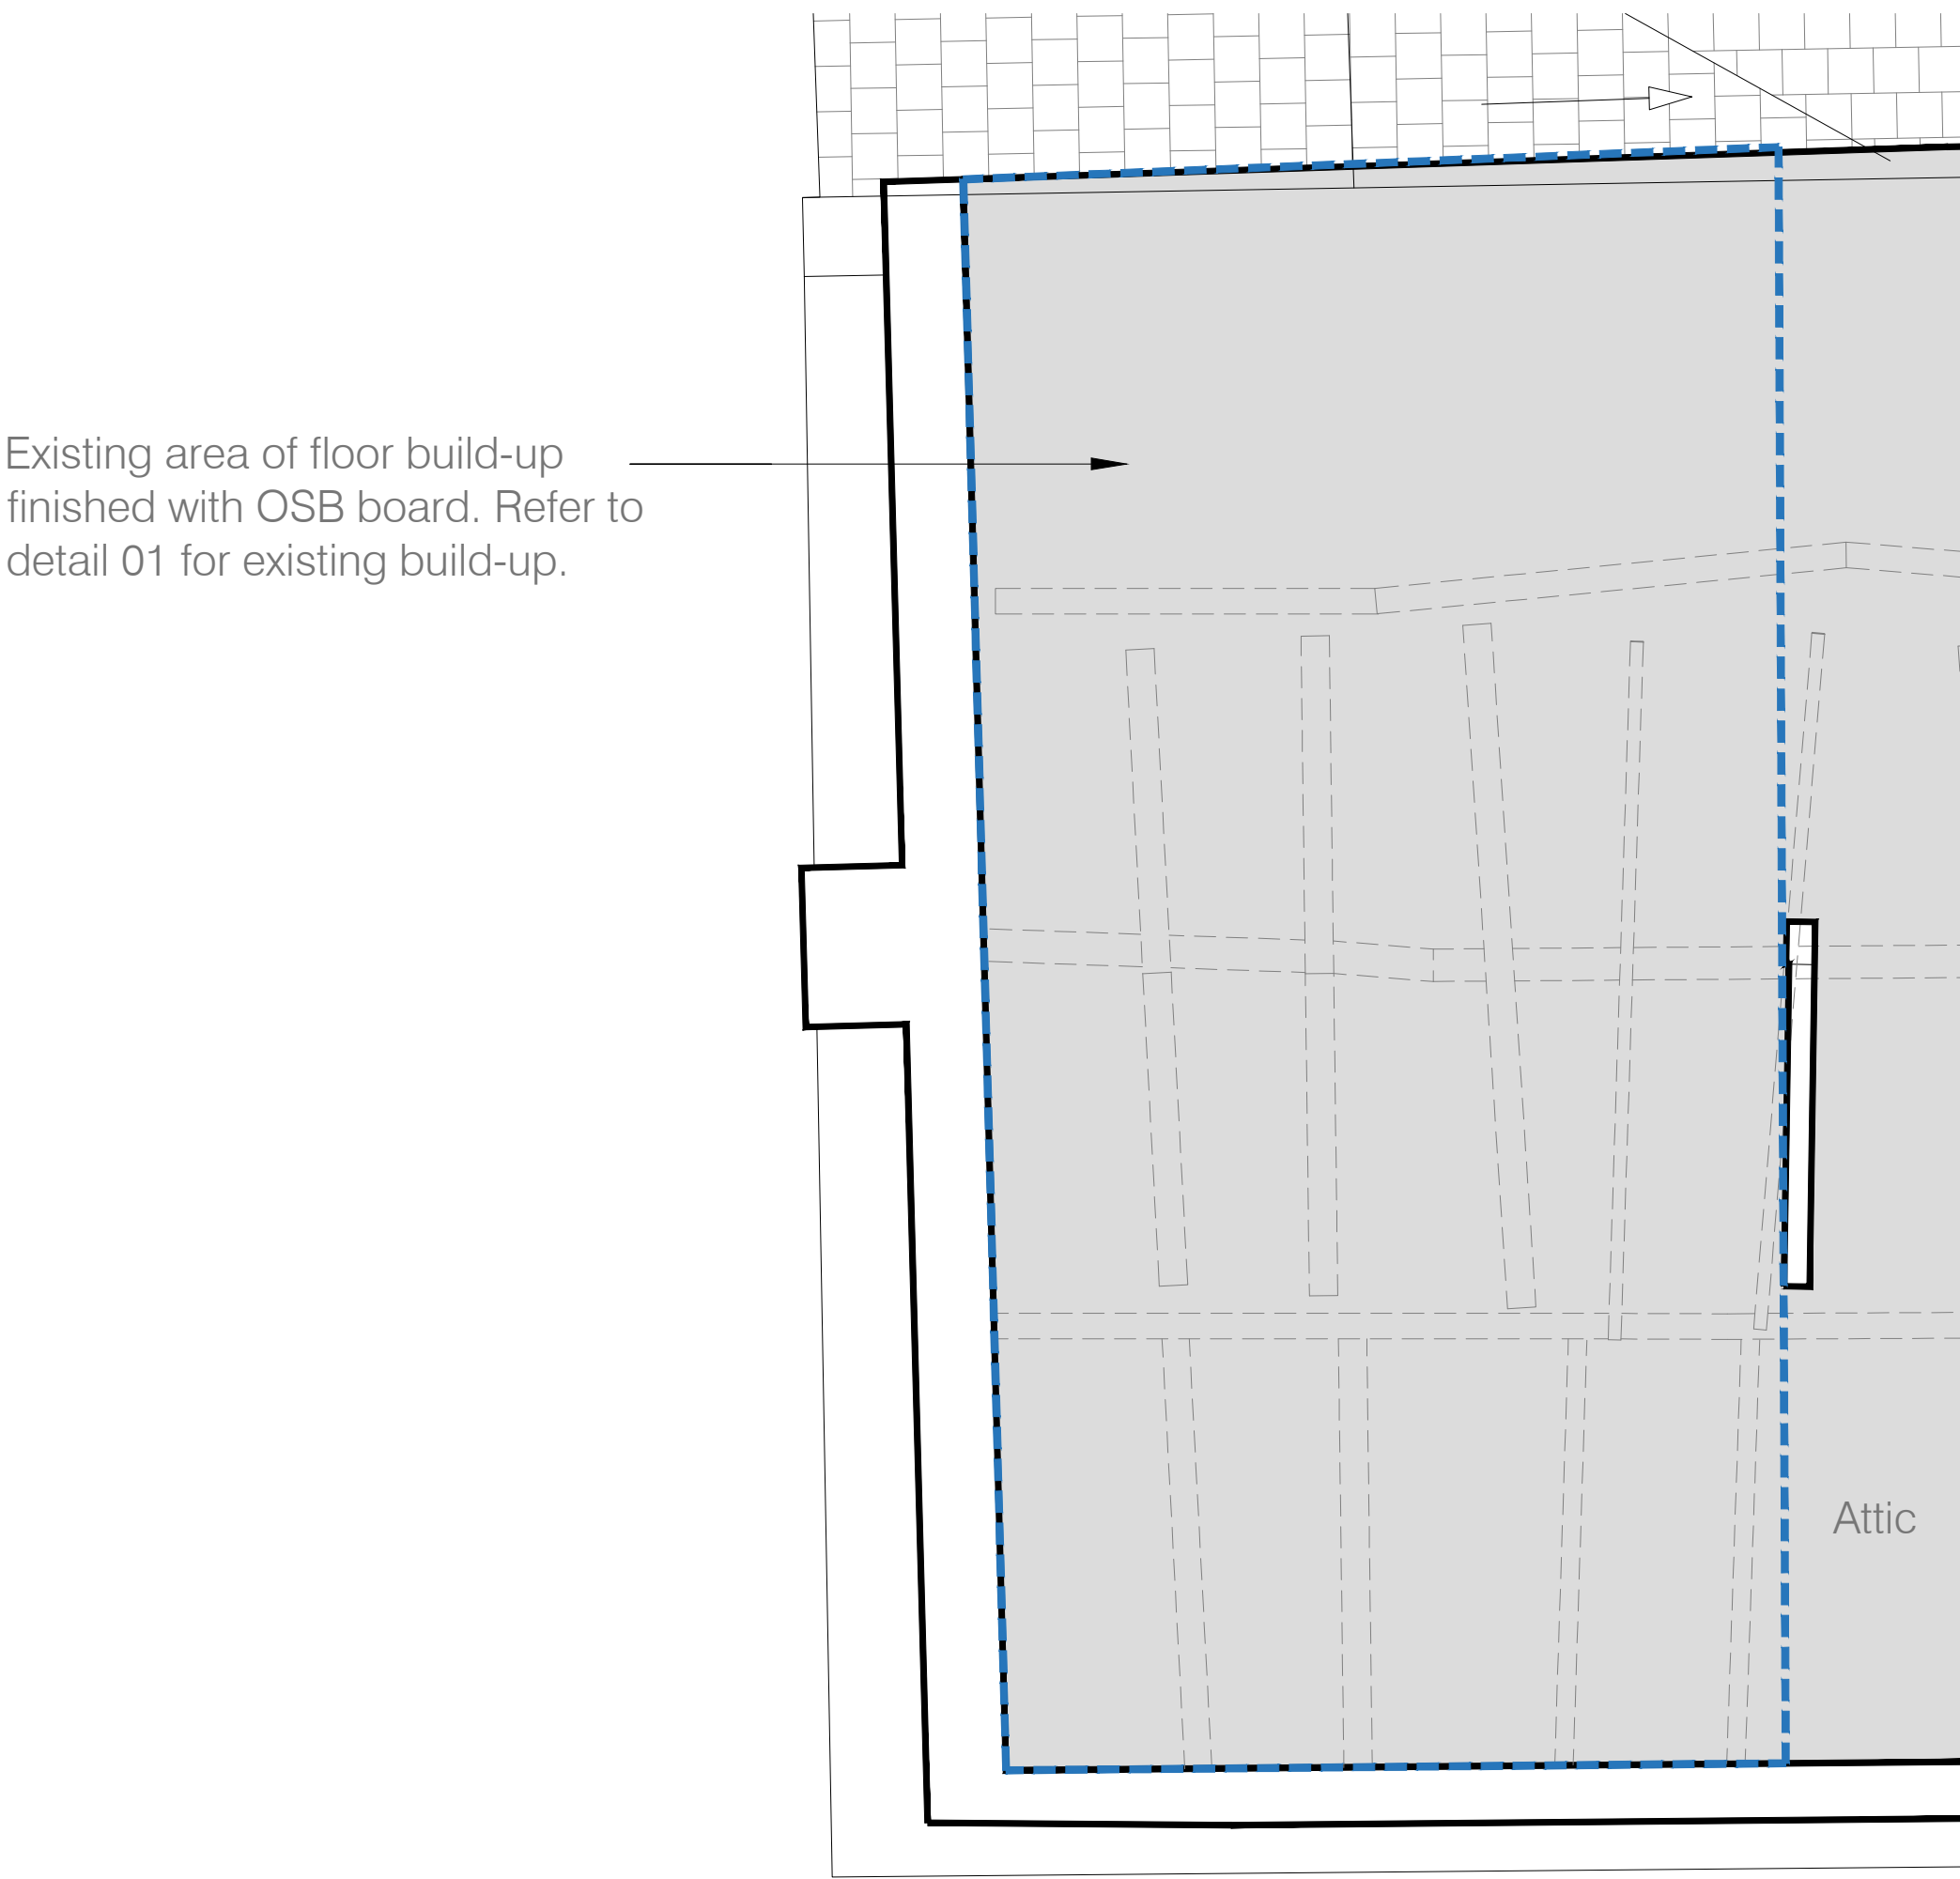


Key Plan
Existing Attic Plan
Scale 1:25@A1
1:50@A3

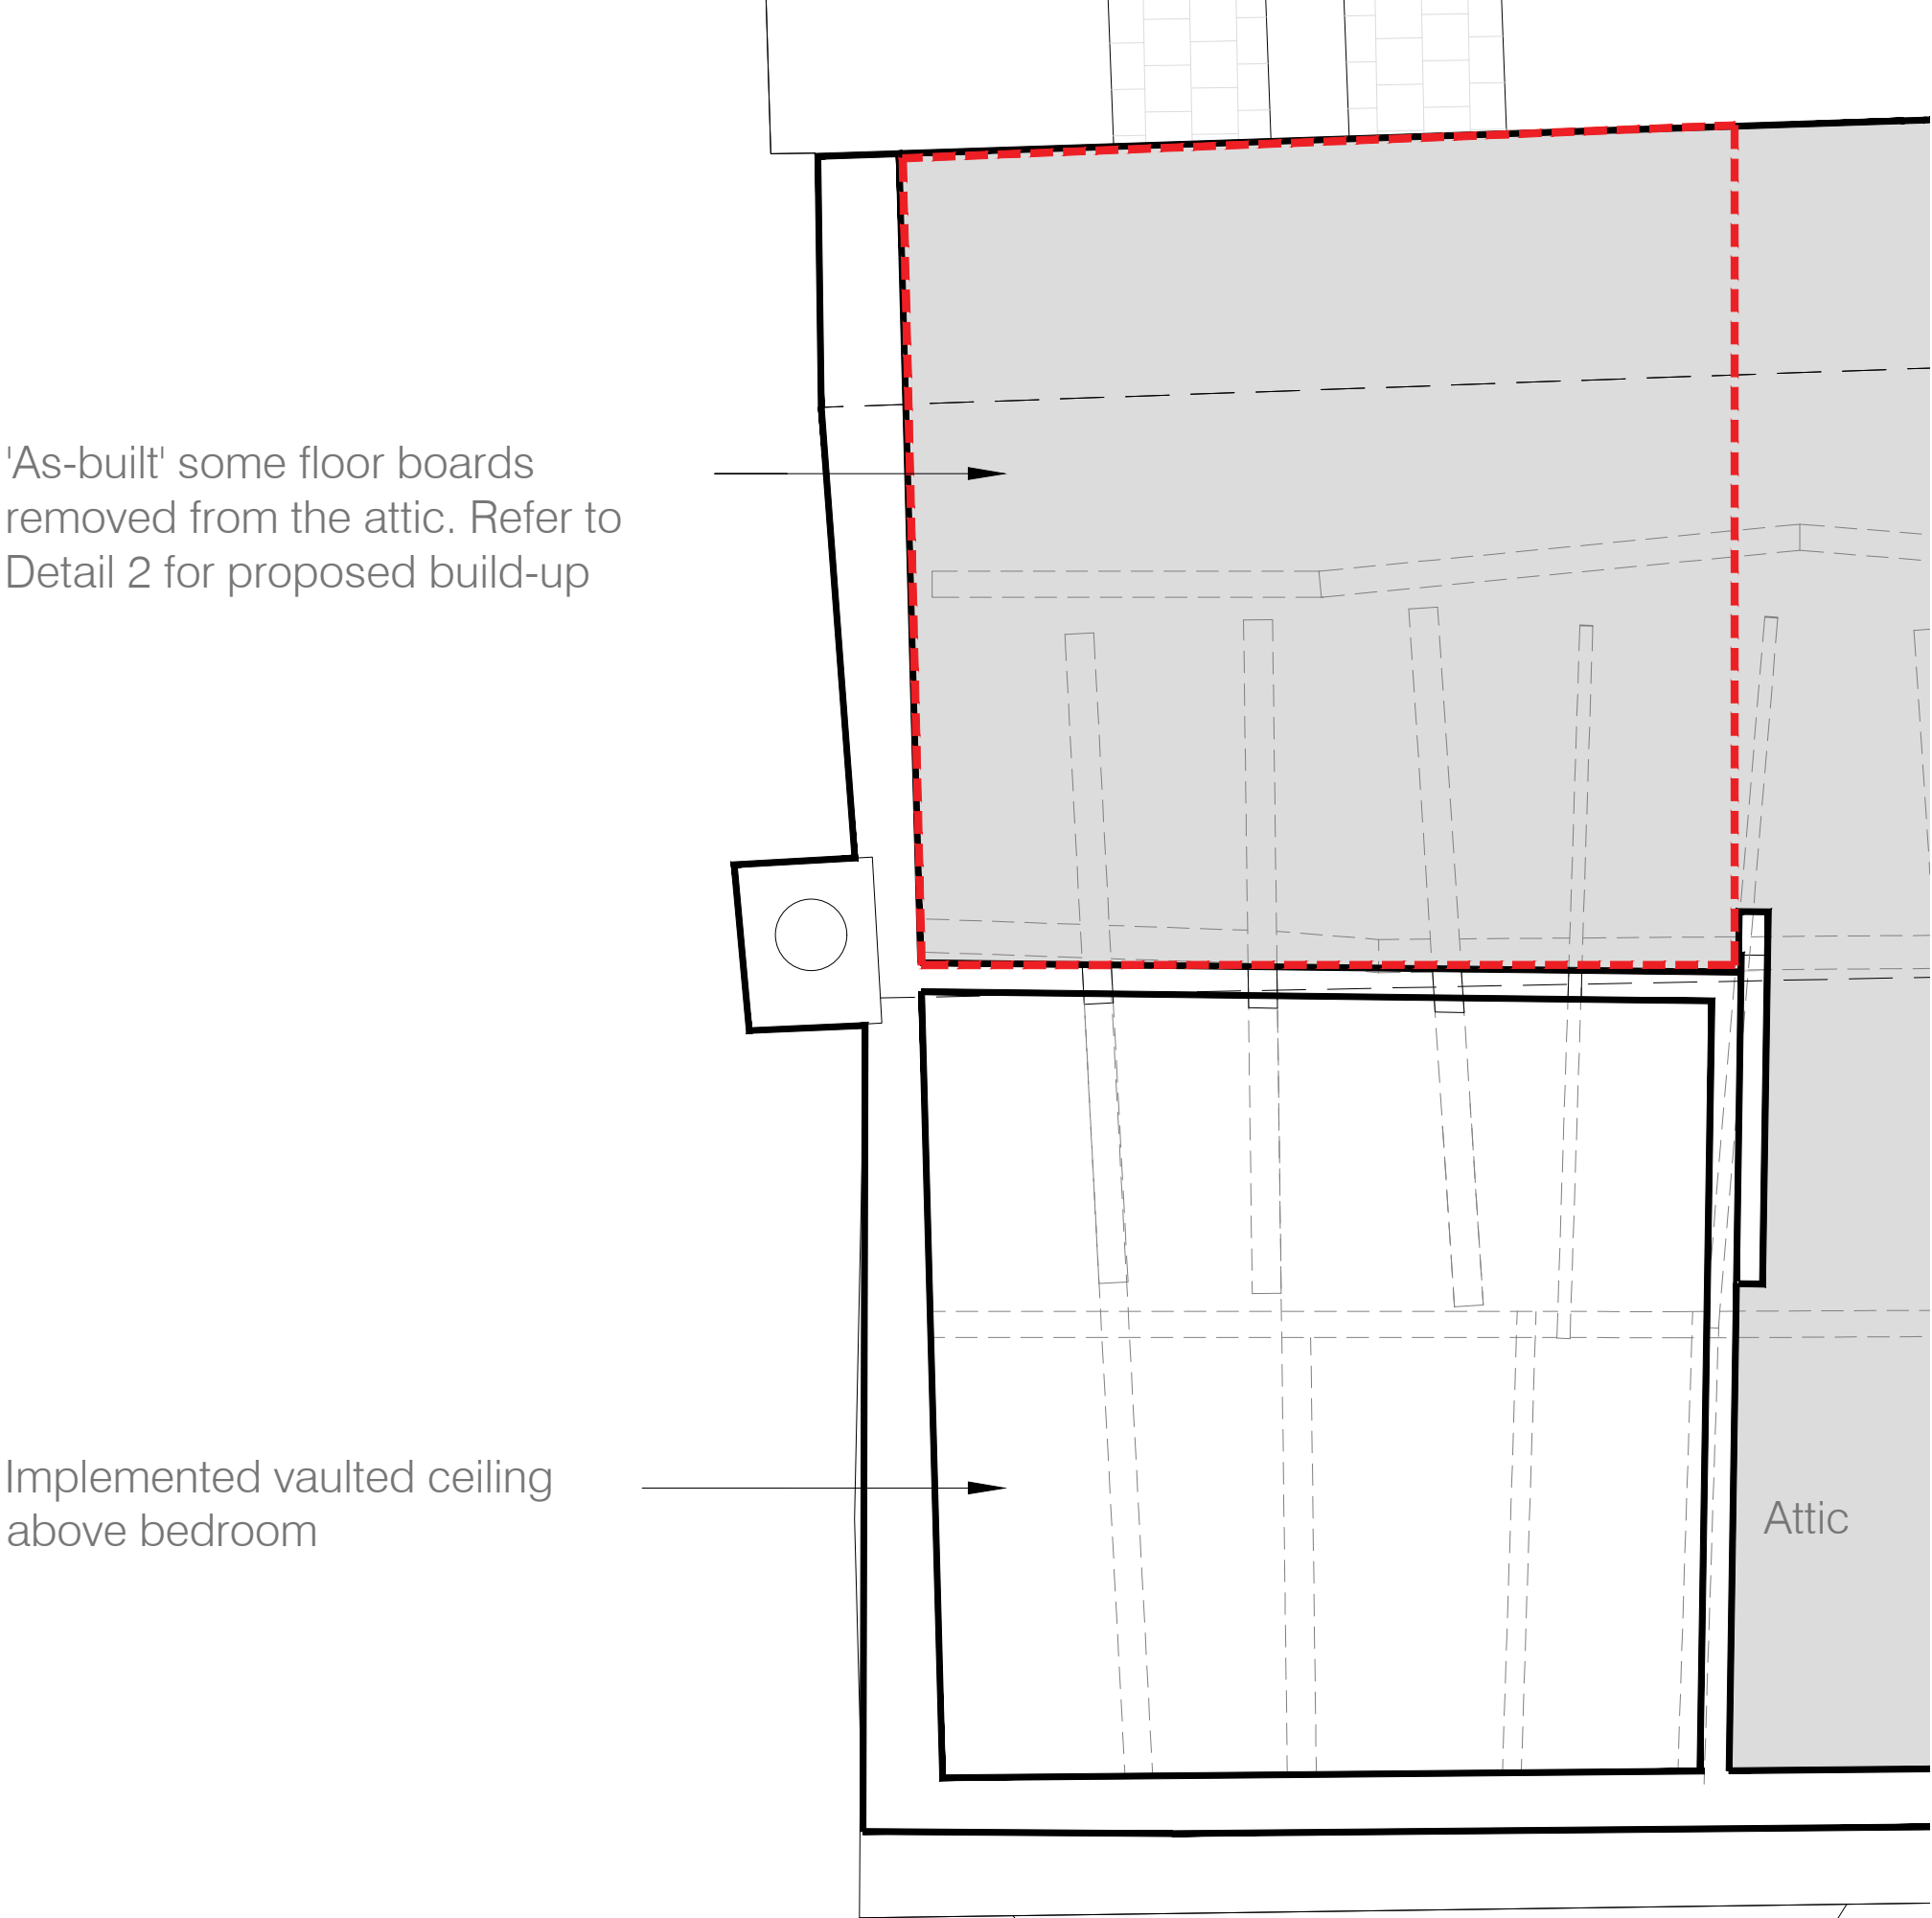

Key Plan
'As-Built' Attic Plan
Scale 1:25@A1
1:50@A3

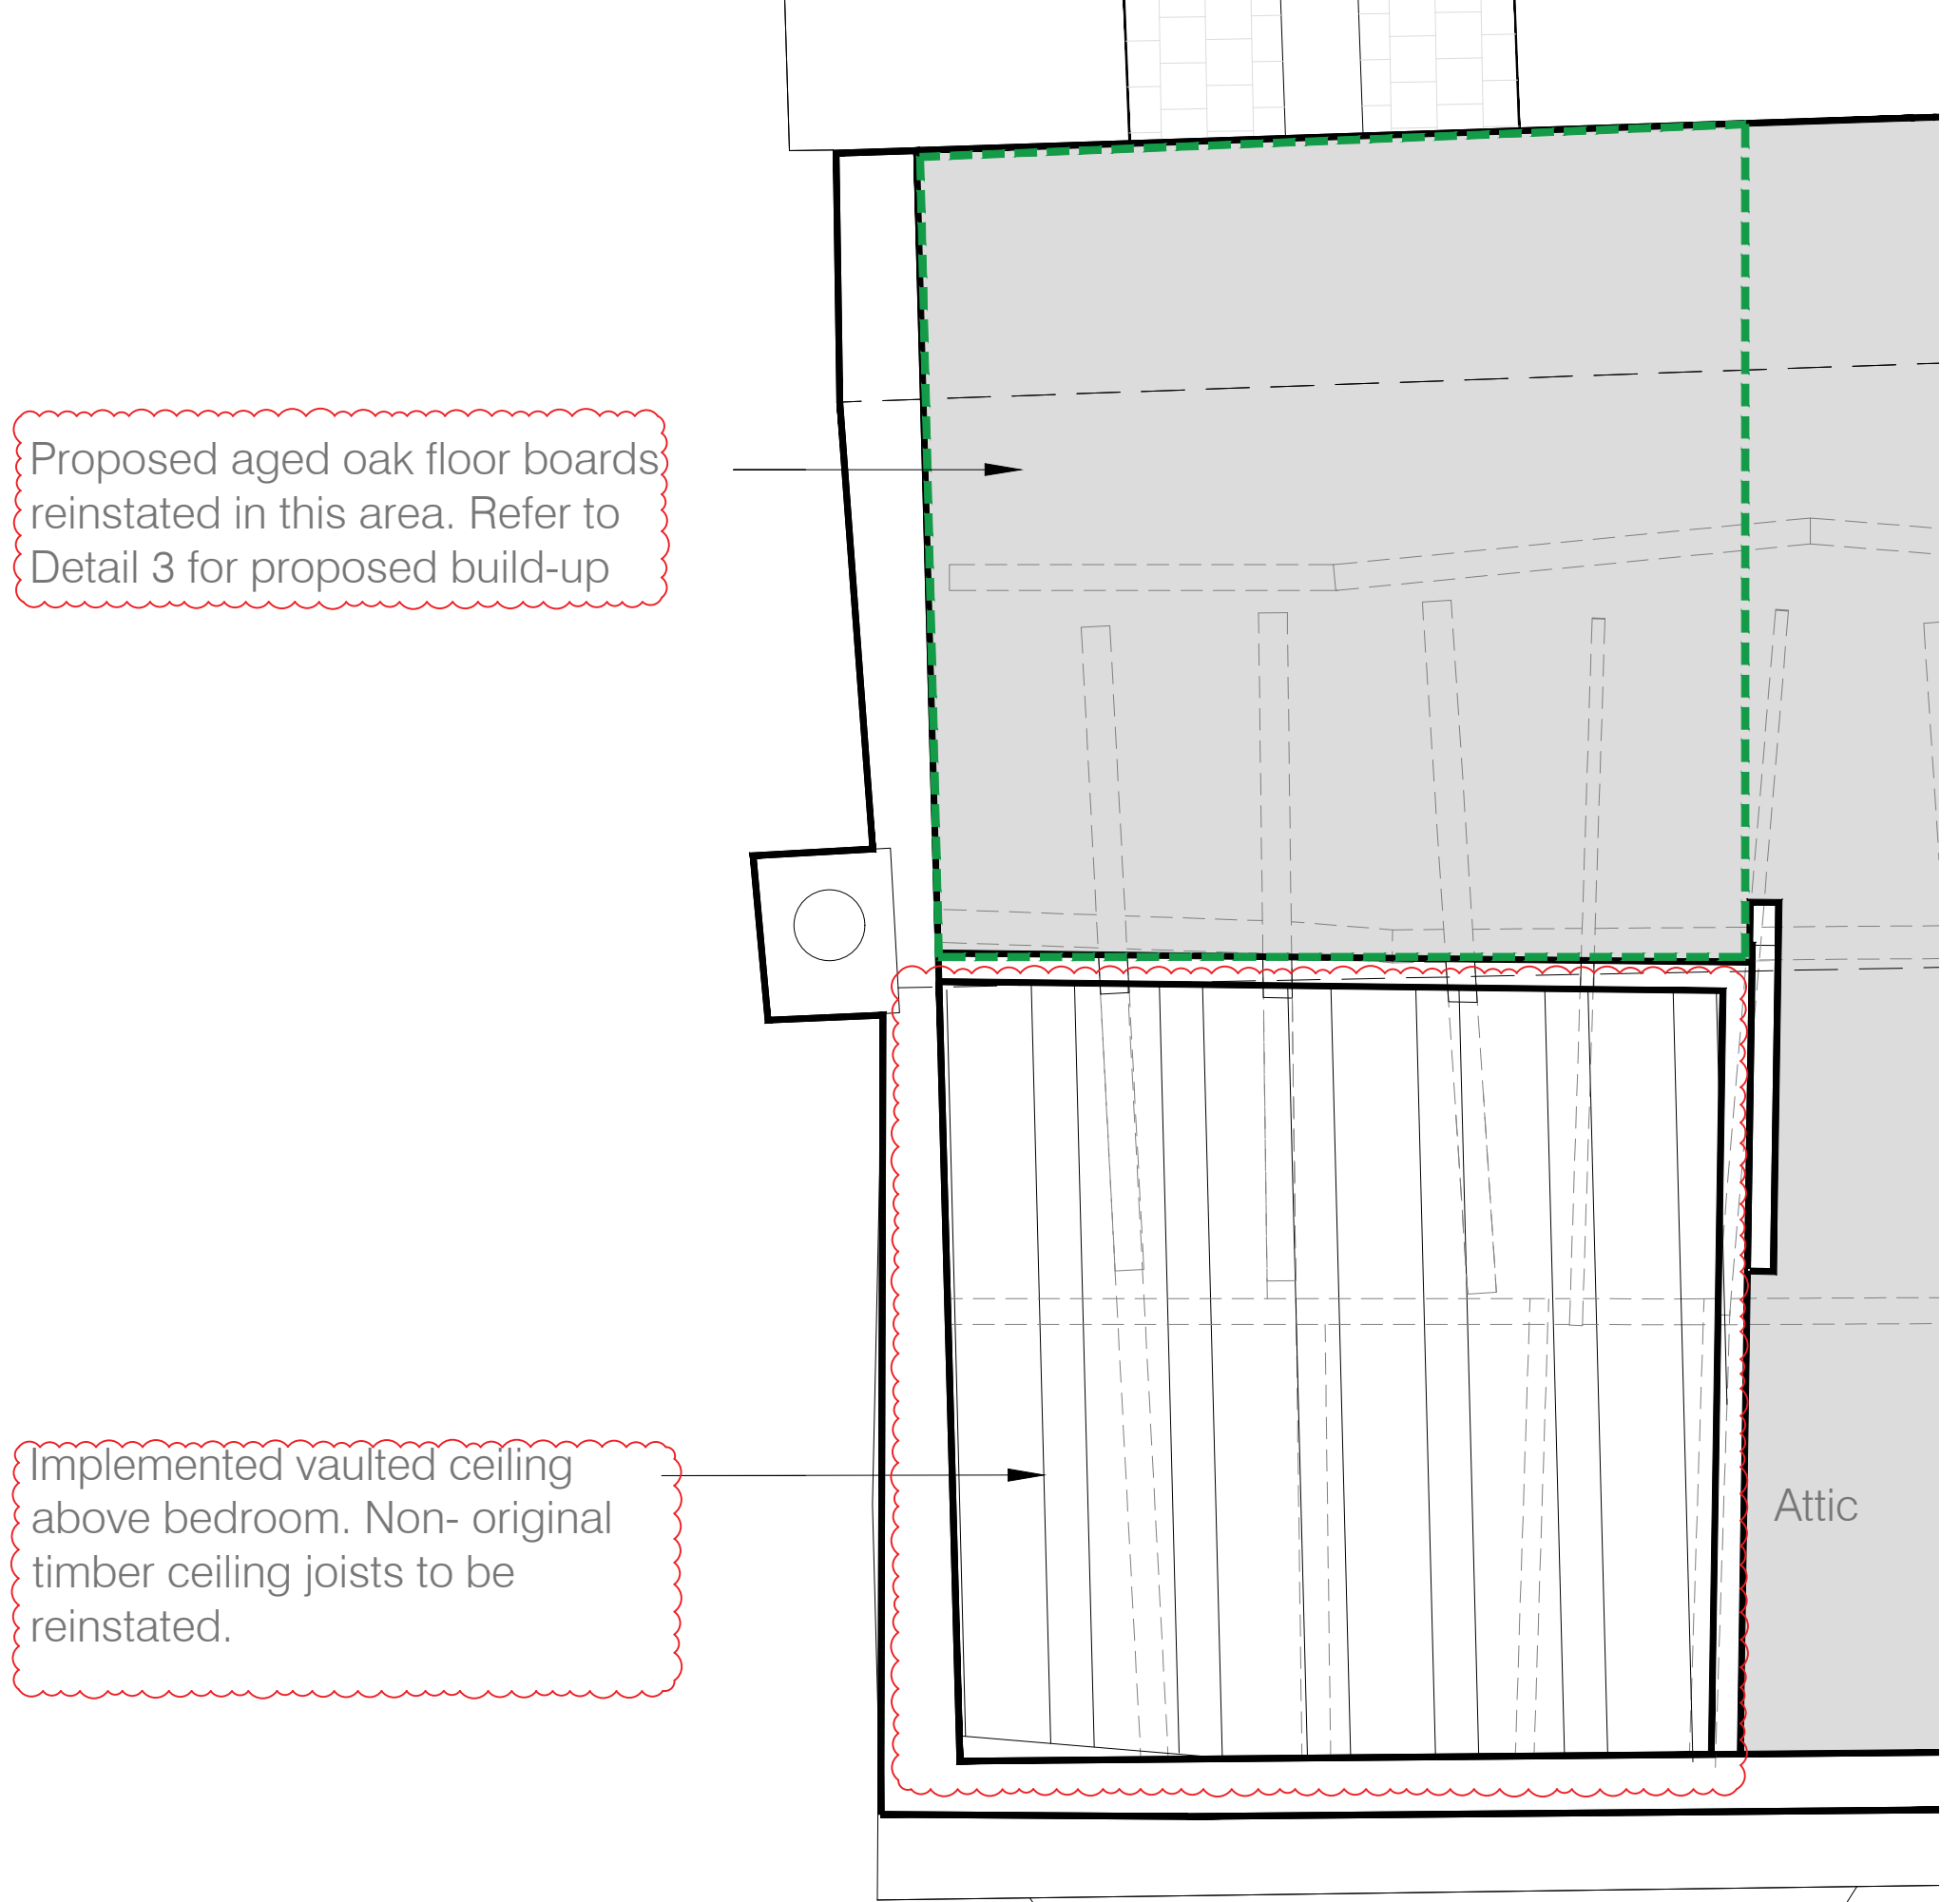


Key Plan
Proposed Attic Plan
Scale 1:25@A1
1:50@A3

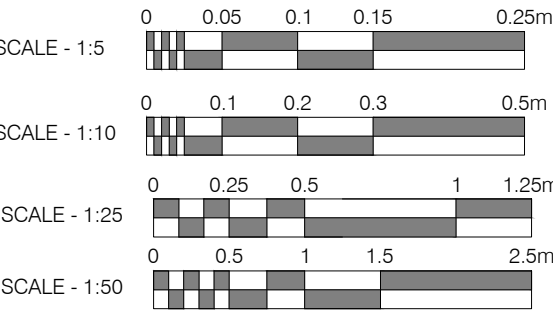

NOTE
DRAWINGS TO BE READ IN CONJUNCTION WITH SUBMITTED
DESIGN&ACCESS STATEMENT AND HERITAGE STATEMENT.

INFORMATION ON THE EXISTING AND PROPOSED MATERIALS
AND BUILD-UPS WERE OBTAINED FROM THE CONTRACTOR.

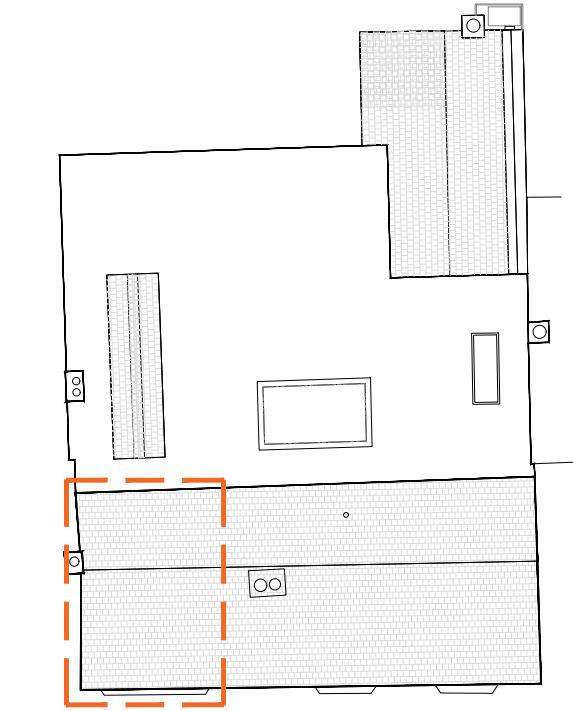

Key Plan 1:200@A1, 1:400@A3

Rev.				Comments:	By:	Date:
A				Amendments as clouded.	KN	Nov 25

Do not scale this drawing All dimensions must be checked on site.
All rights reserved. No reproduction in any material form is permitted without consent.

LISTED BUILDING CONSENT			
Client: Mr. Simon Dougall			
Project Title: 107 High St, Lindfield, Haywards Heath, West Sussex, RH16 2HR			
Drawing Title: Detail Drawings: Attic Floor Boards			
Scale:	Date:	Drawn:	Checked:
1:25@A1 1:5@A1 1:50@A3 1:10@A3	Sep 25	KN	KW

kyson		
Studio		
28 Scrutton Street London UK EC2A 4RP		
T: +44(0) 20 7247 2462 E: enquiries@kyson.co.uk W: www.kyson.co.uk		
Project No.:	Drawing No.:	Revision:
900-25	5029	A