




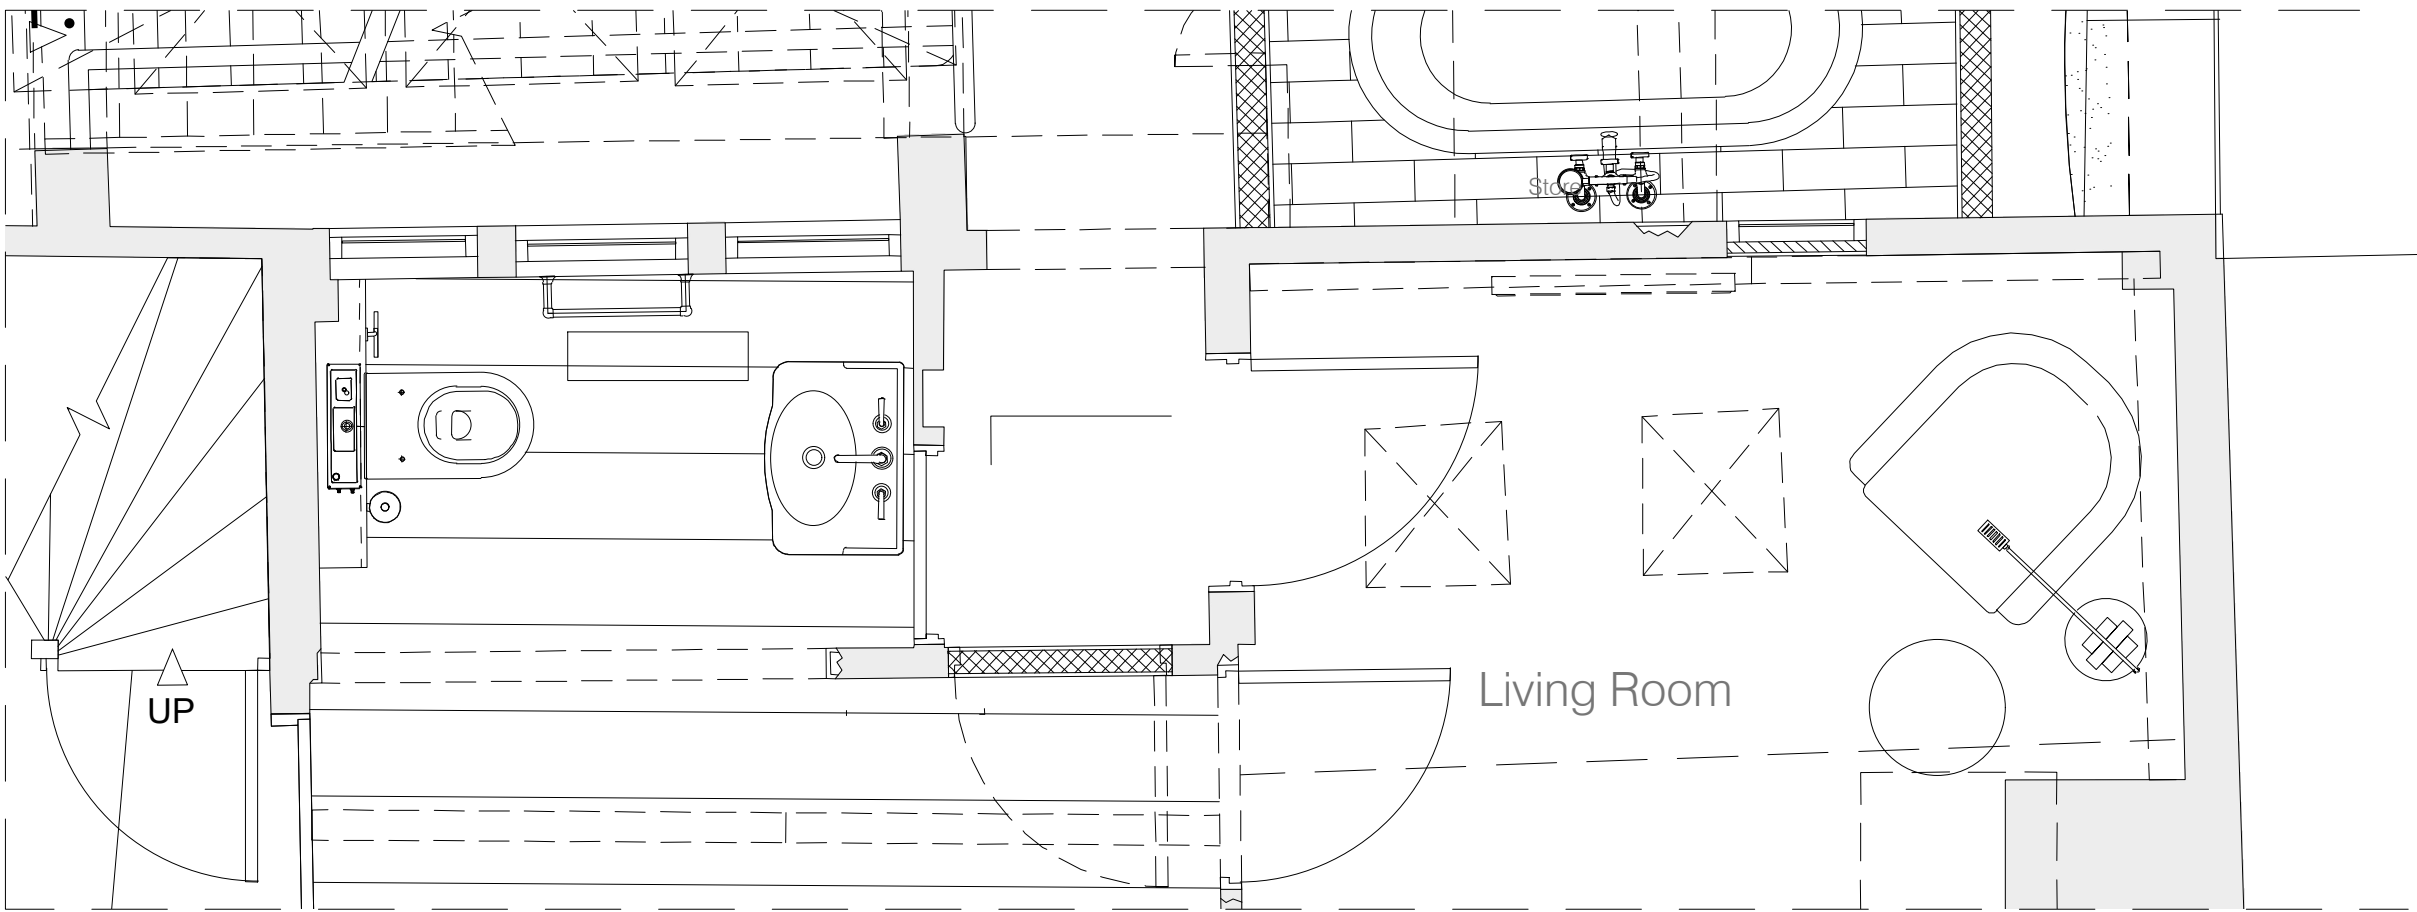

Approved Scheme
First Floor Plan
Scale 1:25:A1
1:50@A3


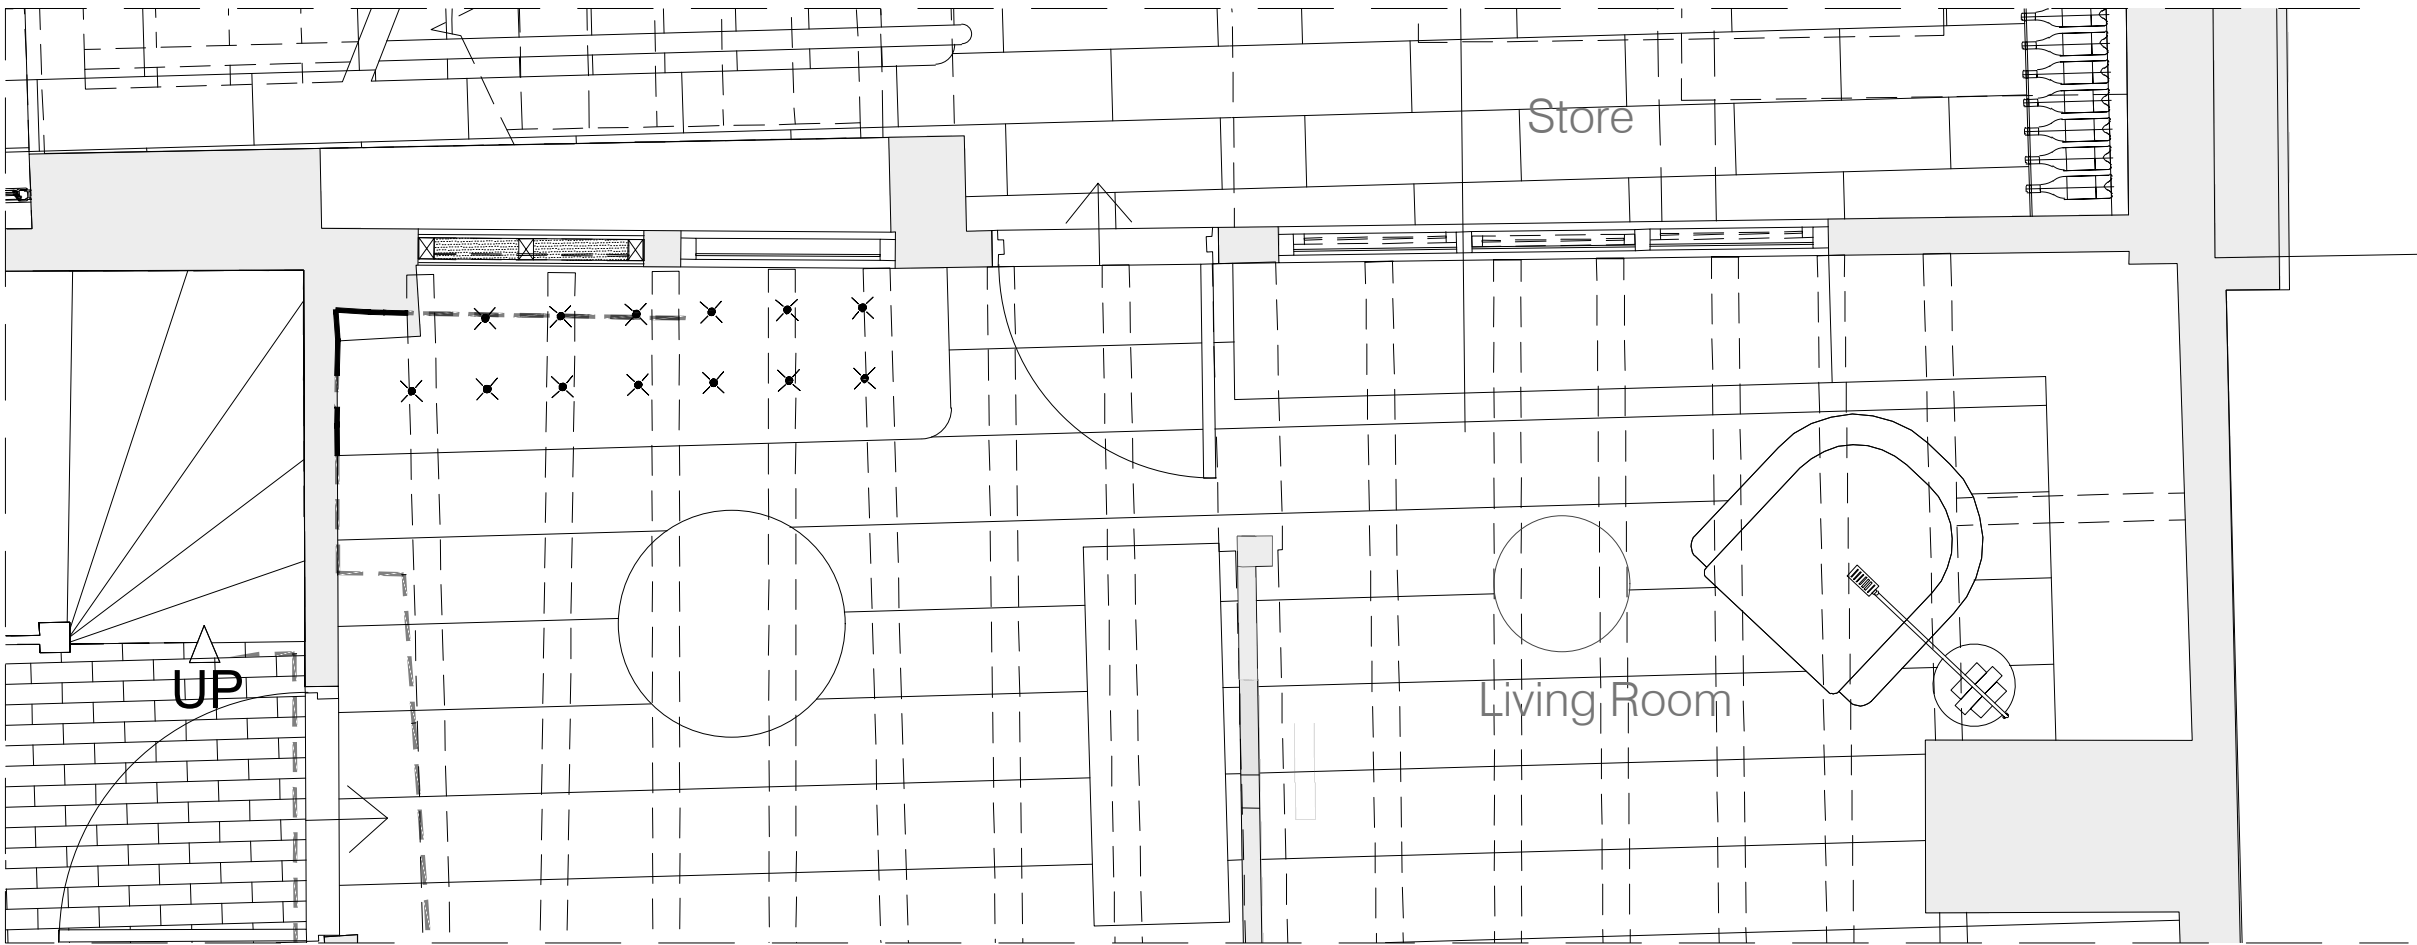


Approved Scheme
Ground Floor Plan
Scale 1:25:A1
1:50@A3

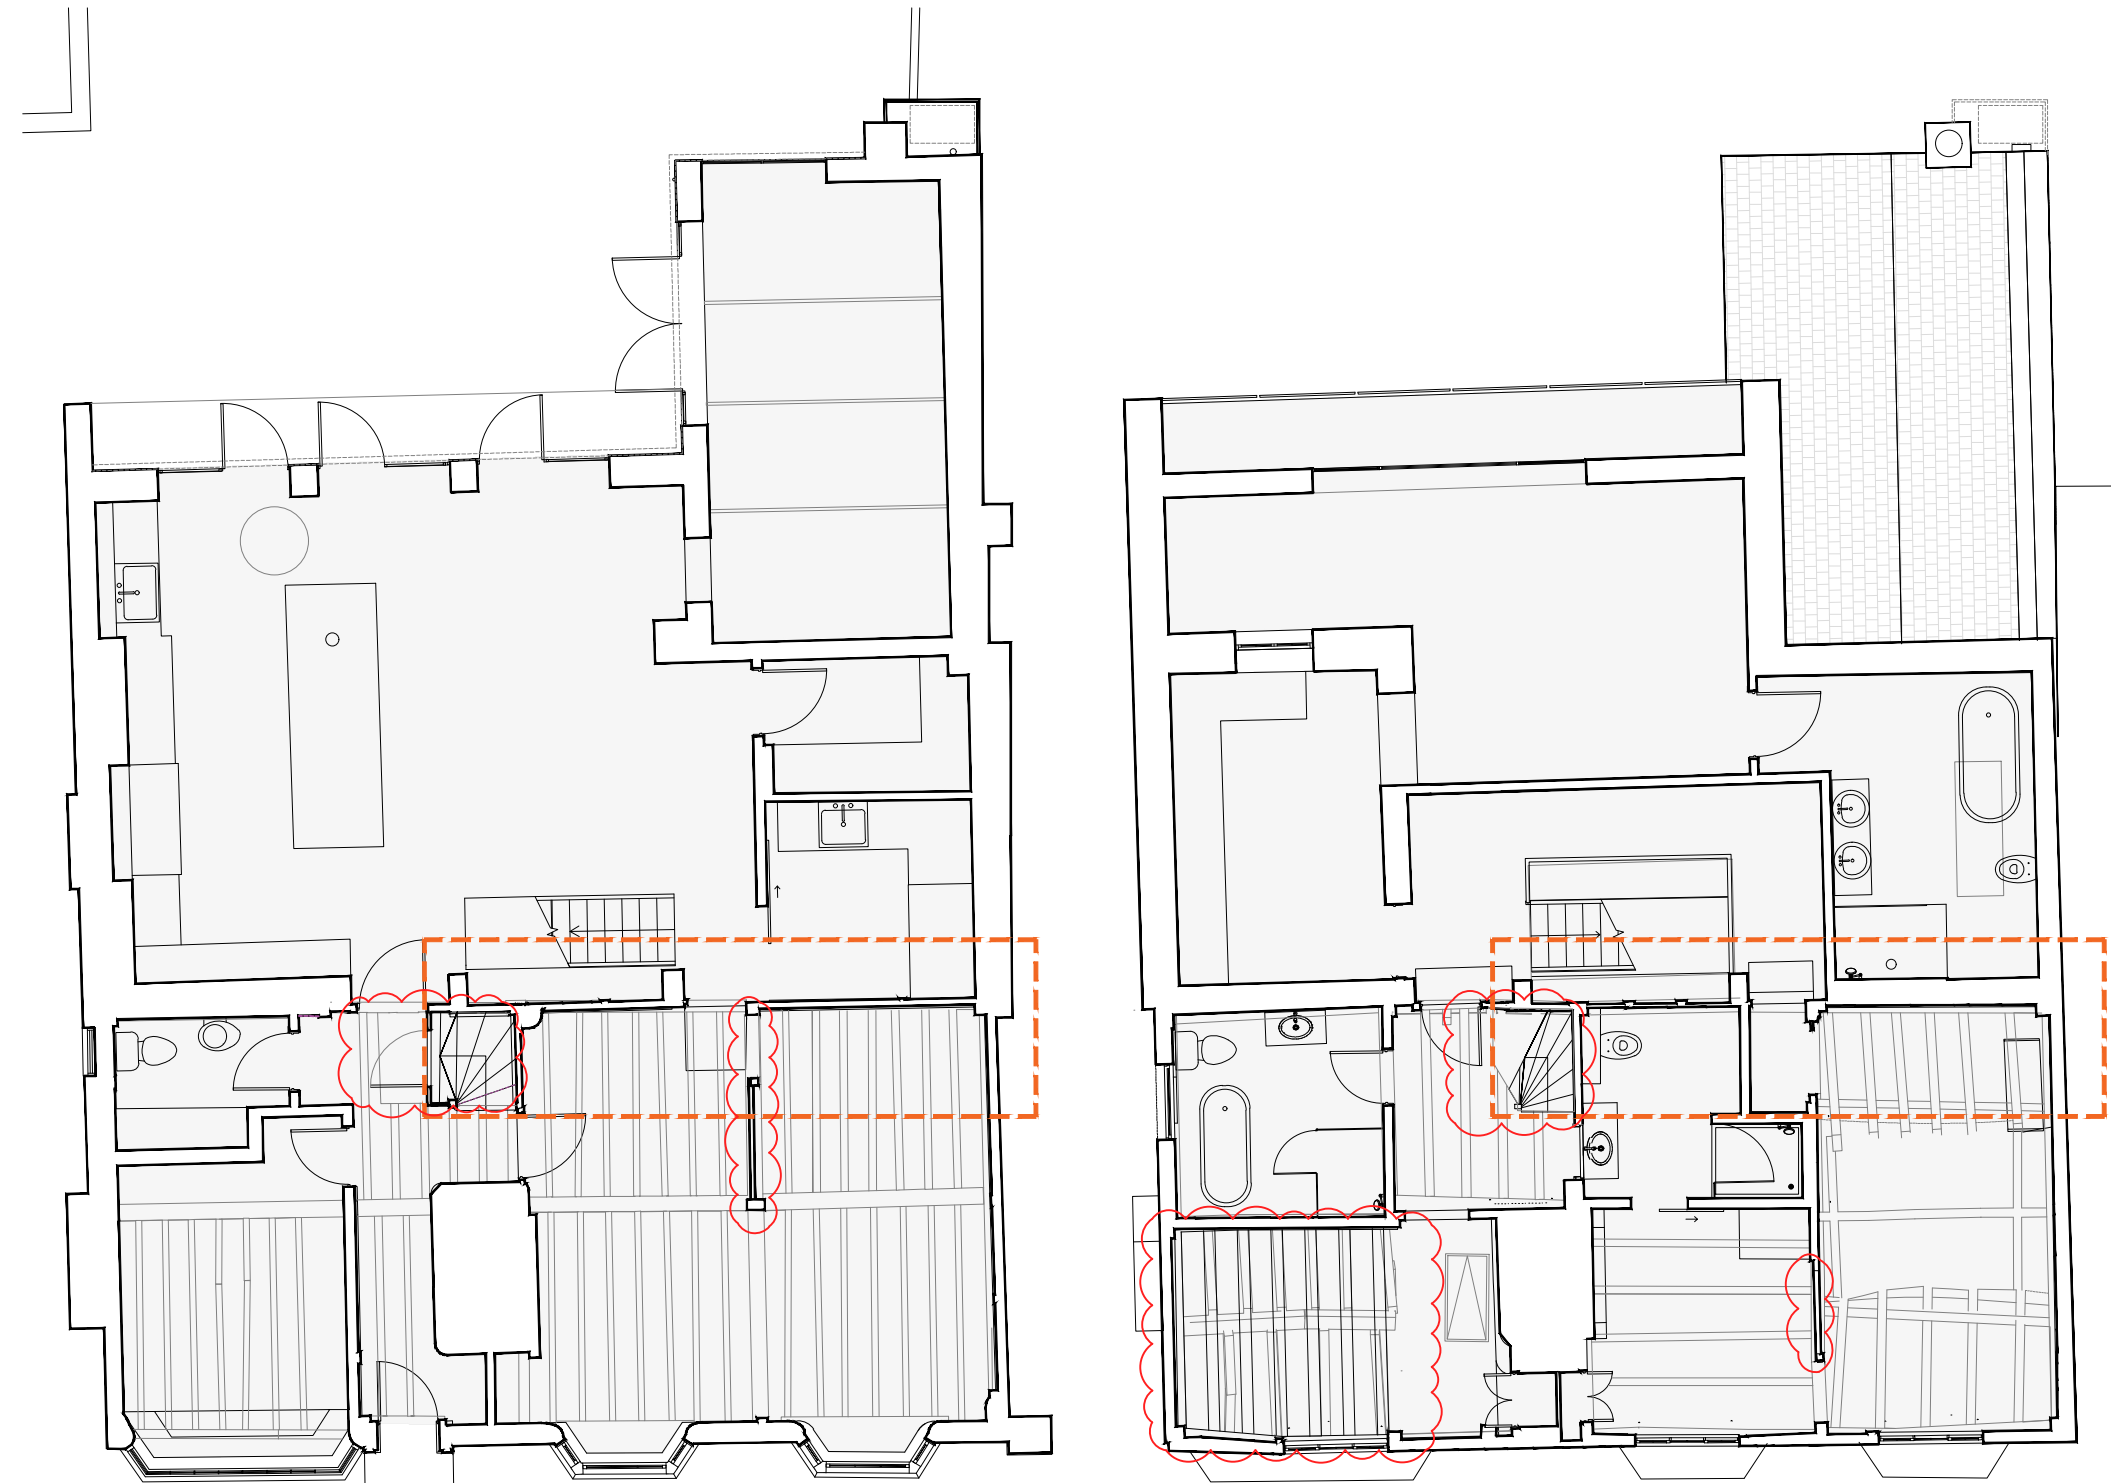


KEY Ground Floor Plan

KEY First Floor Plan

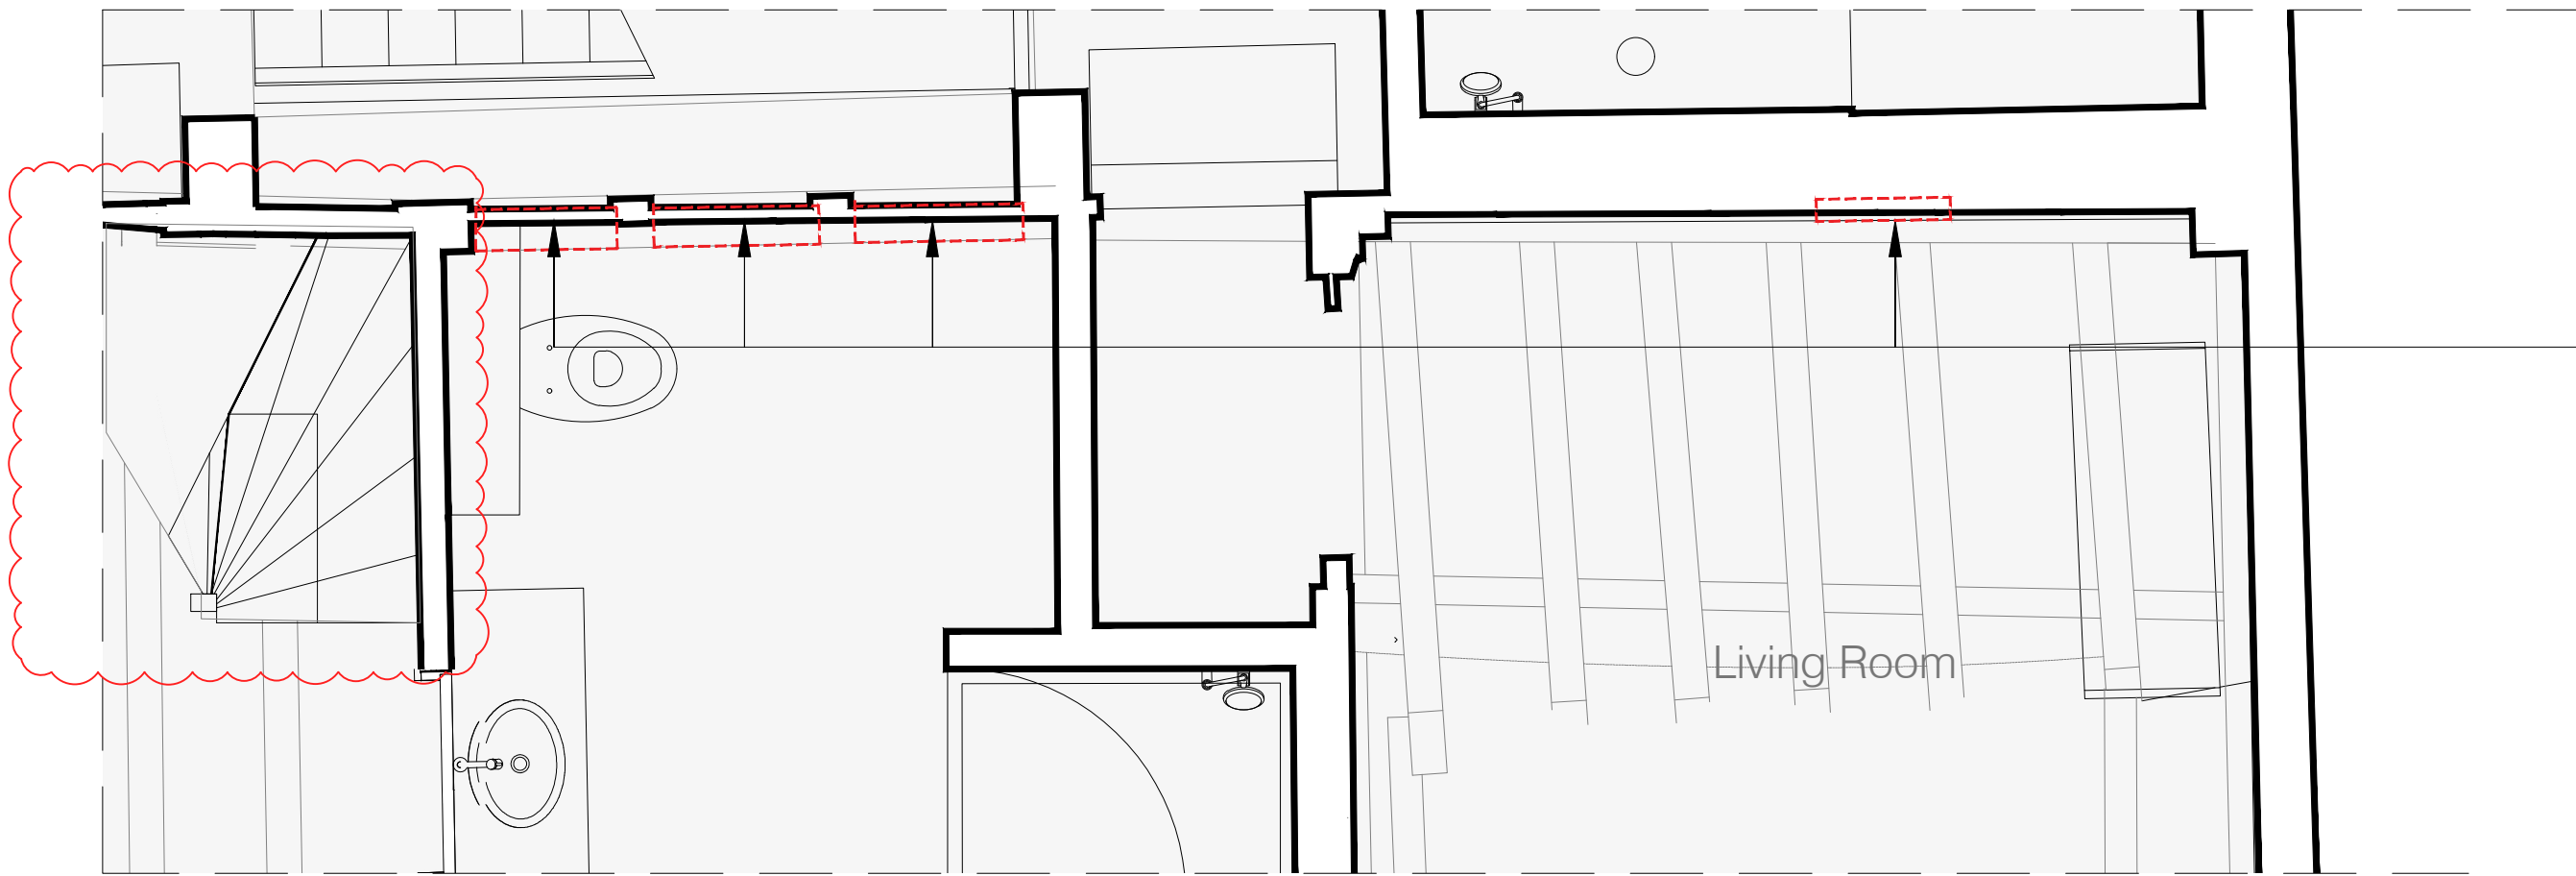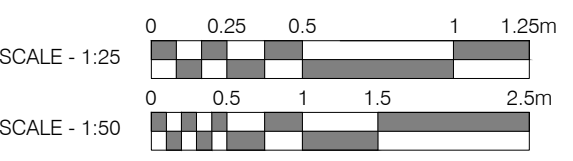

'As Built/ Proposed
First Floor Plan
Scale 1:25:A1
1:50@A3

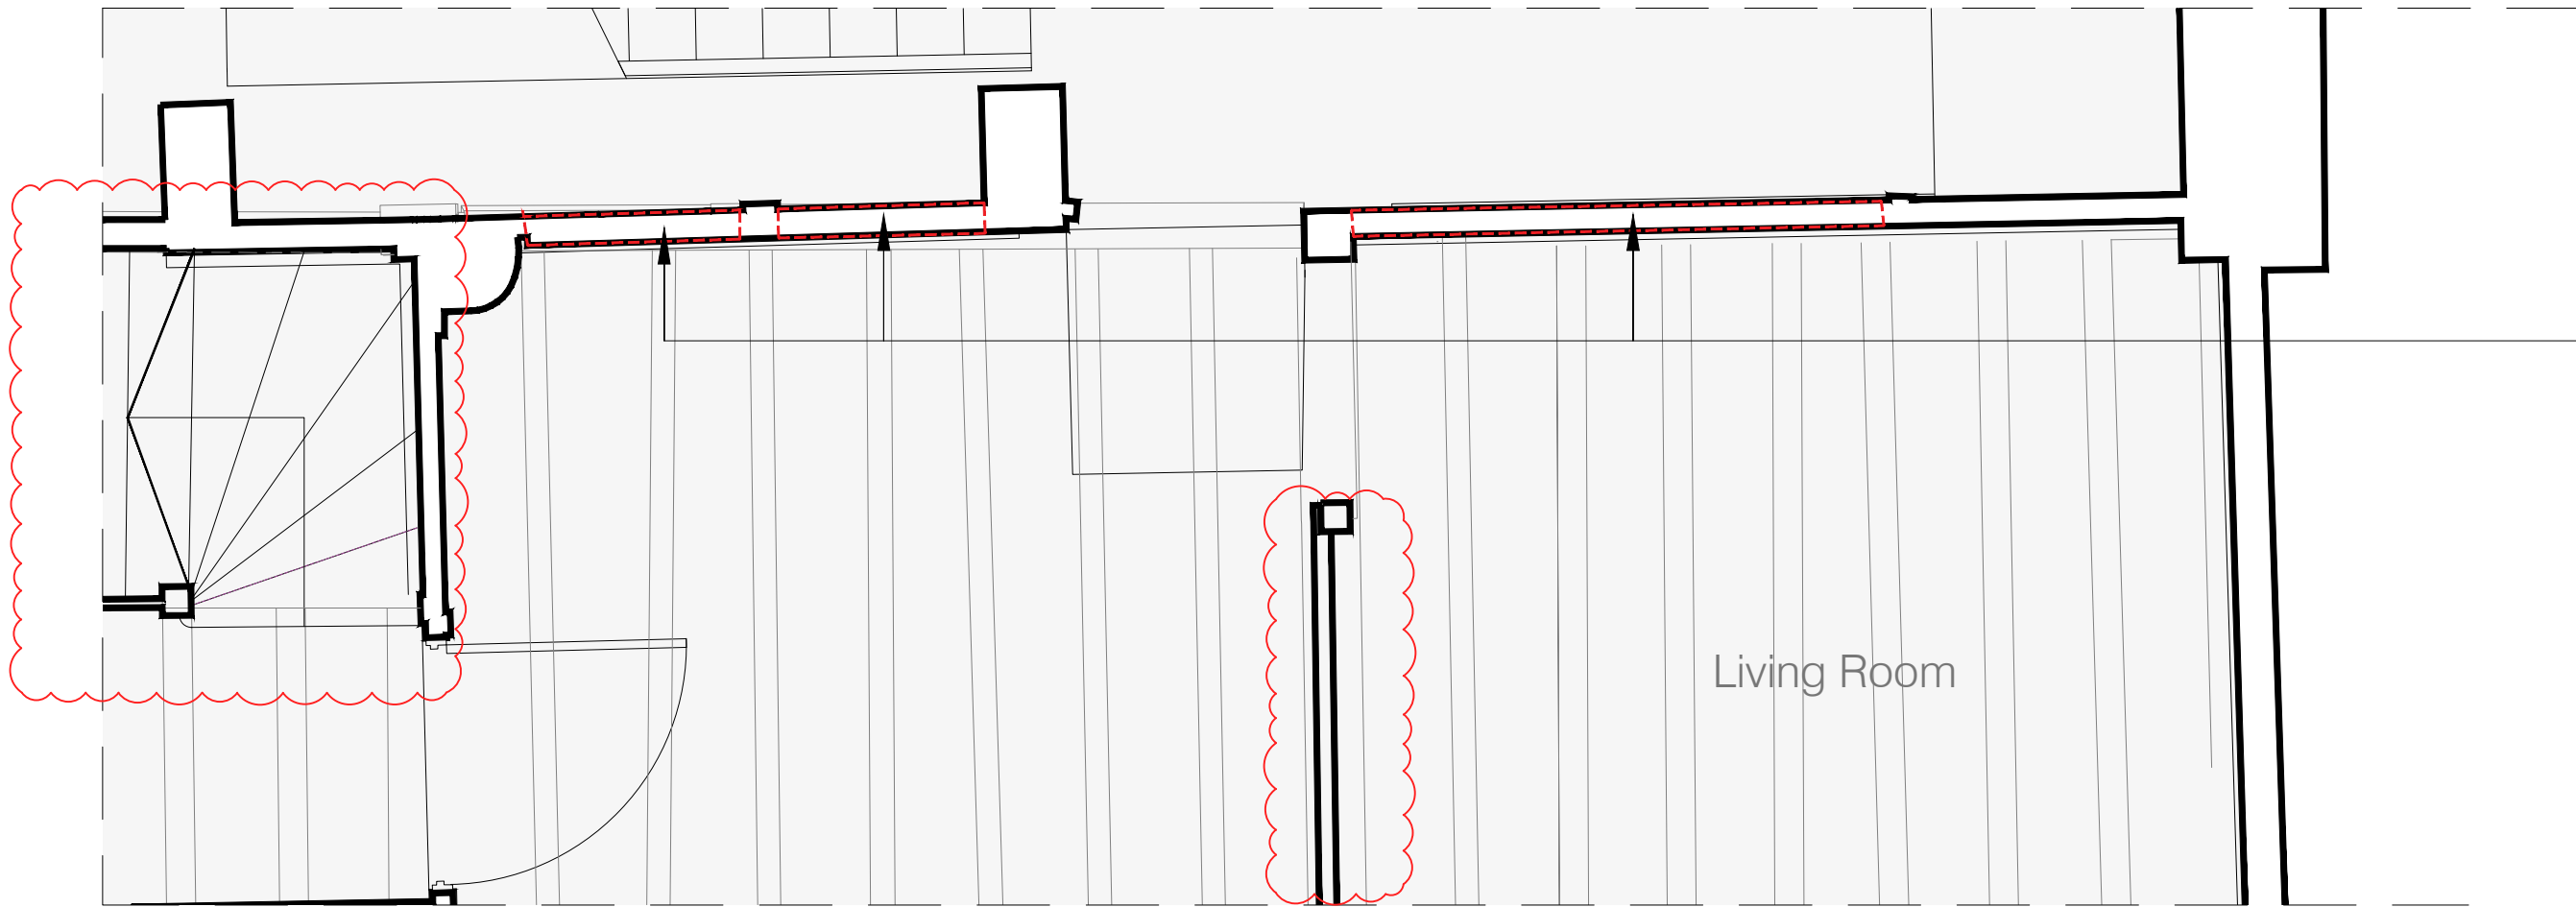

'As Built/ Proposed
Ground Floor Plan
Scale 1:25:A1
1:50@A3

Existing, not original, casement windows to box framing of 15th century west wall removed. Openings filled in with timber stud framing, wood wool boards and lime plaster.

Existing, not original, casement windows to box framing of 15th century west wall removed. Openings filled in with timber stud framing, wood wool boards and lime plaster.



Before: uPVC casement windows before removal



After: Infilled west wall, view from new extension living room

KEY:

 Highlighted difference between Approved Scheme and 'As-Built'/Proposed Scheme

kyson

Rev:

Comments:

By:

Date:

A

Amendments as clouded.

KN

Nov 25

LISTED BUILDING
CONSENT

Client:

Mr. Simon Dougal

Project Title:

107 High St, Lindfield, Haywards Heath, West Sussex, RH16 2HR

Drawing Title:

Detail Drawings:
Removal of Internal Casement Windows

Scale:

Date:

Drawn:

Checked:

1:25@A1

Apr 25

KN

KW

1:50@A3

Studio

28 Scrutton Street
London
UK
EC2A 4RP

T: +44(0) 20 7247 2462
E: enquiries@kyson.co.uk
W: www.kyson.co.uk

Project No.:

Drawing No.:

Revision:

900-25

5020

A

Do not scale this drawing. All dimensions must be checked on site.
All rights reserved. No reproduction in any material form is permitted
without consent.