




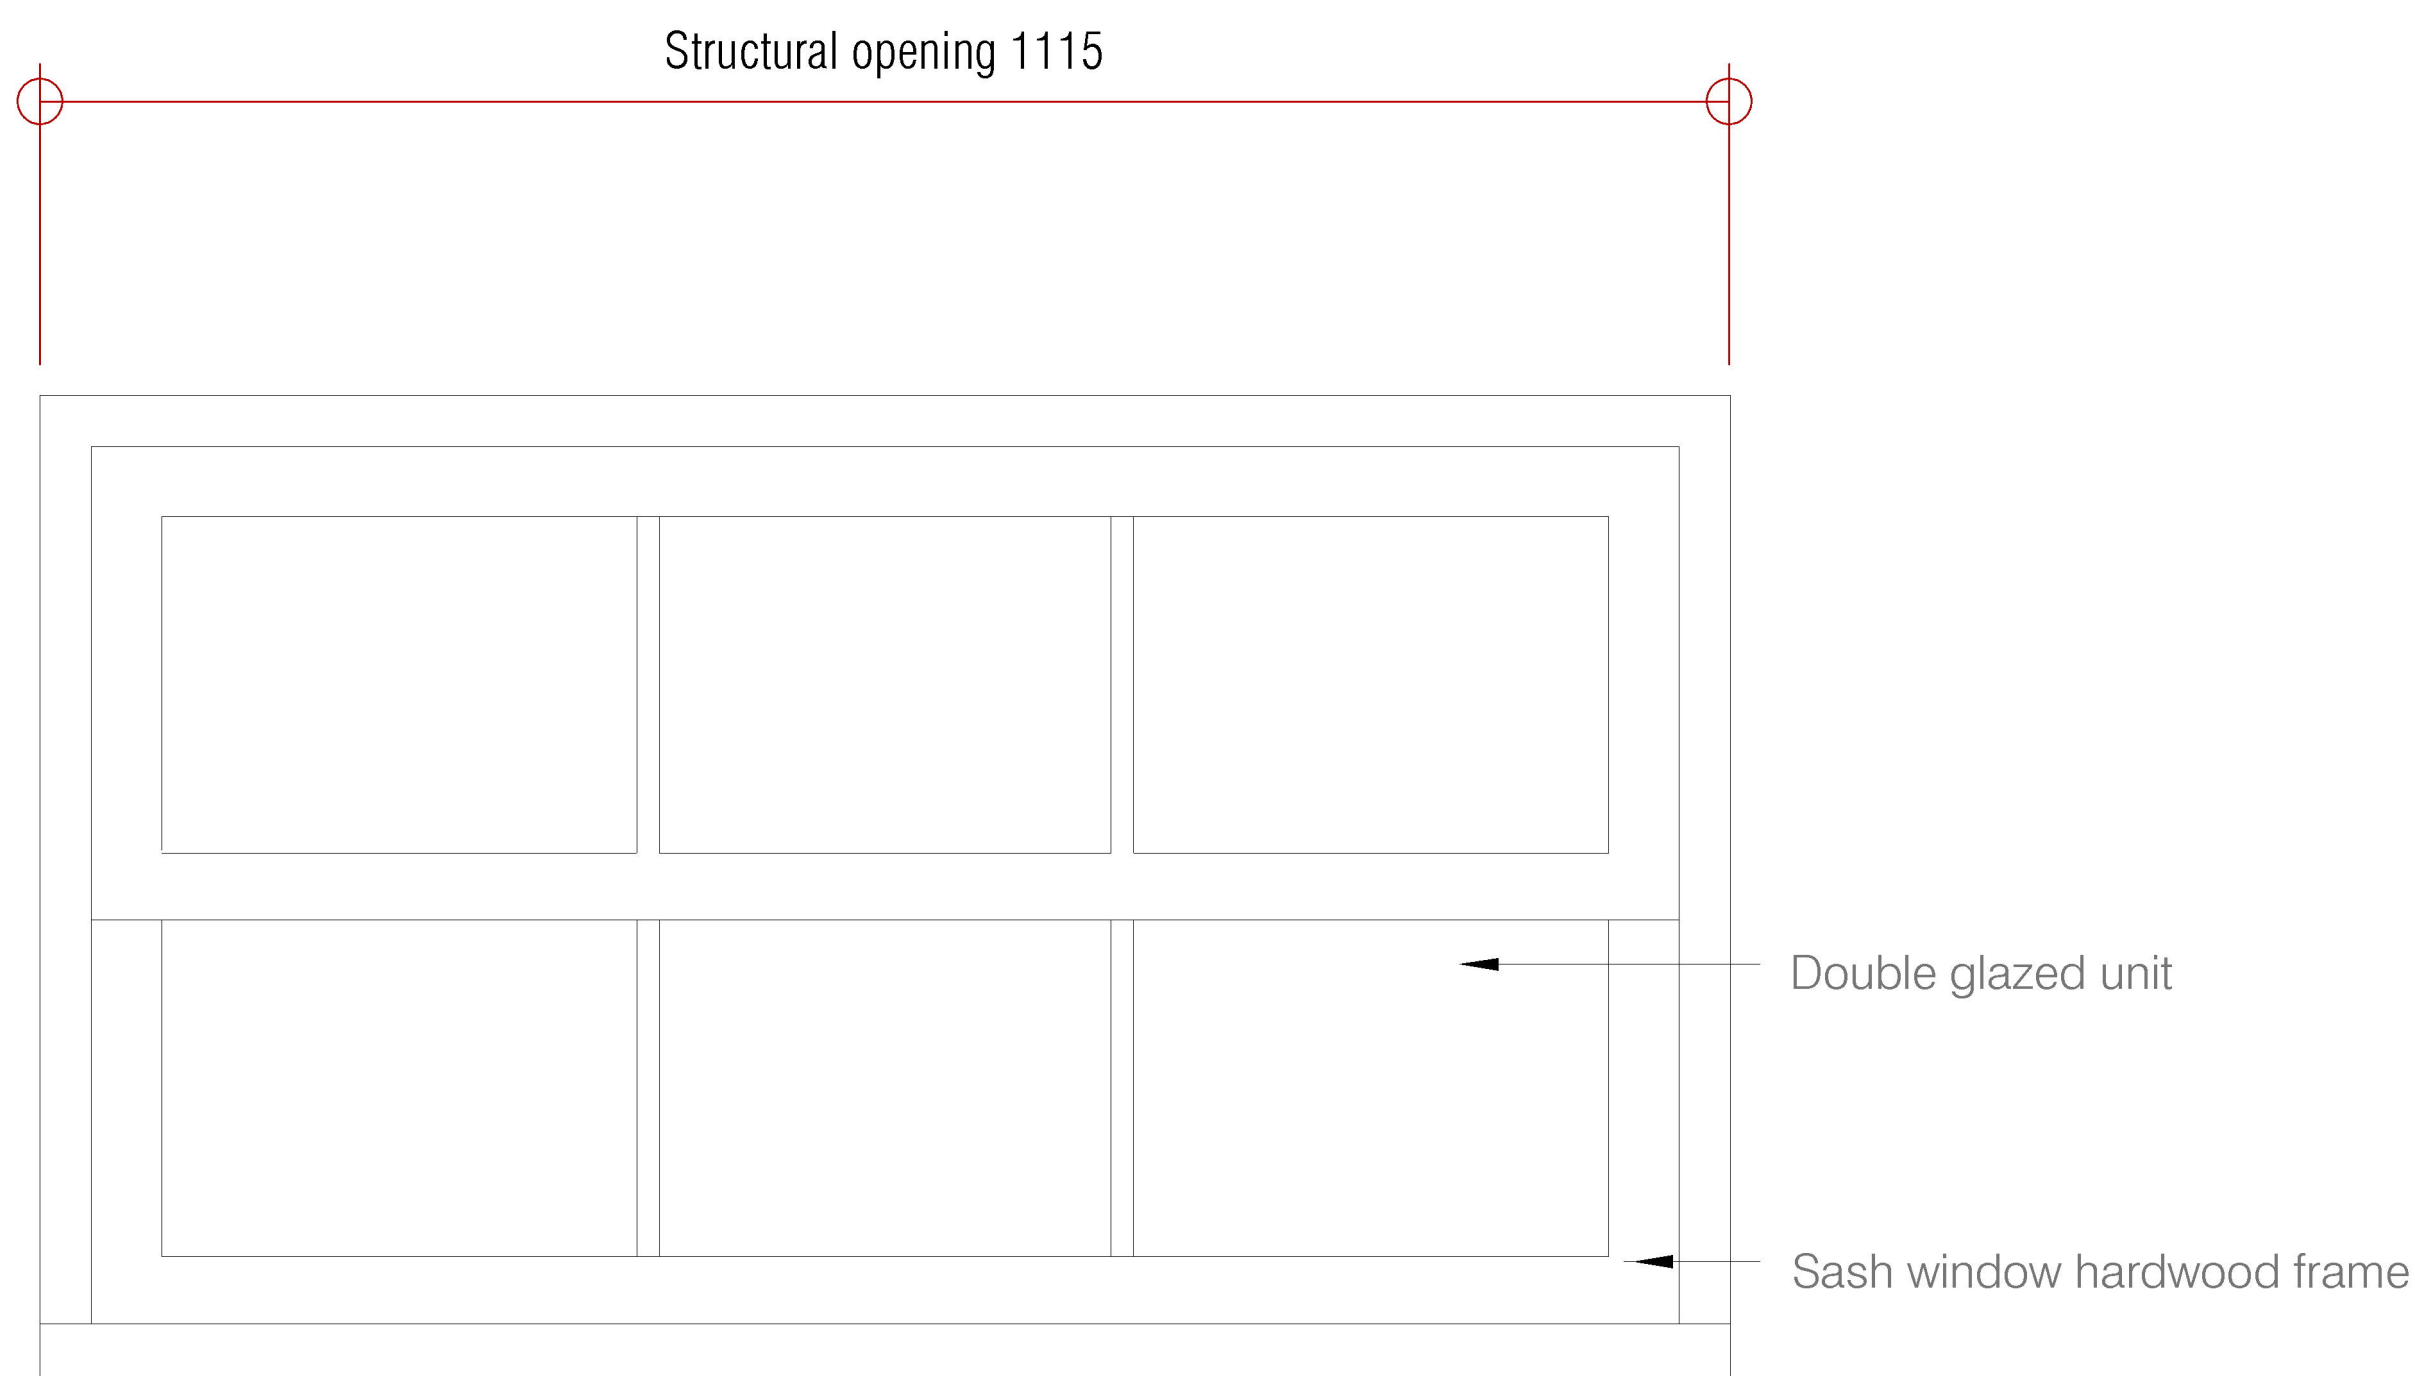

Elevation

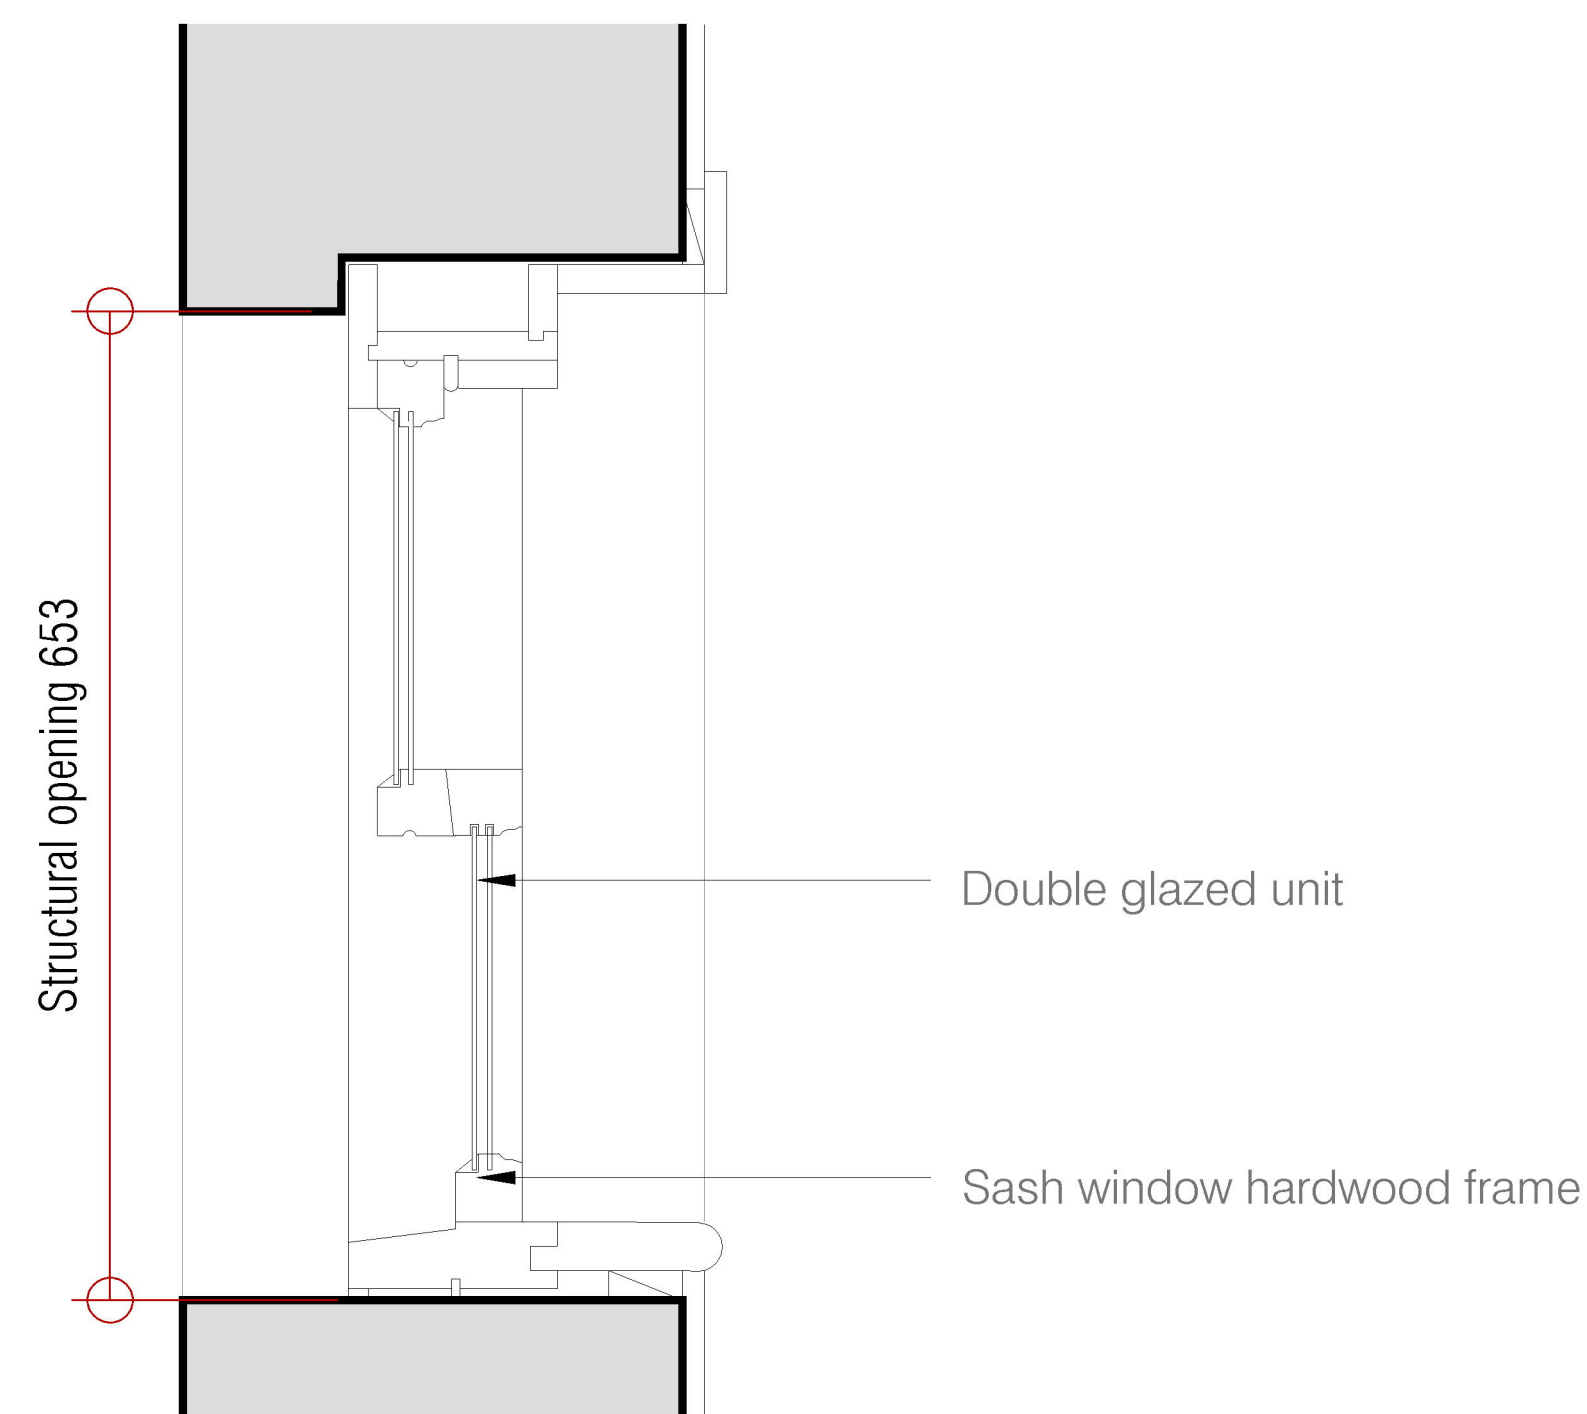


Section

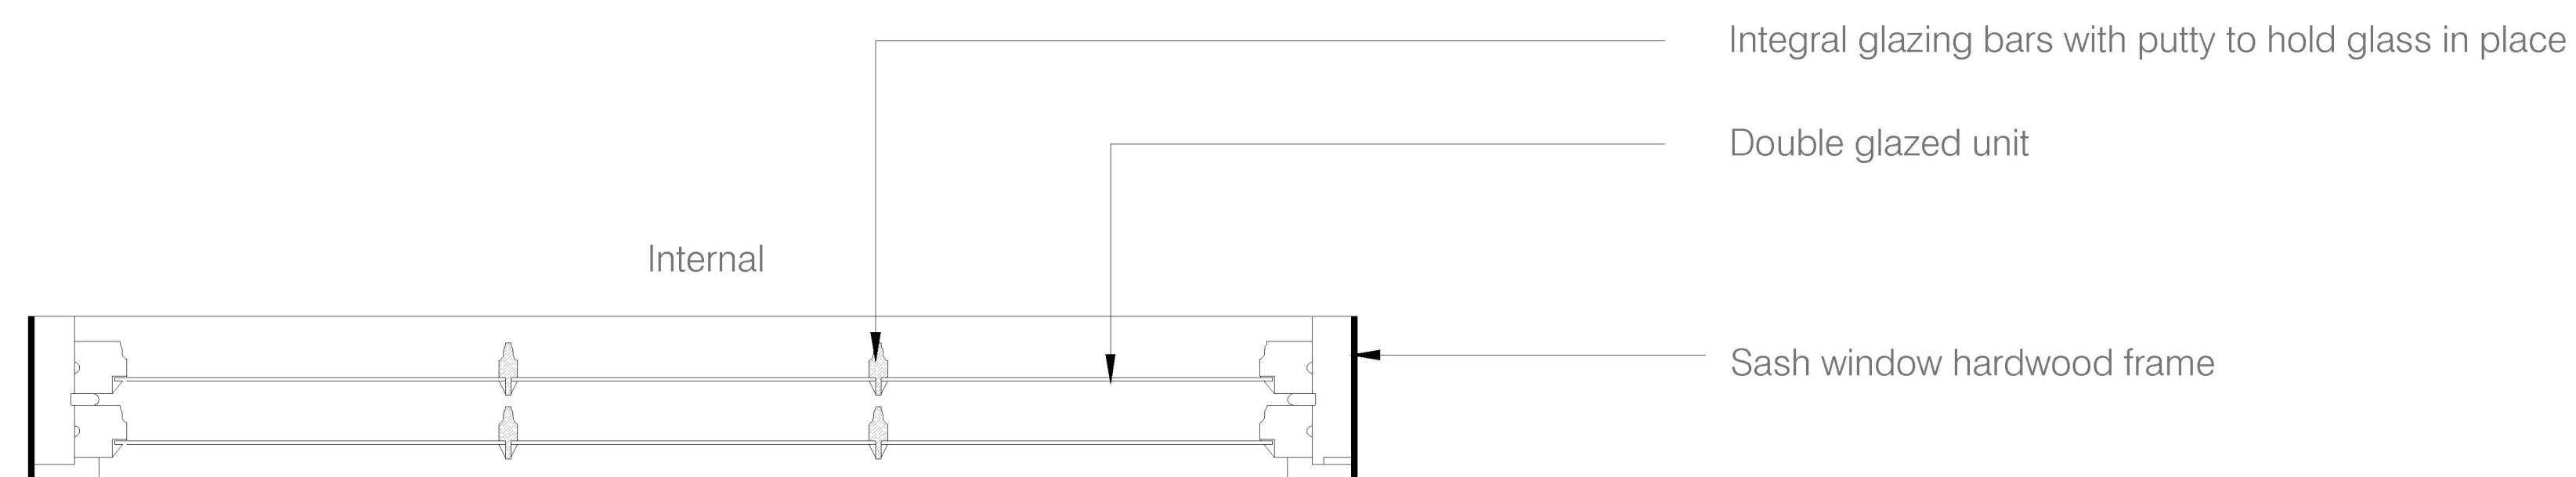

Plan


Replacement window details
Scale 1:5@A1
1:10@A3

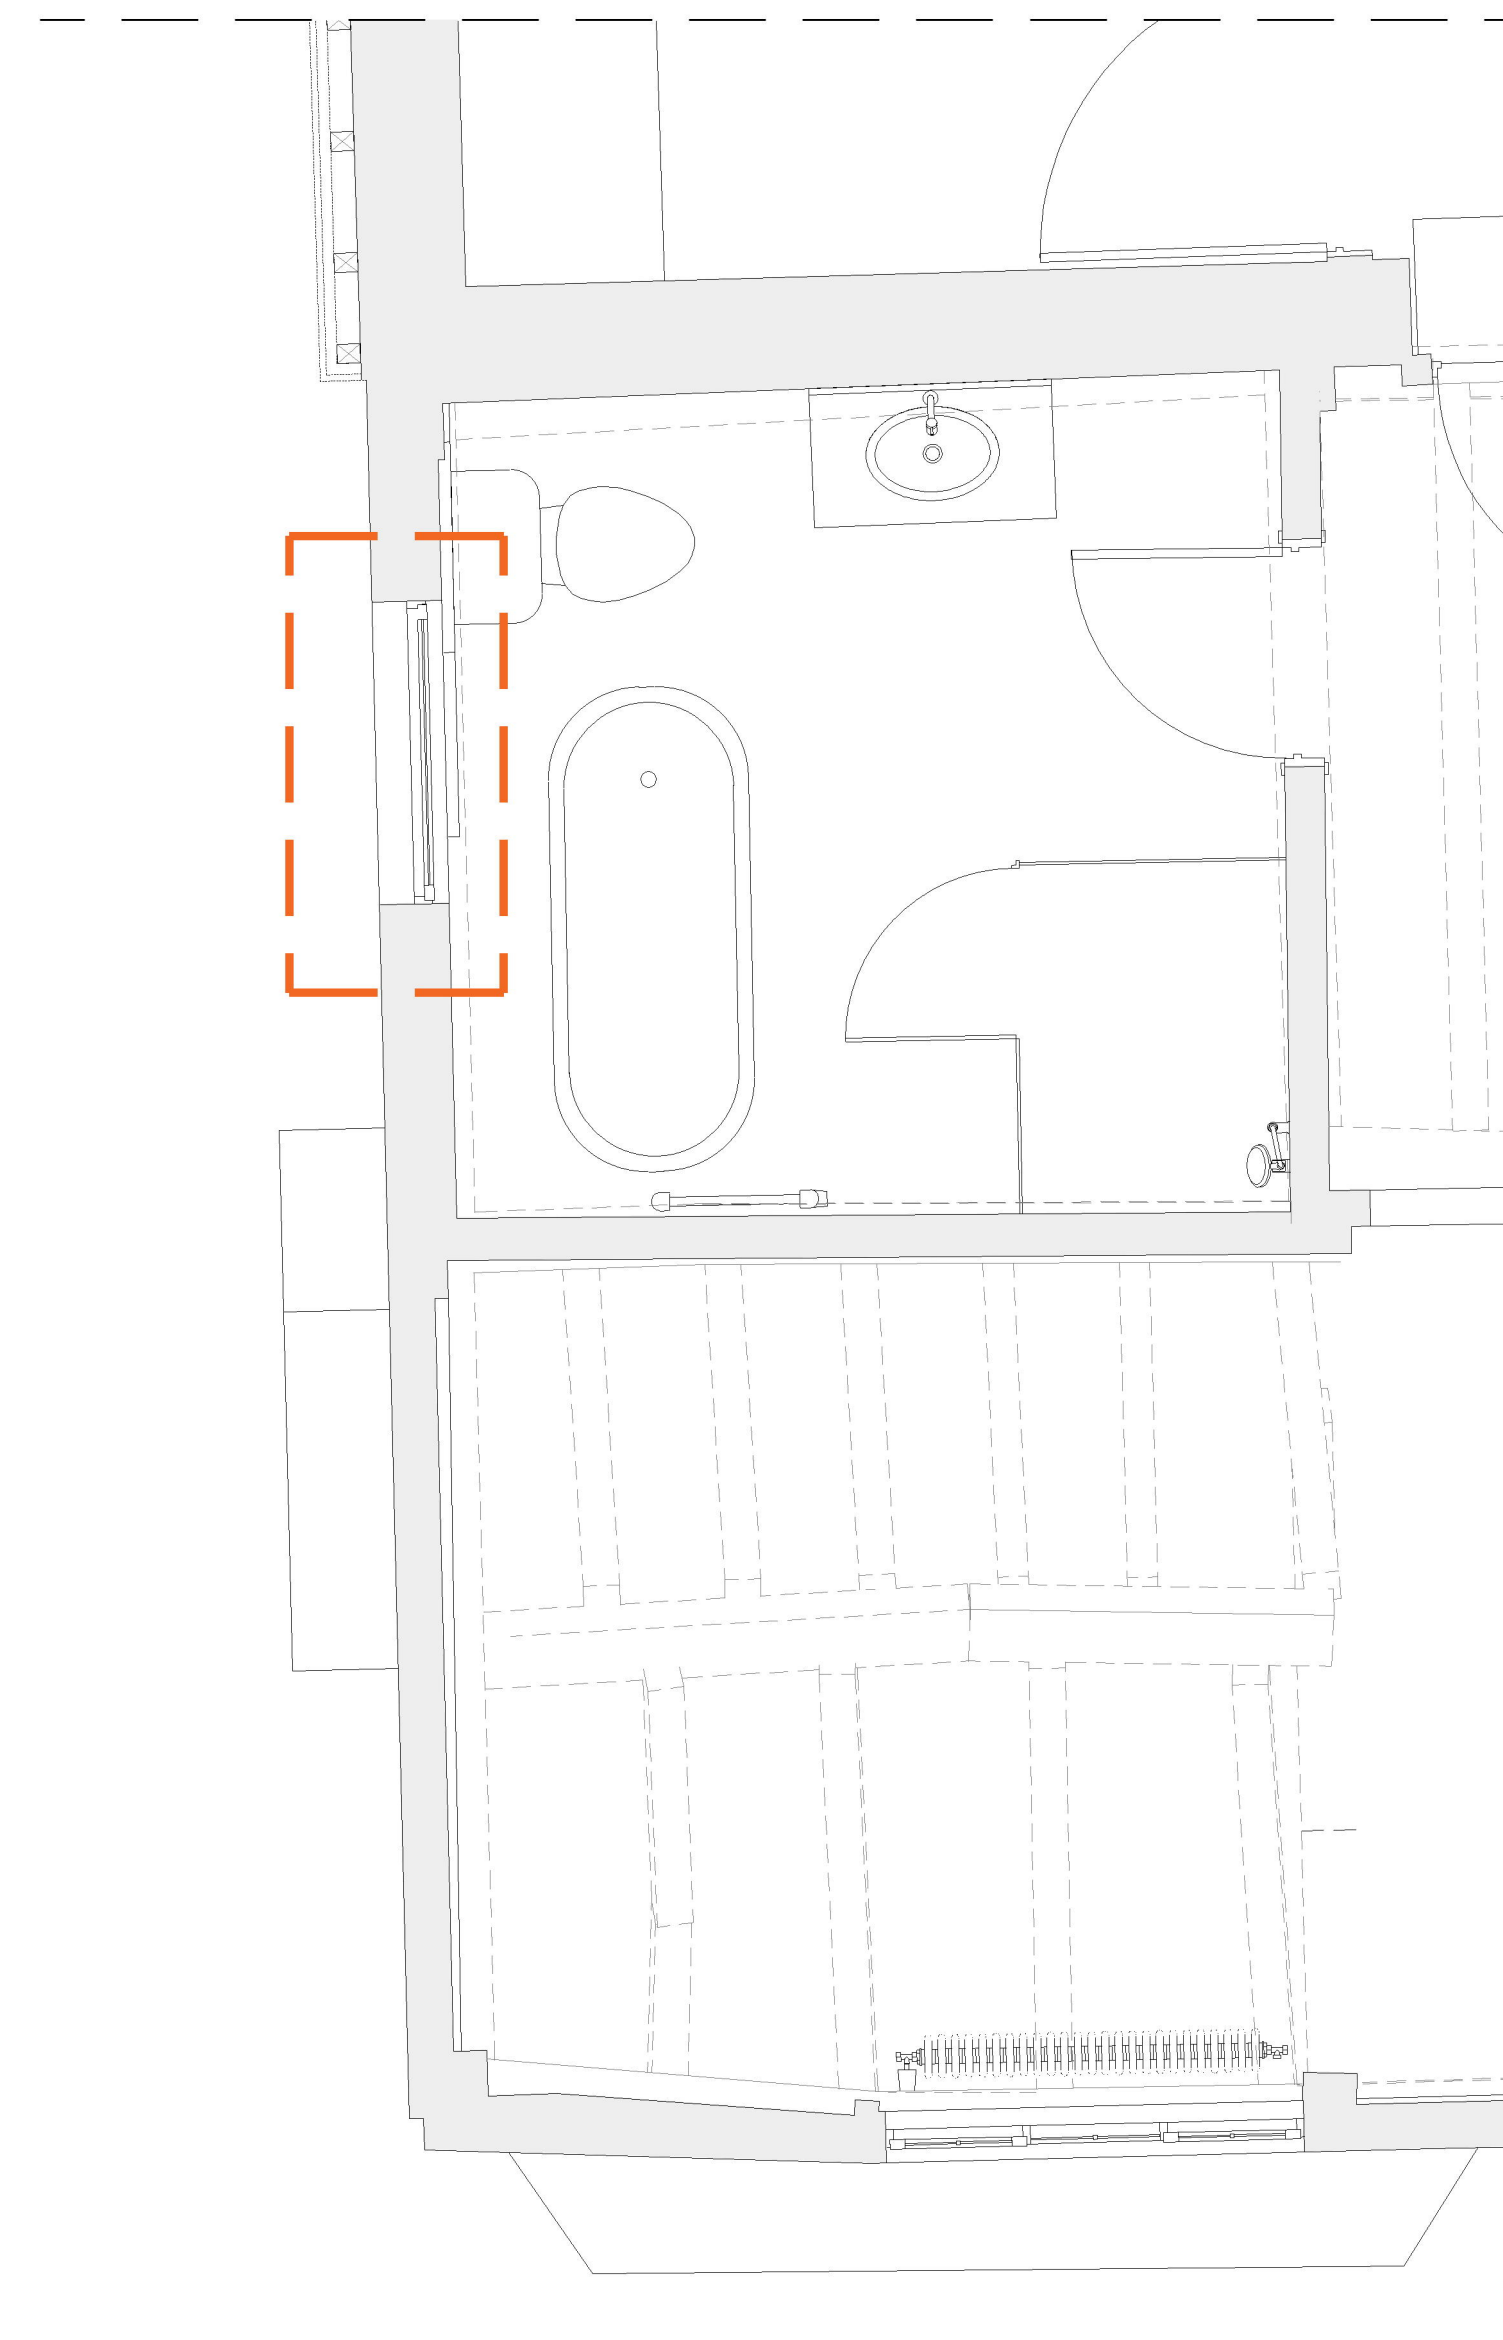

KEY PLAN
First Floor
Scale 1:25@A1
1:50@A3

KEY:
 Highlighted difference between Approved Scheme and 'As-Built'/Proposed Scheme

				kyson			
				Studio			
				28 Scrutton Street London UK EC2A 4RP			
Rev: Comments: By: Date: - - - -				Client: Mr. Simon Dougal			
				Project Title: 107 High St, Lindfield, Haywards Heath, West Sussex, RH16 2HR			
				Drawing Title: Detail Drawings: Replacement casement window - first floor south east elevation			
Do not scale this drawing All dimensions must be checked on site All rights reserved. No reproduction in any material form is permitted without consent.				Scale: Date: Drawn: Checked: 1:25@A1 1:50@A3 1:50@A3 Apr 25 KN KW			
				Project No.: Drawing No.: Revision: 900-25 5023 -			

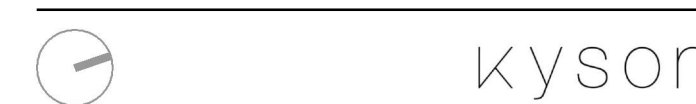

28 Scrutton Street
London
UK
EC2A 4RP
T: +44(0) 20 7247 2462
E: enquiries@kyson.co.uk
W: www.kyson.co.uk