





FRONT ELEVATION SOUTH WEST




SIDE ELEVATION SOUTH EAST

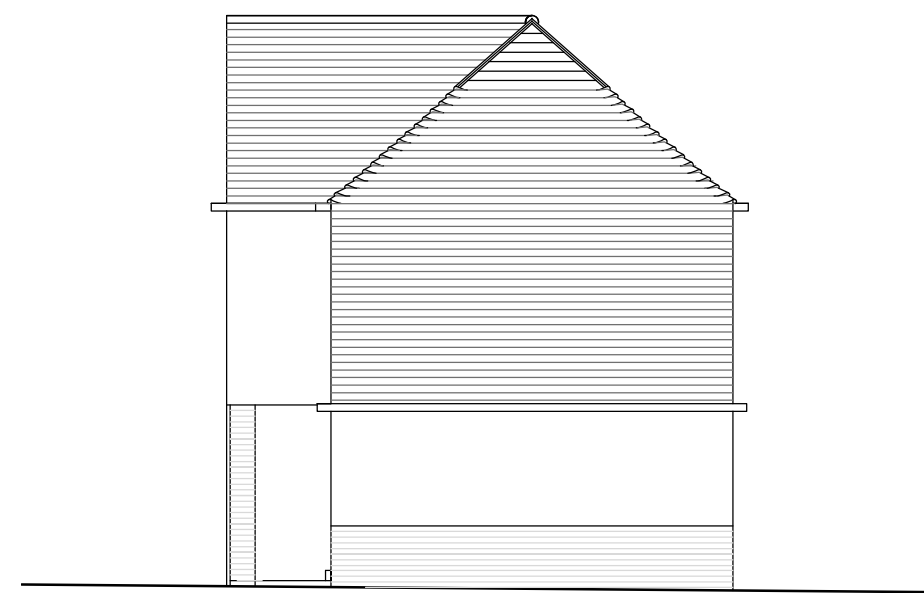


REAR ELEVATION NORTH EAST

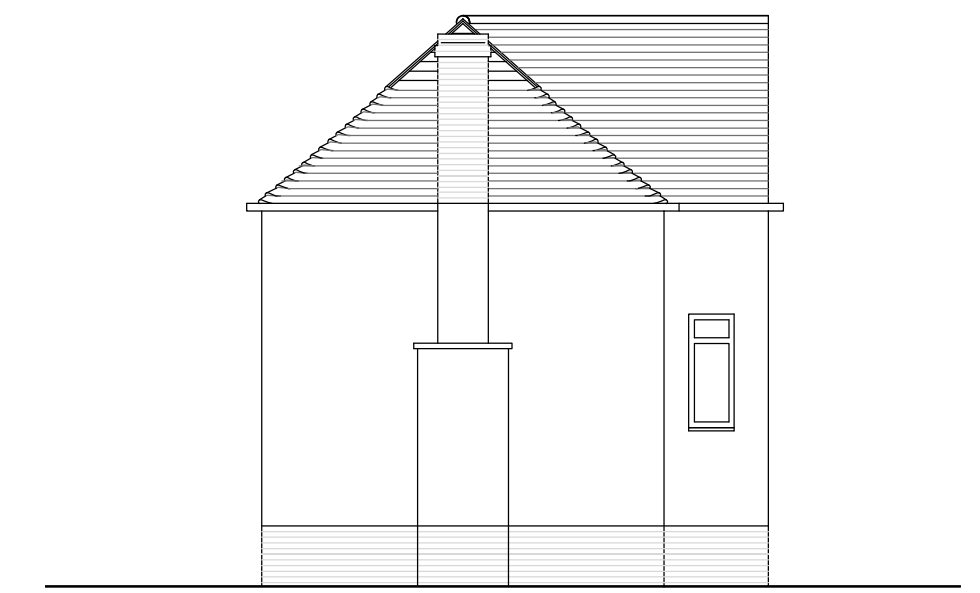


SIDE ELEVATION NORTH WEST

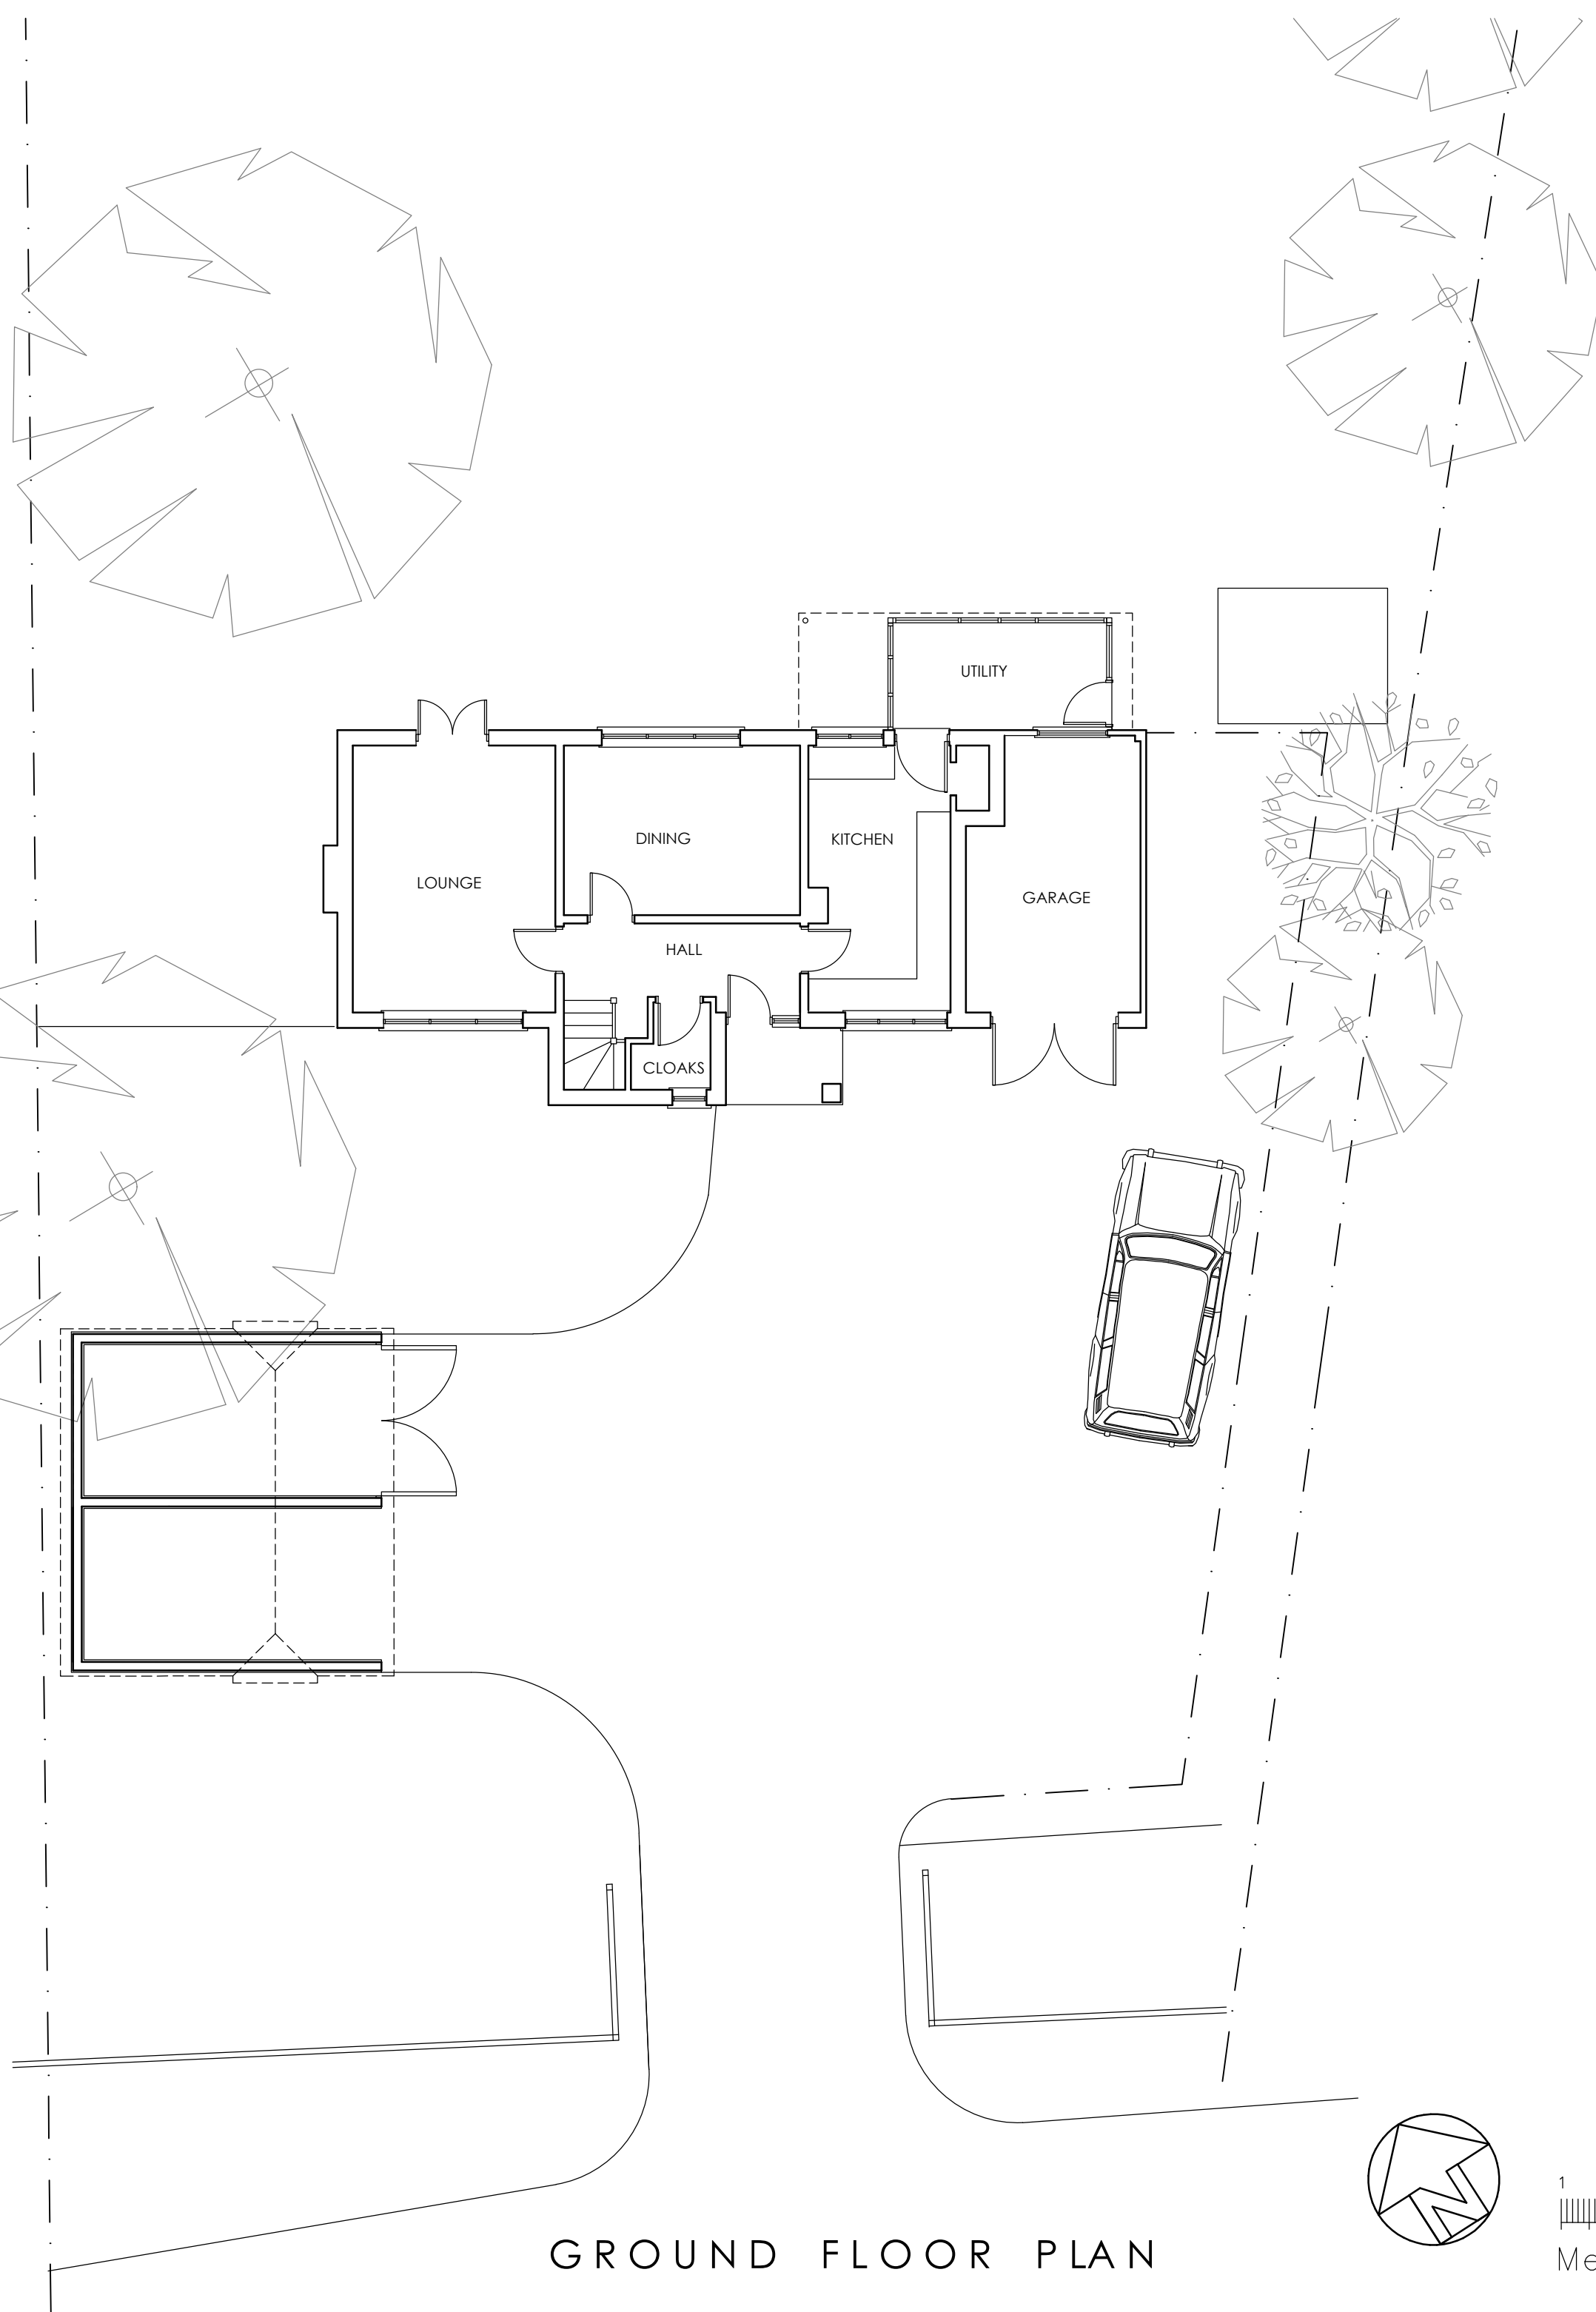



GROUND FLOOR PLAN

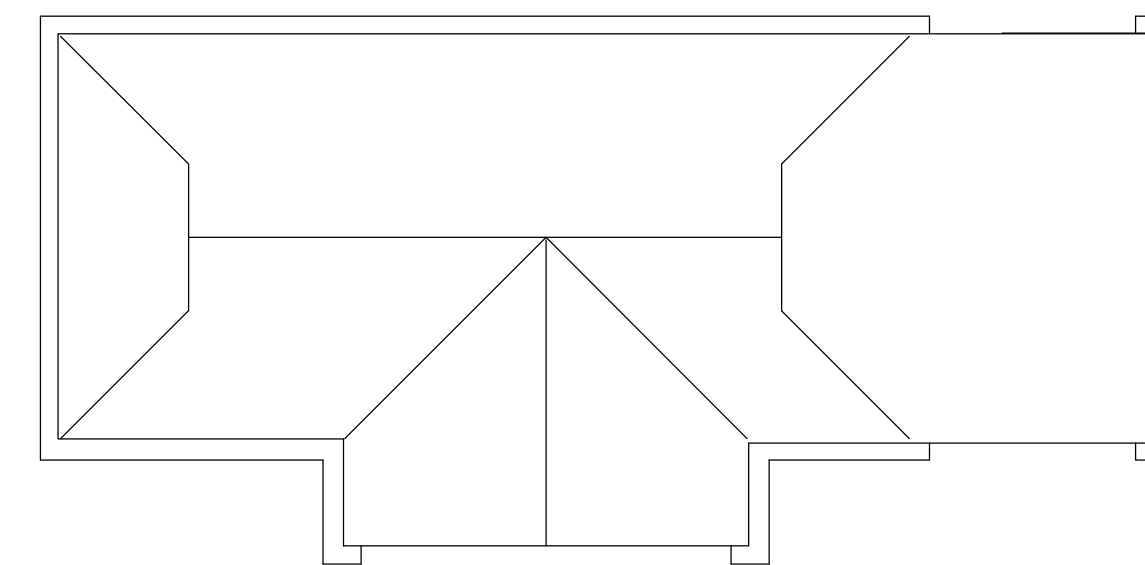

ROOF PLAN

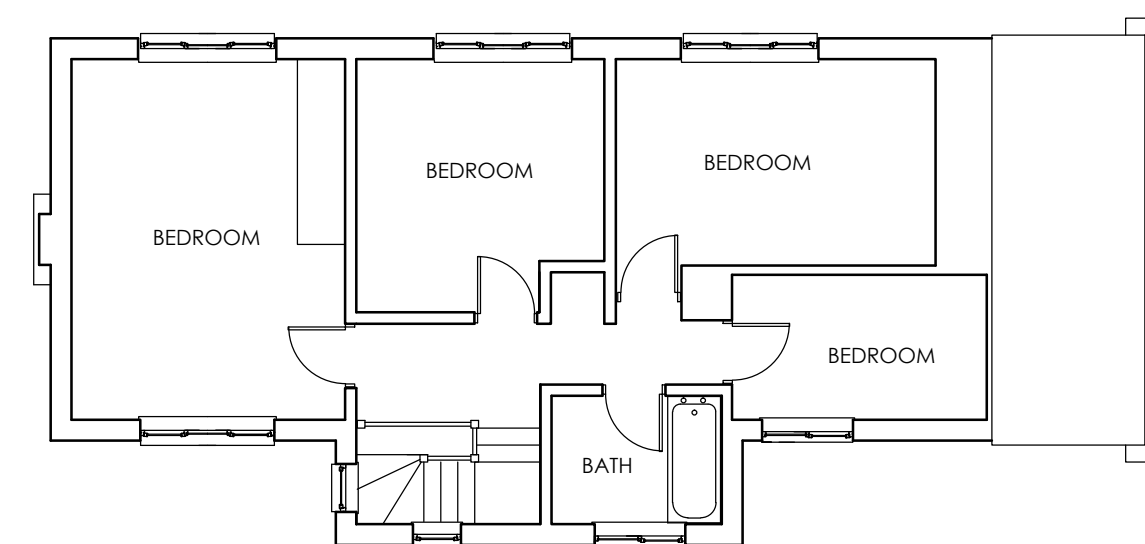

FIRST FLOOR PLAN

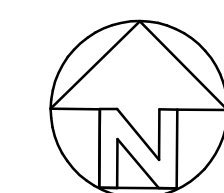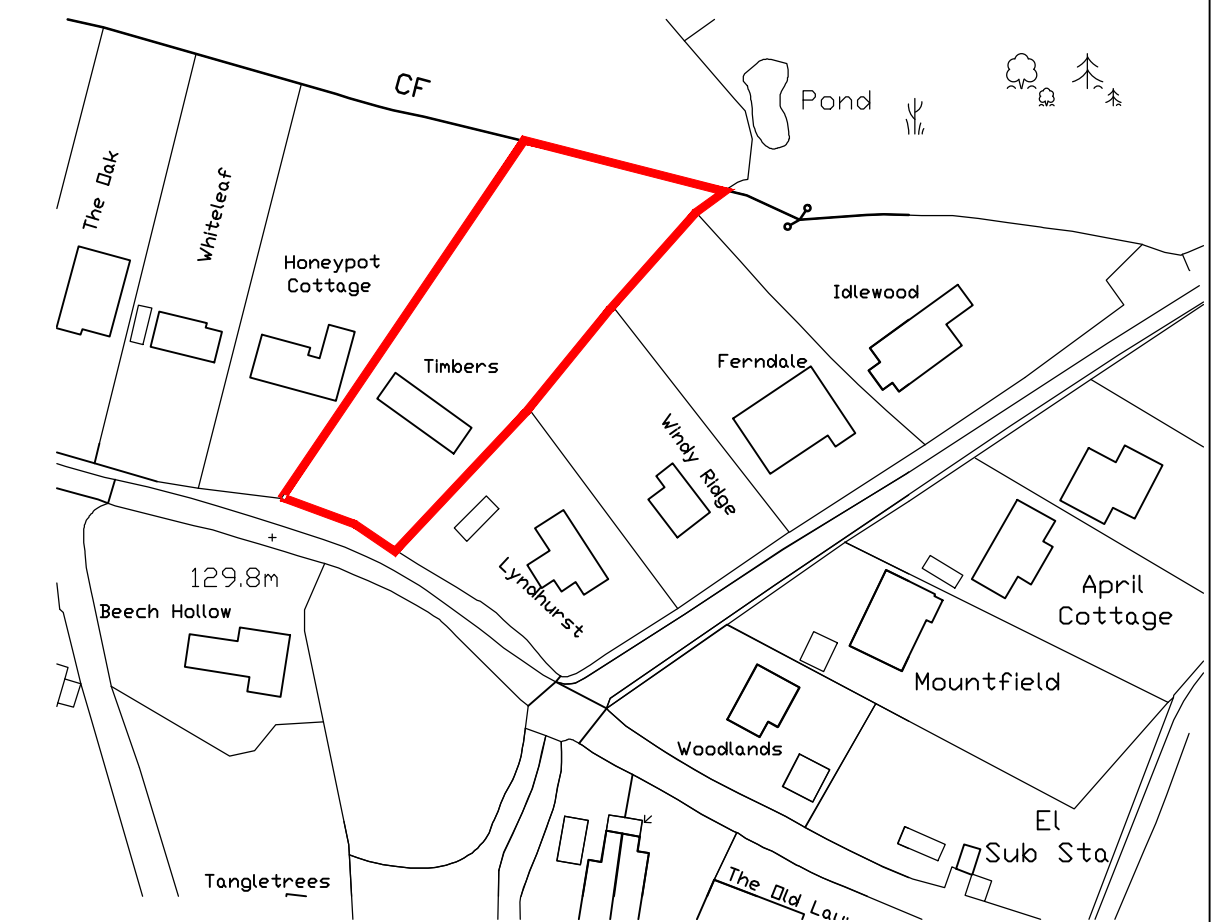

LOCATION PLAN
Scale 1:1250

REVISION A - December 2016
BLOCK PLAN AMENDED TO READ LOCATION PLAN
REVISION B - July 2016
PLAN AMENDED TO SHOW AS BUILT GARAGE

A.J. YOUNGER Dip Arch (Hons) RIBA
CHARTERED ARCHITECTS
102-104 HIGH STREET
GOOSTONE
SURREY
Tel: 01883 742646
Mob: 0781 842 1567
email: alyounger@aol.com

Client: MR & MRS WATKINSON
TIMBERS
CANSIRON LANE
ASHURST WOOD
WEST SUSSEX RH19 3SE

Project: TIMBERS
CANSIRON LANE
ASHURST WOOD
WEST SUSSEX RH19 3SE

Drawing Title:
PLANNING DRAWINGS
AS EXISTING

Date: July 2026
Scale: 1:100 @ A1

Drawing No: AY:99:486:EXG:01
Revision: X B