
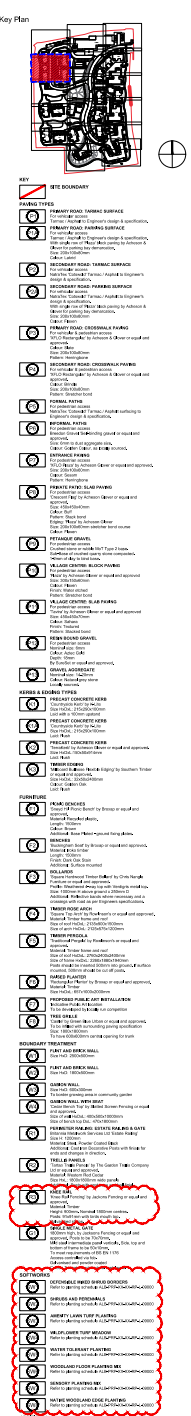


Landscape GA: ALB-PRP-XX-XX-D-L-50004

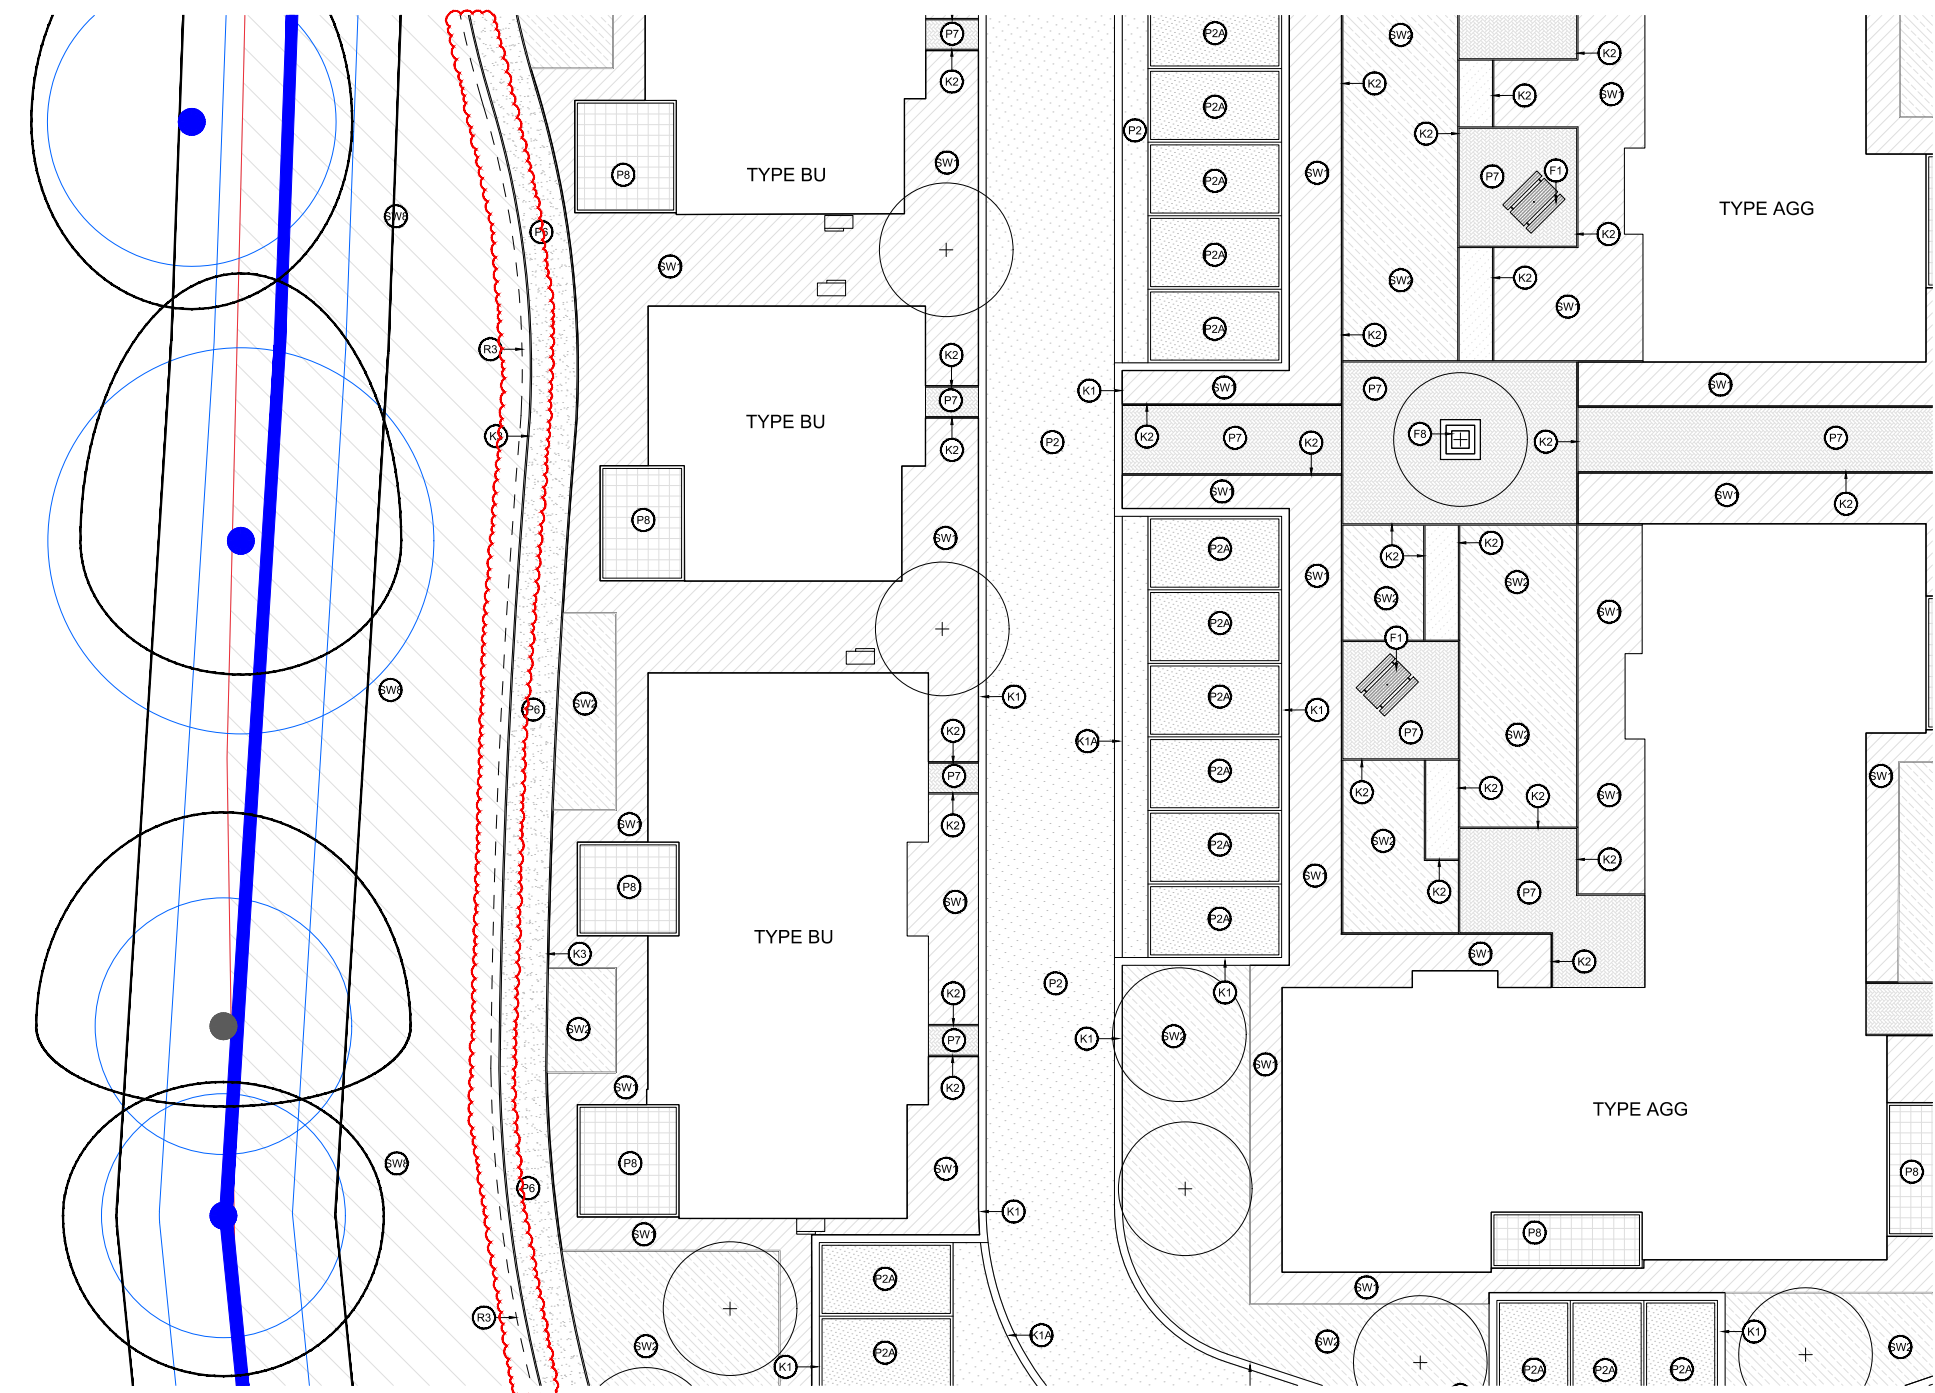

Notes:
1. This drawing is to be read in conjunction with all relevant contract documents from the design team, with any conflicting information to be brought to the attention of PRP in writing before commencing on site.
2. The Contractor is to check and verify all levels and dimensions before construction. Any discrepancies are to be brought to the attention of PRP in writing before commencing on site.
3. All dimensions in mm, unless otherwise stated.
4. All sub base and concrete design and specification to Engineer's detail. All diagrams provided here are purely indicative.
5. Waterproofing to any element to be specified by others.
6. All proprietary products shall be installed in accordance with manufacturer's written instructions.
7. Any proposed detail substitution shall be agreed with the landscape architect prior to ordering.
8. Drainage and SUDS to Engineer's detail.
9. Works around trees and within RPA including proposed surfaces and ball up to be executed in accordance with Arboricultural recommendations.
10. Lighting to Engineer's detail.
11. Engineer to Engineer's detail.
12. All existing and proposed surface covers to Engineer's detail. Refer to Engineer's drawings for provision and location.
13. Works outside defined boundary and to highways by others.
14. This drawing is based on the current topographical survey. For existing trees with their RPS, refer to A02A-LB-ZZ-22-49-PA-001 (SA) Survey and Report.
15. The extent of the existing planting shown in this plan is based on the topographical survey. Extent to be confirmed by the Contractor following a site survey.
16. Shading to Architect's detail.
17. Existing trees to Engineer's detail.
18. Trees in landscape to be installed within a new call system. Refer to tree pit detail for trees to be installed.
19. This drawing is based on the current topographical survey. For existing trees with their RPS, refer to A02A-LB-ZZ-22-49-PA-001 (SA) Survey and Report.
20. The extent of the existing planting shown in this plan is based on the topographical survey. Extent to be confirmed by the Contractor following a site survey.
21. Shading to Architect's detail.
22. Existing trees to Engineer's detail.
23. Trees in landscape to be installed within a new call system. Refer to tree pit detail for trees to be installed.

CDM REGULATIONS 2015. All current drawings and specifications for the project must be read in conjunction with the Designer's Hazard and Environment Assessment Record.

All intellectual property rights reserved.

Where products have been specified, PRP have reviewed applicable products available in the UK at the time of writing the specification. For the avoidance of doubt, product manufacturers and suppliers must confirm that each product is fit for its intended use and provide such evidence as may be requested to confirm performance. Including, but not limited to, product test classification and interfaces with adjacent products.

Where the contractor wishes to propose alternative products, representative samples and a full technical approval should be submitted by the contractor to the employer demonstrating that their proposed alternative has equal or better performance. Any alternative products are subject to design team, building control, warranty provider and employer acceptance.

Rev	Date	Description
R01	18/12/2025	First Issue for Tender
R02	20/01/26	Amendments as per Client's comments
R03	03/02/26	Amendments following Client's comments


Drawn	SM
Checked	AGP
Date	18.12.2025
Scale	@ A1 1:100

ALBOURNE / WELLCROFT GREEN
Landscape GA - Sheet 4

Project Origin Zone Level Type Role Number
ALB - PRP - XX - XX - D - L - 50004
Revision
P03
Stage
S0 - Preliminary / Tender

PRP prp-co.uk
London
020 7653 1200

Landscape GA: ALB-PRP-XX-XX-D-L-50005

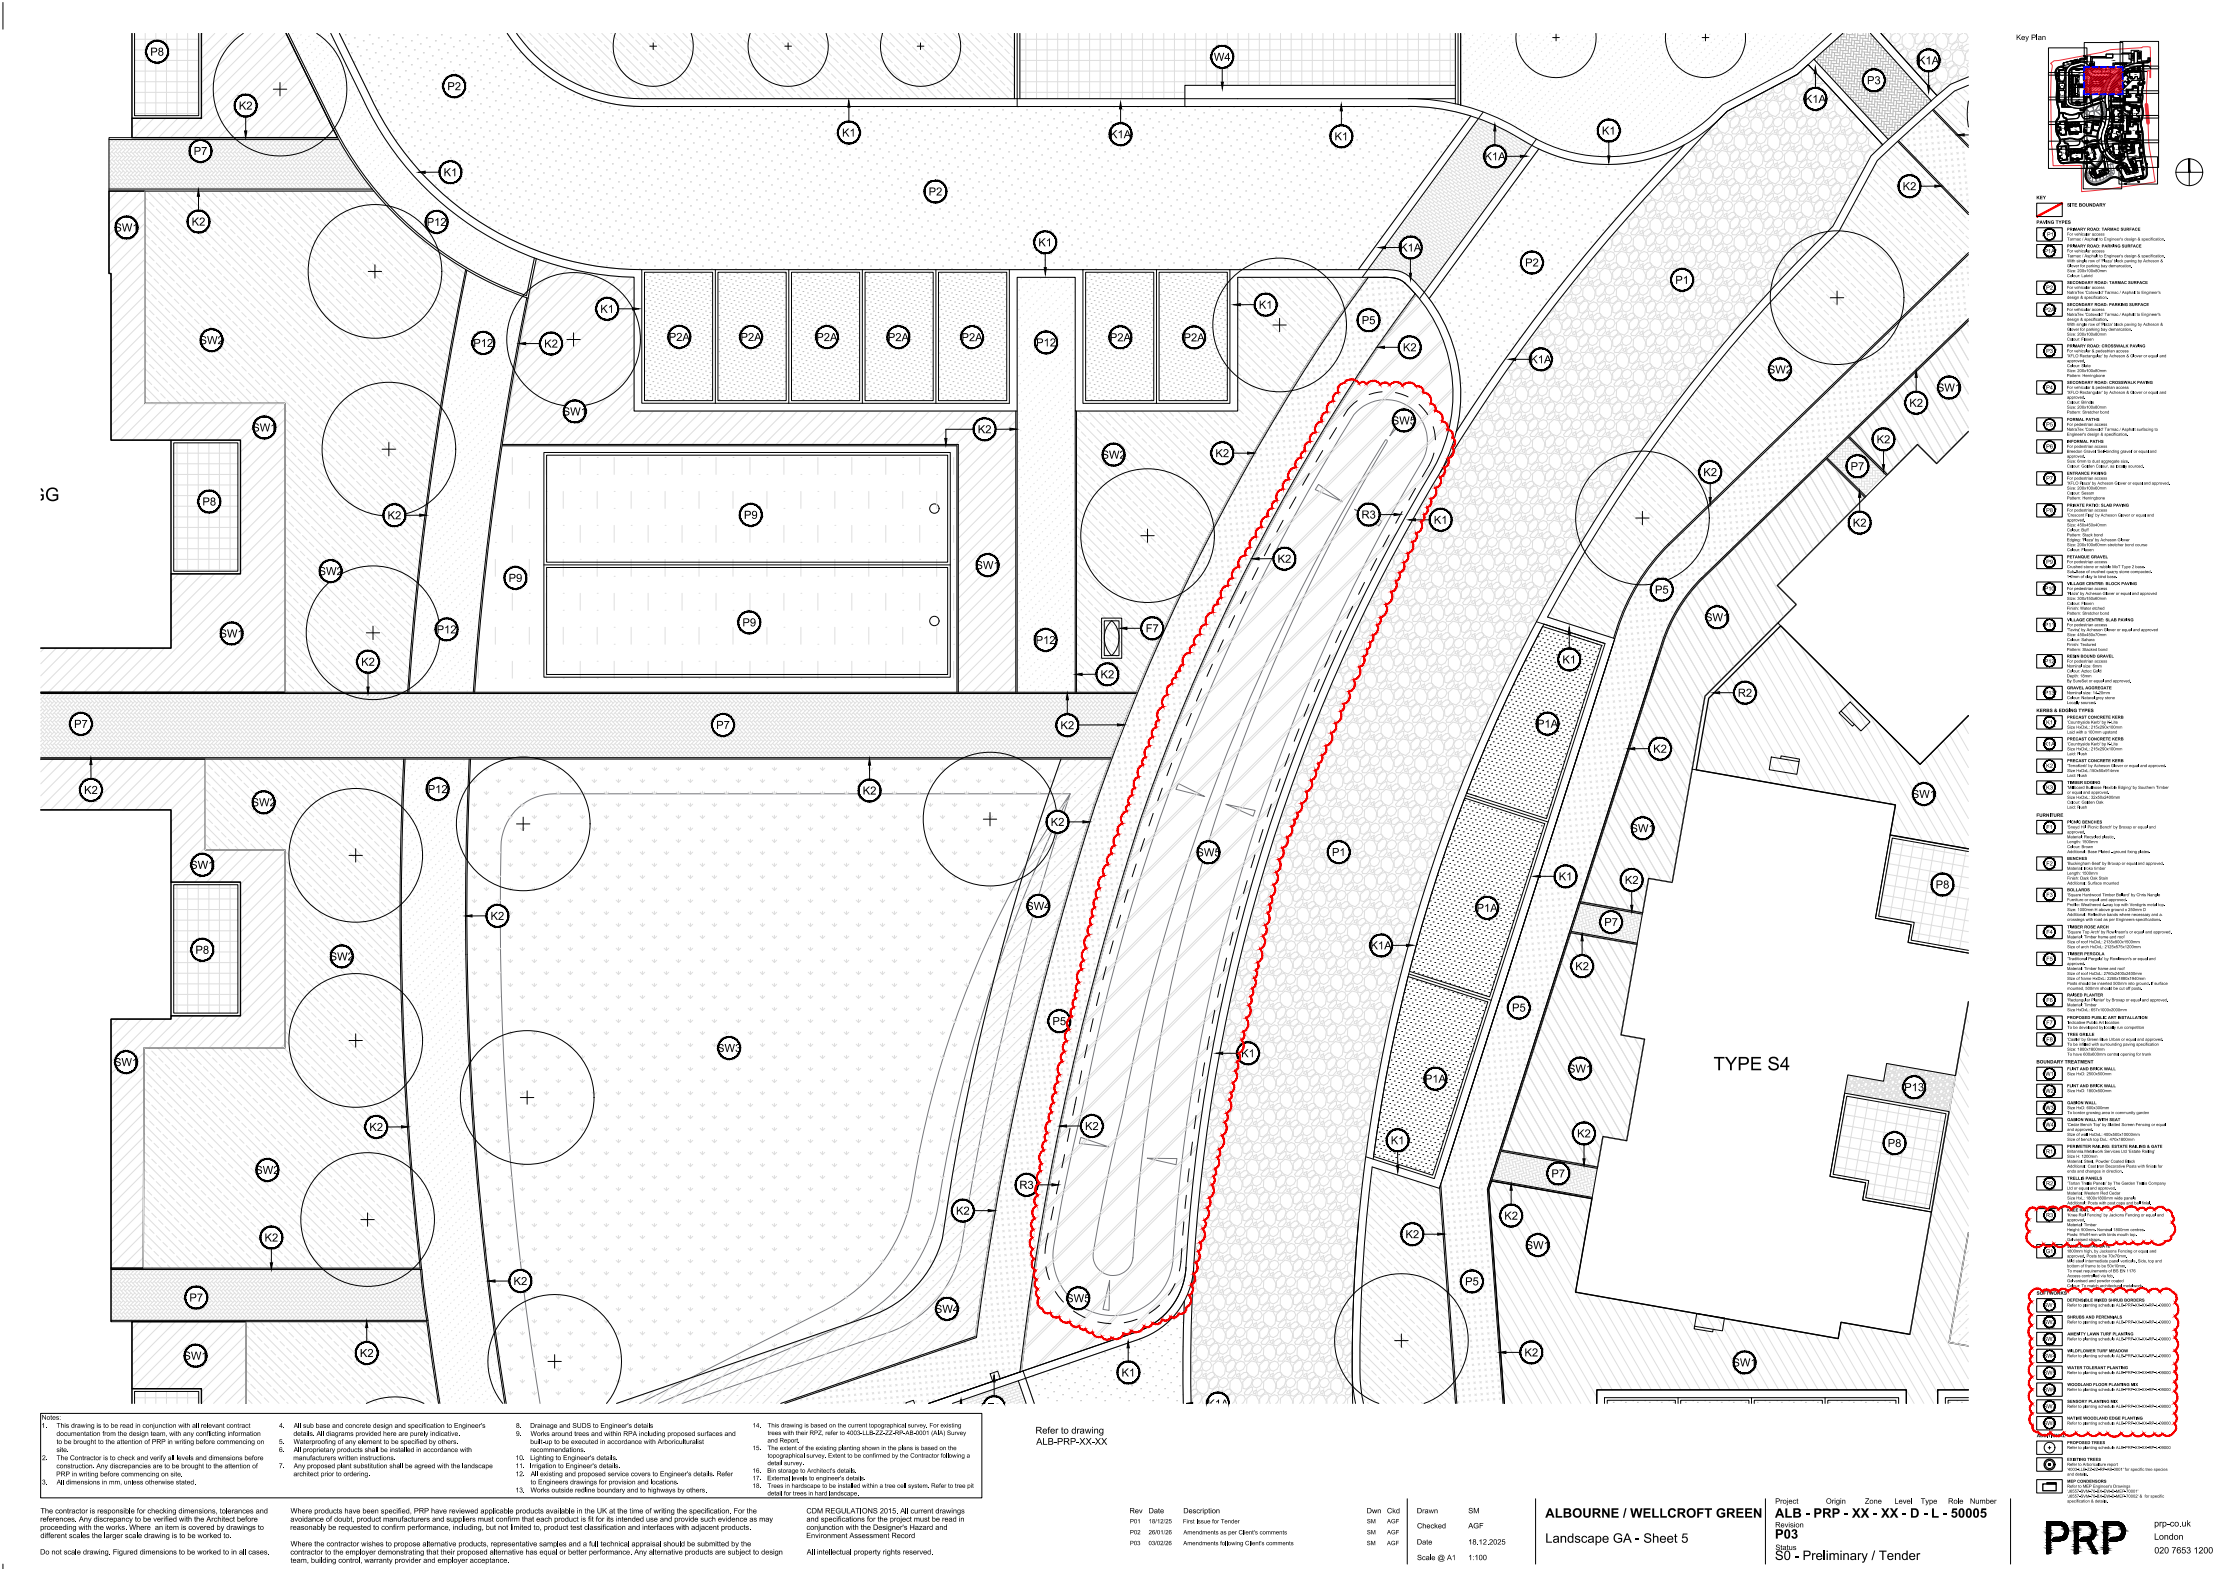

Notes:
1. This drawing is to be read in conjunction with all relevant contract documents and specifications.
2. The Contractor is to check and verify all levels and dimensions before commencing work.
3. All dimensions are in mm, unless otherwise stated.
4. All sub base and concrete design and specification to Engineer's detail. All diagrams provided here are purely indicative.
5. Waterproofing to any element to be specified by others.
6. All proprietary products shall be installed in accordance with manufacturer's written instructions.
7. Any proposed plant substitution shall be agreed with the landscape architect prior to planting.
8. Drainage and SUDS to Engineer's detail.
9. Works around trees and within RPA including proposed surfaces and ball up to be executed in accordance with Arboricultural recommendations.
10. Lighting to Engineer's detail.
11. Engineer to Engineer's detail.
12. All existing and proposed services covers to Engineer's detail. Refer to Engineer's drawings for provision and locations.
13. Works outside red line boundary and to highways by others.
14. This drawing is based on the current topographical survey. For existing trees with their RPA, refer to ALB-PRP-XX-XX-D-L-50005 (A4) Survey and Report.
15. The extent of the existing planting shown in this plan is based on the topographical survey. Extent to be confirmed by the Contractor following a site survey.
16. In storage to Architect's detail.
17. Extends to the Engineer's detail.
18. Trees in landscape to be installed within a new call system. Refer to tree pit detail for trees to be installed.

Refer to drawing
ALB-PRP-XXX

Rev	Date	Description
P01	18/12/2025	First Issue for Tender
P02	20/01/2026	Amendments as per Client's comments
P03	03/02/2026	Amendments following Client's comments

Drawn	Checked	Date	Scale
SM	AGF	18.12.2025	@ A1
SM	AGF		1:100

ALBOURNE / WELLCROFT GREEN
Landscape GA - Sheet 5

Project: ALB - PRP - XX - XX - D - L - 50005
Revision: P03
Stage: S0 - Preliminary / Tender

PRP prp-co.uk
London 020 7653 1200

Landscape GA: ALB-PRP-XX-XX-D-L-50006

