



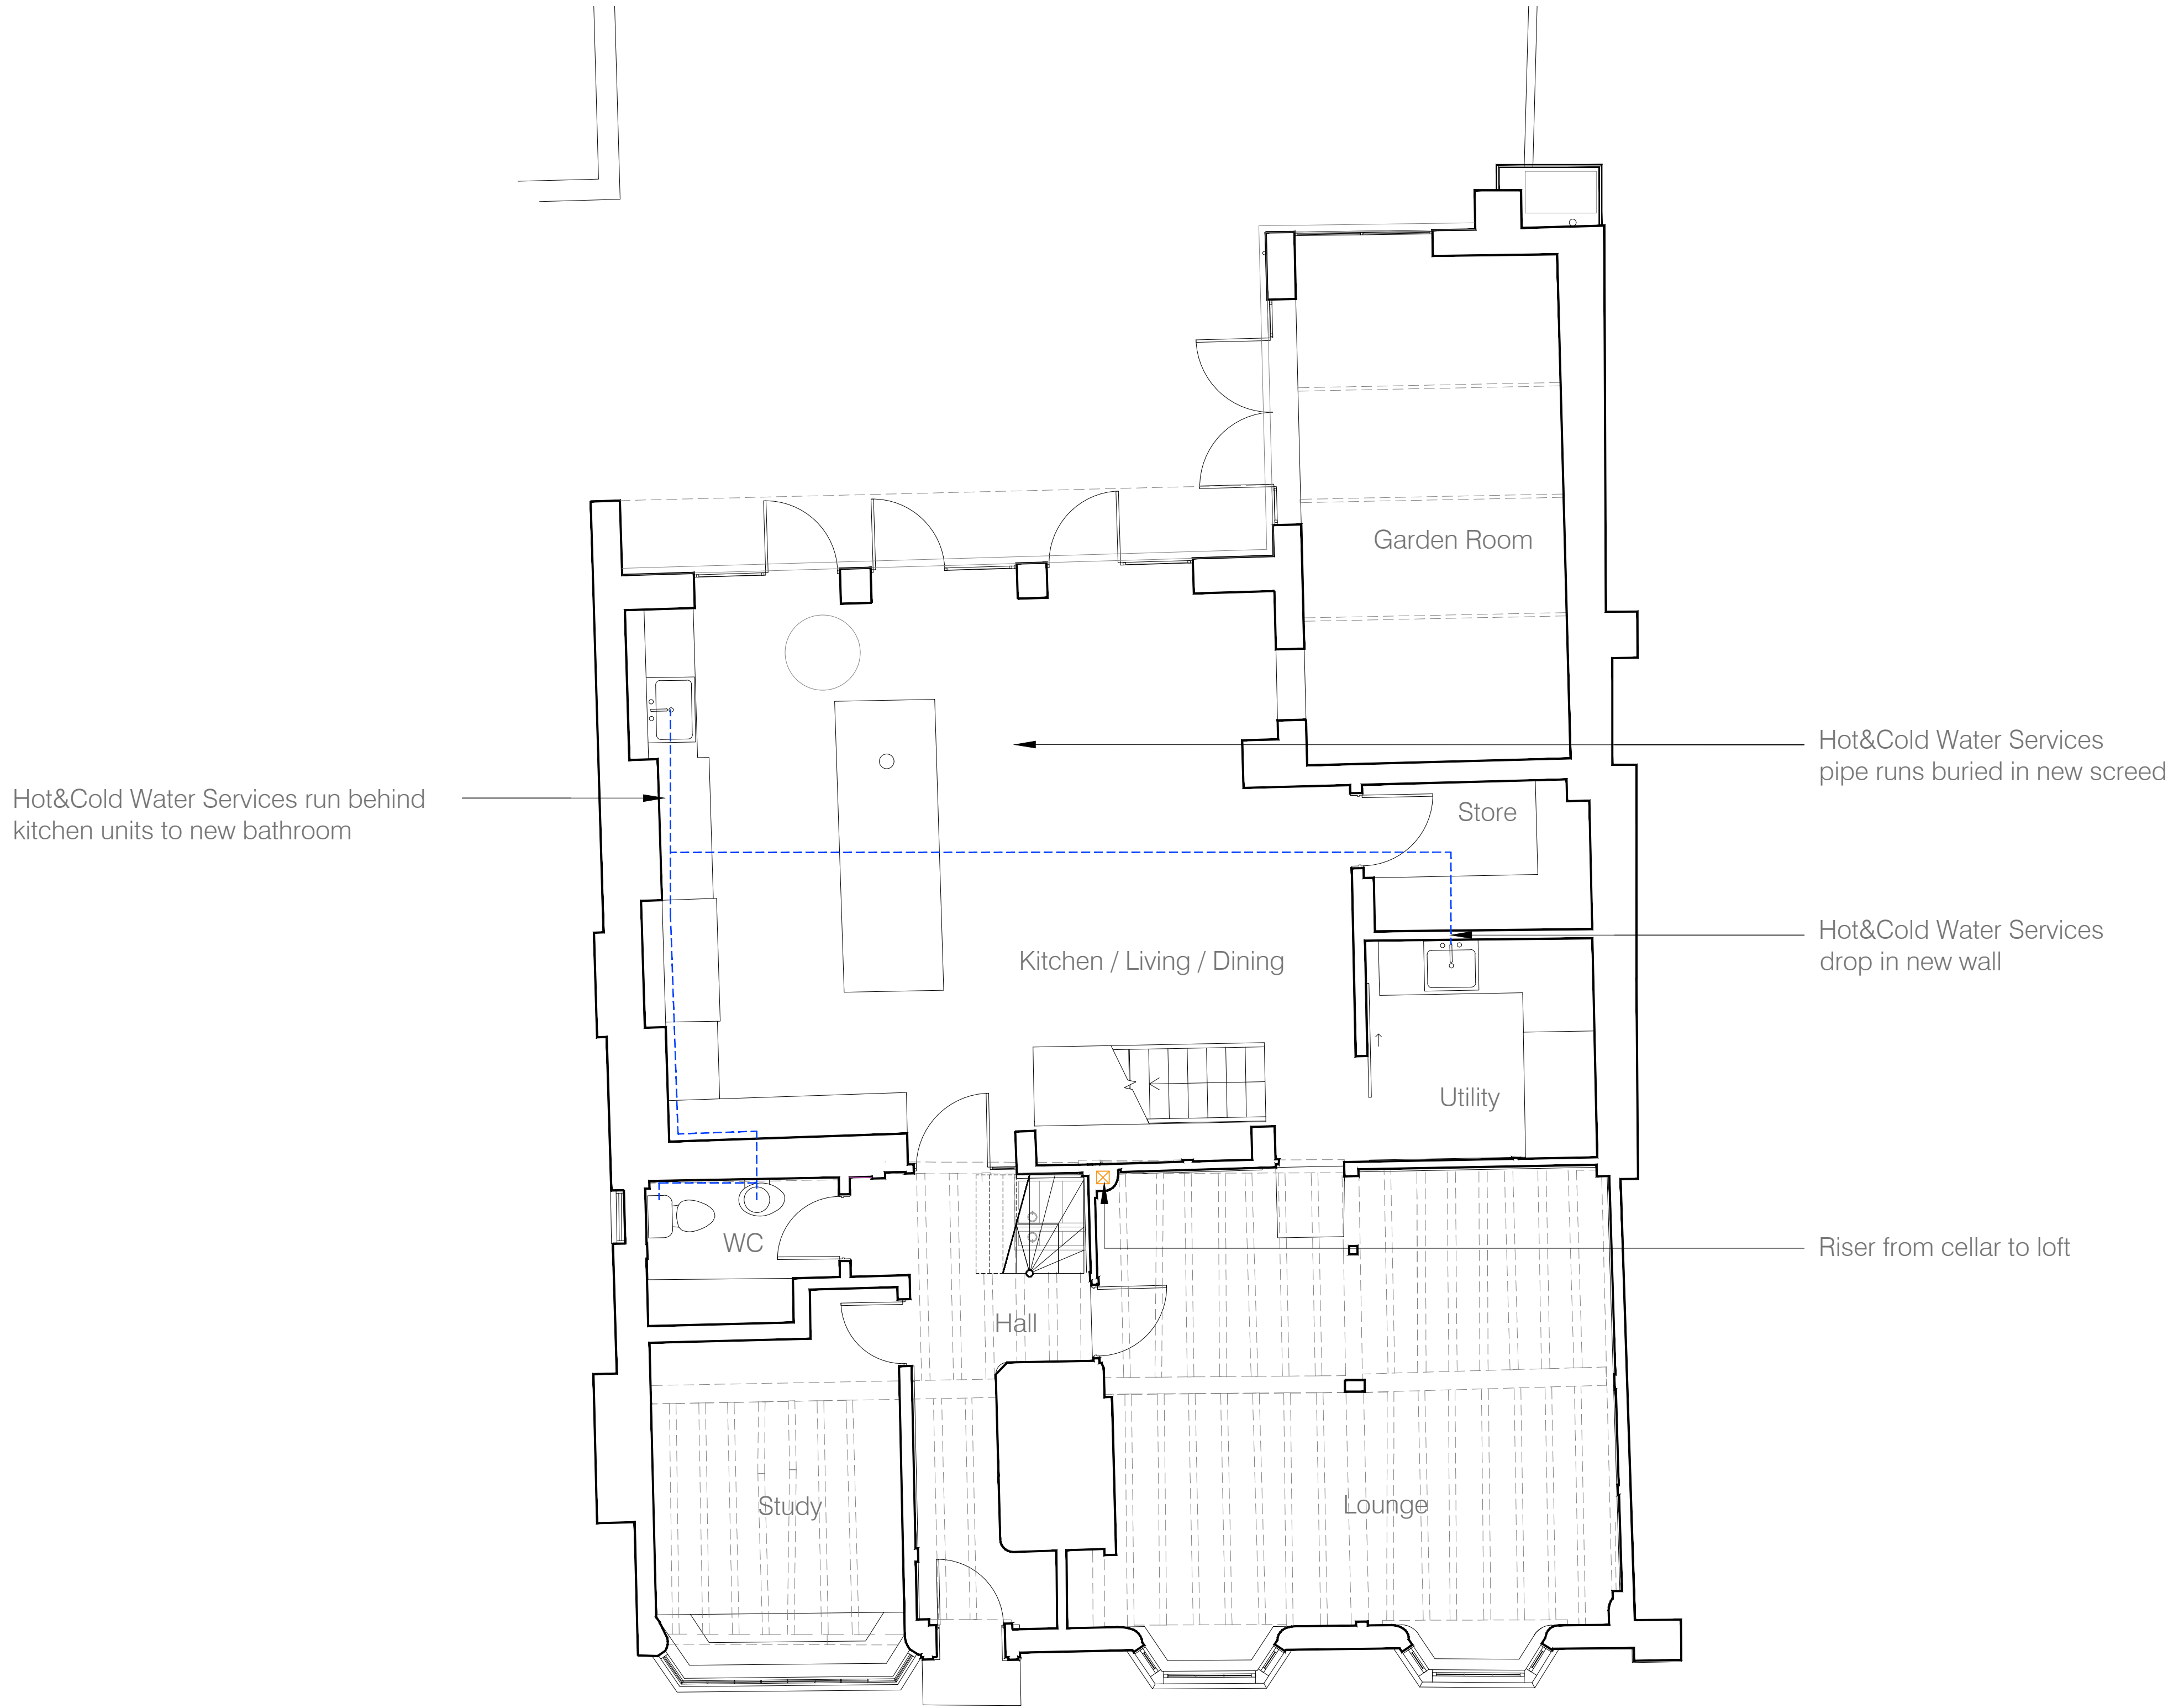


GROUND FLOOR PLAN
 Scale 1:50@A1
 1:100@A3

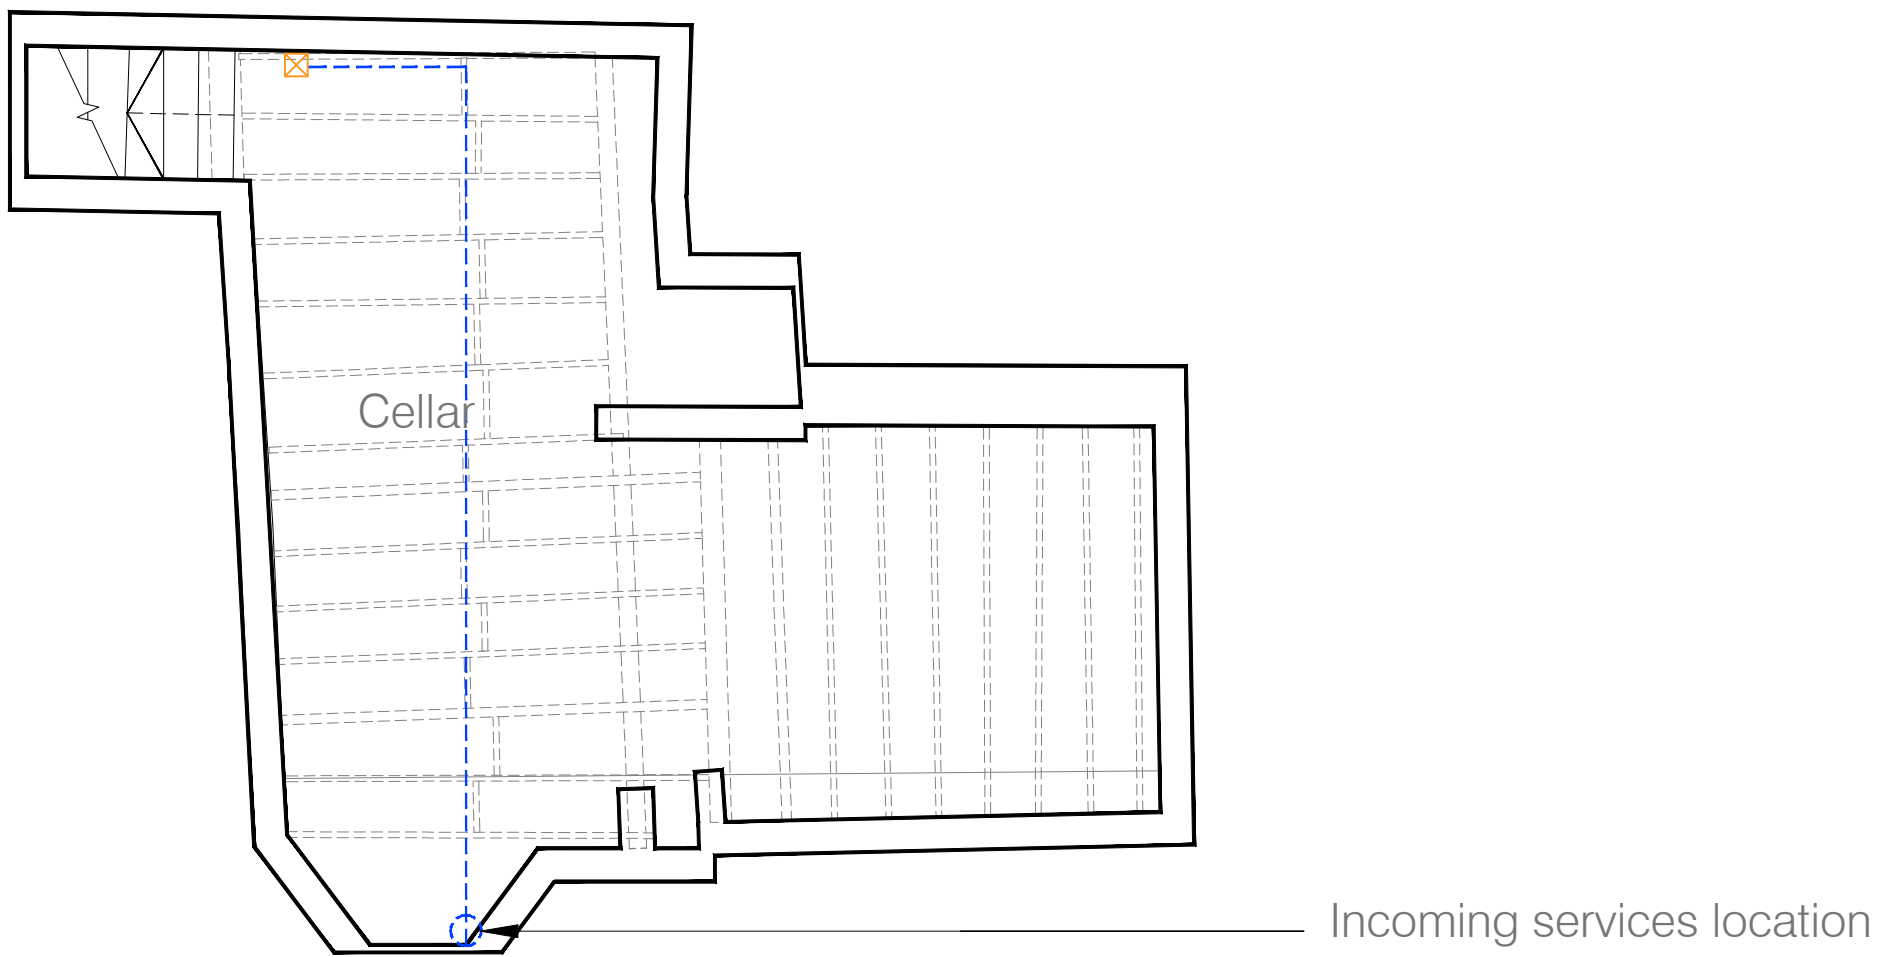

BASEMENT PLAN
 Scale 1:50@A1
 1:100@A3

NOTE
 DRAWINGS TO BE READ IN CONJUNCTION WITH SUBMITTED
 DESIGN&ACCESS STATEMENT AND HERITAGE STATEMENT

SERVICES INFORMATION OBTAINED FROM THE CONTRACTOR
 WHO INSTALLED IT.

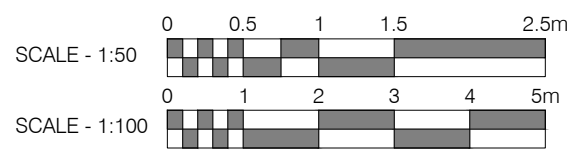

Rev.	Comments	By:	Date:
-	-	-	-

Do not scale this drawing All dimensions must be checked on site
 All rights reserved. No reproduction in any material form is permitted
 without consent.

LISTED BUILDING CONSENT			
Client: Mr. Simon Dougall			
Project Title: 107 High St, Lindfield, Haywards Heath, West Sussex, RH16 2HR			
Drawing Title: 'As-Built' Services: Basement and Ground Floor			
Scale: 1:50@A1 1:100@A3	Date: Sep 25	Drawn: KN	Checked: KW

kyson [®]		
Studio 28 Scrutton Street London UK EC2A 4RP T: +44(0) 20 7247 2462 E: enquiries@kyson.co.uk W: www.kyson.co.uk		
Project No.: 900-25	Drawing No.: 2400	Revision: -